
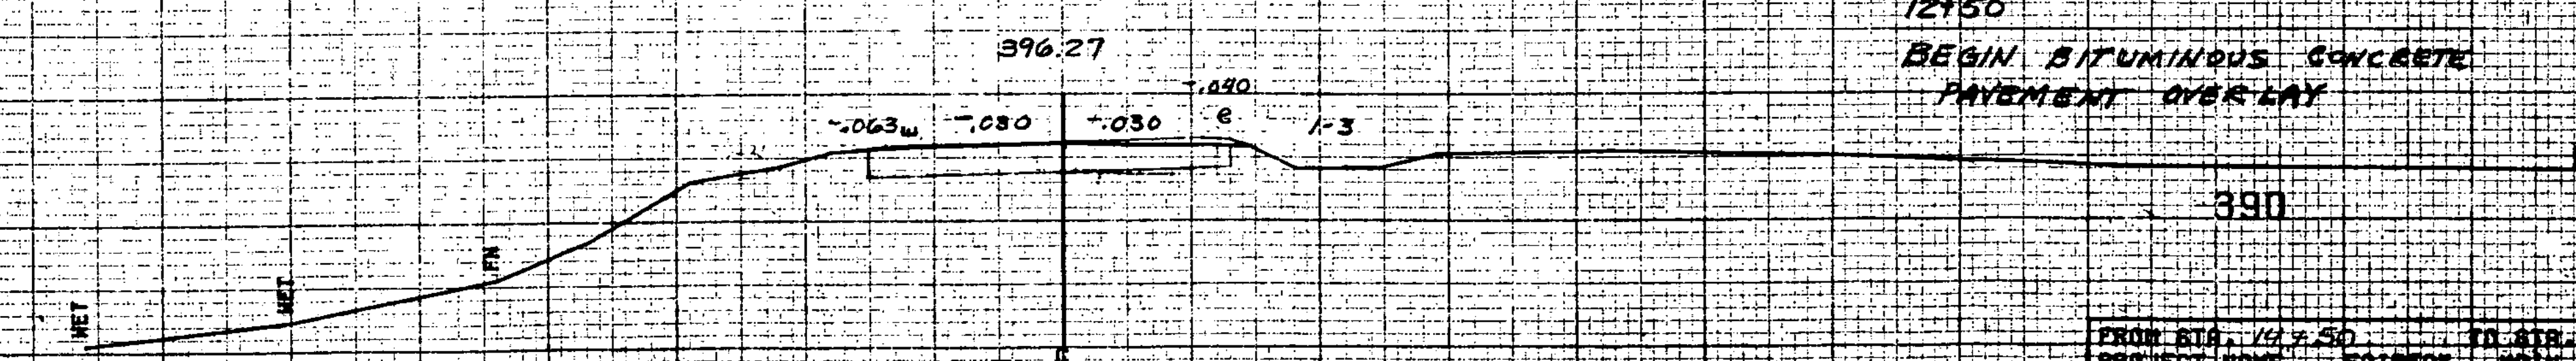


15+50  
 BEGIN PROJECT  
 END APPROACH

14+50  
 BEGIN APPROACH  
 END BITUMINOUS CONCRETE  
 PAVEMENT OVERLAY

396.12  
 Artesian Well  
 Rev 14+60

Approach  
 Transition Diagram

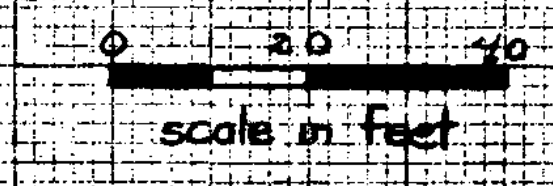

12+50  
 BEGIN BITUMINOUS CONCRETE  
 PAVEMENT OVERLAY

Rev 14+50

End Bituminous Concrete Pavement Overlay - Basin Approach

PROJ STA.	14+50	TO STA.	14+95.60
PROJECT NAME	FAIRFAX	DATE	10/20/00
NO.	BR022123	PLOTTED DATE	10/20/00
DRAWN BY	CALL	CHECKED BY	BR022123