


Rev. PT. 15+75.21  
 P. 2'00"  
 Full Banking .050'

Rev. 15+50  
 End Approach - Begin Project BR5 G229(2)

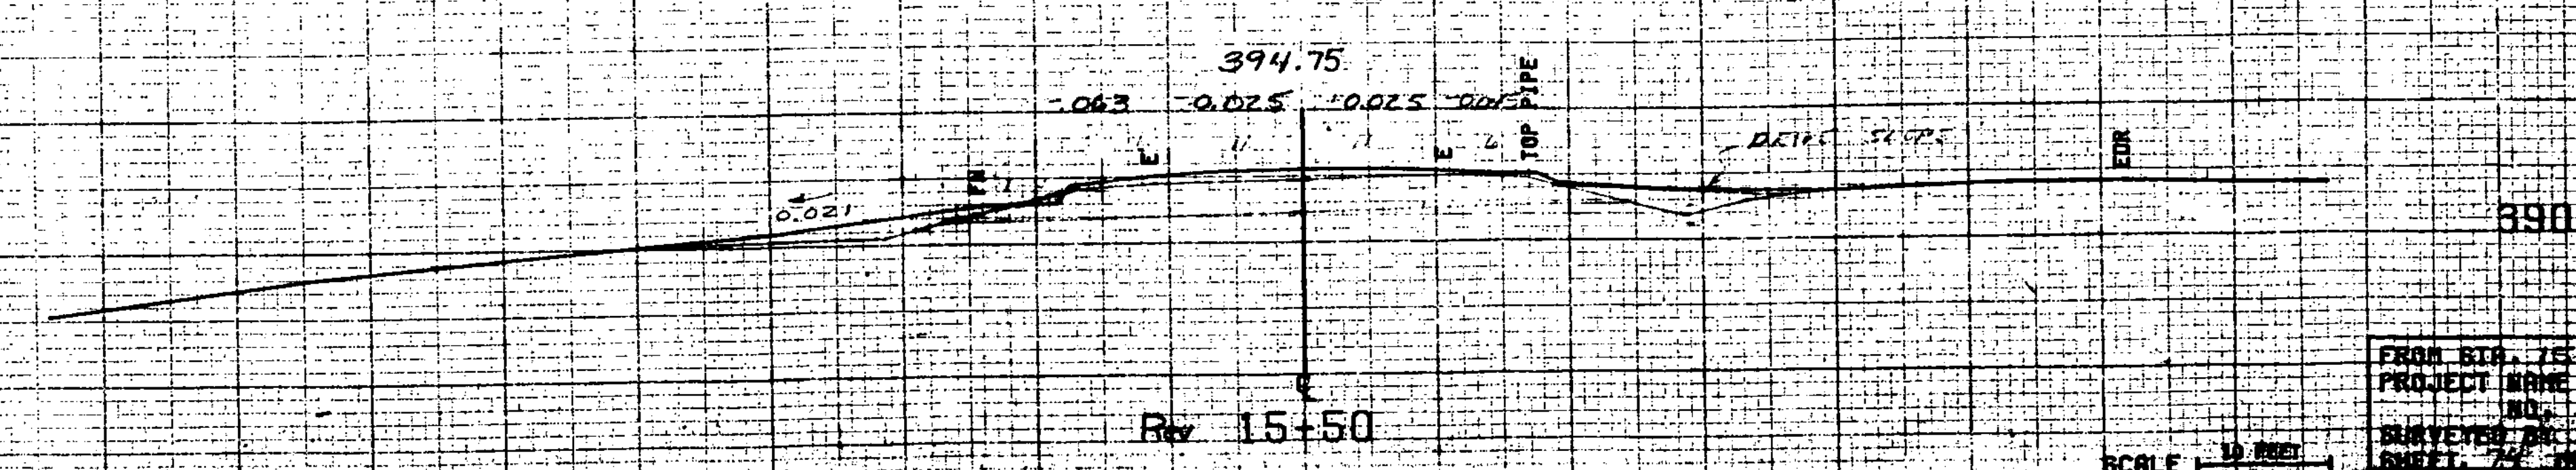

FROM STA. 15+25	TO STA. 16+00
PROJECT NAME	FAIRFAX MAIN
NO.	BR5 G229(2)
DATE	PLANNED
SCALE	1" = 10'