


Rev. PC 17+36.41
 D=7°30' E
 FB 0.080 F/FT

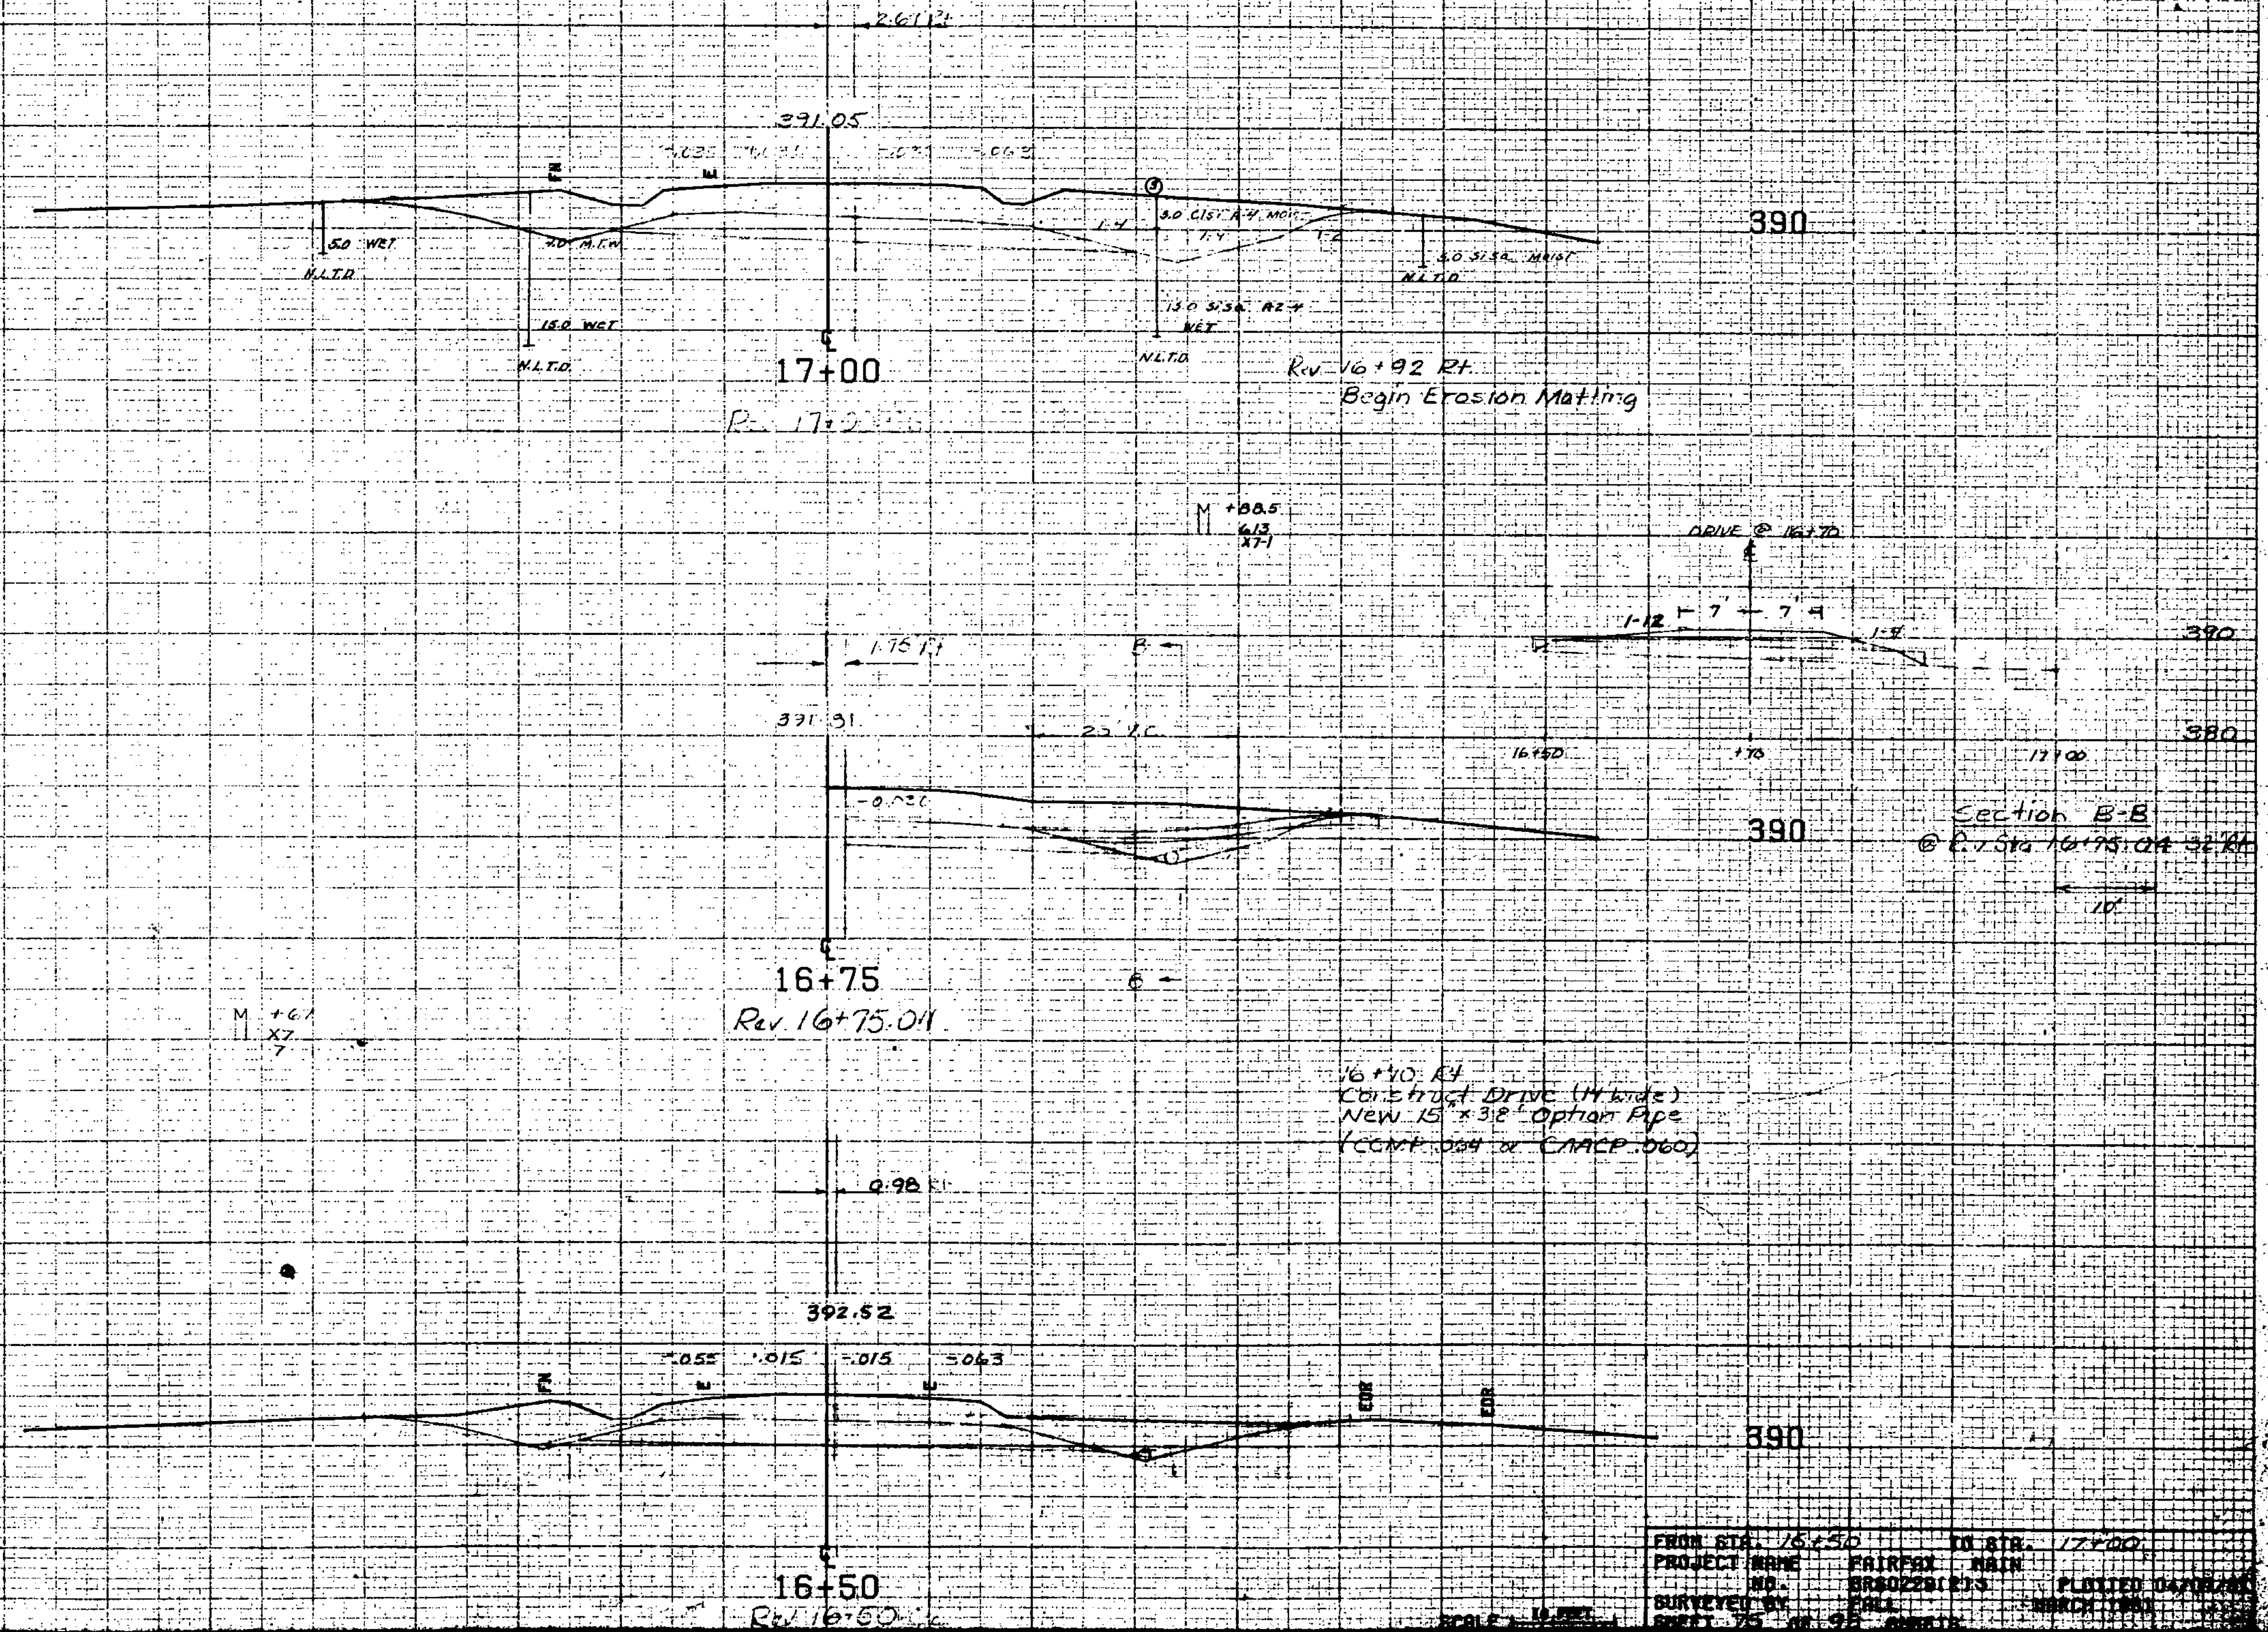

Section B-B
 @ 17.50 to 16+75.04 32' W

FROM STA	16+50	TO STA	17+00
PROJECT NAME	FAIRFAX MAIN		
NO.	BR0228123		PLOTTED DATE
SURVEYED BY	DRL		DATE
DATE	75		