

18+30
Construct Drive
New 15" x 38" Option Pipe
(CGMP 1064 or CAACP 1060)

18+43
Rev. 18+42.51

18+00
Rev. 17+97.60


Rev. 18+00
Begin Grading and Blasting of
Solid Rock Subgrade

18+00 RT
Construct Drive (N side)
New 15" x 38" Option Pipe
(CGMP 1064 or CAACP 1060)

Rev. 17+66 RT
End Erosion Matting

17+50
Rev. 17+49.60

Banking Transition Diagram

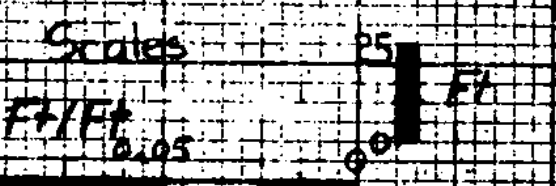

FROM STA. 17+50	TO STA. 18+43
PROJECT NAME: FAIRFAX MAIN	PLOTTED BY: J. J. [unclear]
NO. 200221215	DATE: 1981
SURVEYED BY: [unclear]	