


Scale in Feet
0 10 20

Gravel Turnout Detail
SEE STANDARDS 3-17

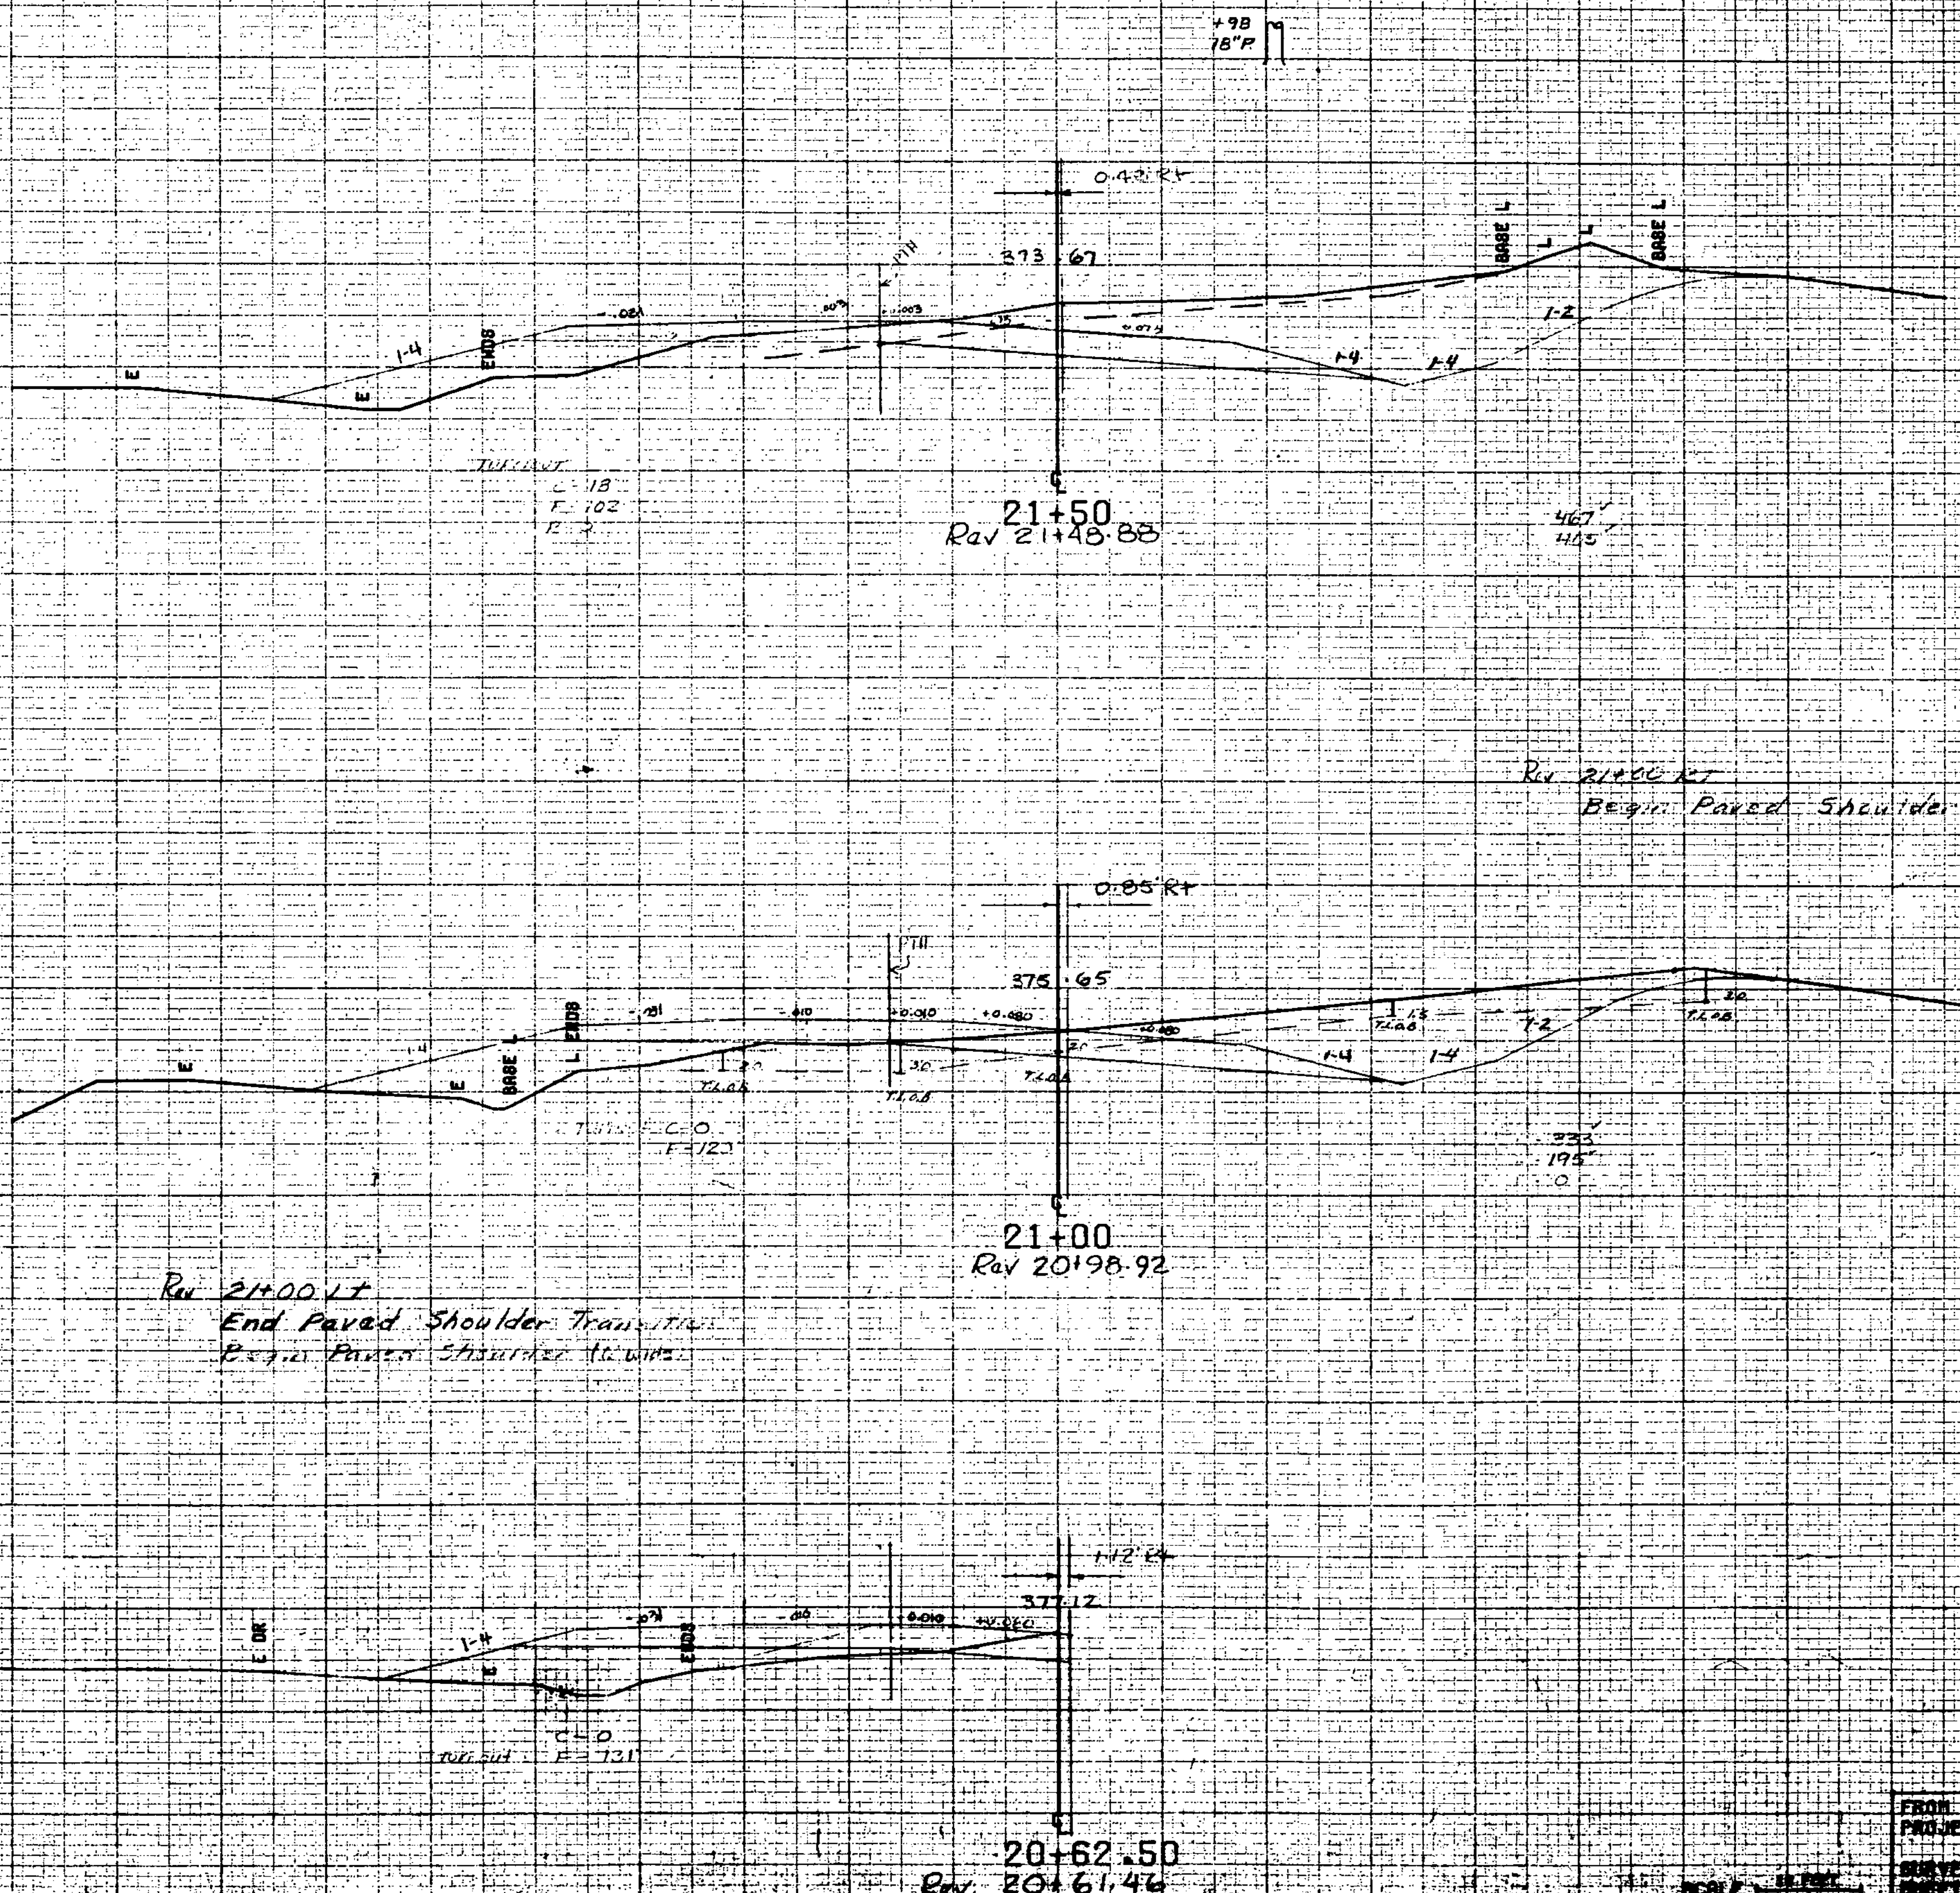

+98
18" P

21+50
Rev 21+48.88

Rev 21+00 RT
Begin Paved Shoulder Transition

Paved Shoulder
Transition Detail

Scale in Feet
0 20 40

Rev 21+00 LT
End Paved Shoulder Transition
Begin Paved Shoulder Transition

21+00
Rev 20+98.92

20+62.50
Rev 20+61.46

FROM STA.	20+62.50	TO STA.	21+65.00
PROJECT NAME	FAIRFAX PATH		
NO.	00000003	DATE	08/11/00
SURVEYED BY	ESL	DESIGNED BY	ESL
CHECKED BY	ESL	APPROVED BY	ESL