



23+38 Lt
 End Excavation & Removal of Road
 Surfaces & Pavements

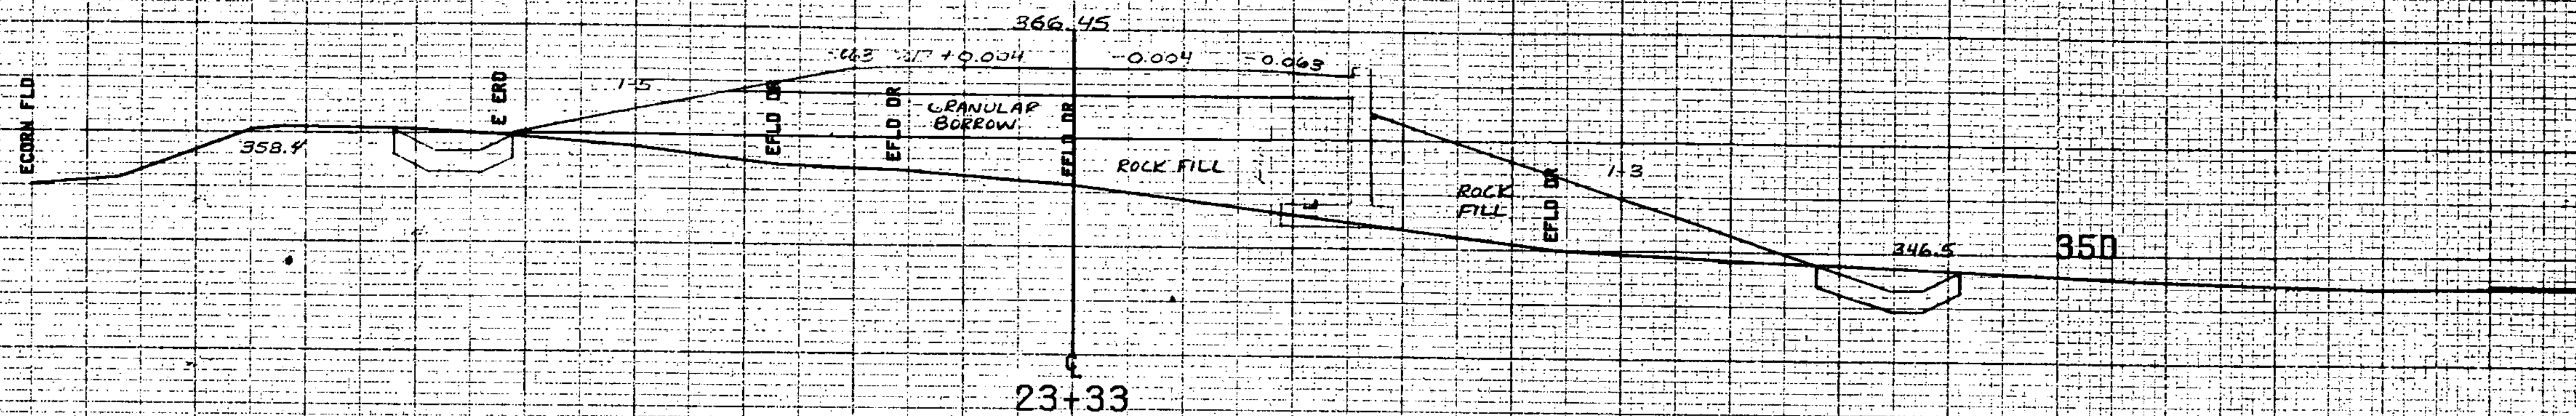


23+37.5 Lt
 End Standard Steel Beam Guard
 Rail w/ Wood Posts, Type II
 Begin Guard Rail Approach
 Section, Type I

23+28 Rt
 End Standard Steel Beam Guard Rail
 w/ Wood Posts, Type II Item 62128
 Begin Guard Rail Approach Section, Type I Item 62190

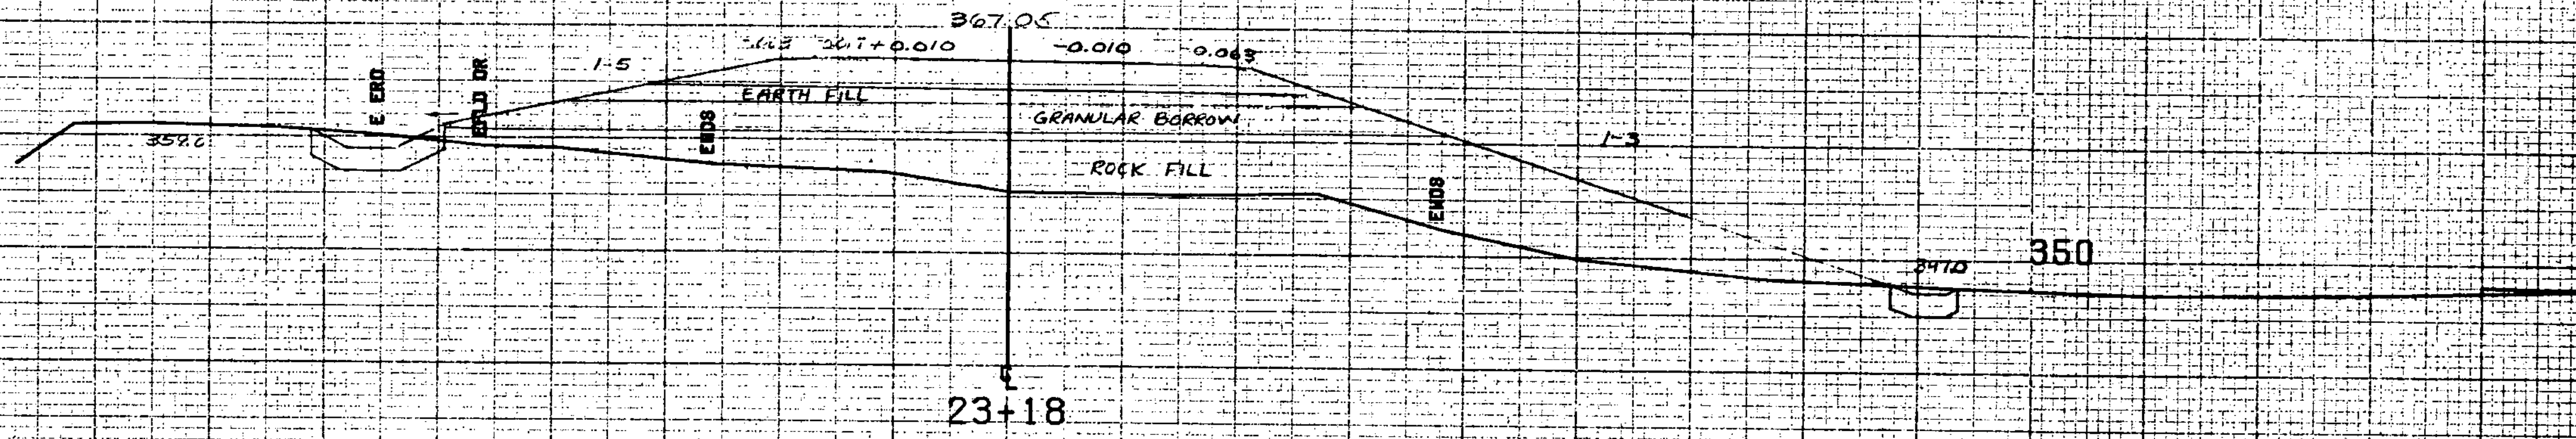


23+00
 End Drilling and Blasting of
 Solid Rock Subgrade

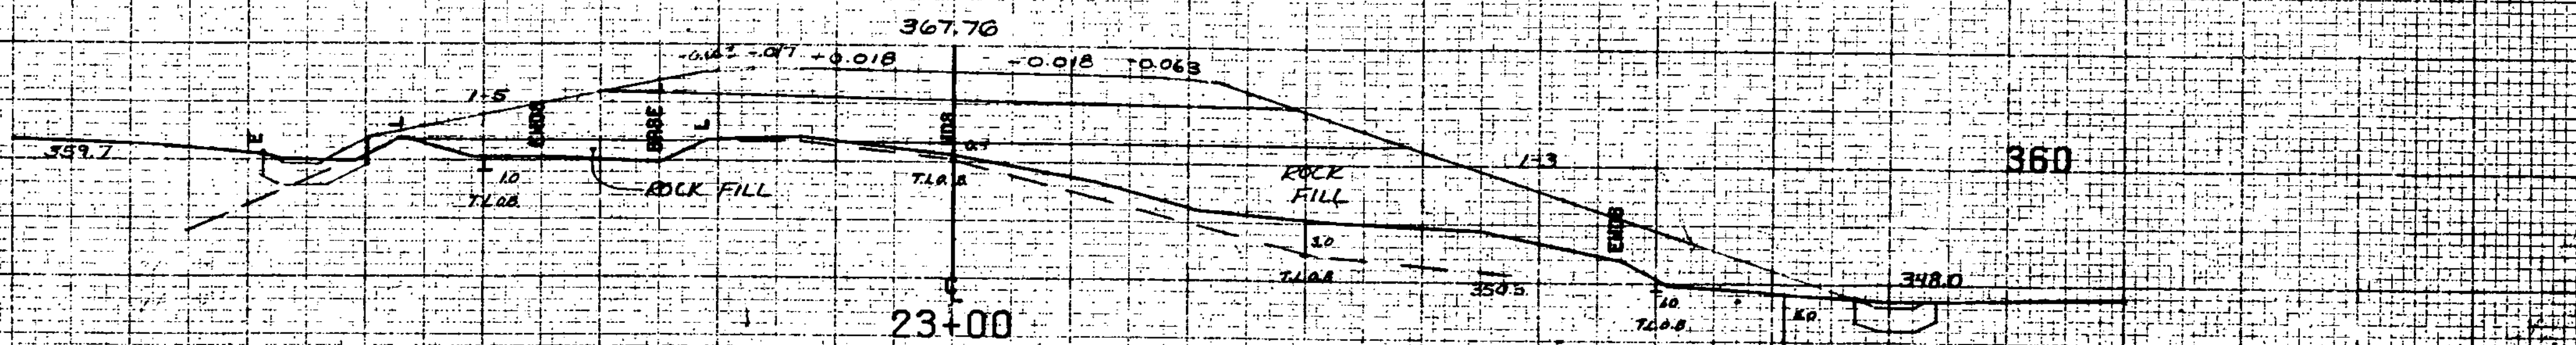

ORDER RAIL
 Guard Rail Approach
 Section Type I

Guard Rail standard
 Steel Beam w/ Wood
 Post Type II
 BCI
 SEE 674

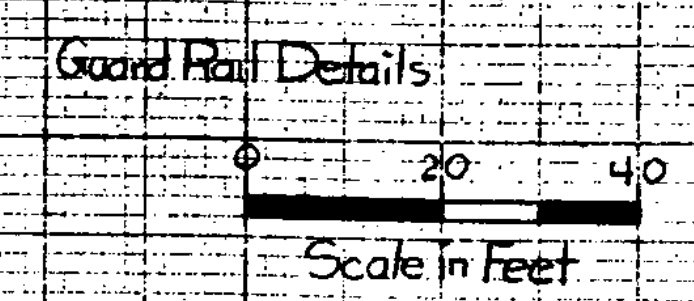

FROM STA. 23+00	TO STA. 23+30
PROJECT NAME	FAIRFAX MAIN
NO.	ROADWAY 21-5
SURVEYED BY	CALL
DATE	MARCH 1991