


NOTE BOOK PLATE
AREAS CHECKED
NO.

NOTE BOOK PLATE
AREAS CHECKED
NO.

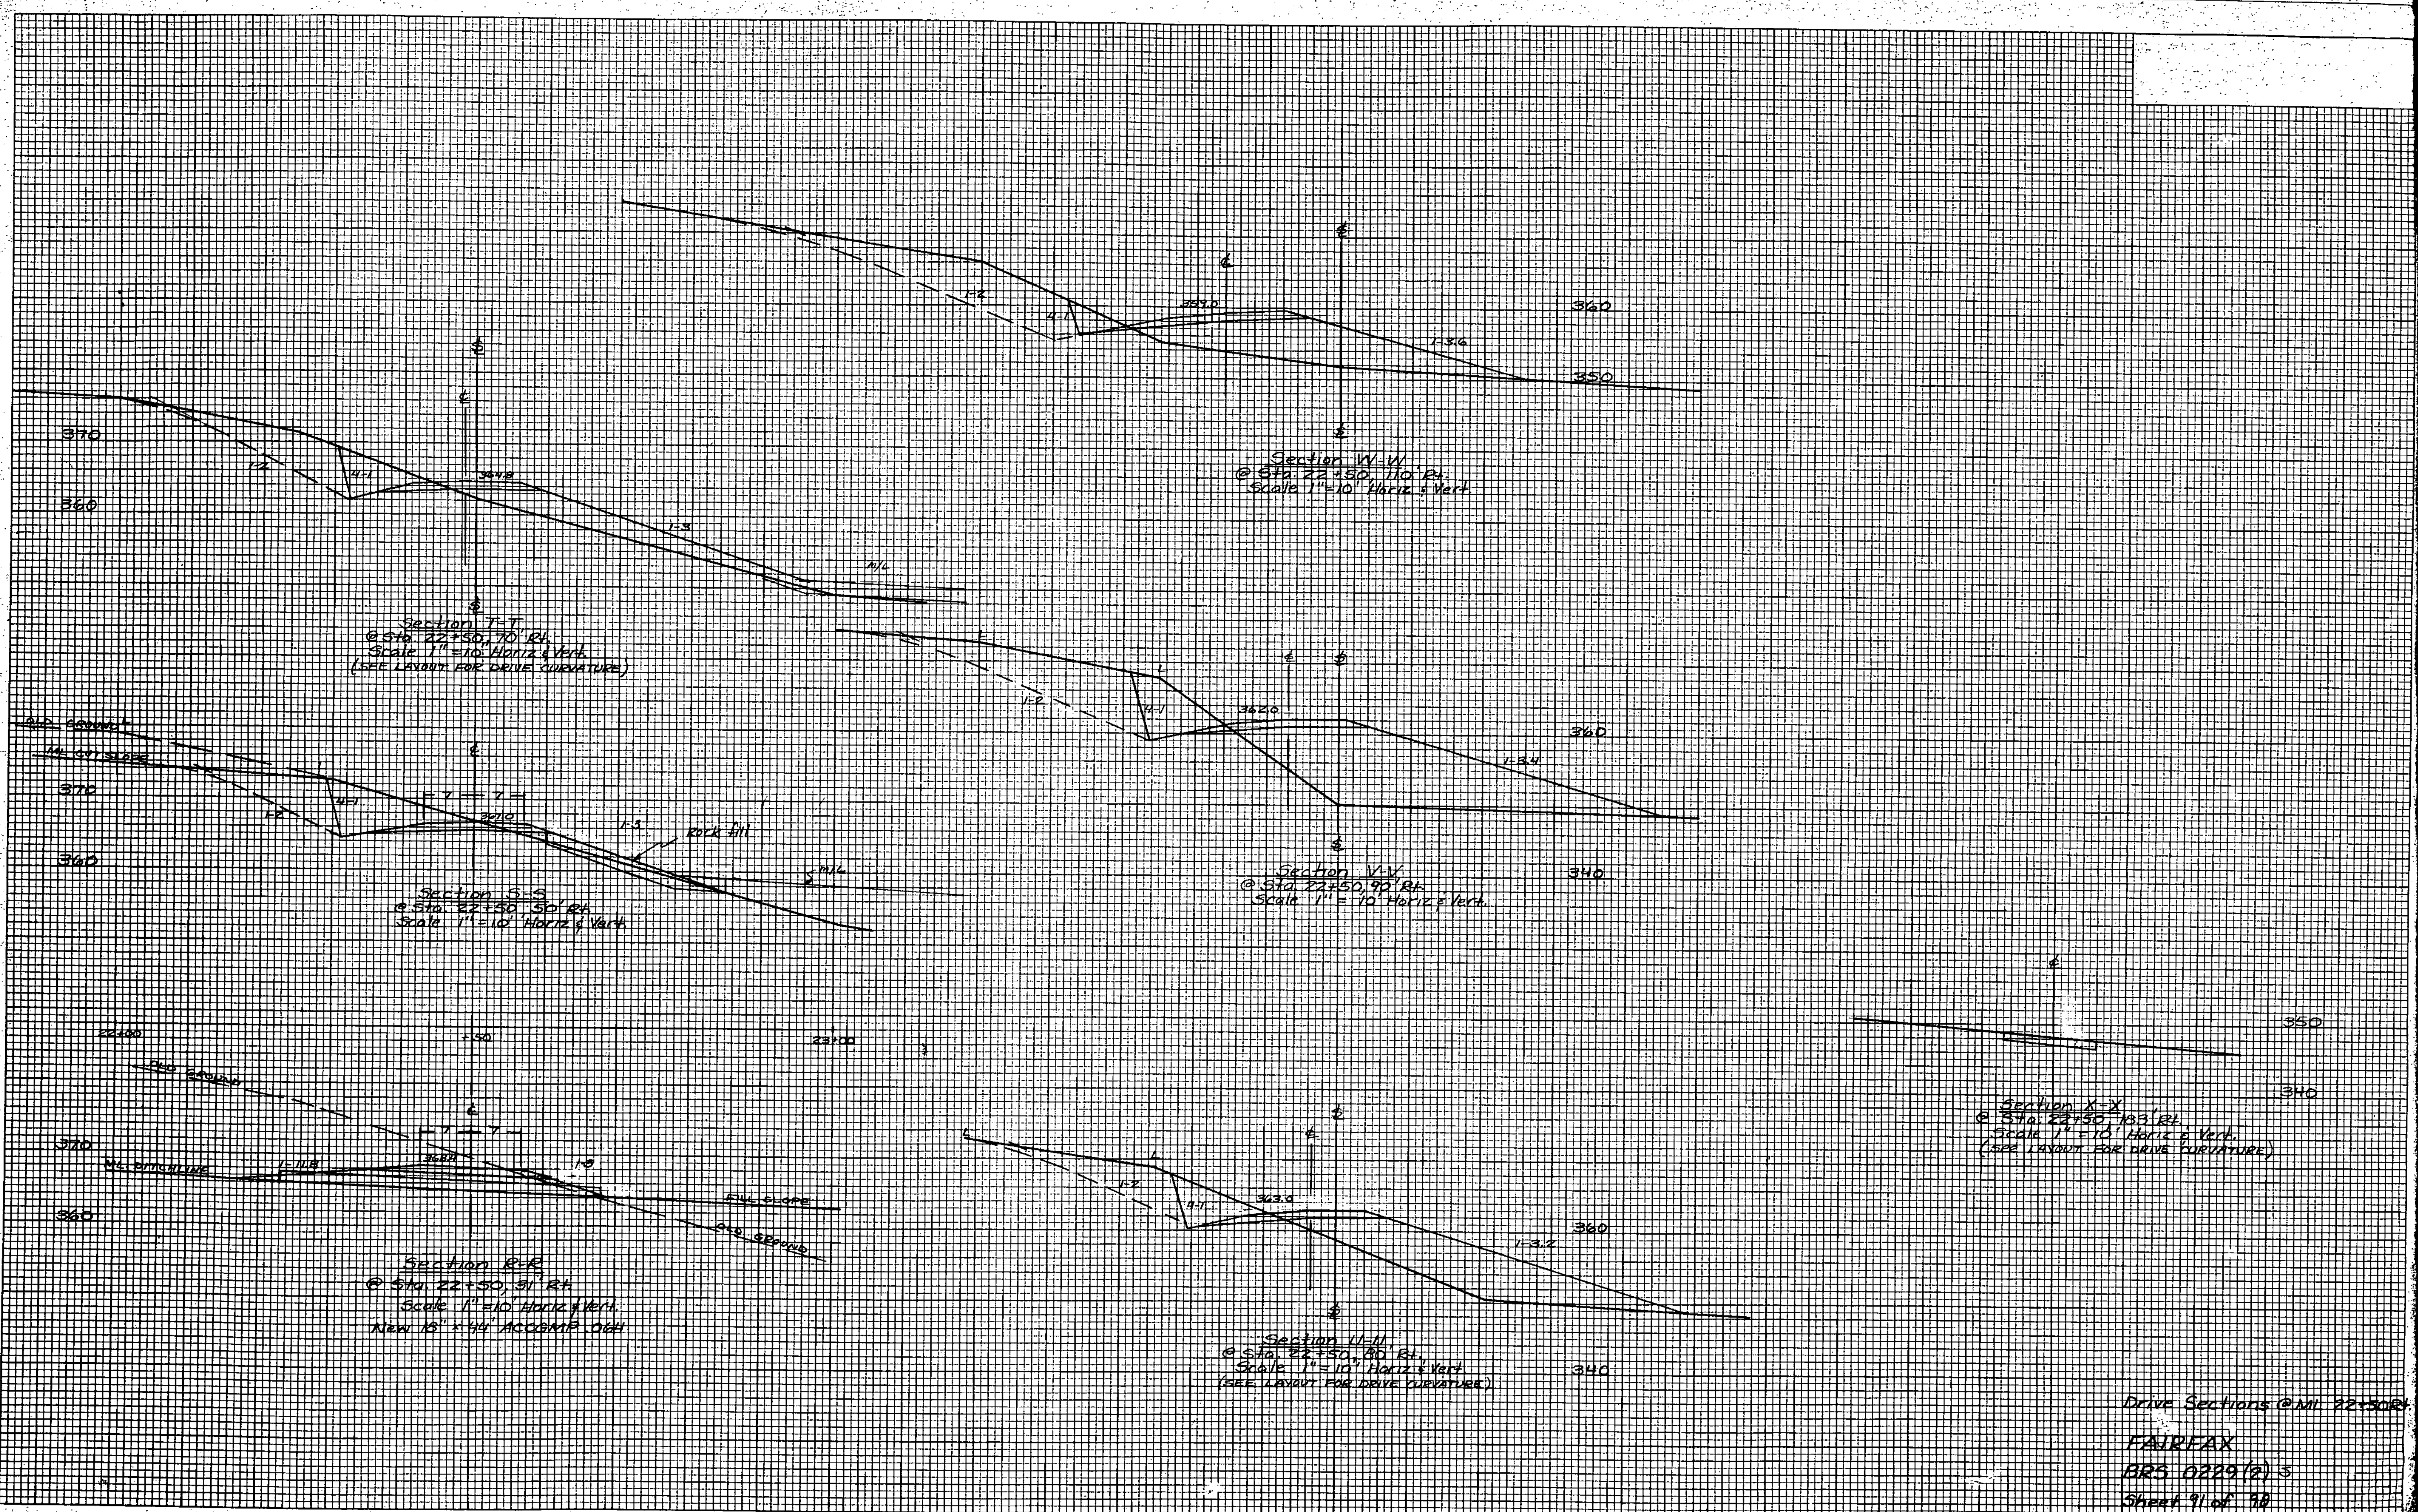

SECTION T-T
@ Sta. 22+50, 70' R/L
Scale 1" = 10' Horiz & Vert
(SEE LAYOUT FOR DRIVE CURVATURE)

Section W-W
@ Sta. 22+50, 110' R/L
Scale 1" = 10' Horiz & Vert

Section S-S
@ Sta. 22+50, 50' R/L
Scale 1" = 10' Horiz & Vert

Section V-V
@ Sta. 22+50, 90' R/L
Scale 1" = 10' Horiz & Vert

Section R-R
@ Sta. 22+50, 51' R/L
Scale 1" = 10' Horiz & Vert
NEW 15' x 44' ASPHALT OGH

Section X-X
@ Sta. 22+50, 103' R/L
Scale 1" = 10' Horiz & Vert
(SEE LAYOUT FOR DRIVE CURVATURE)

Section U-U
@ Sta. 22+50, 80' R/L
Scale 1" = 10' Horiz & Vert
(SEE LAYOUT FOR DRIVE CURVATURE)

Drive Sections @ MI 22+50 R/L
FAIRFAX
BRS 0229 (2) S
Sheet 91 of 90