
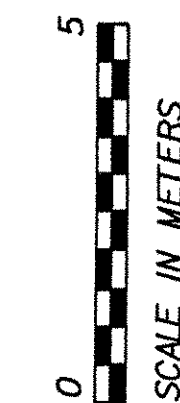


TEMPORARY DETOUR

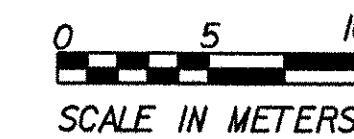

STATE OF VERMONT AGENCY OF TRANSPORTATION	
Town Of HARTLAND	Bridge No. 60
Highway No. U.S. ROUTE 5	Log Sta. Surv. Sta.
U.S. ROUTE 5 OVER LULLS BROOK	
TEMPORARY DETOUR PROFILE	
Designed By S.E. COSILMON	Drawn By R. REMY / G.F. O'NEIL
Checked By J. R. McDUFFEE	Bridge Design Supervisor J. MIECZKOWSKI
Date 2/ 04	Date 2/ 04
PROJECT HARTLAND	PROJECT NO. BRS No. 013(22)
I.G.C. Info. M:\1456201\VA0T Hartland\zxf204xsl.dgn	
Bridge Sheet No.	Sheet 21 of 86