




**ABUTMENT NO. 2 PLAN**

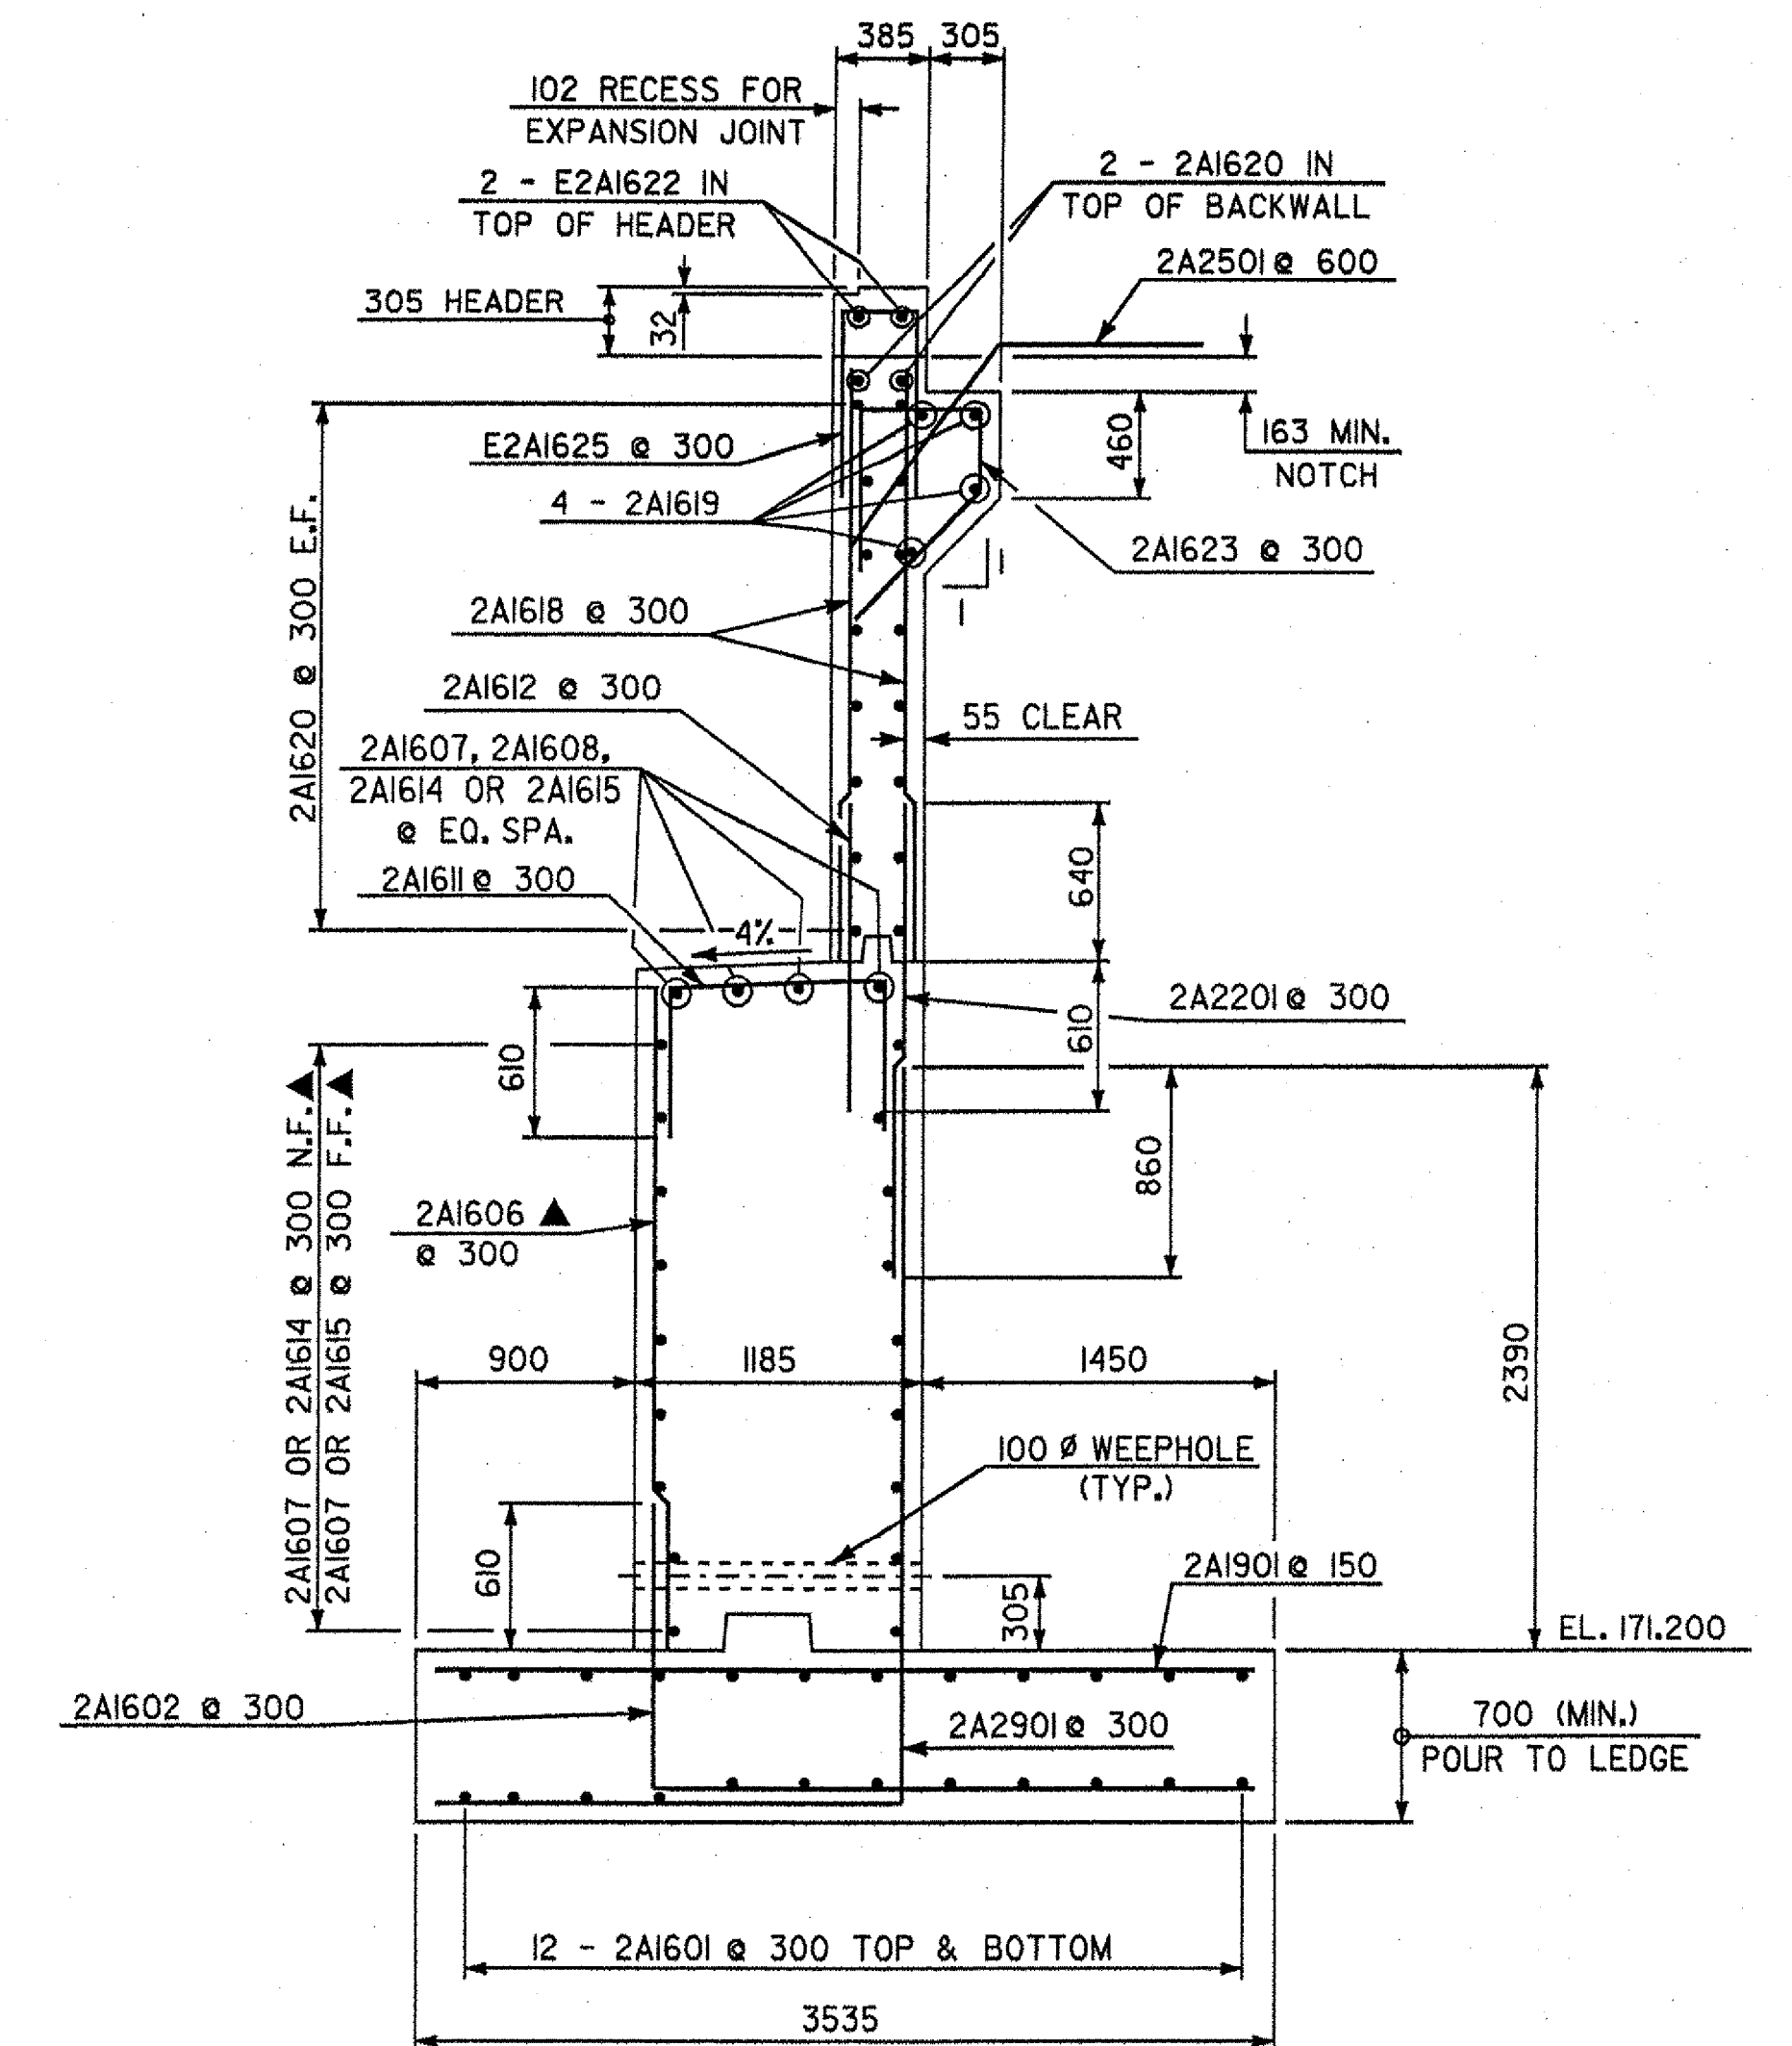

**SECTION G-G**

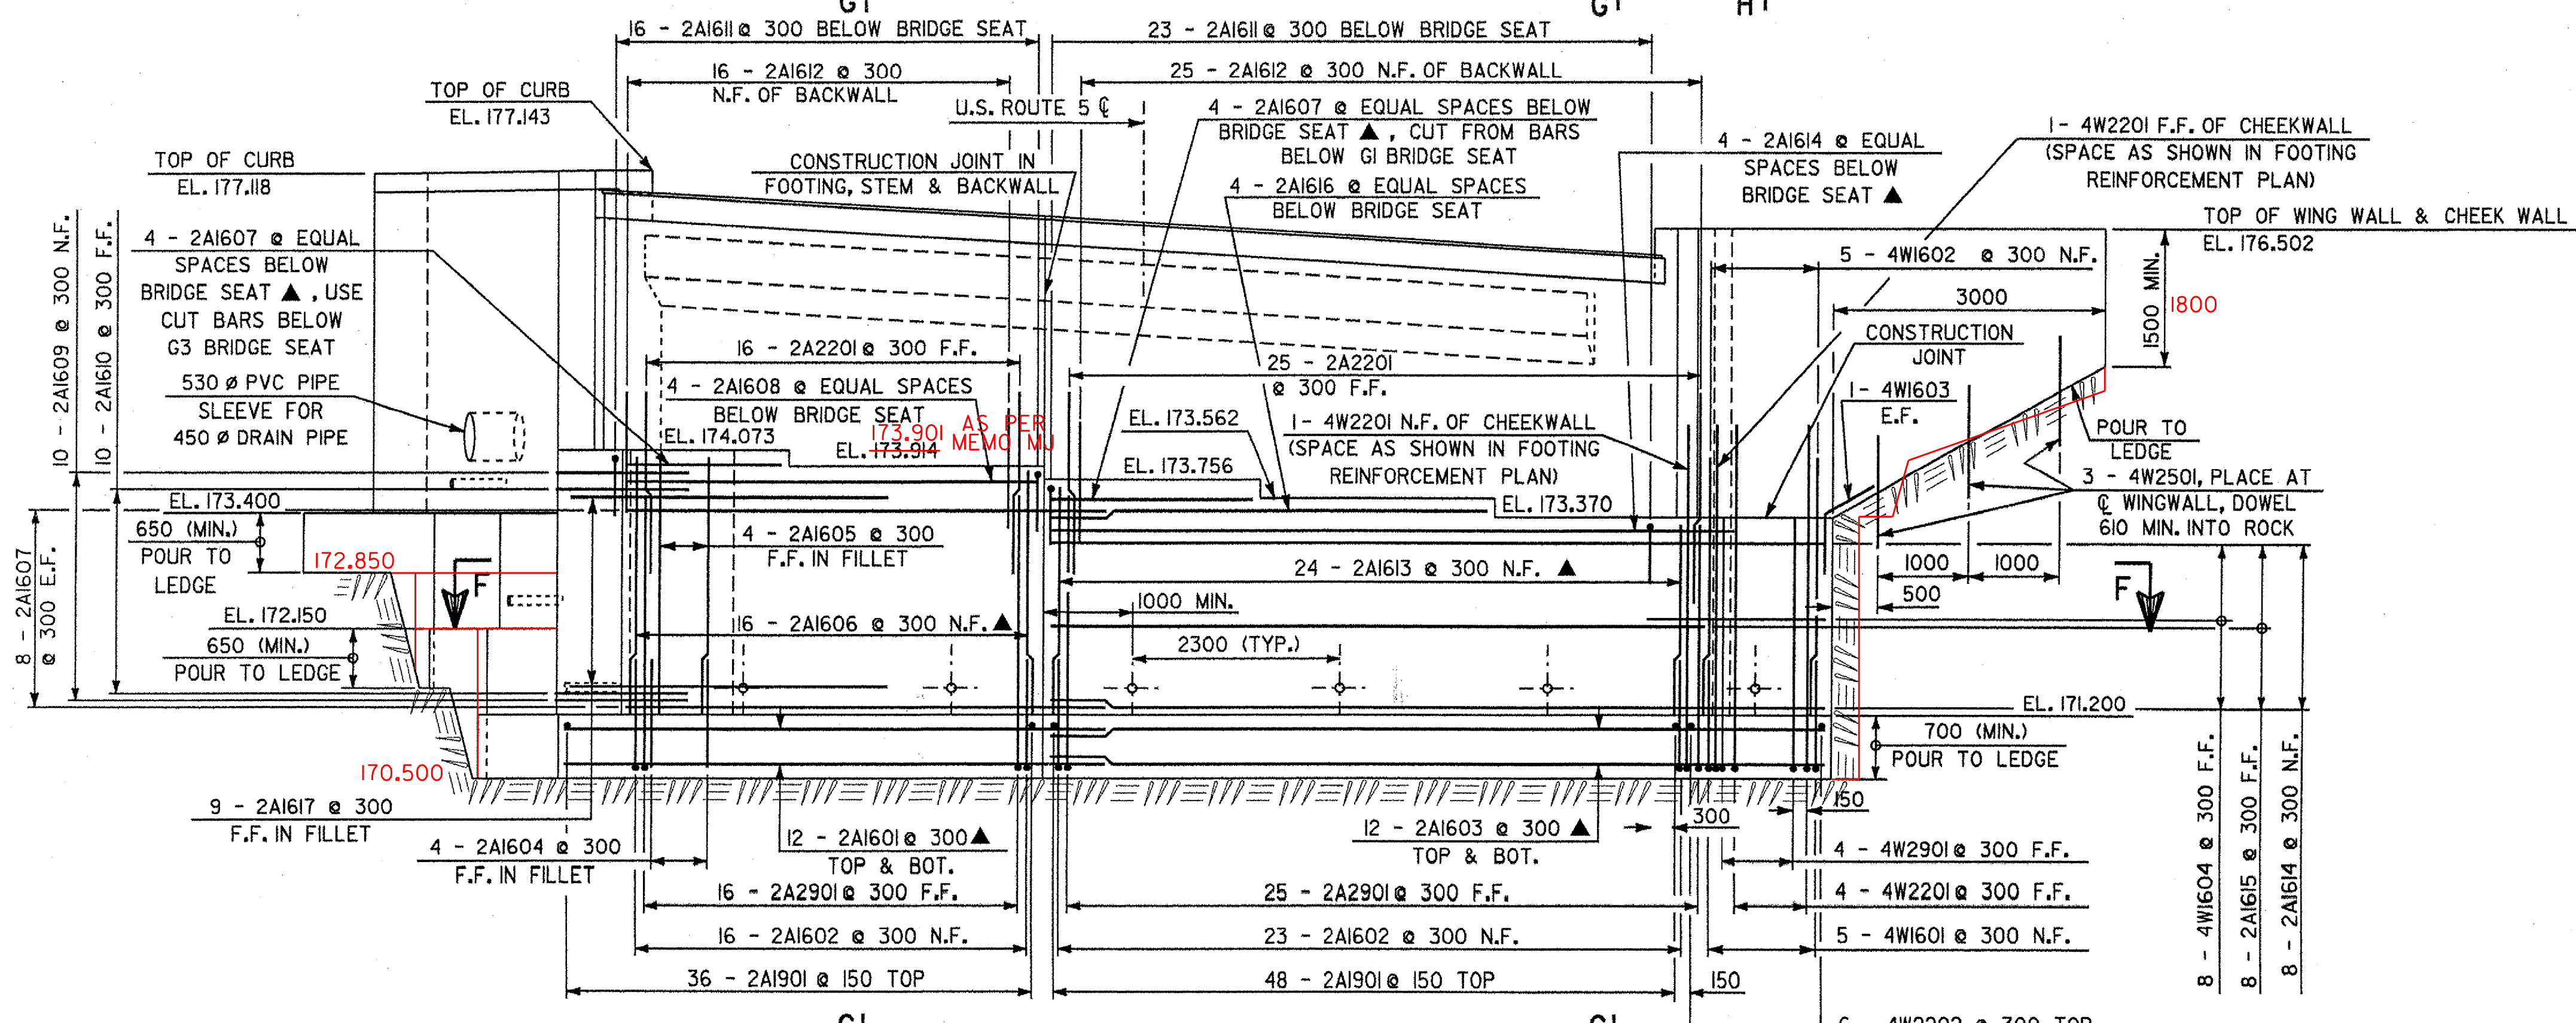

**ABUTMENT NO. 2 ELEVATION**

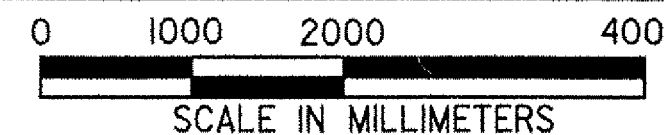

**NOTES:**

- N.F. - NEAR FACE
- F.F. - FAR FACE
- E.F. - EACH FACE
- REINFORCING COVER 80 CLEAR ON ALL FACES EXCEPT WHERE NOTED.
- MINIMUM LAP LENGTH FOR HORIZONTAL #16 BARS IS 610 UNLESS NOTED OTHERWISE.
- E - DENOTES EPOXY COATED REINFORCEMENT.
- ▲ - CUT TO FIT IN FIELD
- FOR SECTIONS F-F AND H-H, SEE SHEET BR127.

<b>STATE OF VERMONT AGENCY OF TRANSPORTATION</b>		
Town Of	HARTLAND	Bridge No. 60
Highway No.	U.S. ROUTE 5	Log Sta. Surv. Sta.
U.S. ROUTE 5 OVER LULLS BROOK		
<b>ABUTMENT NO. 2 DETAILS</b>		
Designed By	S. BAKI	Drawn By W. GAYNOR
Checked By	Date	Bridge Design Supervisor J. MECZKOWSKI Date
PROJECT	HARTLAND	PROJECT NO. BRS No. 0113(22)
I.G.C. Info. M:\1456201\VA0T Hartland\struct\z2f204am2.dgn		
Bridge Sheet No.	BR123	Sheet 58 of 86