

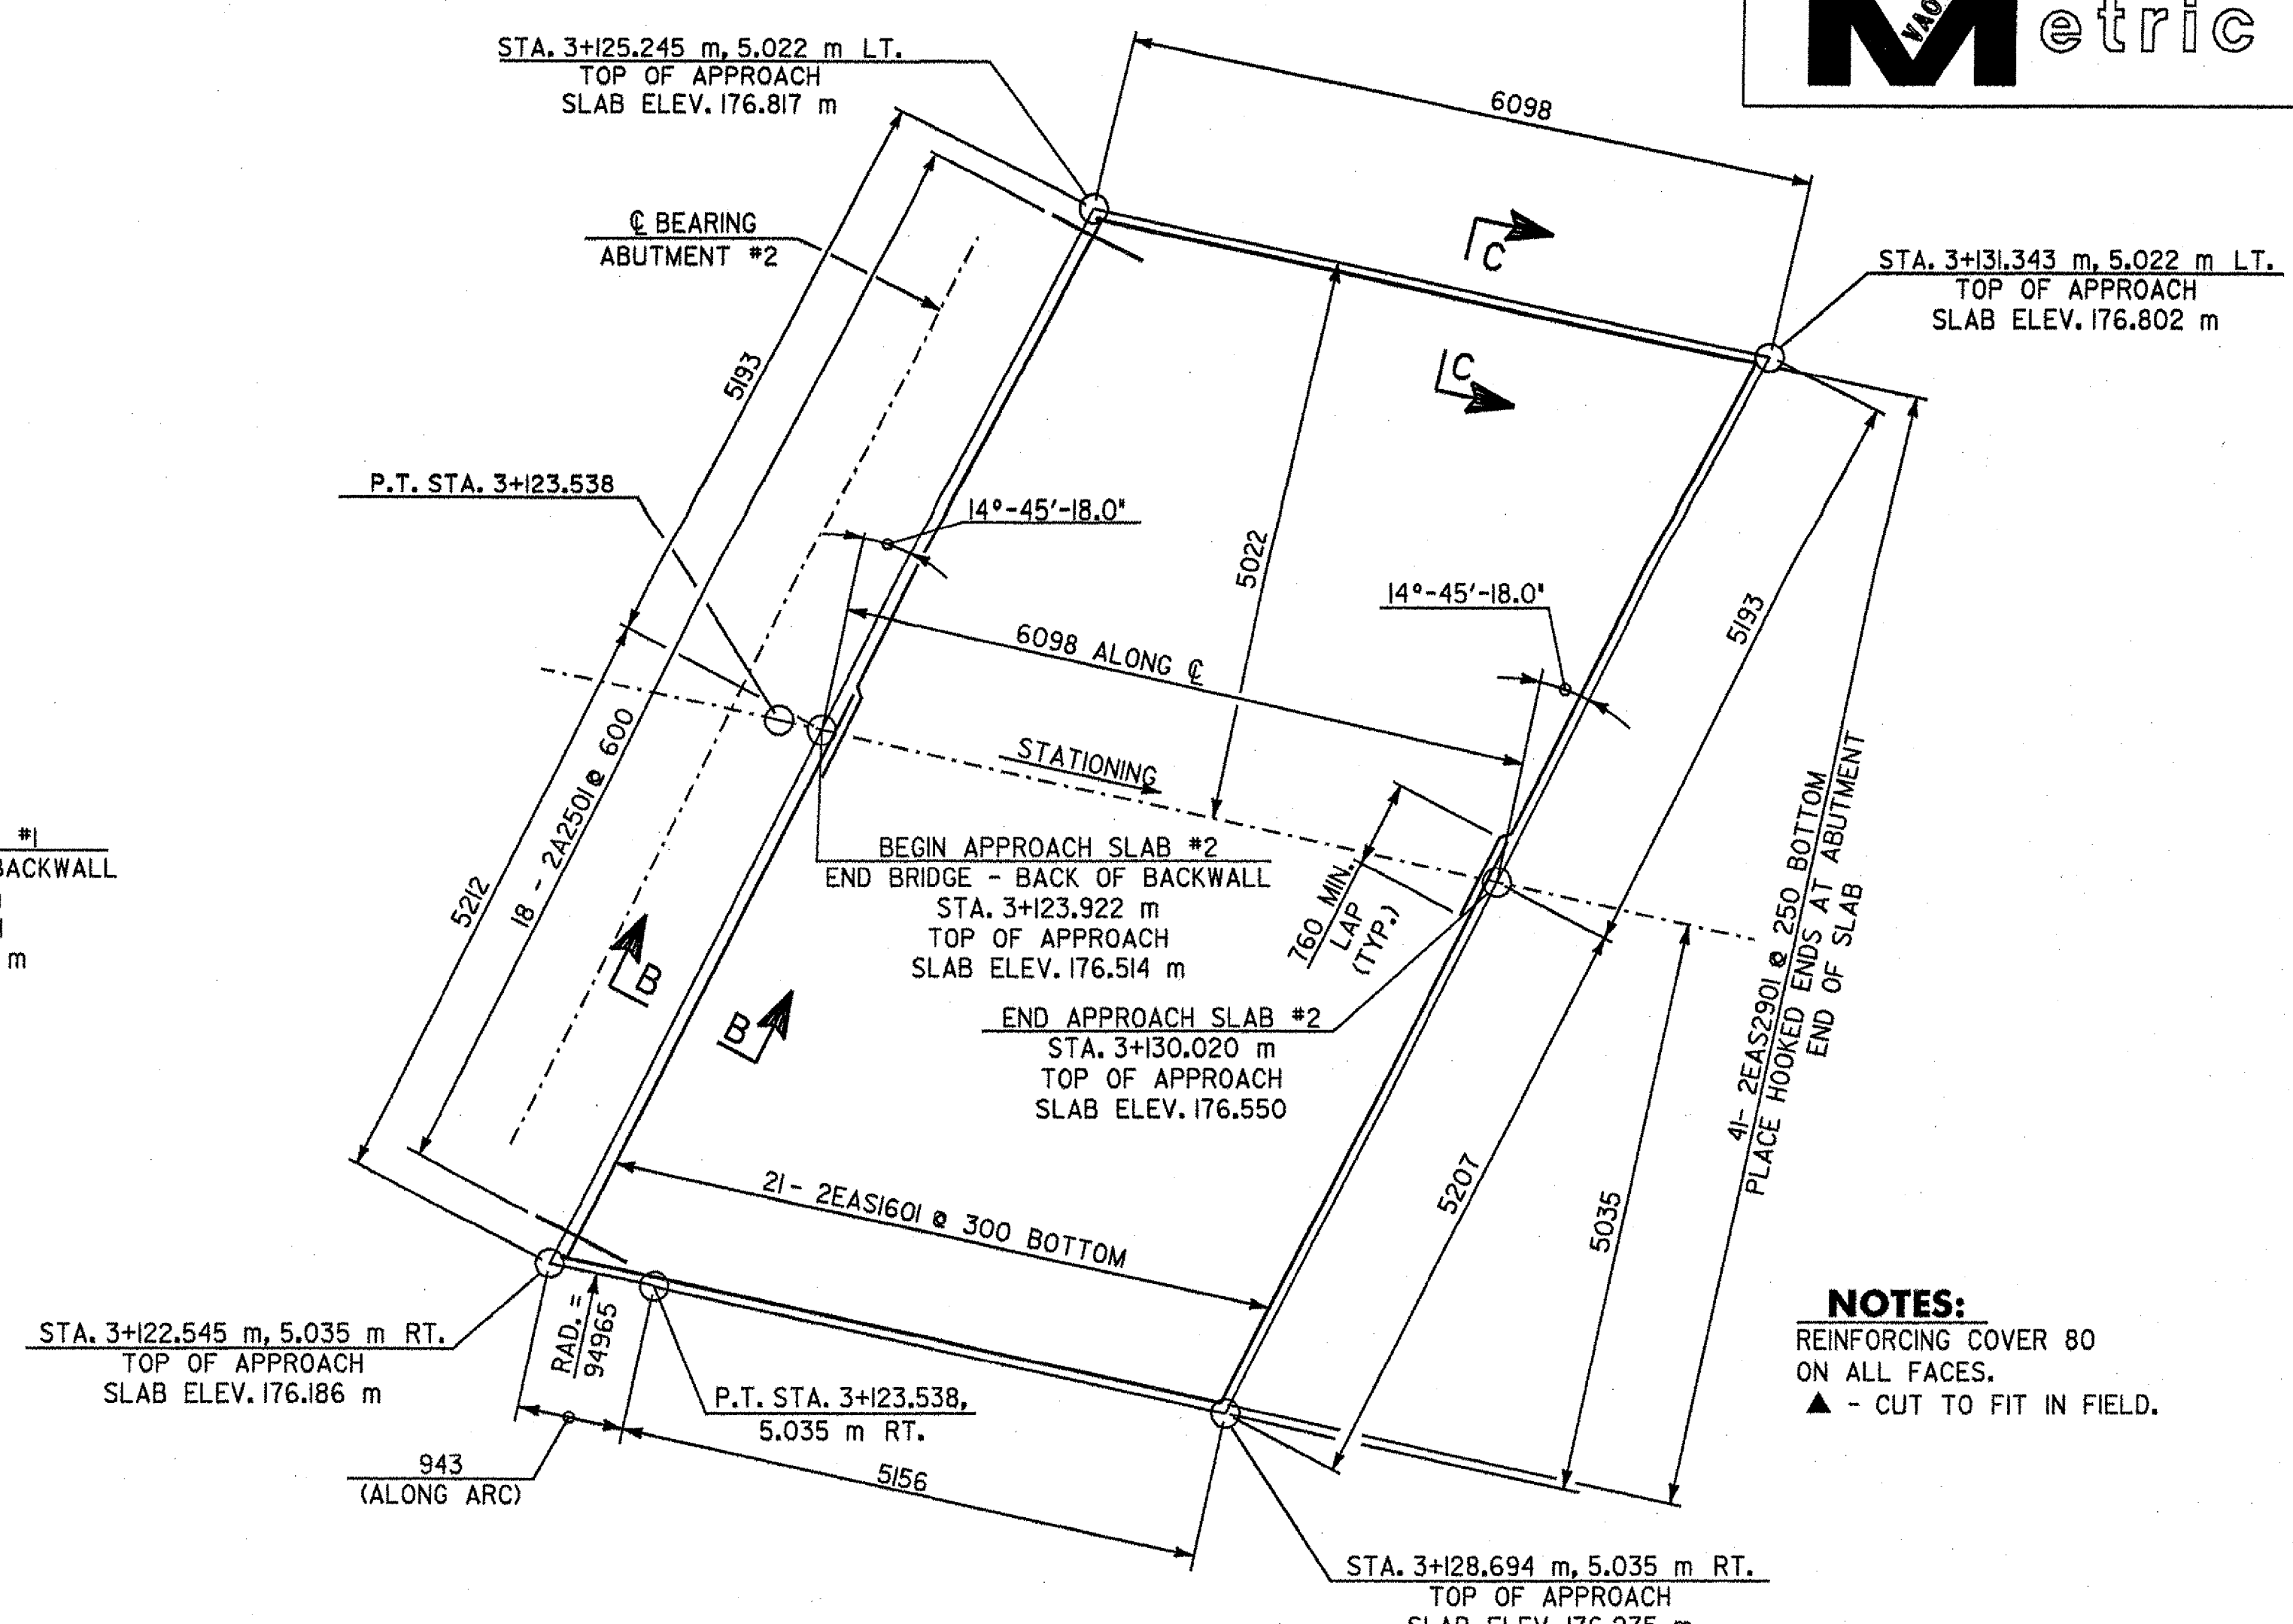


APPROACH SLAB NO. 1 PLAN
0 1000 2000 4000
SCALE IN MILLIMETERS

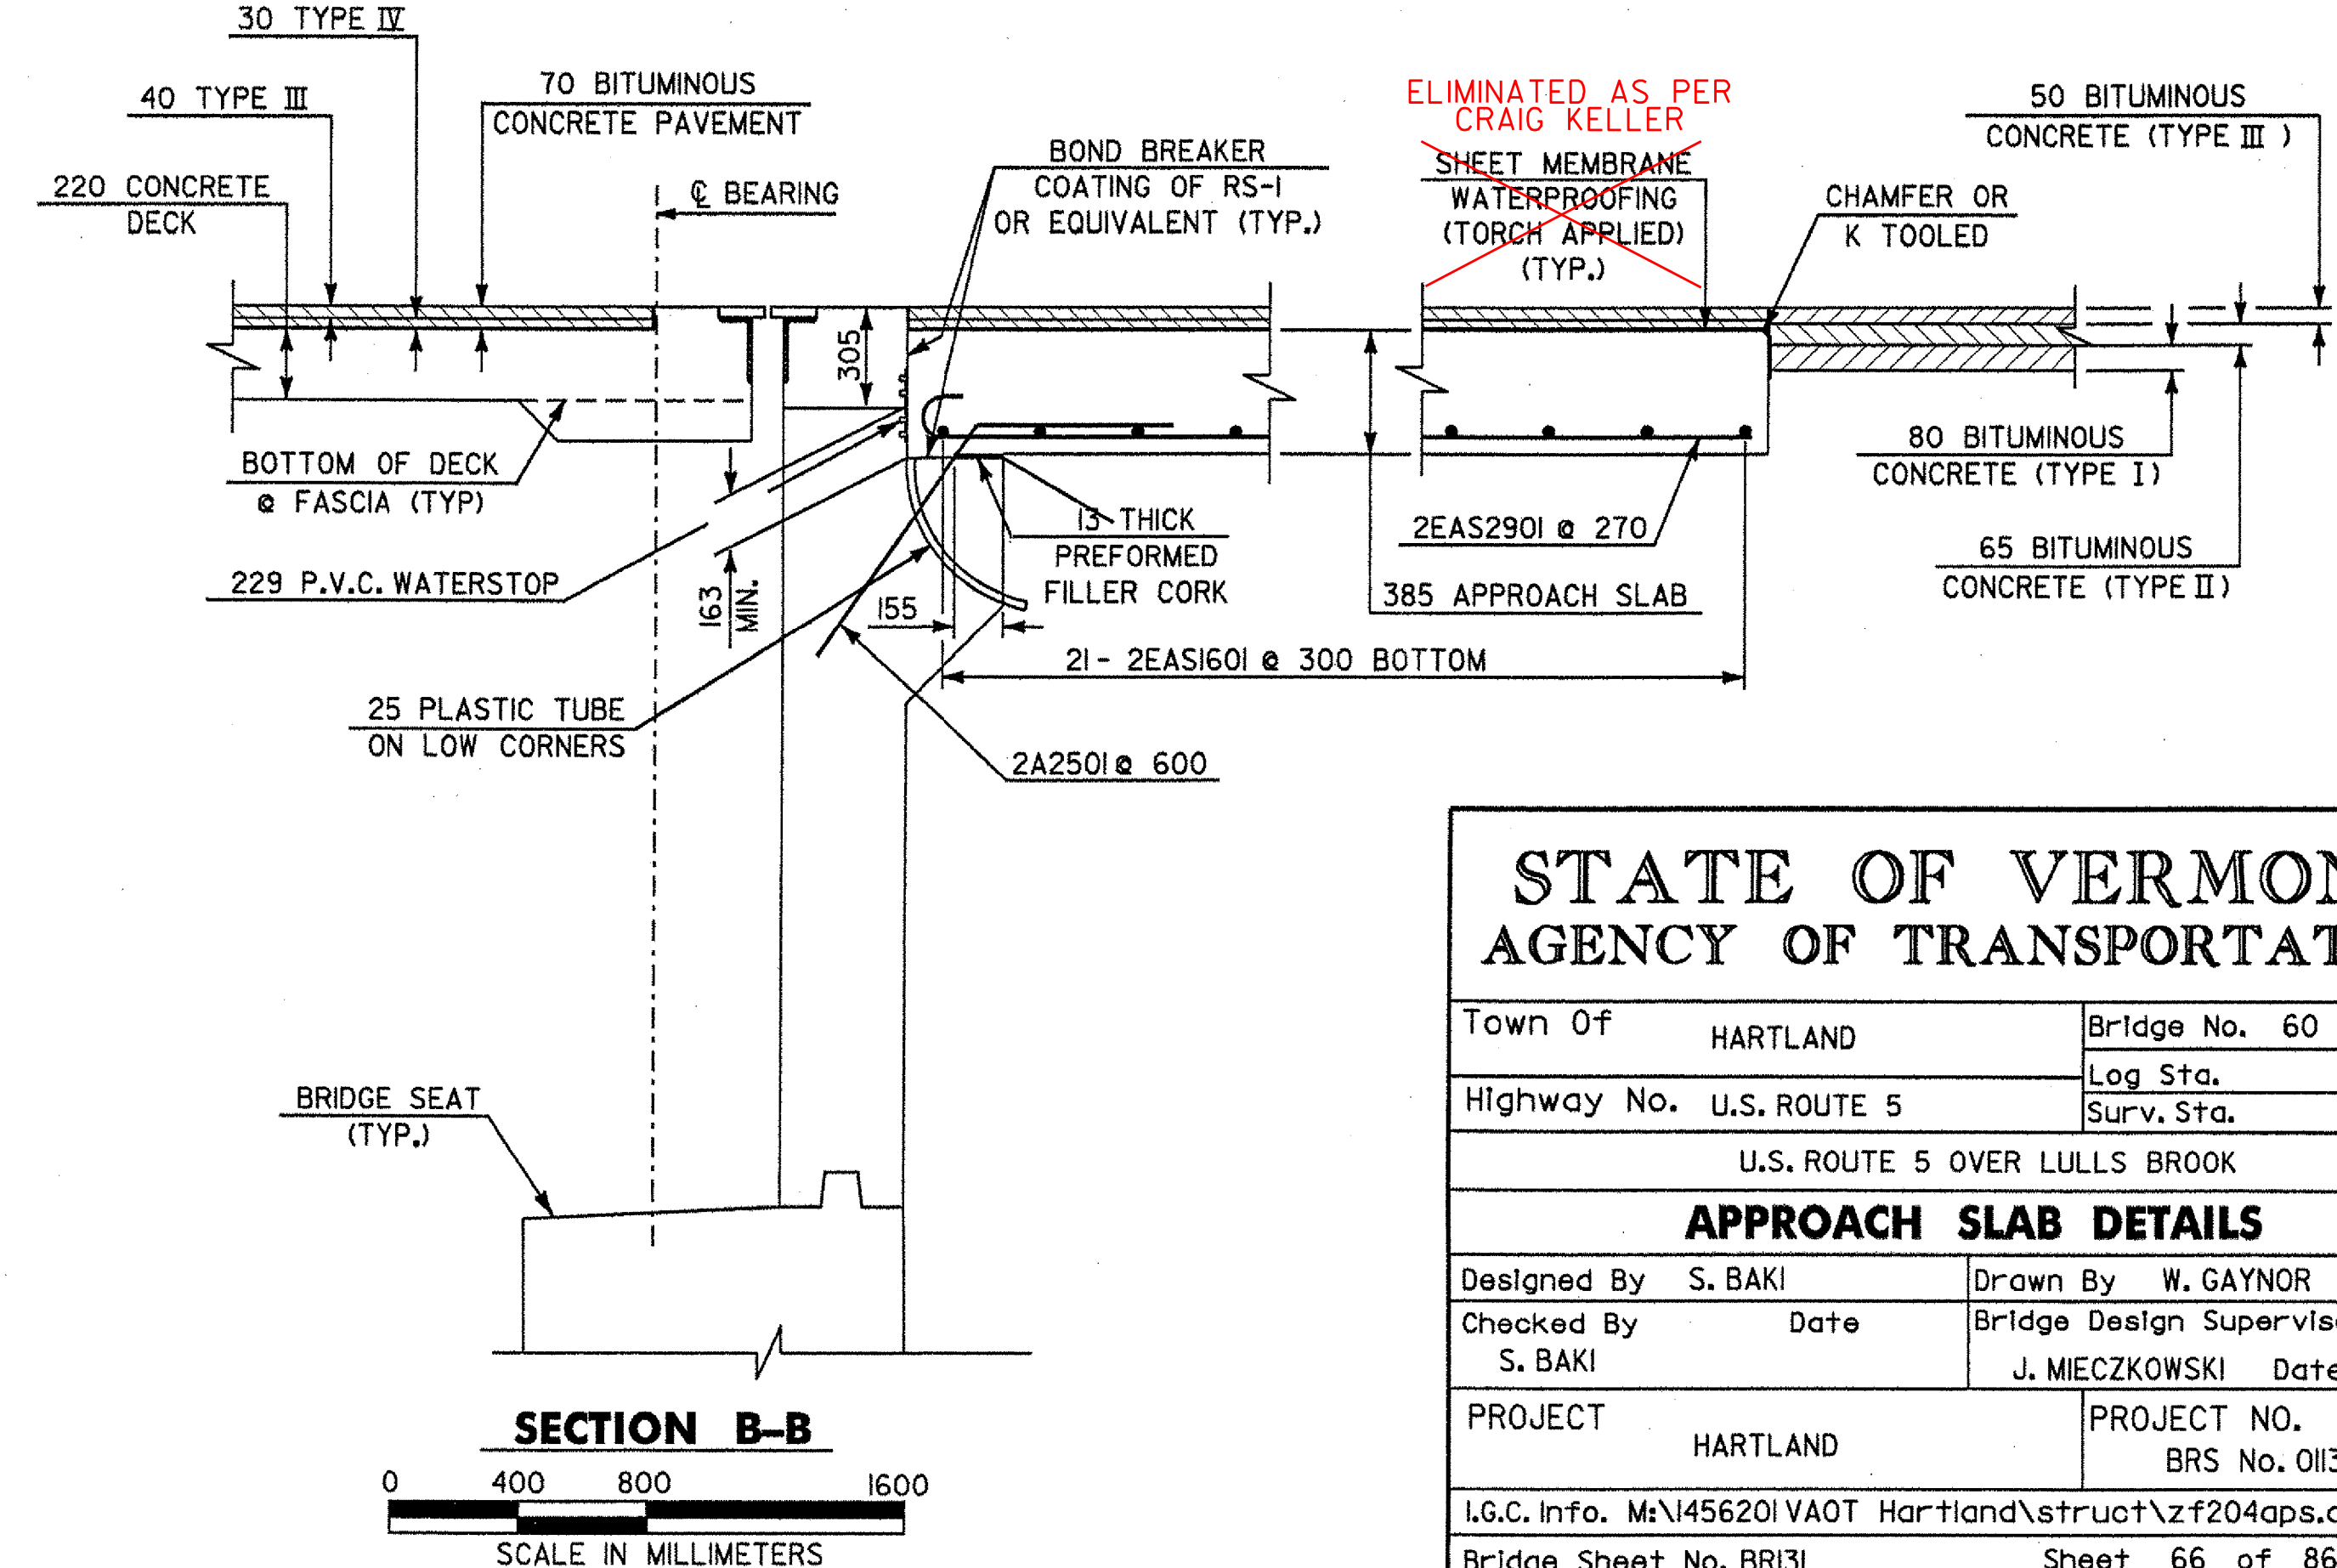

APPROACH SLAB NO. 2 PLAN
0 1000 2000 4000
SCALE IN MILLIMETERS

NOTES:
REINFORCING COVER 80 ON ALL FACES.
▲ - CUT TO FIT IN FIELD.

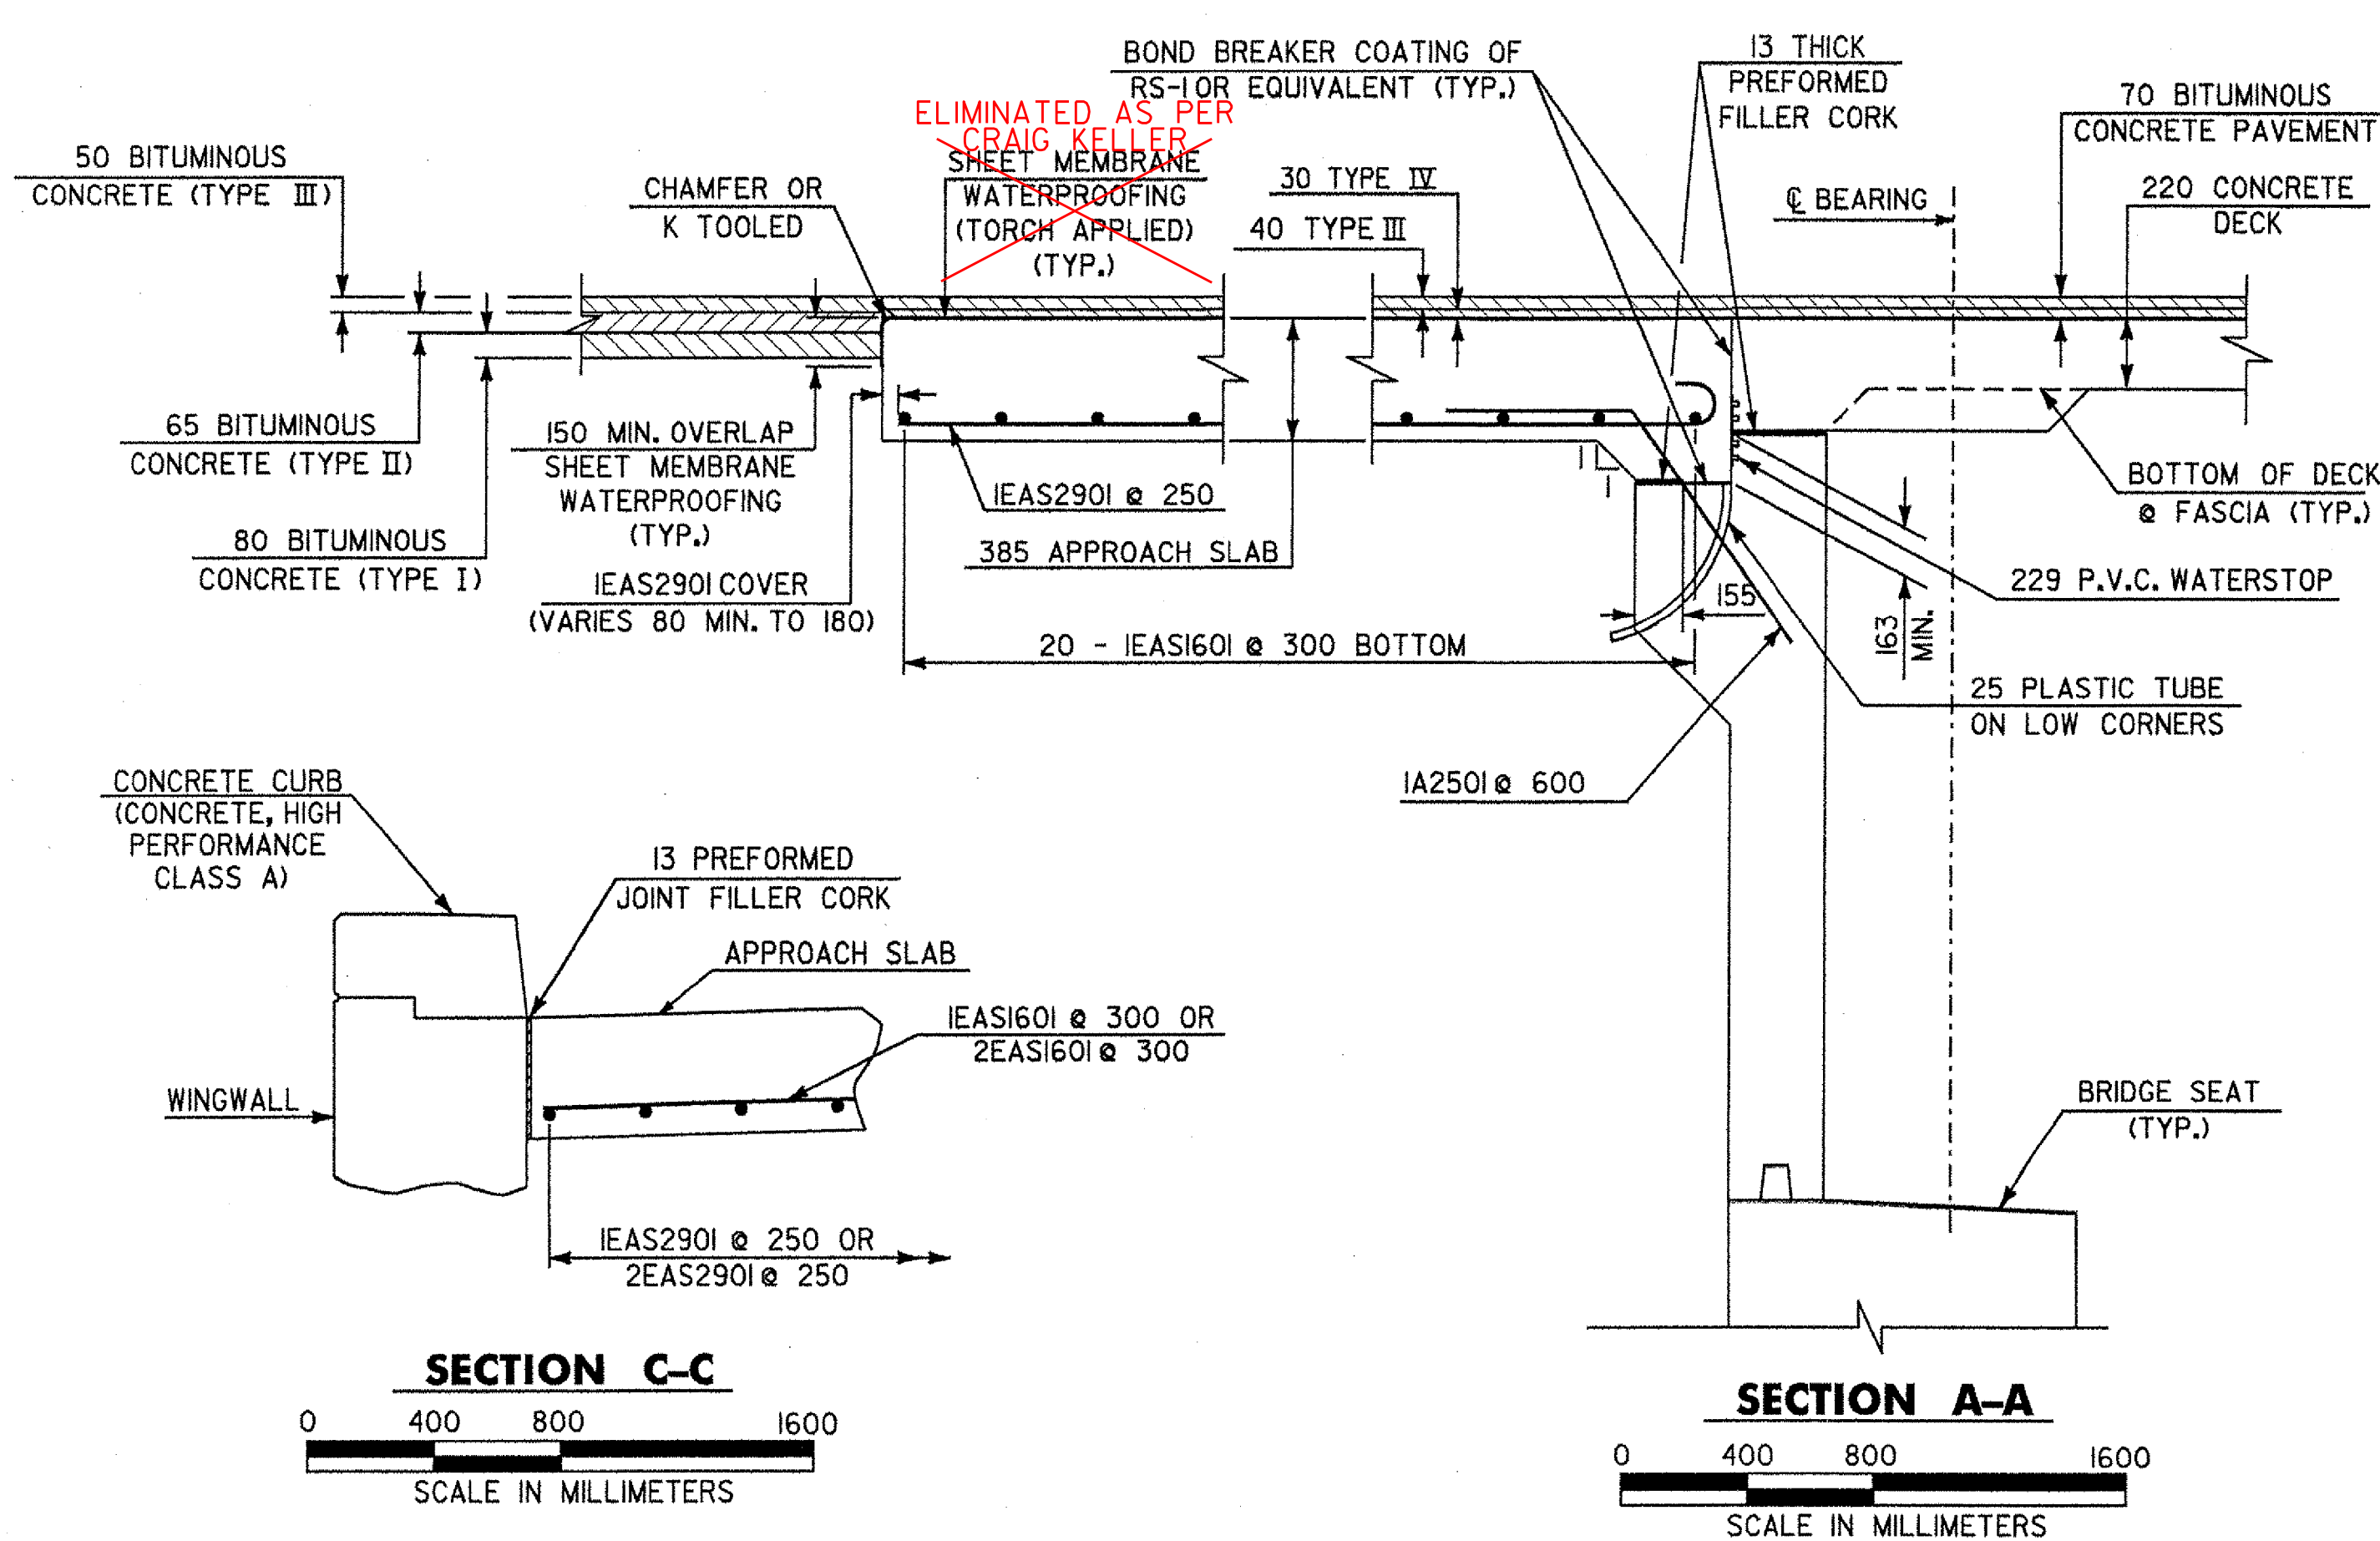

STATE OF VERMONT AGENCY OF TRANSPORTATION			
Town Of	HARTLAND	Bridge No.	60
Highway No.	U.S. ROUTE 5	Log Sta.	
		Surv. Sta.	
U.S. ROUTE 5 OVER LULLS BROOK			
APPROACH SLAB DETAILS			
Designed By	S. BAKI	Drawn By	W. GAYNOR
Checked By	S. BAKI	Date	
		Bridge Design Supervisor	J. MIECZKOWSKI
PROJECT	HARTLAND	PROJECT NO.	BRS No. 0113(22)
I.G.C. Info. M:\456201\VAOT Hartland\struct\zf204aps.dgn			
Bridge Sheet No. BR131		Sheet 66 of 86	