


1+040

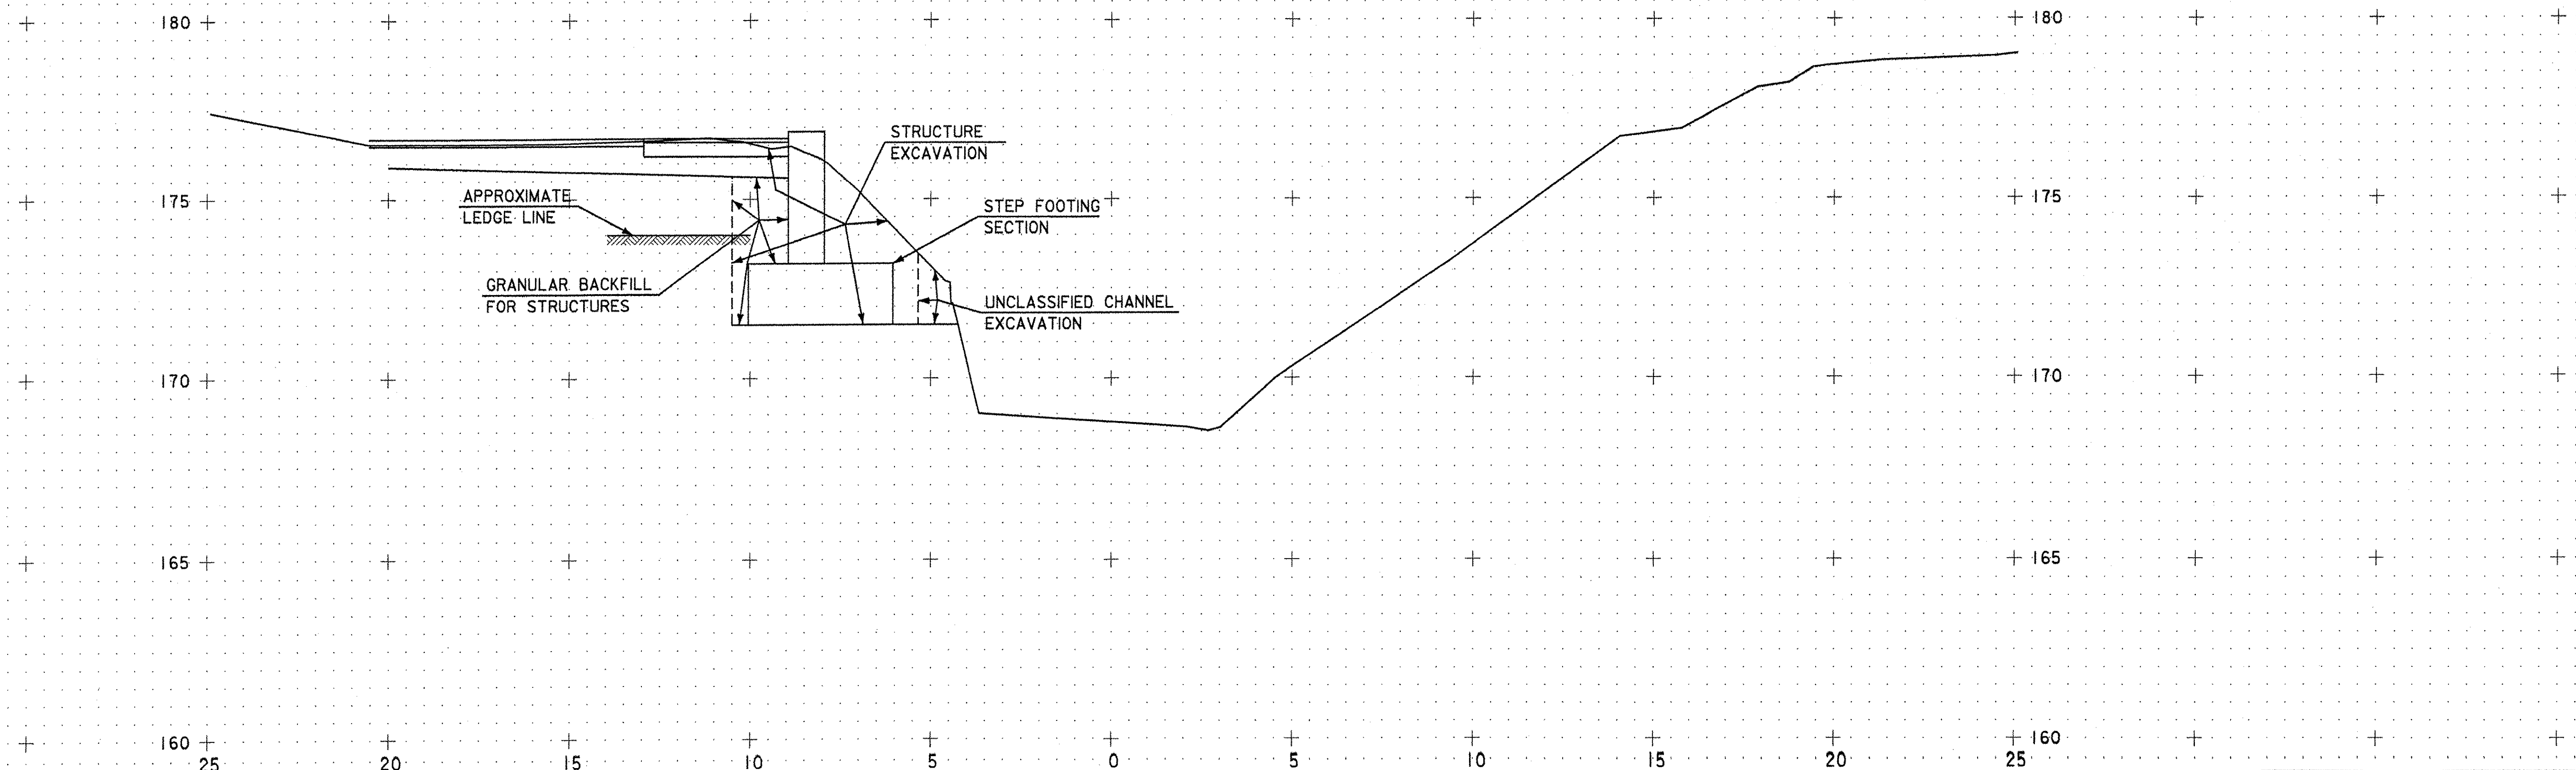

1+030

CHANNEL SECTIONS

FROM STA. 1+030 TO STA. 1+040
 PROJECT NAME: U.S. ROUTE 5 OVER LULLS BROOK
 PROJECT NO. BRS 0113 (22)
 PLOTTED BY: CJM 5/11/95 CHECKED BY: SAB 5/11/95
 SHEET 72 OF 86 SHEETS

SCALE 1" = 1m