


I+080

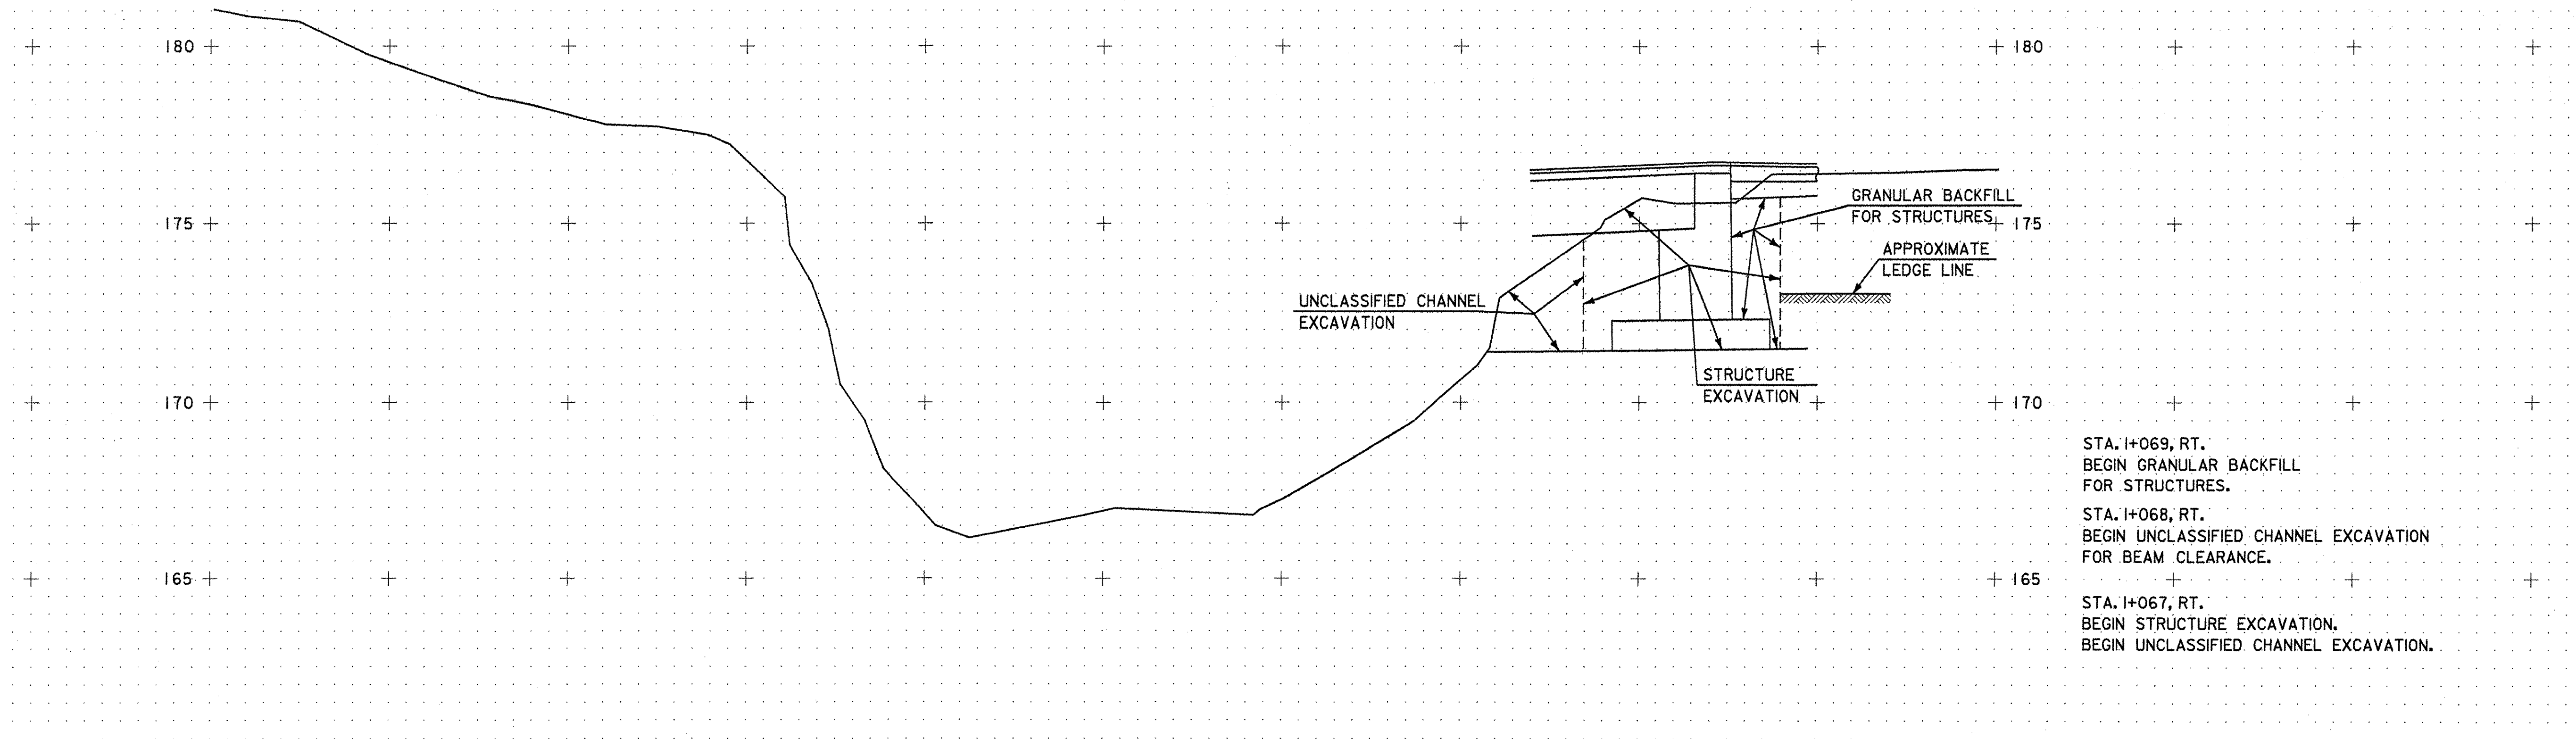

I+070

STA. I+069, RT.  
 BEGIN GRANULAR BACKFILL  
 FOR STRUCTURES.  
 STA. I+068, RT.  
 BEGIN UNCLASSIFIED CHANNEL EXCAVATION  
 FOR BEAM CLEARANCE.  
 STA. I+067, RT.  
 BEGIN STRUCTURE EXCAVATION.  
 BEGIN UNCLASSIFIED CHANNEL EXCAVATION.

**CHANNEL SECTIONS**

FROM STA. I+070 TO STA. I+080  
 PROJECT NAME: U.S. ROUTE 5 OVER LULLS BROOK  
 PROJECT NO. BRS 013 (22)  
 PLOTTED BY: CJM 5/11/95 CHECKED BY: SAB 5/11/95  
 SHEET 74 OF 86 SHEETS

SCALE 1m