
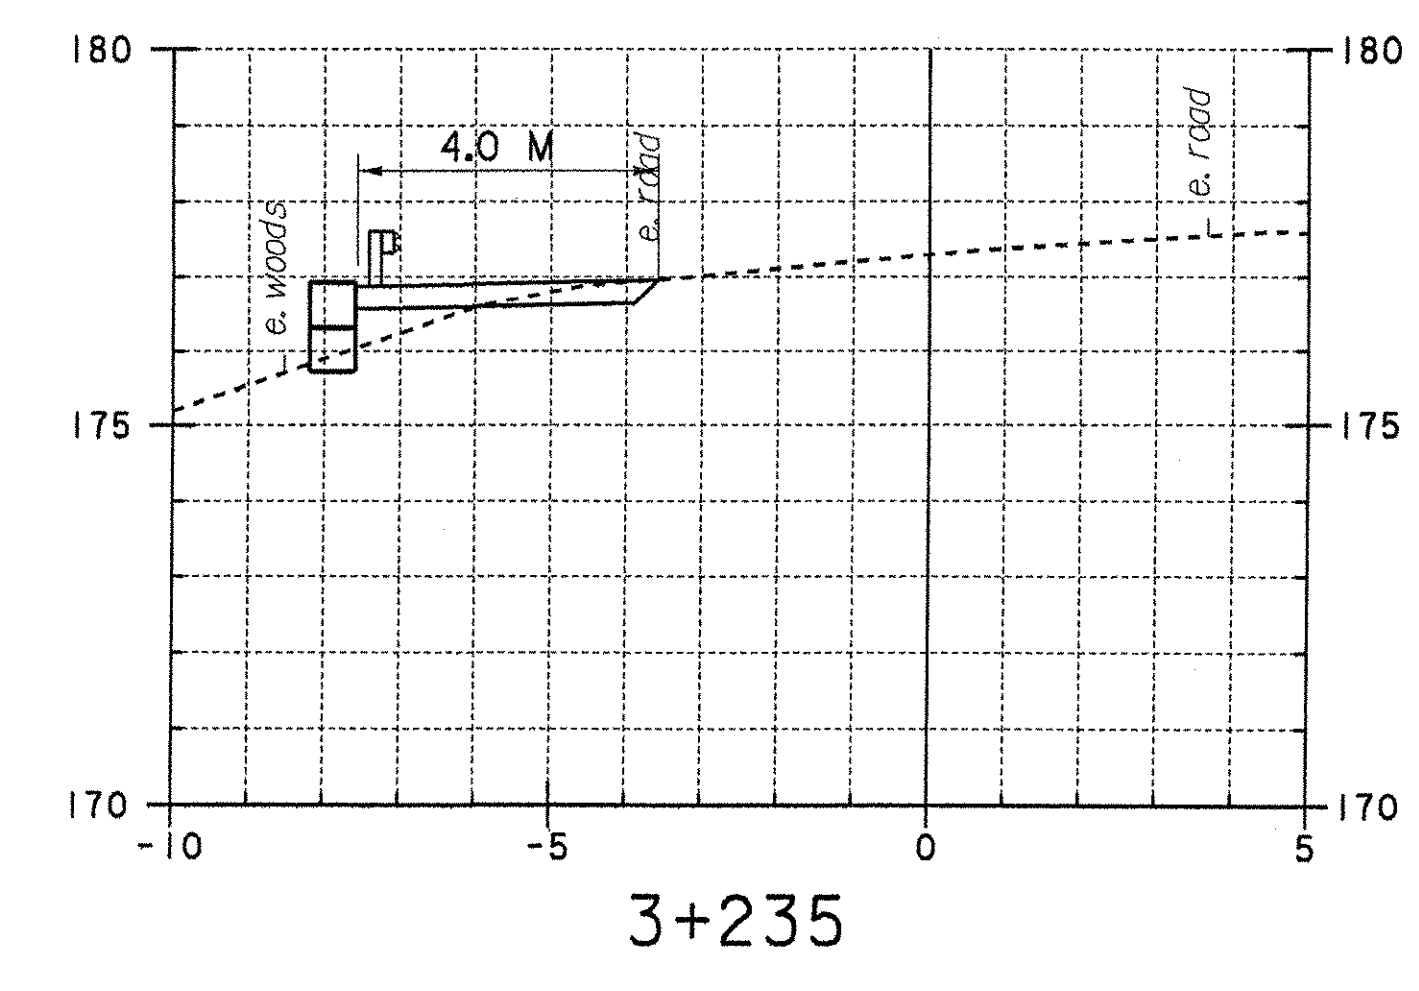
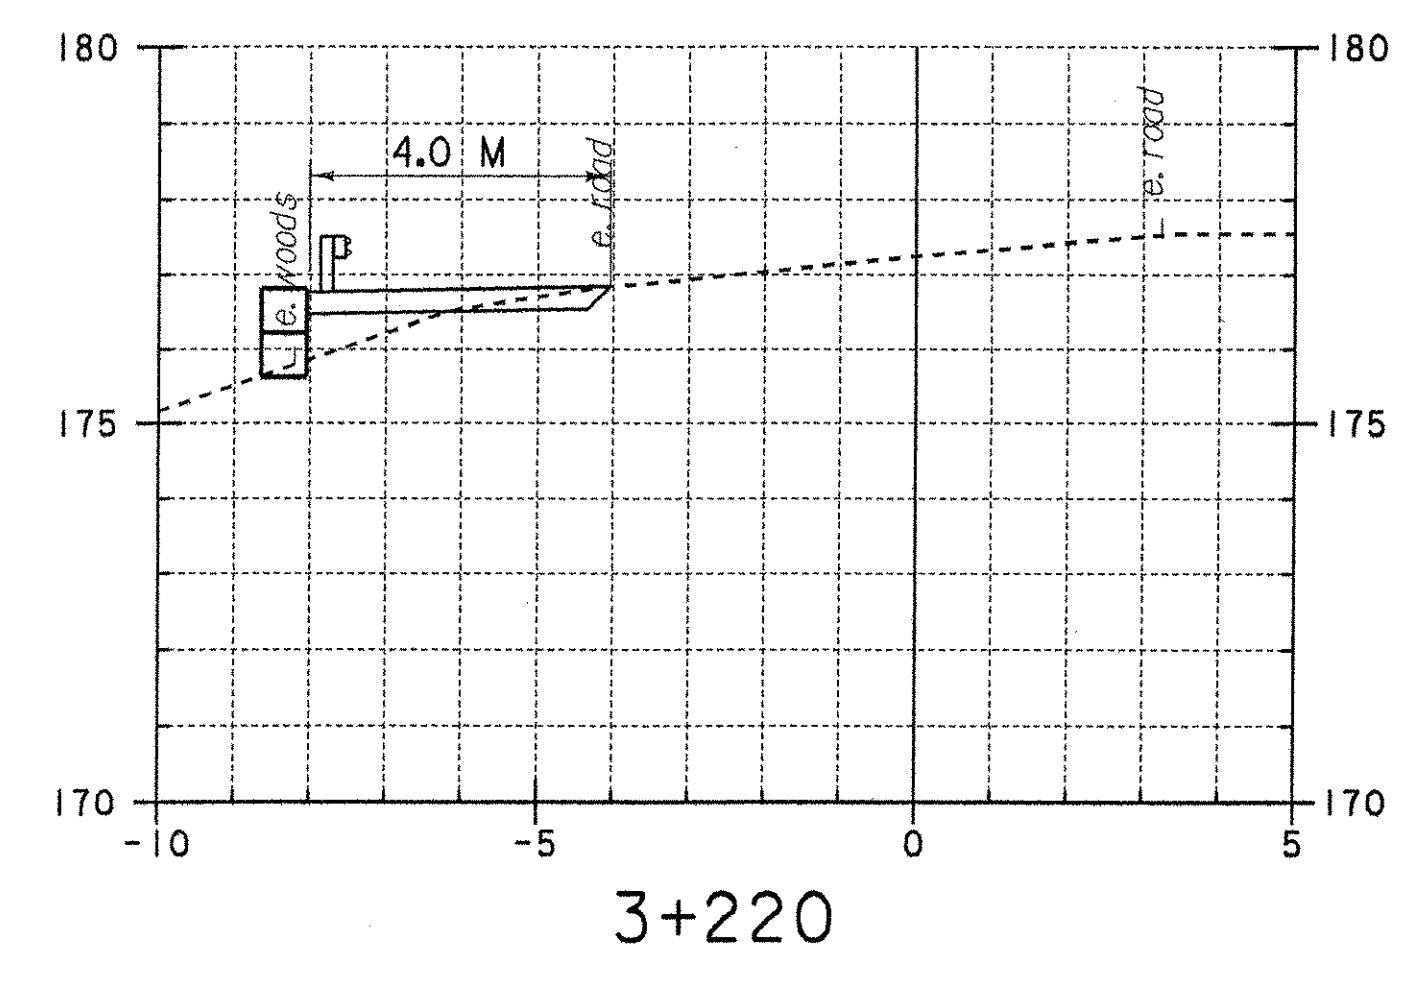


3+210 End Guardrail & Sidewalk Left
3+206 Begin Precast Concrete Block Wall
3+209 Begin Guardrail for Parking Area

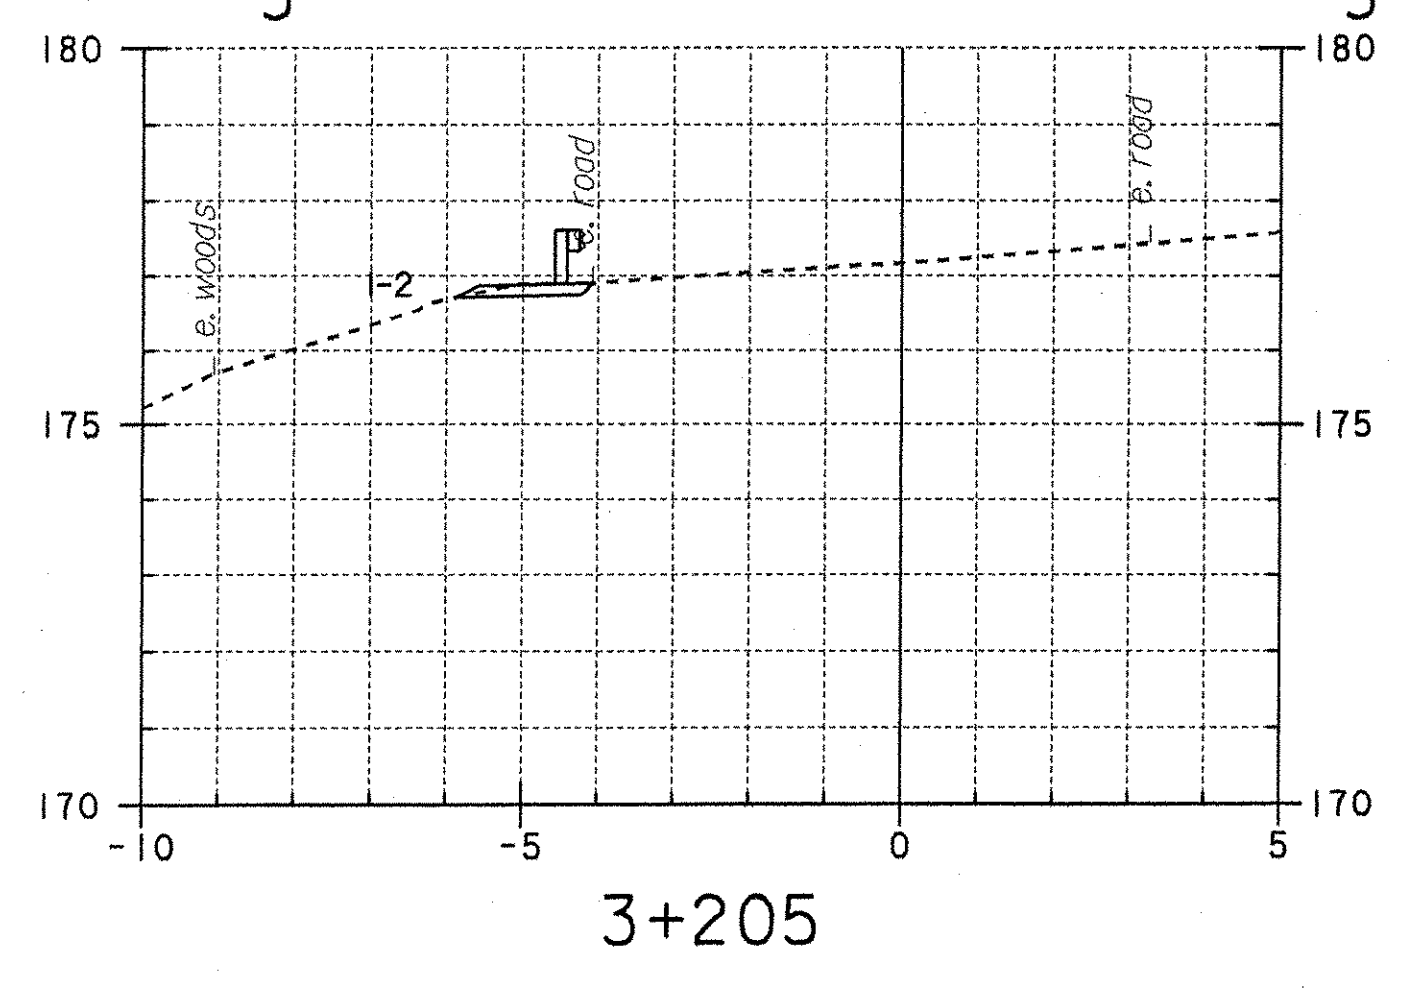

Temporary Sidewalk & Retaining Wall Sections

PROJECT NAME:	Hartland
PROJECT NUMBER:	BRS 0113 (22)
FILE NAME:	/str5/78f204/sf204park.dgn
PROJECT LEADER:	C. Keller
DESIGNED BY:	G. Shangraw
PLOT DATE:	17-AUG-2004
DRAWN BY:	G. Shangraw
CHECKED BY:	
SHEET	86 OF 86