
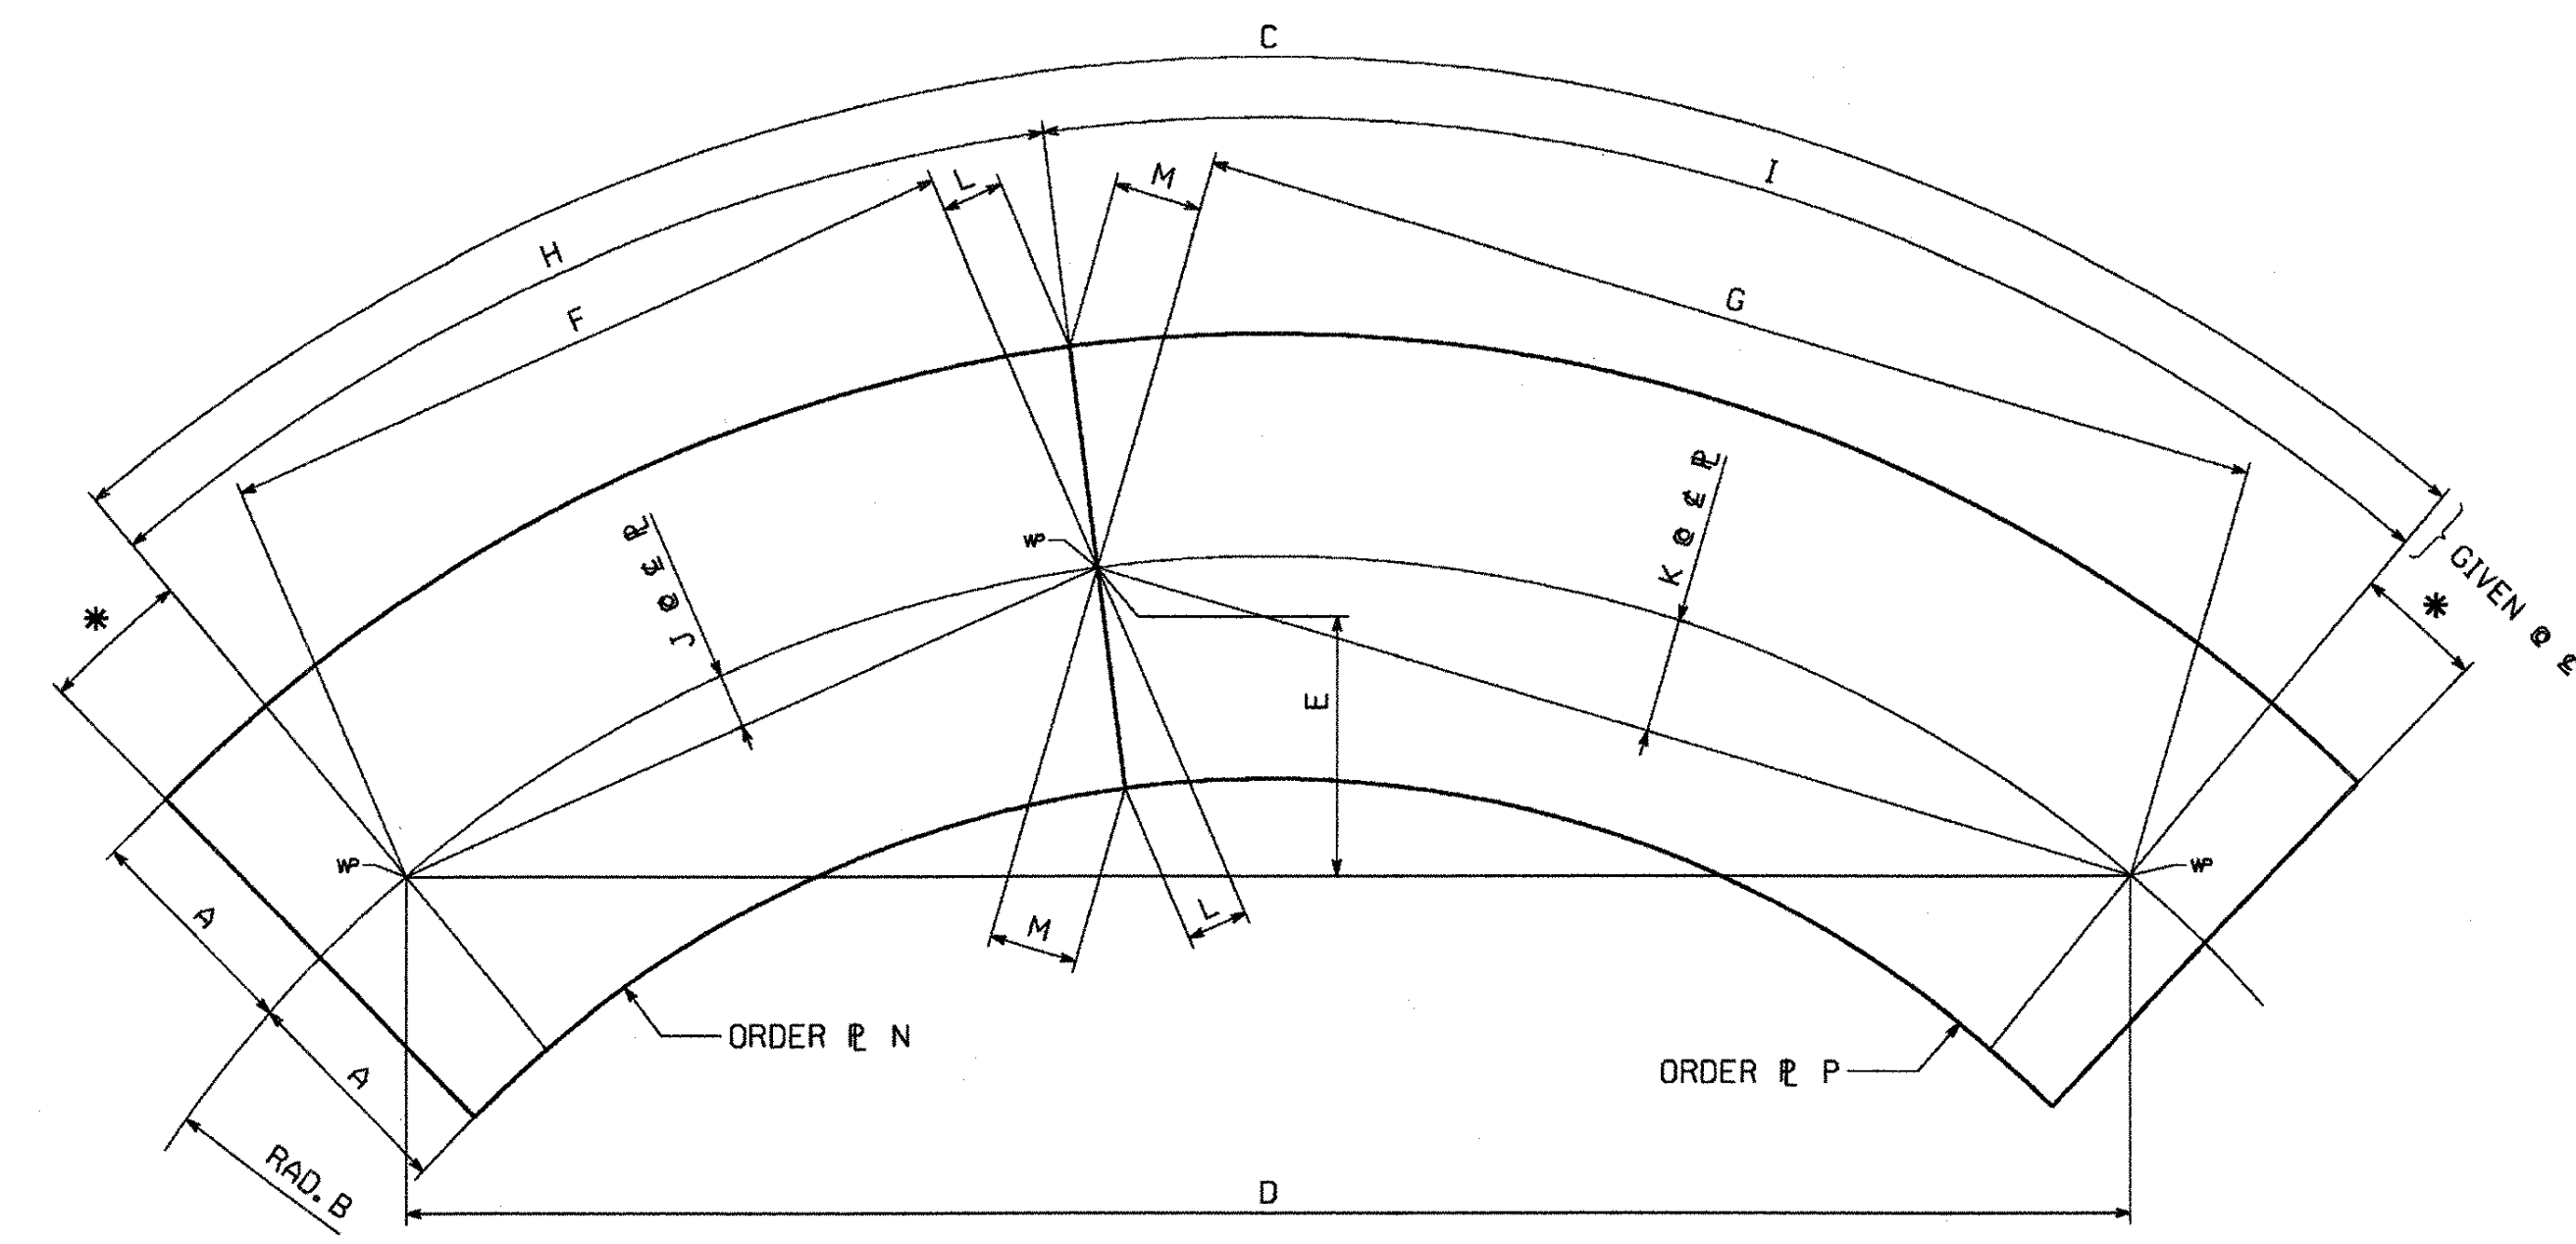


METRIC

1. ALL DIMENSIONS ARE IN MILLIMETERS UNLESS OTHERWISE NOTED.
2. ALL WEIGHTS ARE IN KILOGRAMS.

FED. ROAD DIV. NO.	STATE	FED. AID PROJ. NO.
	VT	

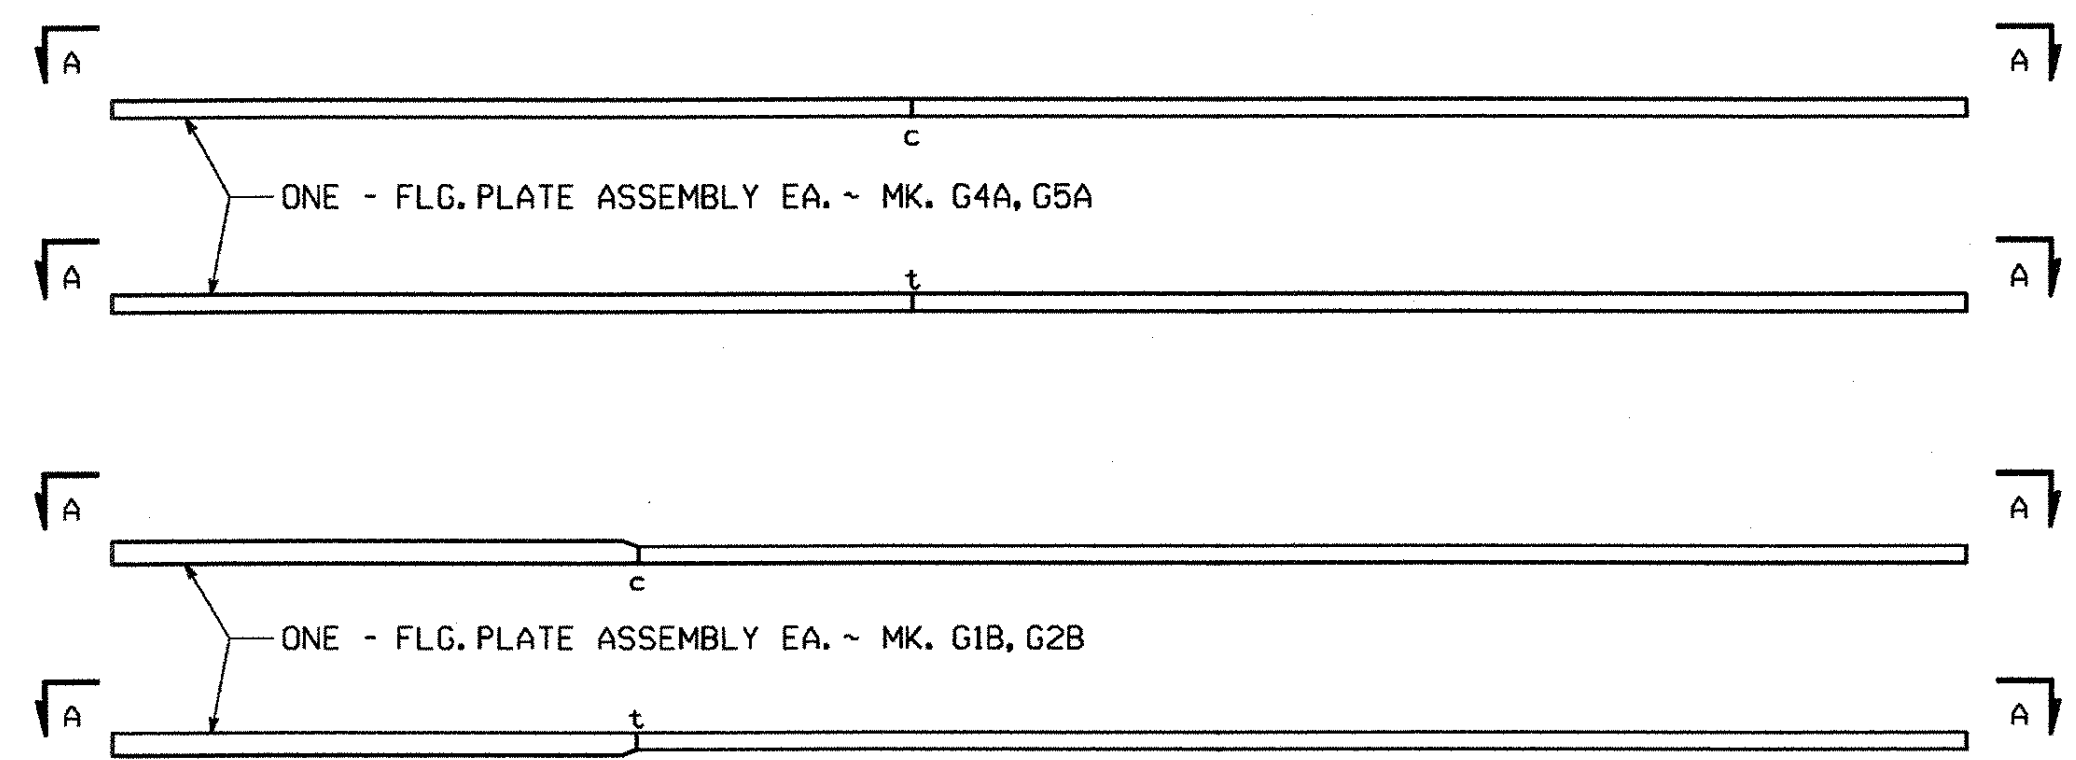

VIEW A-A

MARK	FLANGE	A	B	C	D	E	F	G	H	I	J	K	L	M	N	P
G4A	TOP	205	97 485	33 471	33 307	1421	15 215	18 215	15 230	18 241	297	426	16	19	22 x 410 x 15 280 (4/32)	22 x 410 x 18 280 (4/28)
G5A	TOP	205	94 970	33 556	33 382	1466	15 214	18 298	15 230	18 326	305	442	16	20	22 x 410 x 15 280 (4/31)	22 x 410 x 18 360 (4/26)
G4A	BOTT.	205	97 485	33 460	33 296	1421	15 215	18 204	15 230	18 230	297	426	16	19	22 x 410 x 15 280 (T) (4/30)	22 x 410 x 18 280 (T) (4/27)
G5A	BOTT.	205	94 970	33 548	33 374	1465	15 214	18 290	15 230	18 318	305	441	16	20	22 x 410 x 15 280 (T) (4/29)	22 x 410 x 18 360 (T) (4/25)
G1B	TOP	305	105 030	11 230	11 225	126	3360	7868	3360	7870	13	74	5	11	45 x 610 x 3400 (4/8)	32 x 610 x 7920 (4/10)
G2B	TOP	305	102 515	10 326	10 322	113	3286	7039	3286	7040	13	60	5	10	45 x 610 x 3400 (4/8)	32 x 610 x 7080 (4/12)
G1B	BOTT.	305	105 030	11 211	11 206	125	3341	7868	3341	7870	13	74	5	11	65 x 610 x 3380 (T) (4/4)	32 x 610 x 7920 (T) (4/9)
G2B	BOTT.	305	102 515	10 309	10 305	112	3269	7039	3269	7040	13	60	5	10	65 x 610 x 3380 (T) (4/4)	32 x 610 x 7080 (T) (4/11)

Reviewed
 Rejected
 Furnish as Contracted
 Revise and Resubmit
 Submit Specified Item

This review is only for general conformance with the design concept and the information given in the Construction Documents. Corrections or comments made on the shop drawings during this review do not relieve the contractor from compliance with the requirements of the plans and specifications. Review of a specific item shall not include review of an assembly of which the item is a component. The Contractor is responsible for dimensions to be confirmed and corrected as the process information that pertains solely to the fabrication process or to the means, methods, techniques, sequences and procedures of construction; coordination of the Work with that of all other trades and performing all work in a safe and satisfactory manner.

McFarland-Johnson, Inc.
 Date: 6/15/05
 By: [Signature]

VTrans
RECEIVED
 OK'D BY: [Signature] OK'D BY: [Signature]
 JUN 03 2005
 RESUBMIT: _____ APPROVED: _____
 BY: _____ DATE: _____

NOTES:
 FOR WELDING DETAILS, SEE DWG. FS1.
 FOR OTHER NOTES, SEE DWG. FS1.

△			
△			
△	CAMBER DESIGN CHANGE	MGK	4-26-05
NO.	REVISION	BY	DATE
1170 Hempstead Road Lancaster, PA 17605-0008 Phone 717/299-5211 HIGH STEEL STRUCTURES, INC. A Division of High Industries, Inc.			
FLANGE SPLICE DETAILS U.S. RTE. 5 (BRIDGE #60) OVER LULLS BROOK U.S. RTE. 5 STA. 3+080.77 TO STA. 3+123.110 TOWN OF HARTLAND WINDSOR COUNTY, VERMONT STATE OF VERMONT, AGENCY OF TRANSPORTATION			
STATE CONTRACT OR REF. NO. PROJECT NO. BRS-01131221			
CONTRACTOR: MILLER CONSTRUCTION, INC.			
IN CHARGE: GLIDDEN (IH) MADE BY: DB72 CHK'D BY: MGK DATE: 4/15/05			
CONTRACT NUMBER: VT-05017-1		DRAWING NUMBER: FS2 OF FS3	

CODE: 30

11055

PLOTTED: 4/28/2005 9:58:41 AM
 BH: mh-rev0d1