
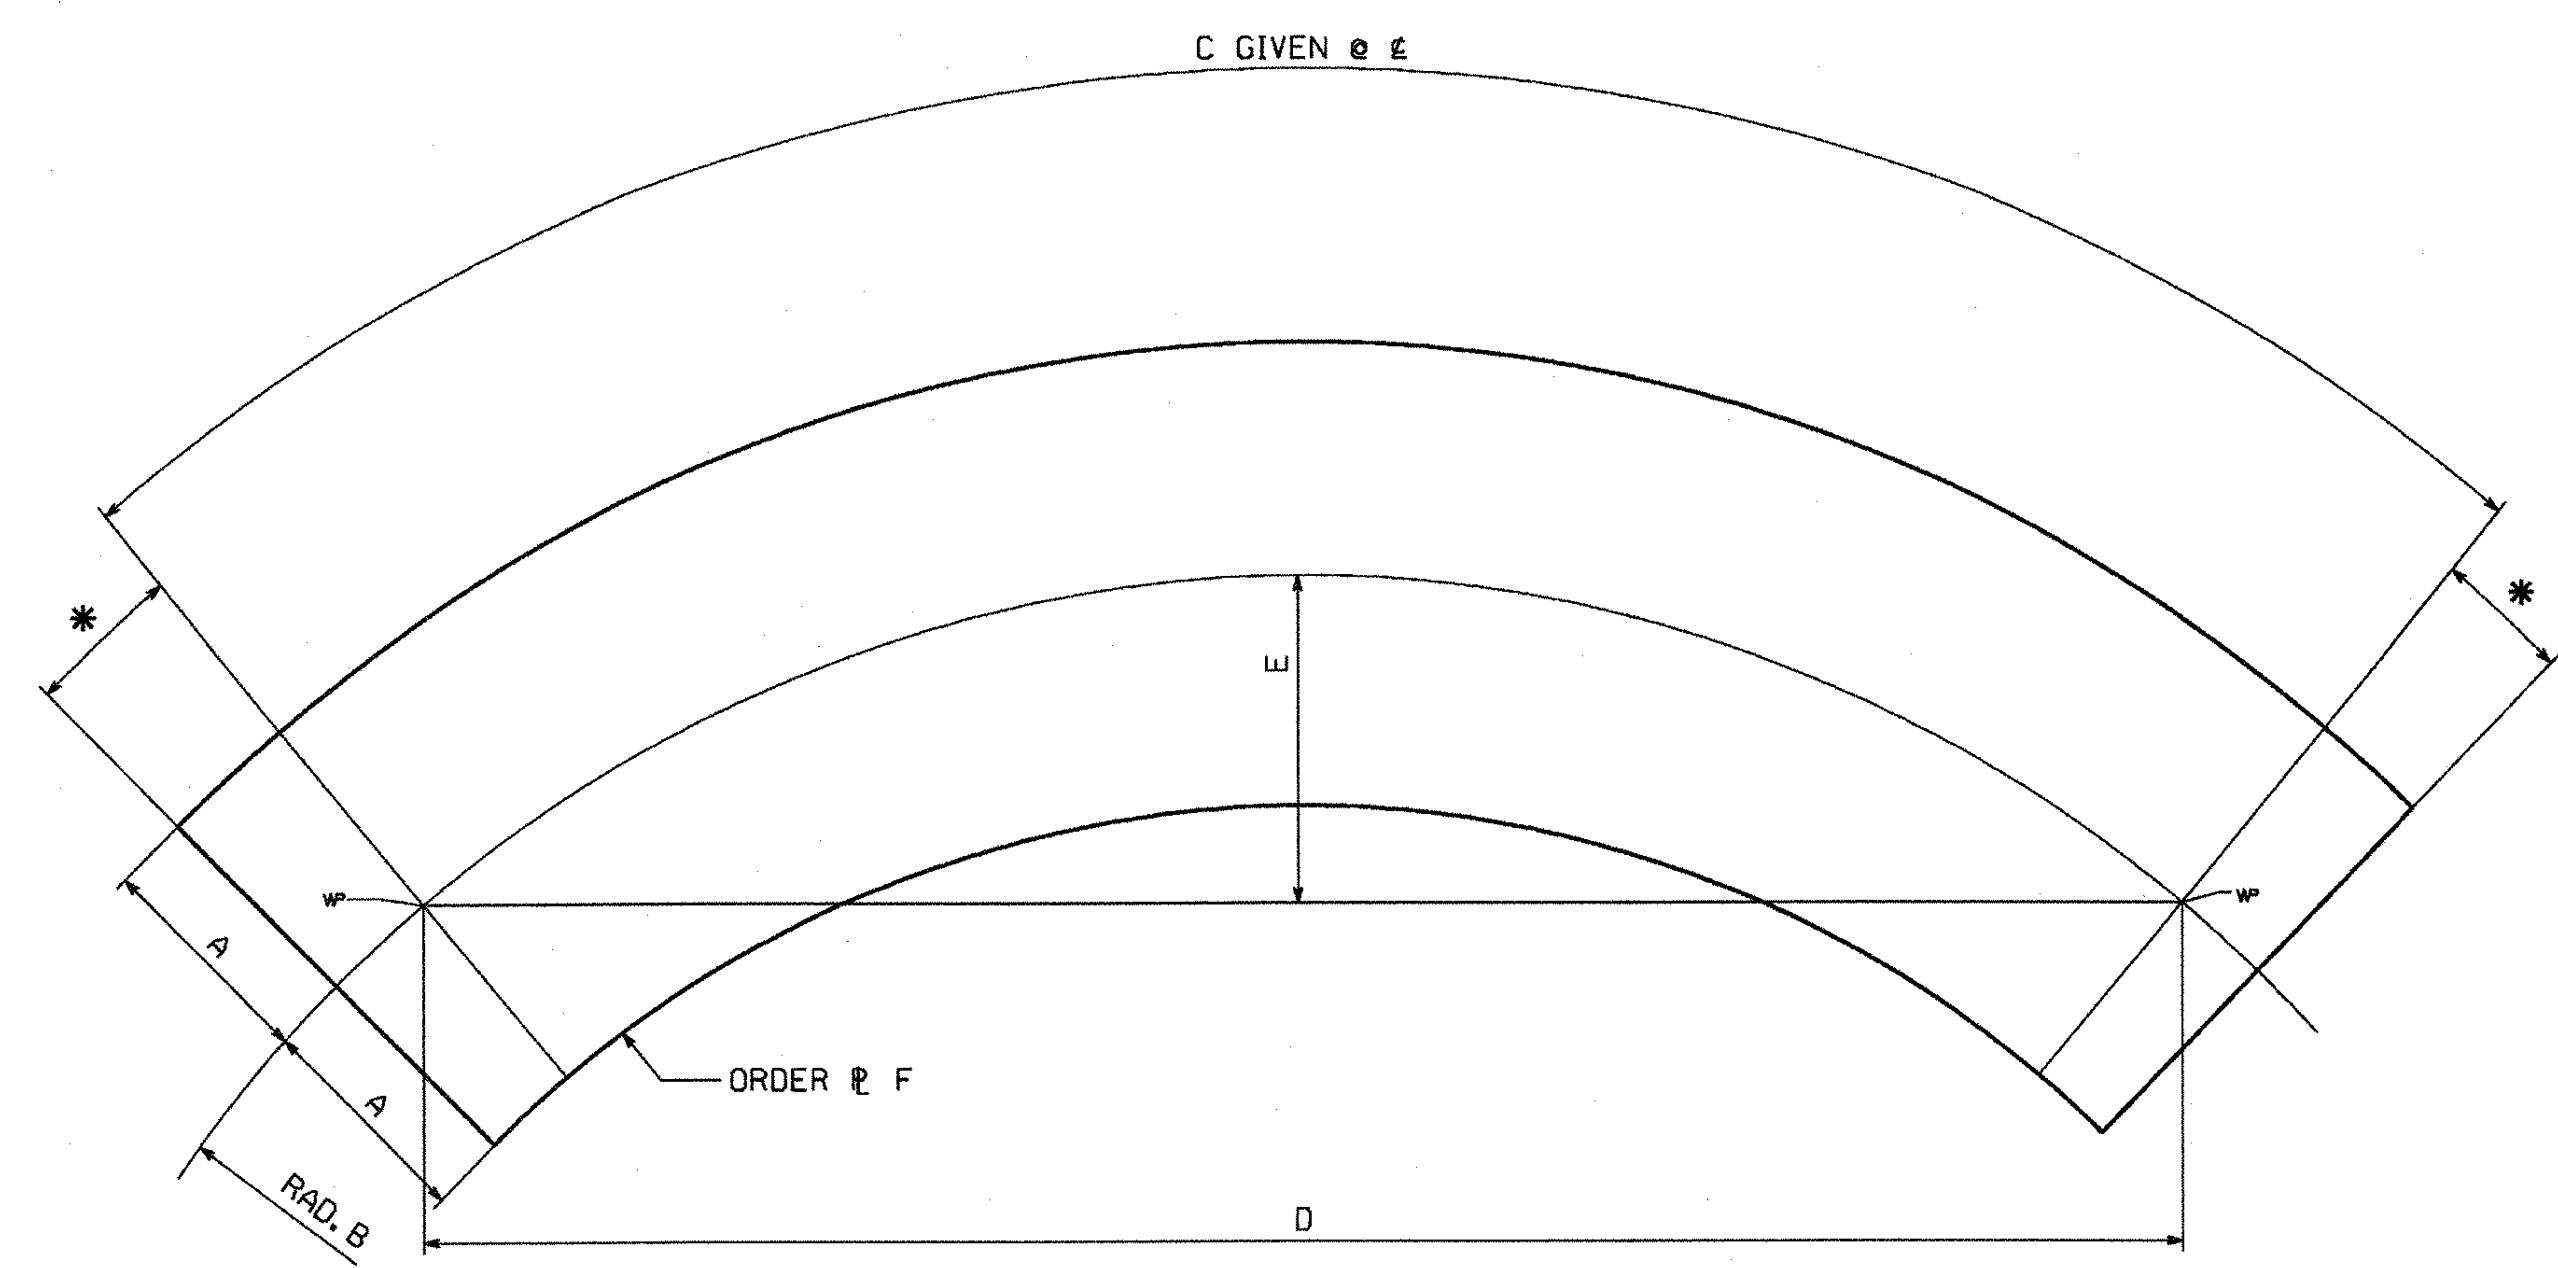


METRIC


1. ALL DIMENSIONS ARE IN MILLIMETERS UNLESS OTHERWISE NOTED.  
2. ALL WEIGHTS ARE IN KILOGRAMS.

FED. ROAD DIV. NO.	STATE	FED. AID PROJ. NO.
	VT	

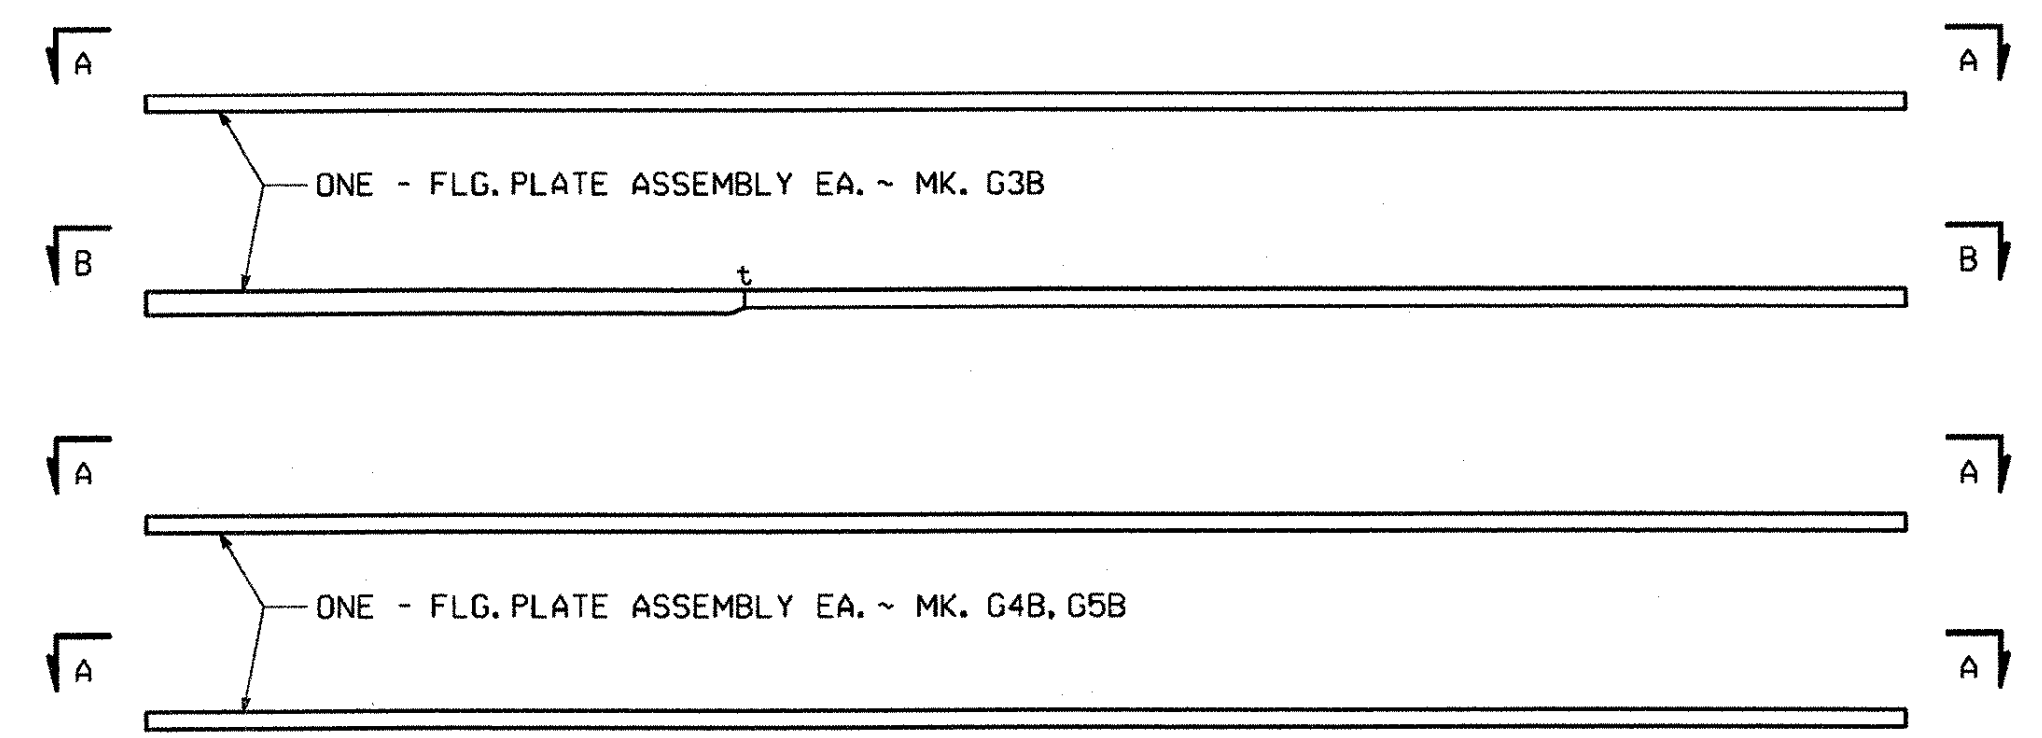

VIEW A-A

MARK	FLANGE	A	B	C	D	E	F
G3B	TOP	230	100 000	9420	9417	111	25 x 460 x 9460 (4/22)
G4B	TOP	205	97 485	8513	8510	93	22 x 410 x 8560 (4/33)
G5B	TOP	205	94 970	7606	7604	76	22 x 410 x 7660 (4/35)
G4B	BOTT.	205	97 485	8501	8498	93	22 x 410 x 8540 (T) (4/34)
G5B	BOTT.	205	94 970	7595	7593	76	22 x 410 x 7640 (T) (4/36)

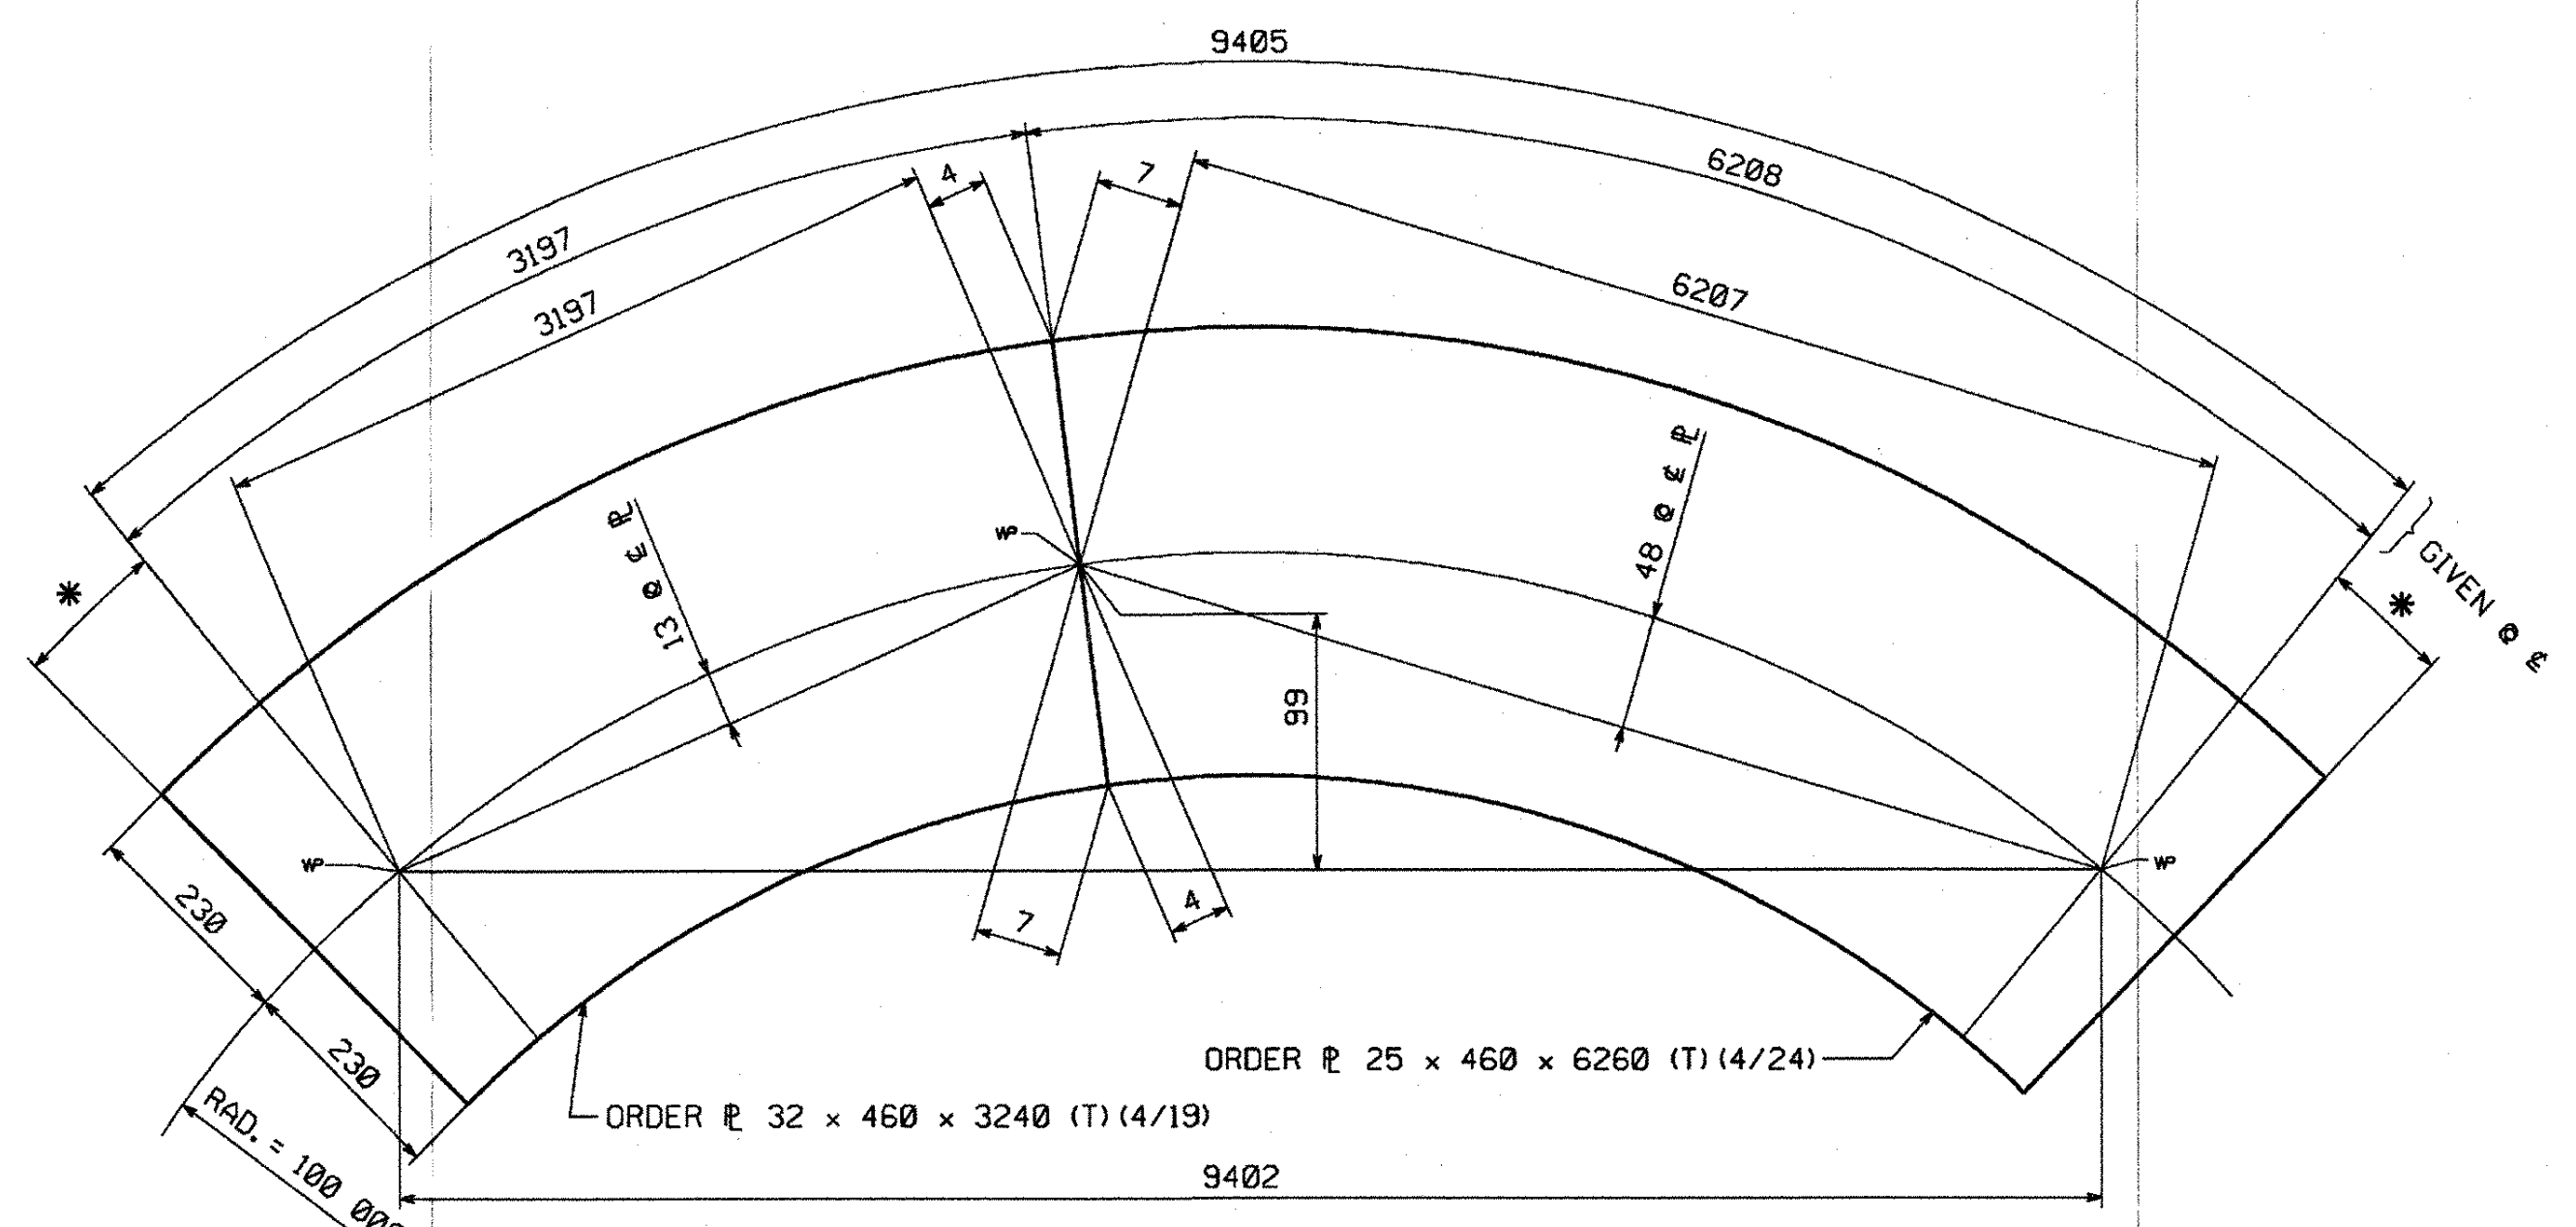

VIEW B-B

RECEIVED  
OK'D BY JWC OK'D BY \_\_\_\_\_  
JUN 03 2005  
RESUBMIT \_\_\_\_\_ APPROVED \_\_\_\_\_  
BY \_\_\_\_\_ DATE \_\_\_\_\_

NOTES:  
FOR WELDING DETAILS, SEE DWG. FS1.  
FOR OTHER NOTES, SEE DWG. FS1.

Reviewed  Rejected   
Furnish as Corrected   
Revise and Resubmit   
Submit Specified Item   
This review is only for general conformance with the design concept and the information given in the Construction Documents. Corrections or comments made on the shop drawings during this review do not relieve the contractor from compliance with the requirements of the plans and specifications. Review of a specific item shall not include review of an assembly of which the item is a component. The Contractor is responsible for dimensions to be confirmed and corrected at the job site. Information that pertains solely to the fabrication process or to the means, methods, techniques, sequences and procedures of construction; coordination of the Work with that of all other trades and performing all work in a safe and satisfactory manner.  
McFarland-Johnson, Inc.  
Date: 6/15/05  
By: EN

△		
△		
△	CAMBER DESIGN CHANGE	MKG 4-26-05
NO.	REVISION	BY DATE
<p><b>HIGH STEEL STRUCTURES, INC.</b> 1770 Hempstead Road Lancaster, PA 17605-0008 Phone 717/299-5211 A Division of High Industries, Inc.</p>		
FLANGE SPLICE DETAILS		
U.S. RTE. 5 (BRIDGE #60) OVER LULLS BROOK		
U.S. RTE. 5 STA. 3+080.77 TO STA. 3+123.110		
TOWN OF HARTLAND		
WINDSOR COUNTY, VERMONT		
STATE OF VERMONT, AGENCY OF TRANSPORTATION		
STATE CONTRACT OR REF. NO.	PROJECT NO. BRS-01131221	
CONTRACTOR: MILLER CONSTRUCTION, INC.		
IN CHARGE: GLIDDEN (IH)	MADE BY: DBZ	CHK'D BY: MKG DATE: 4/15/05
CONTRACT NUMBER: VT-05017-1	DRAWING NUMBER: FS3 OF FS3	

CODE: 30

BY: mkretdd1  
PLOTTED: 4/26/2005 9:28:42 AM