



METRIC

1. ALL DIMENSIONS ARE IN MILLIMETERS UNLESS OTHERWISE NOTED.
2. ALL WEIGHTS ARE IN KILOGRAMS.

FED. ROAD DIV. NO.	STATE	FED. AID PROJ. NO.
	VT	

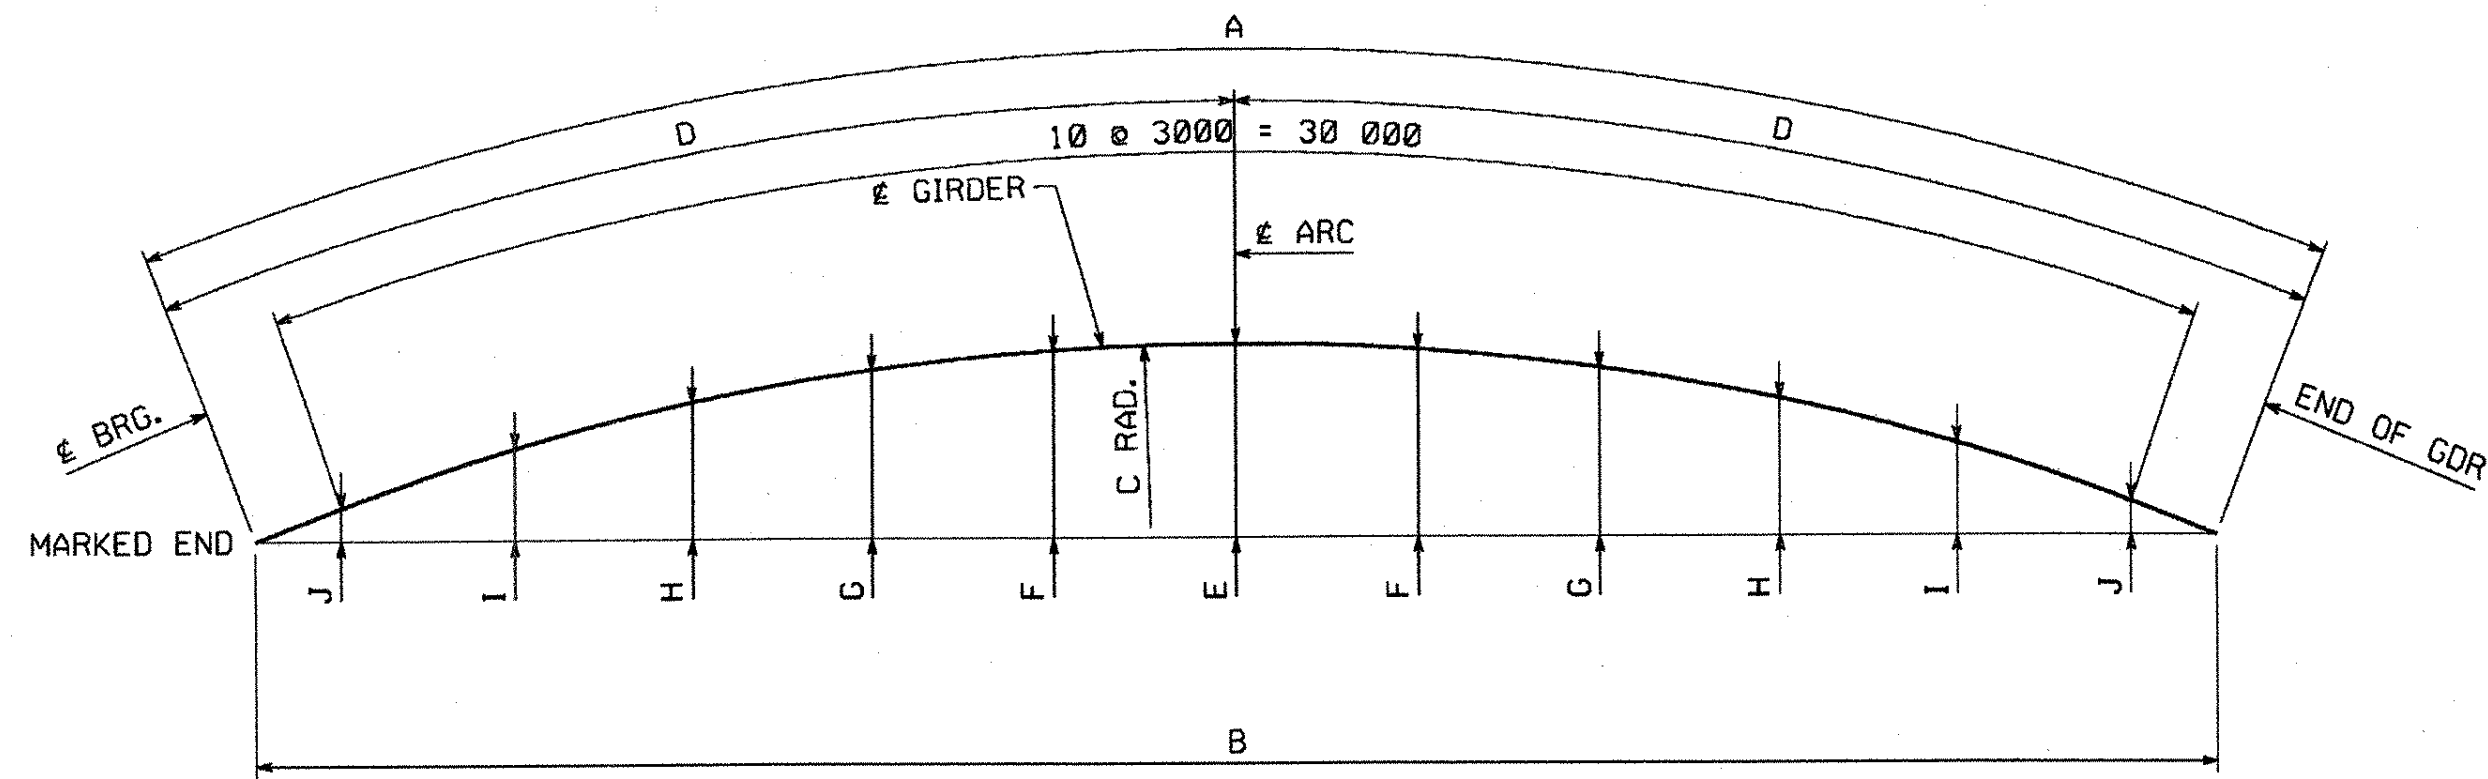

MARK	A	B	C	D	E	F	G	H	I	J
G1A	33 008	32 872	105 030	16 504	1294	1251	1123	909	609	225
G2A	33 082	32 939	102 515	16 541	1332	1288	1156	937	630	236
G3A	33 160	33 008	100 000	16 580	1371	1326	1191	967	652	248
G4A	33 241	33 080	97 485	16 621	1413	1367	1229	998	676	262
G5A	33 326	33 155	94 970	16 663	1458	1411	1269	1032	701	276

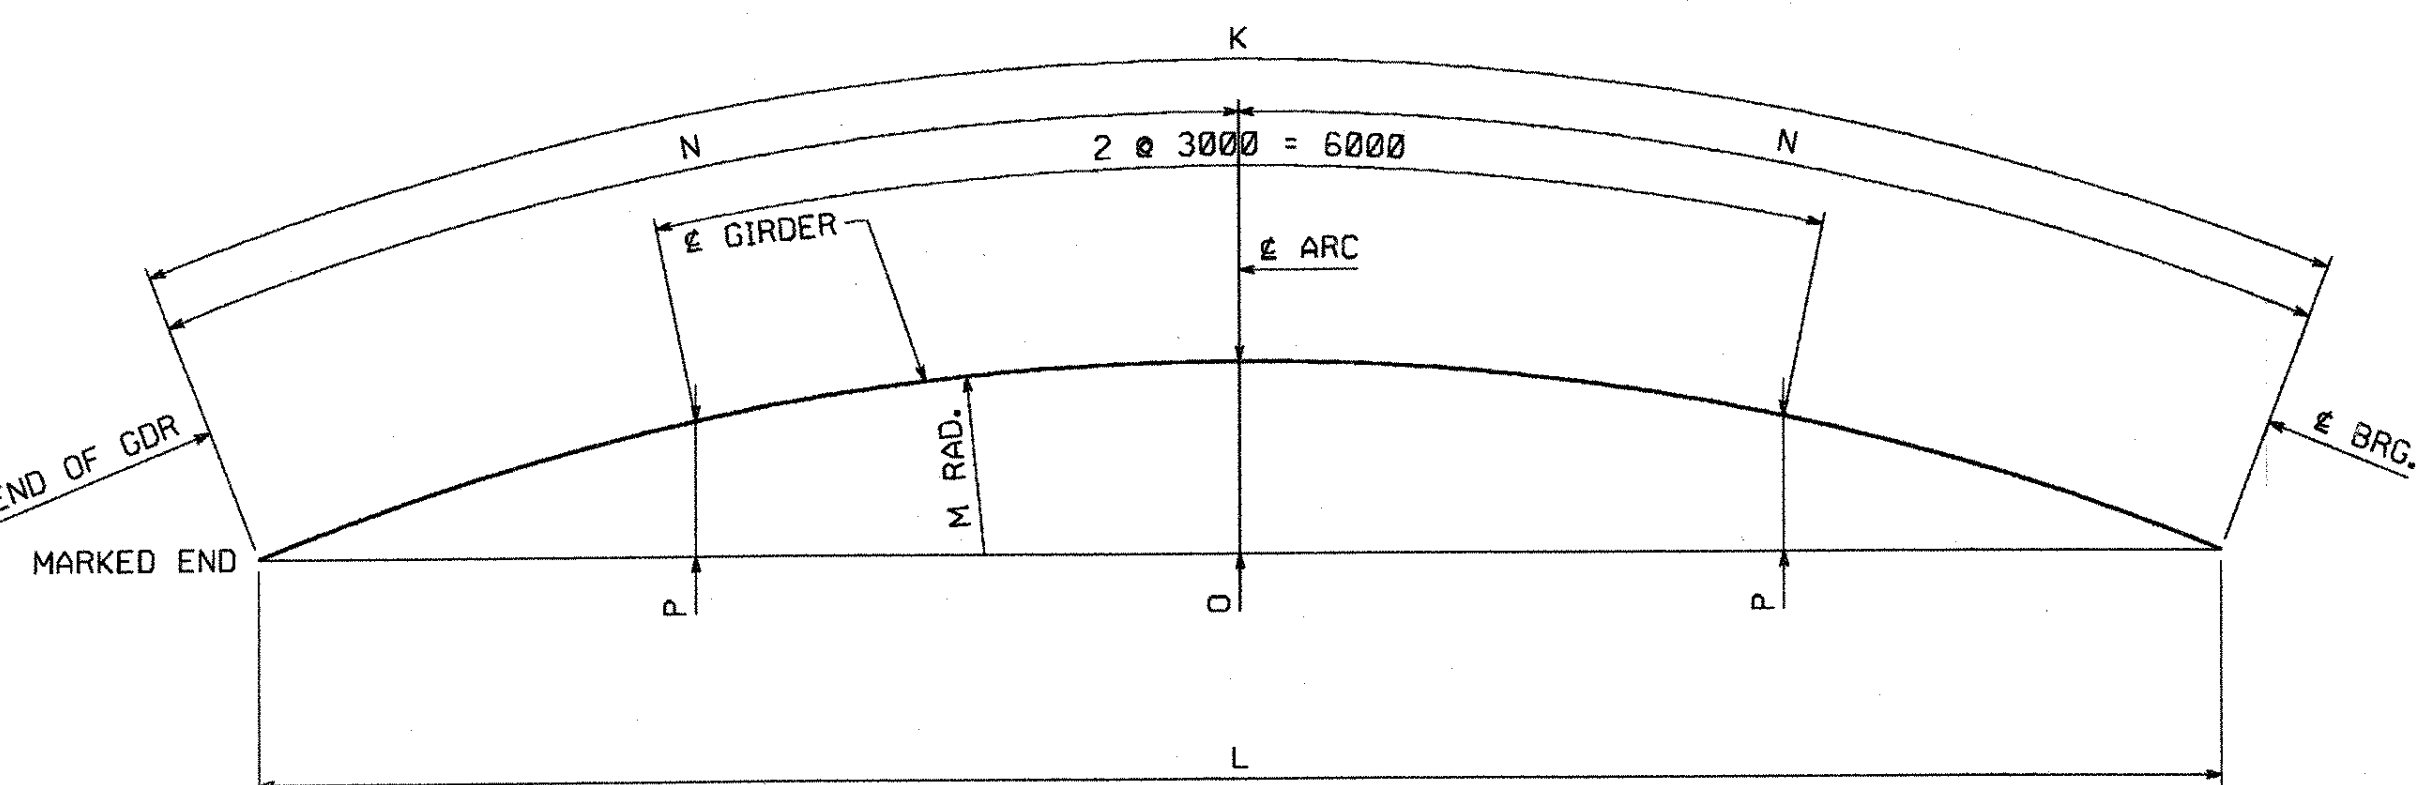

MARK	K	L	M	N	O	P
G1B	11 000	10 995	105 030	5500	144	101
G2B	10 096	10 092	102 515	5048	124	80
G3B	9190	9187	100 000	4595	106	61
G4B	8283	8281	97 485	4142	88	42
G5B	7376	7374	94 970	3688	72	24

NOTES:
ALL DIMENSIONS APPLY AT THE TOP OF WEB PLATE OF THE GIRDERS.

- Reviewed
- Rejected
- Furnish as Corrected
- Revise and Resubmit
- Submit Specified Item

This review is only for general conformance with the design concept and the information given in the Construction Documents. Corrections or omissions made on the shop drawings during this review do not relieve the contractor from compliance with the requirements of the plans and specifications. Review of a specific item shall not include review of an assembly of which the item is a component. The Contractor is responsible for dimensions to be confirmed and corrected at the job site. Information that pertains solely to the fabrication process or to the means, methods, techniques, sequences and procedures of construction; coordination of the Work with that of all other trades and performing all work in a safe and satisfactory manner.

McFarland-Johnson, Inc.
Date: 6/10/05
By: [Signature]

VTrans
RECEIVED
CK'D BY: [Signature] OK'D BY: [Signature]
JUN 03 2005
RESUBMIT: [Signature] APPROVED: [Signature]
BY: [Signature] DATE: [Signature]

△			
△			
△	CAMBER DESIGN CHANGE	WW	4-28-05
NO.	REVISION	BY	DATE

HIGH STEEL STRUCTURES, INC.
1770 Hempstead Road
Lancaster, PA 17605-0008
Phone 717/299-5211
A Division of High Industries, Inc.

HORIZONTAL CURVE DIAGRAMS
U.S. RTE. 5 (BRIDGE #60) OVER LULLS BROOK
U.S. RTE. 5 STA. 3+080.77 TO STA. 3+123.110
TOWN OF HARTLAND
WINDSOR COUNTY, VERMONT
STATE OF VERMONT, AGENCY OF TRANSPORTATION

STATE CONTRACT OR REF. NO. PROJECT NO. BRS-0113(22)

CONTRACTOR MILLER CONSTRUCTION, INC.
IN CHARGE: GLIDDEN (IH) MADE BY: KMA CHK'D BY: SJA DATE: 4-21-05

CONTRACT NUMBER: VT-05017-1 DRAWING NUMBER: HC1 OF HC1

CODE: 30

113 SS

BY: mkr-ede1
PLOTTED: 4/28/2005 9:38:46 AM