
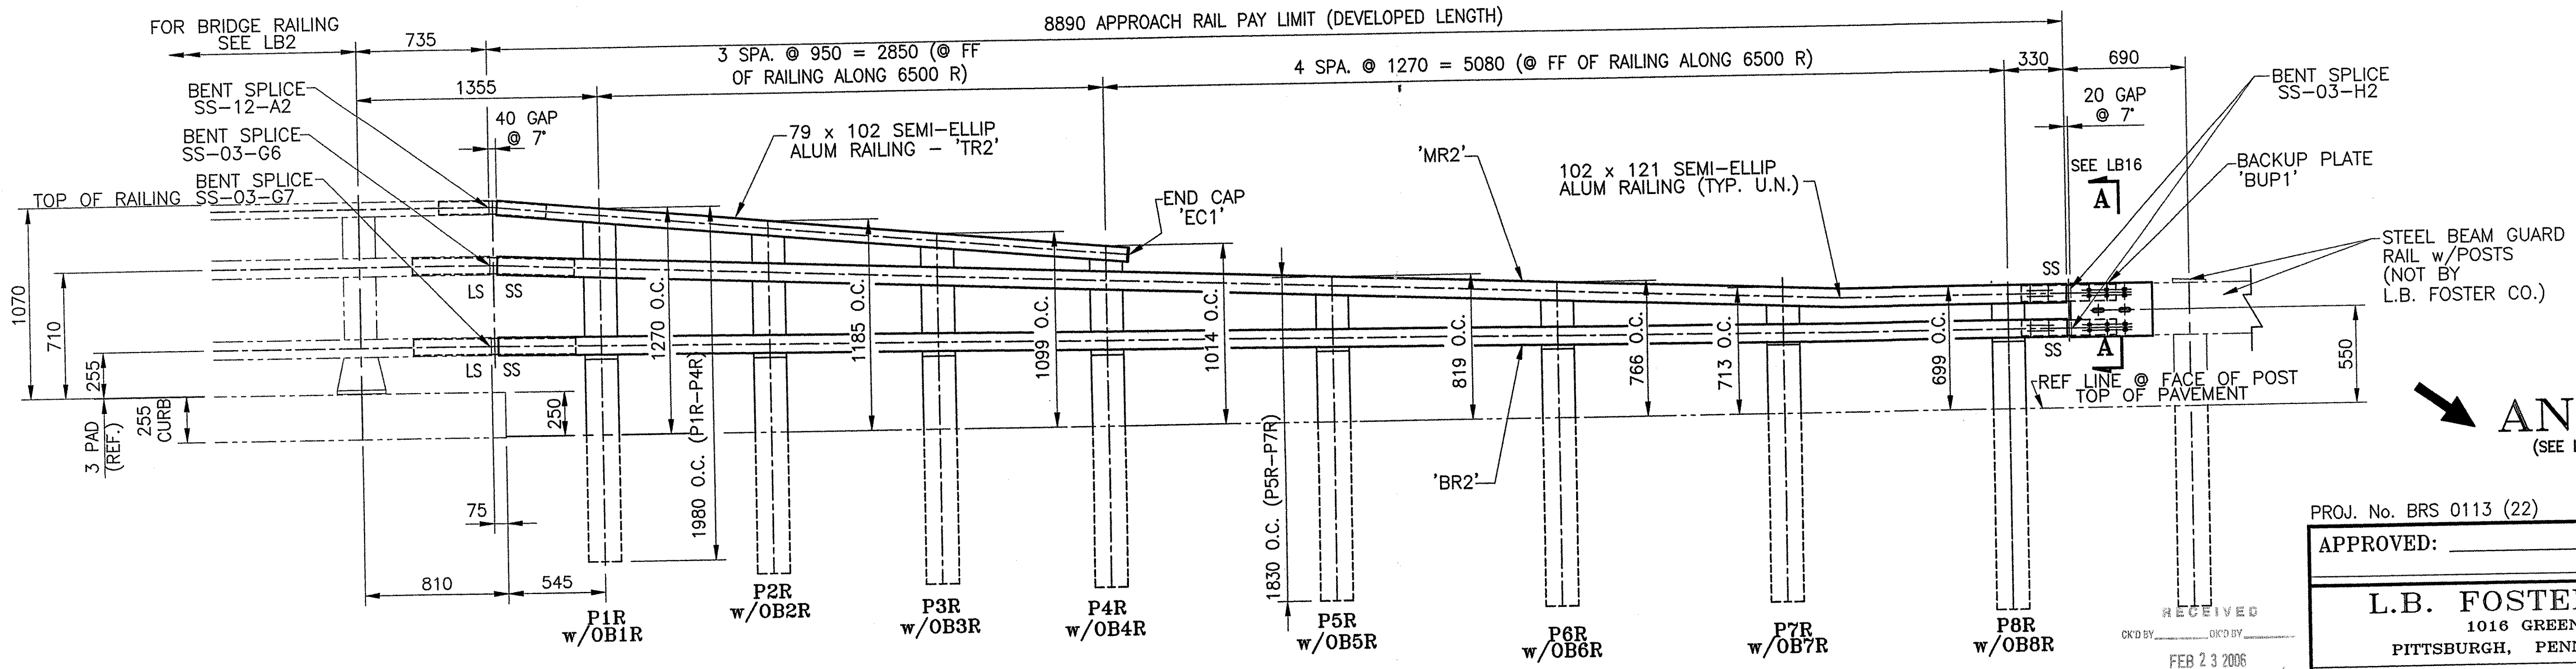


- NOTE:
- RAIL LENGTHS DO NOT INCLUDE END CAPS AND/OR GAPS.
 - LENGTH OF APPROACH RAILING ON THIS SHEET IS 8.89 M (29.16 LF) PAY LENGTH.
 - METRIC DIMENSIONS ARE IN MILLIMETERS (mm), UNLESS NOTED.

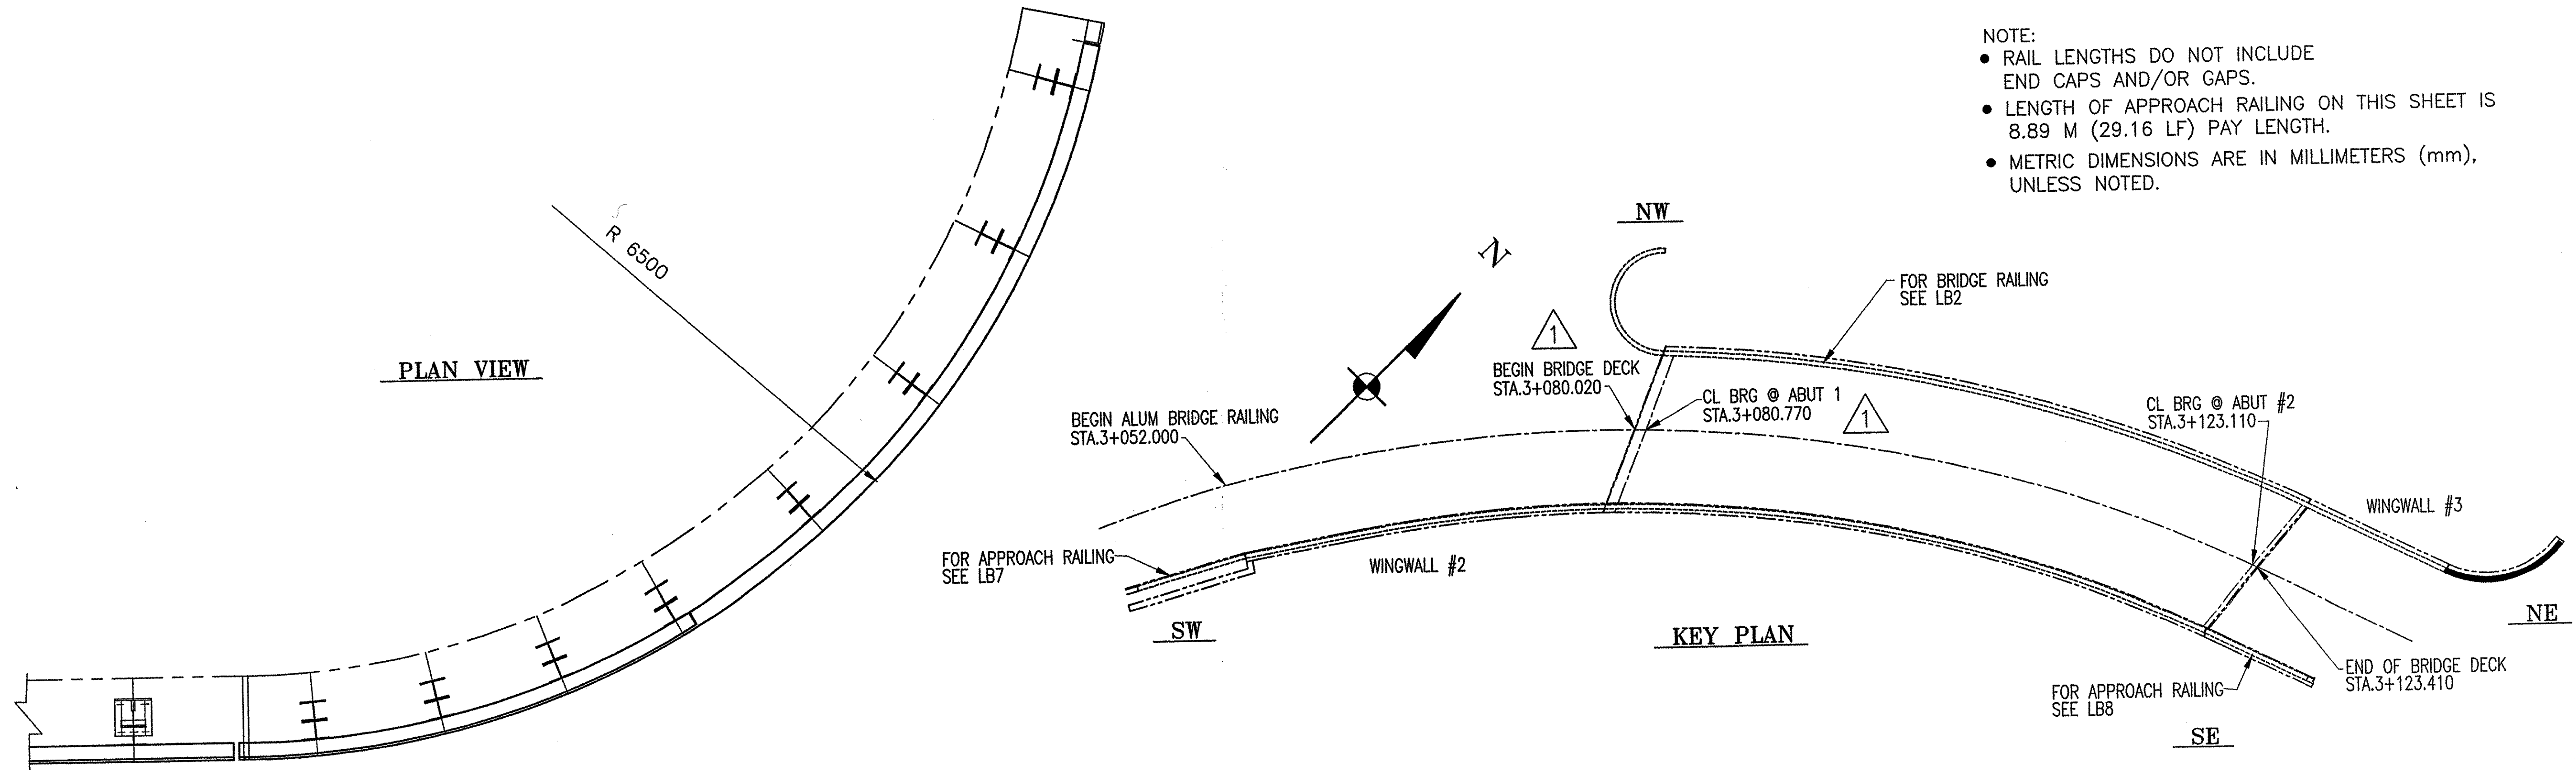

ANODIZED
(SEE LB1 FOR SPECIFICATIONS)

PROJ. No. BRS 0113 (22) ITEM No: 621.74

APPROVED: _____ REC'D APPROVAL _____
DRAWING _____

L.B. FOSTER COMPANY
1016 GREENTREE ROAD
PITTSBURGH, PENNSYLVANIA 15220

FOR: A. D. ROSSI CORPORATION
VERMONT AGENCY OF TRANSPORTATION
TOWN OF HARTLAND, COUNTY OF WINDSOR
BRIDGE #60 - US RTE 5 OVER LULLS BROOK
3L ALUMINUM APPROACH RAIL ELEVATIONS

MADE CMS DATE 05/25/05 JOB No. ARO200 CUST. No. _____
CHECK Dd DATE 11/7/05 DRAWING LB6 REV. No. ONE

RECEIVED
OK'D BY _____ OK'D BY _____
FEB 23 2006
RESUBMIT _____ APPROVED _____
BY SJD DATE 2/15/06

REV.	DESCRIPTION	BY	DATE
1	REVISED PER VT DOT CHGS TO BRIDGE LENGTHS	CMS	01/31/06

SS = SHORT SLOTTED SIDE
LS = LONG SLOTTED SIDE