


NOTE:
 • RAIL LENGTHS DO NOT INCLUDE
 END CAPS AND/OR GAPS.
 • LENGTH OF APPROACH RAILING ON THIS SHEET IS
 7.6 M (25 LF) PAY LENGTH.
 • METRIC DIMENSIONS ARE IN MILLIMETERS (mm),
 UNLESS NOTED.

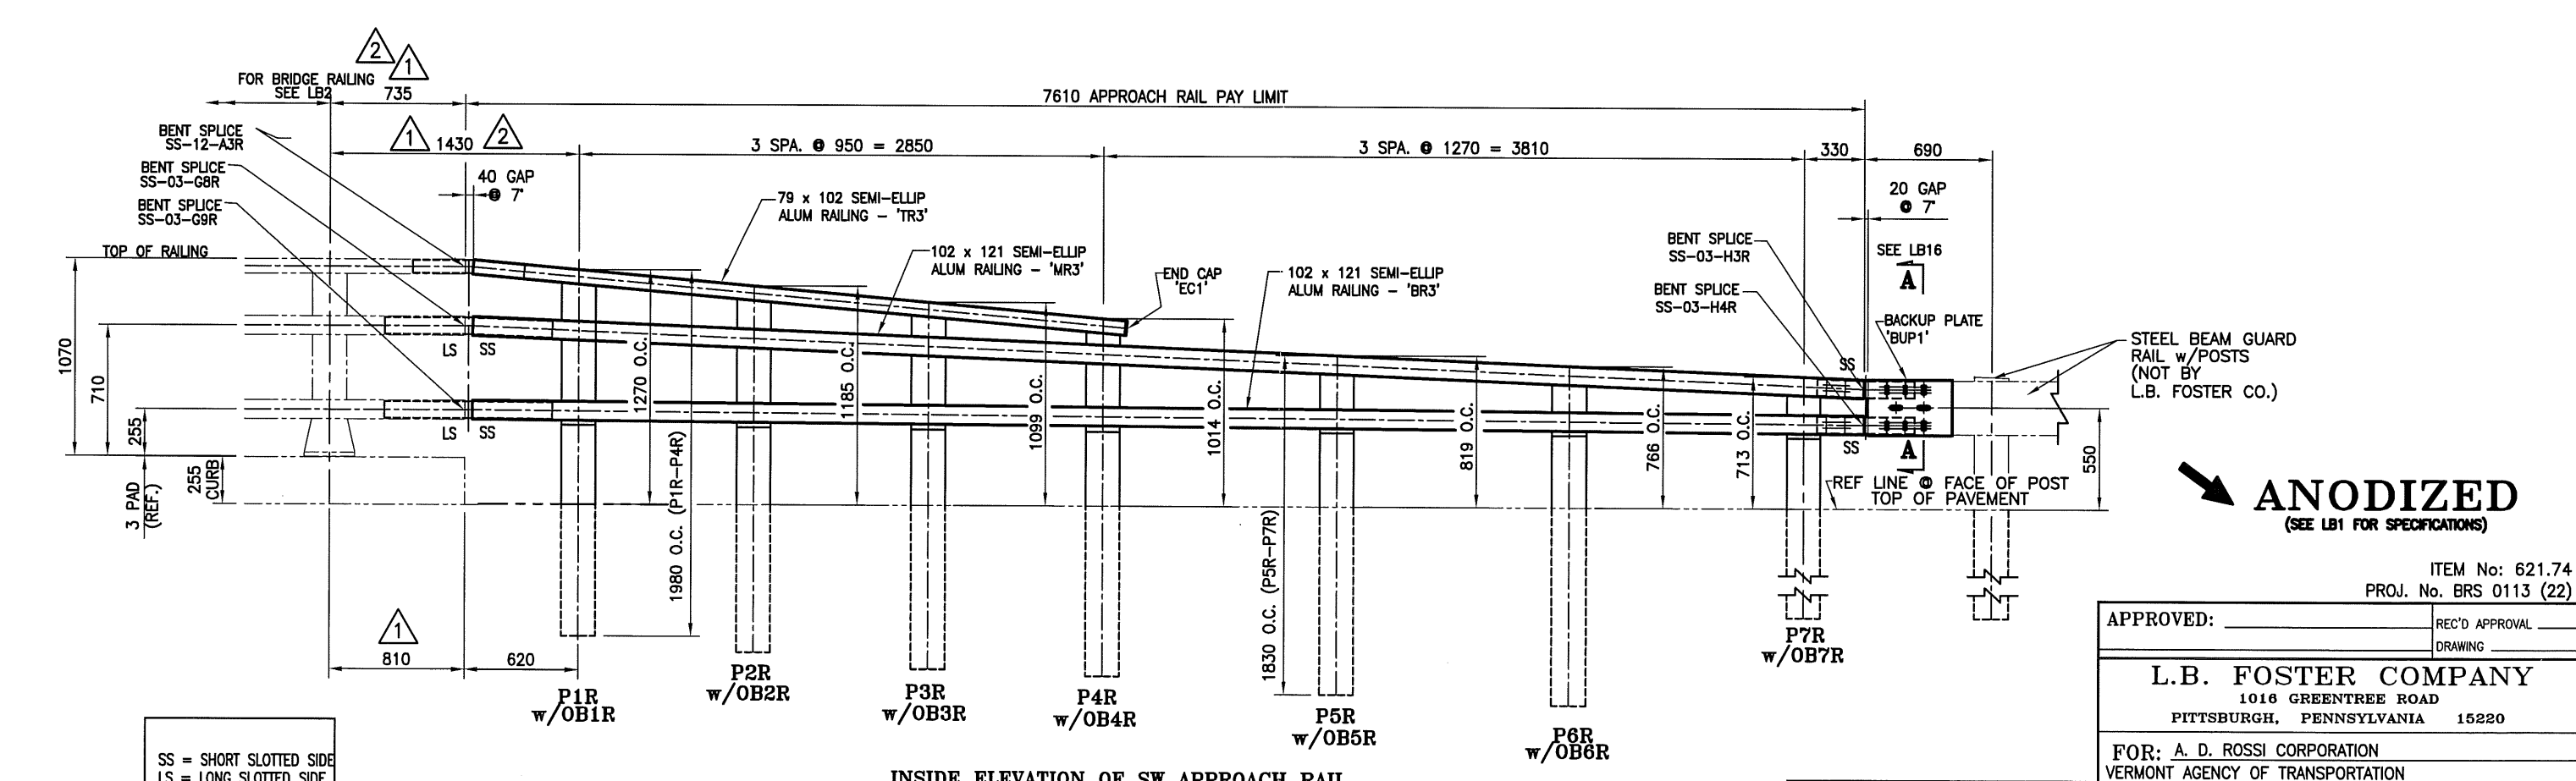

ITEM No: 621.74
 PROJ. No: BRS 0113 (22)

APPROVED: _____
 CHECK APPROVAL
 DRAWING

L.B. FOSTER COMPANY
 1016 ORIENTREE ROAD
 PITTSBURGH, PENNSYLVANIA 15220

FOR: A. D. ROSSI CORPORATION
 VERMONT AGENCY OF TRANSPORTATION
 TOWN OF HARTLAND, COUNTY OF WINDSOR
 BRIDGE #60 - US RTE 5 OVER LULLS BROOK
 ALUMINUM APPROACH RAIL ELEVATIONS

MADE CMS DATE 05/25/05 JOB No. ARO200 CUST. No.
 CHECKED DATE 11/27/05 DRAWING 187 REV. No. 2

REV.	DESCRIPTION	BY	DATE
07	REVISED PER VT DOT PHONE CONVERS.	Dd	08
01	REVISED PER VT DOT CHGS IN BRIDGE LENGTHS	CMS	01
06			06

SS = SHORT SLOTTED SIDE
 LS = LONG SLOTTED SIDE