


NOTE:
 • RAIL LENGTHS DO NOT INCLUDE END CAPS AND/OR GAPS.
 • LENGTH OF APPROACH RAILING ON THIS SHEET IS 7.6 M (25 LF) PAY LENGTH.
 • METRIC DIMENSIONS ARE IN MILLIMETERS (mm), UNLESS NOTED.

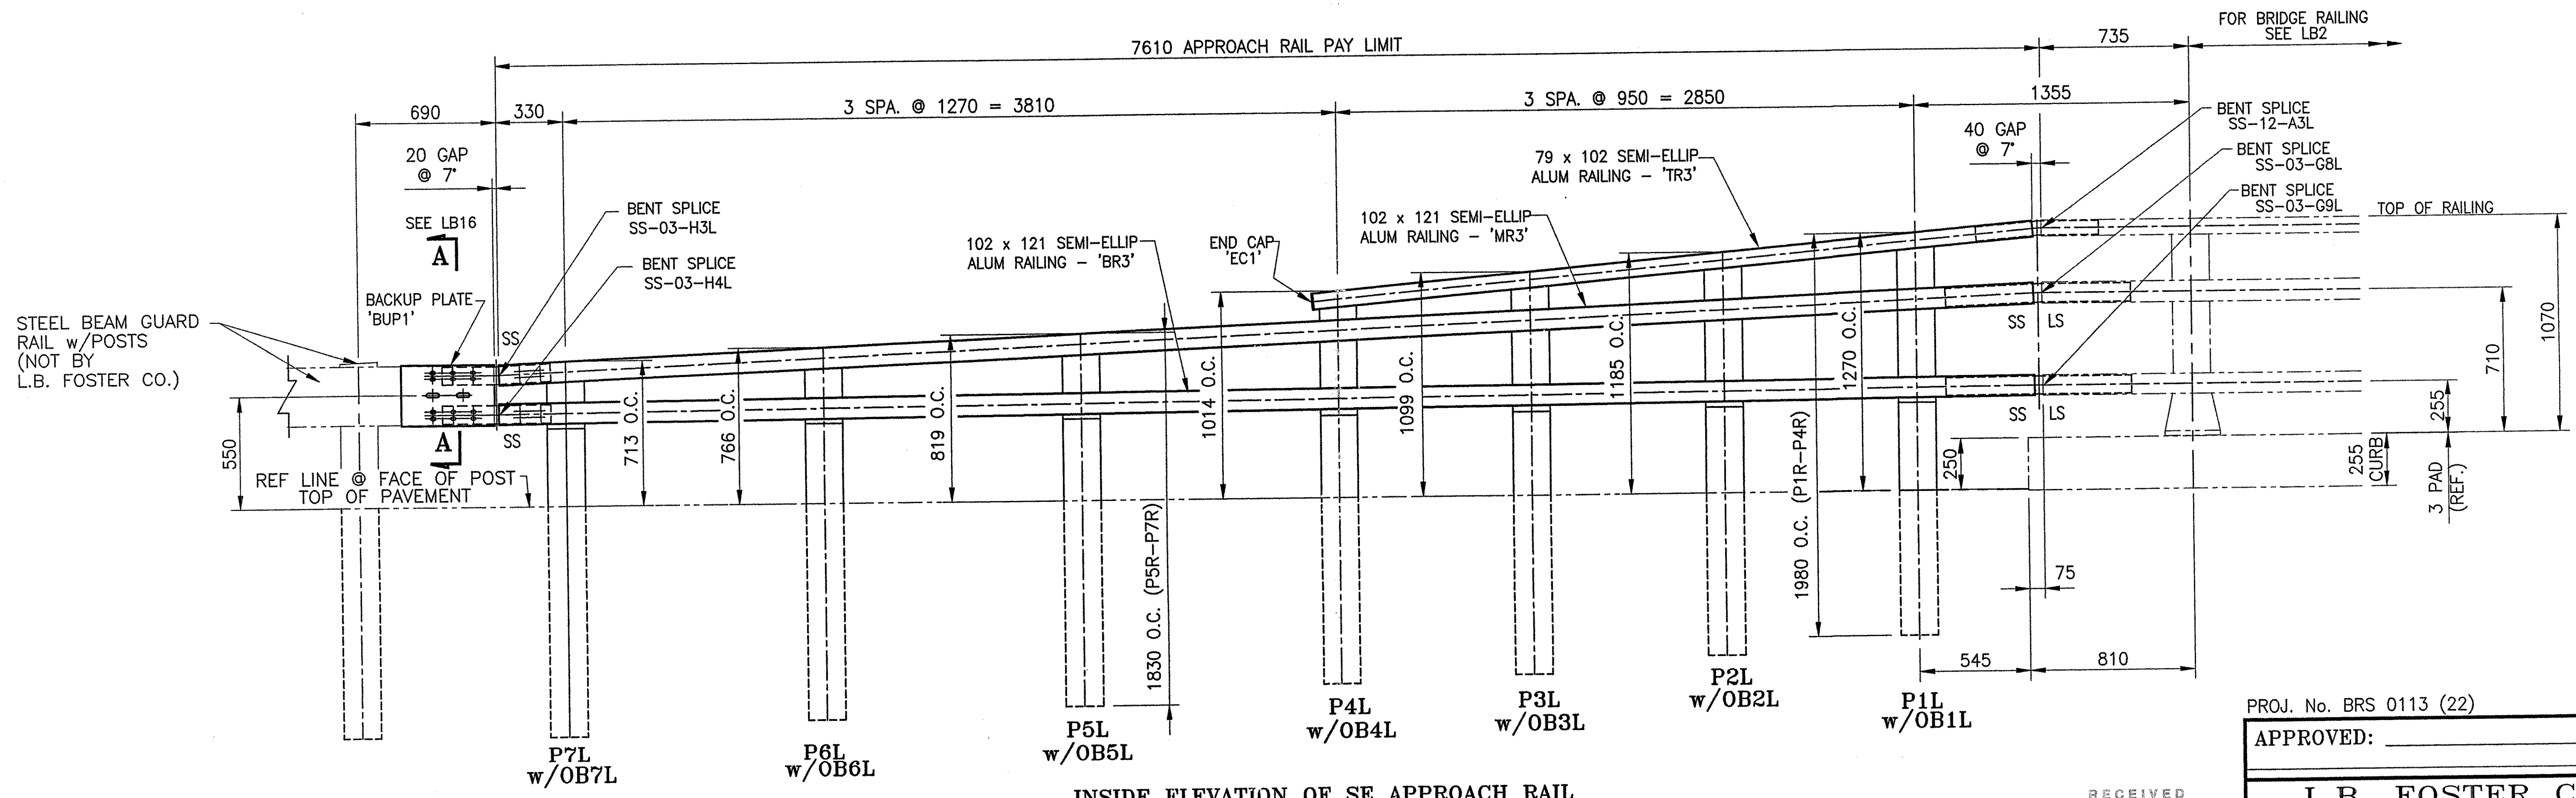

INSIDE ELEVATION OF SE APPROACH RAIL

SS = SHORT SLOTTED SIDE
 LS = LONG SLOTTED SIDE

ANODIZED
 (SEE LB1 FOR SPECIFICATIONS)

RECEIVED
 OK'D BY _____ DATE _____
 FEB 23 2006
 RESUBMIT _____ APPROVED _____
 BY *WJ* DATE *2/23/06*

REV.	DESCRIPTION	BY	DATE
1	REVISED PER VTDOT CHGS TO BRIDGE LENGTHS	CMS	01 31 06

PROJ. No. BRS 0113 (22) ITEM No: 621.74

APPROVED: _____ REC'D APPROVAL _____
 DRAWING _____

L.B. FOSTER COMPANY
 1016 GREENTREE ROAD
 PITTSBURGH, PENNSYLVANIA 15220

FOR: A. D. ROSSI CORPORATION
 VERMONT AGENCY OF TRANSPORTATION
 TOWN OF HARTLAND, COUNTY OF WINDSOR
 BRIDGE #60 - US RTE 5 OVER LULLS BROOK
 3L ALUMINUM APPROACH RAIL ELEVATIONS

MADE CMS DATE 05/25/05 JOB No. AR0200 CUST. No. _____
 CHECK_Dd DATE 11/7/05 DRAWING LB8 REV. No. ONE