

**OFFSET BLOCK CHART FOR (NW) & (SE) APPROACHES
CURB CONDITION - POSTS P5L - P7L**


POST No.	OFFSET BLOCK	QTY.	OFFSET BLOCK ~ POST MTG. DIMENSIONS						BEV
			A	B	C	D	E	F (O.C.)	X
P5L	OB5L	2	423	348	56	8	48	419	4
P6L	OB6L	2	380	305	56	8	48	376	
P7L	OB7L	2	337	262	56	8	48	332	
P8L	OB8L	3	332	246	52	0	52	332	SQ

OFFSET BLOCK ~ RAIL MTG. DIMENSIONS					
POST No.	OFFSET BLOCK	G	H	J	K
P5L	OB5L	32	327	29	320
P6L	OB6L	32	283	29	276
P7L	OB7L	32	240	29	233
P8L	OB8L	31	224	31	224

**OFFSET BLOCK CHART FOR (NE) & (SW) APPROACHES
CURB CONDITION - POSTS P5R - P8R**

POST No.	OFFSET BLOCK	QTY.	OFFSET BLOCK ~ POST MTG. DIMENSIONS						BEV
			A	B	C	D	E	F (O.C.)	X
P5R	OB5R	2	423	348	56	8	48	419	4
P6R	OB6R	2	380	305	56	8	48	376	
P7R	OB7R	2	337	262	56	8	48	332	
P8R	OB8R	1	332	246	52	0	52	332	SQ

OFFSET BLOCK ~ RAIL MTG. DIMENSIONS					
POST No.	OFFSET BLOCK	G	H	J	K
P5R	OB5R	32	327	29	320
P6R	OB6R	32	283	29	276
P7R	OB7R	32	240	29	233
P8R	OB8R	31	224	31	224

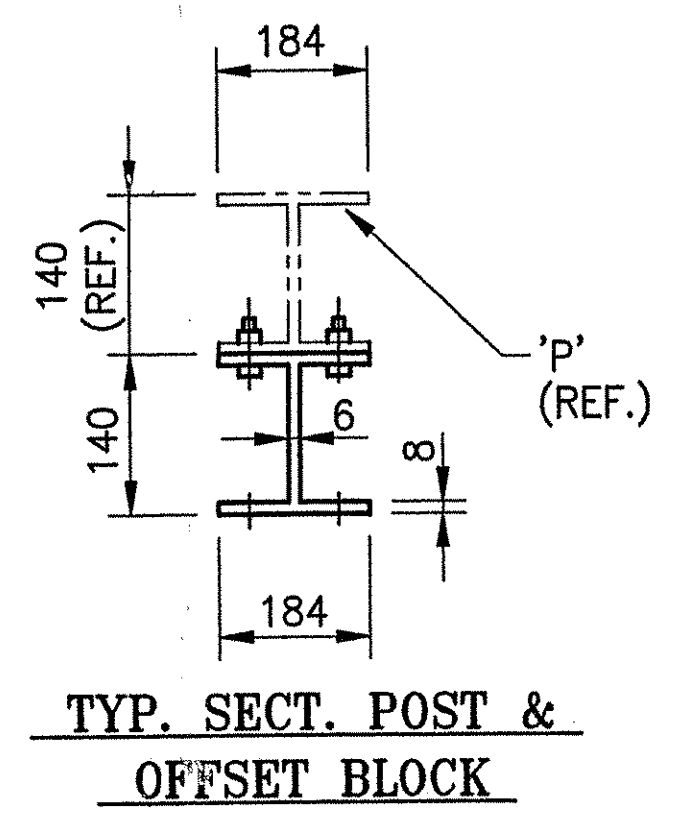

NOTE:
2 CLAMPING BARS CB-01-B (#28596) PER POSTS P1-P4
4 CLAMPING BARS CB-03-A (#19447) PER POSTS P1-P4
w/ 13 (1/2" φ-13 UNC S.S. BOLT x 1" LG. 'FB1', 1 1/16" O.D. x 17/32" I.D. x 3/32" THK. ALUM WASHER 'FW1' (#22935 & # 19404) (16 PER POST)

NOTE:
4 CLAMPING BARS CB-03-A (#19447) PER POSTS P5-P7
w/ 13 (1/2" φ-13 UNC S.S. BOLT x 25 (1" LG. 'FB1', 27 (1 1/16" O.D. x 13 (17/32" I.D. x 2 (3/32" THK. ALUM WASHER 'FW1' (#22935 & # 19404) (8 PER POST)

ANODIZED
(SEE LB1 FOR SPECIFICATIONS)

PROJ. No. BRS 0113 (22) ITEM No: 621.74

RECEIVED
OCT'D BY: _____ OCT'D BY: _____
FEB 23 2006
RESUBMIT BY: *wj* APPROVED BY: *[Signature]* DATE: 2/15/06

APPROVED: _____ REC'D APPROVAL: _____
DRAWING: _____

L.B. FOSTER COMPANY
1016 GREENTREE ROAD
PITTSBURGH, PENNSYLVANIA 15220

FOR: A. D. ROSSI CORPORATION
VERMONT AGENCY OF TRANSPORTATION
TOWN OF HARTLAND, COUNTY OF WINDSOR
3L APPROACH RAILING FOR BRIDGE #60 - US RTE 5 OVER LULLS BROOK
OFFSET BOX DETAILS - NW, NE, SW & SE APPROACHES

MADE CMS DATE 05/24/05 JOB No. ARO200 CUST. No. _____
CHECK Dd DATE 11/7/05 DRAWING LB11 REV. No. _____

REV.	DESCRIPTION	BY	DATE