


- NOTE:
- RAIL LENGTHS DO NOT INCLUDE END CAPS AND/OR GAPS.
  - LENGTH OF APPROACH RAILING ON THIS SHEET IS 11.43 M (37.5 LF) PAY LENGTH.
  - METRIC DIMENSIONS ARE IN MILLIMETERS (mm), UNLESS NOTED.

SS = SHORT SLOTTED SIDE  
 LS = LONG SLOTTED SIDE

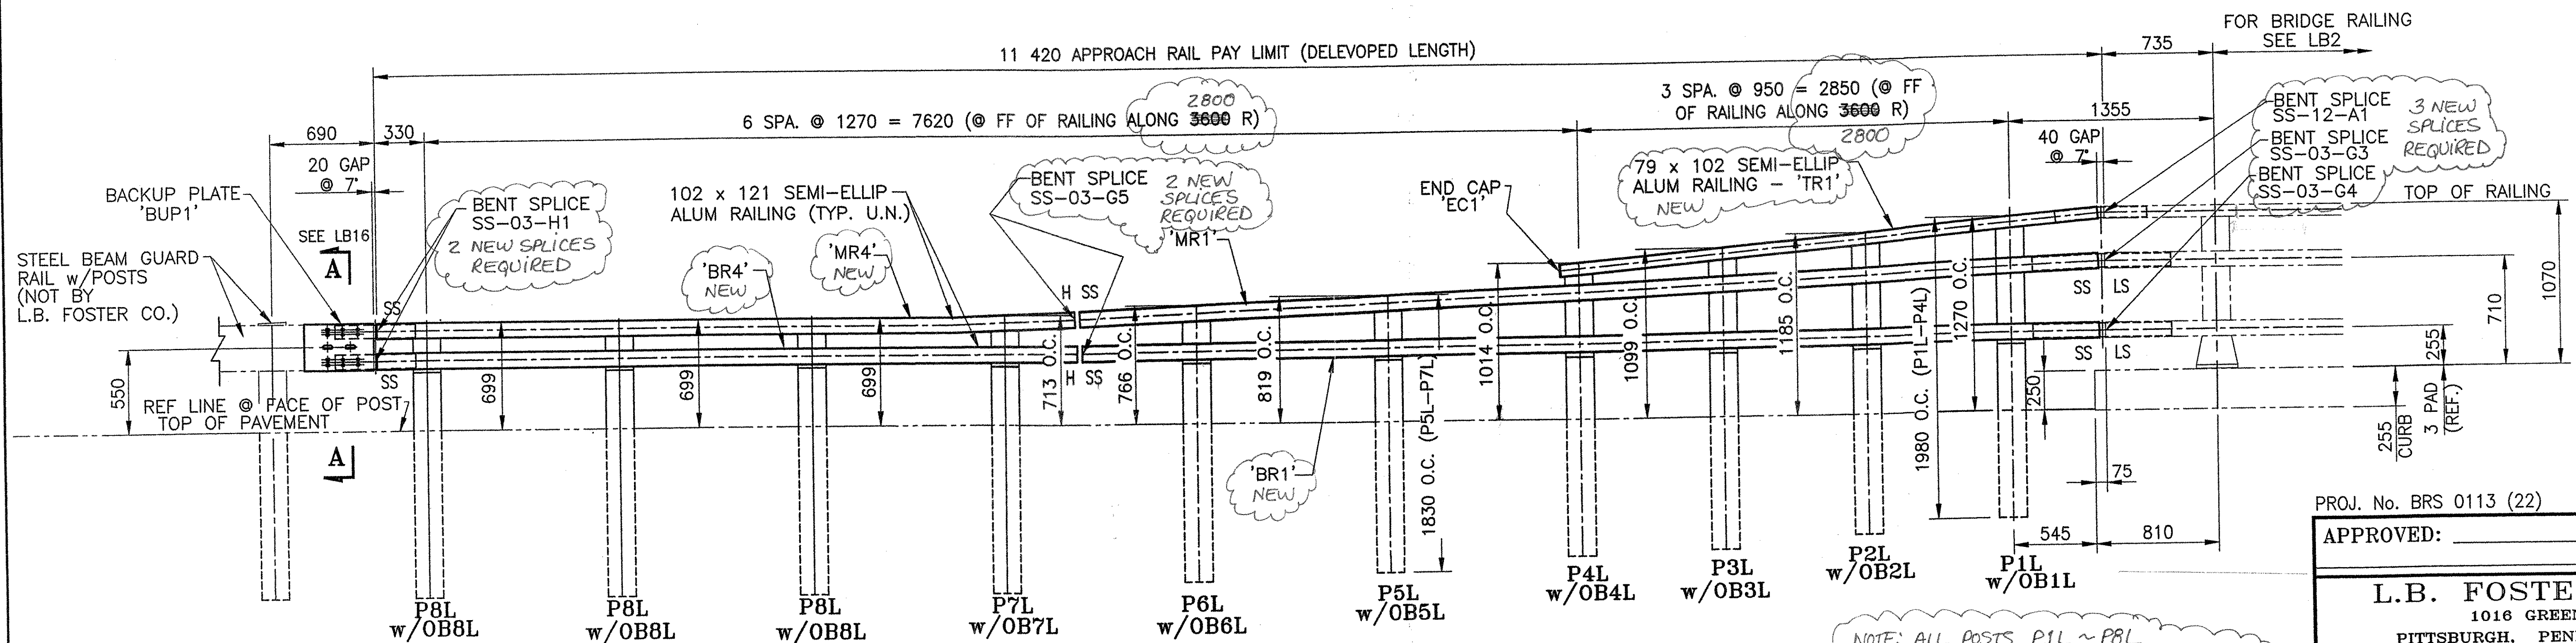

INSIDE ELEVATION OF NW APPROACH RAIL

NOTE: ALL POSTS P1L ~ P8L AND ALL OFFSET BLOCKS OB1L ~ OB8L WILL BE SALVAGED AND USED ON THE PROPOSED 2800 RADIUS

**ANODIZED**  
 (SEE LB1 FOR SPECIFICATIONS)

1	REVISED PER VDOT CHGS IN BRIDGE LENGTHS	CMS	01/31/06
REV.	DESCRIPTION	BY	DATE

PROJ. No. BRS 0113 (22) ITEM No: 621.74

APPROVED: \_\_\_\_\_ REC'D APPROVAL \_\_\_\_\_  
 DRAWING \_\_\_\_\_

**L.B. FOSTER COMPANY**  
 1016 GREENTREE ROAD  
 PITTSBURGH, PENNSYLVANIA 15220

FOR: A. D. ROSSI CORPORATION  
 VERMONT AGENCY OF TRANSPORTATION  
 TOWN OF HARTLAND, COUNTY OF WINDSOR  
 BRIDGE #60 - US RTE 5 OVER LULLS BROOK  
 3L ALUMINUM APPROACH RAIL ELEVATIONS

MADE CMS DATE 05/25/05 JOB No. ARO200 CUST. No. \_\_\_\_\_  
 CHECK\_Dd DATE 11/7/05 DRAWING LB5 REV. No. ONE