




3+051.80

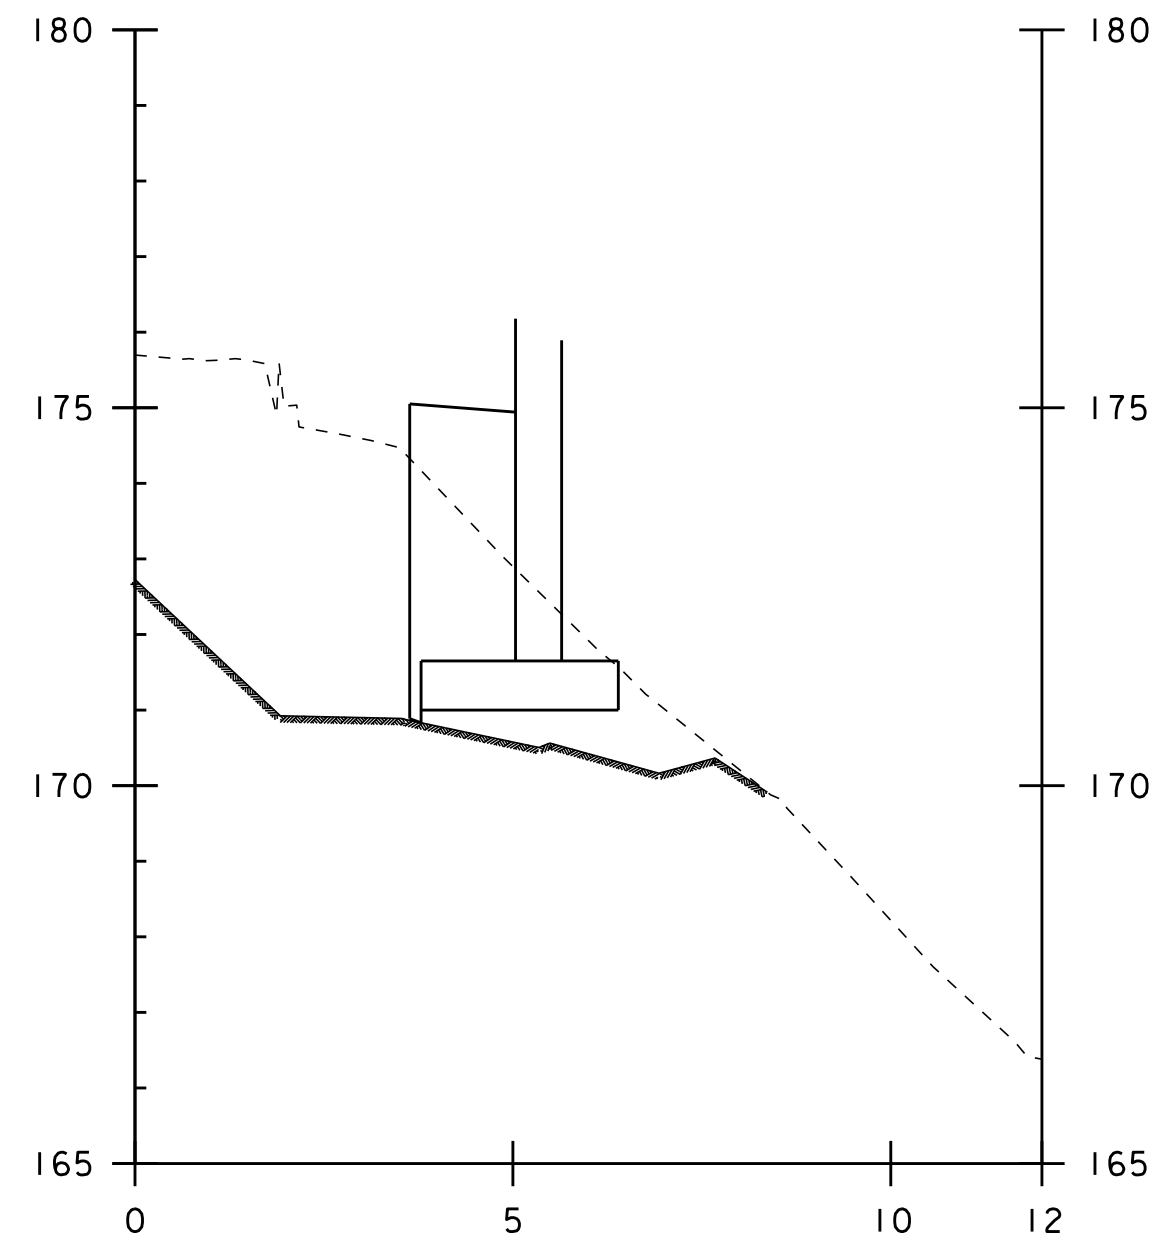


3+067.80

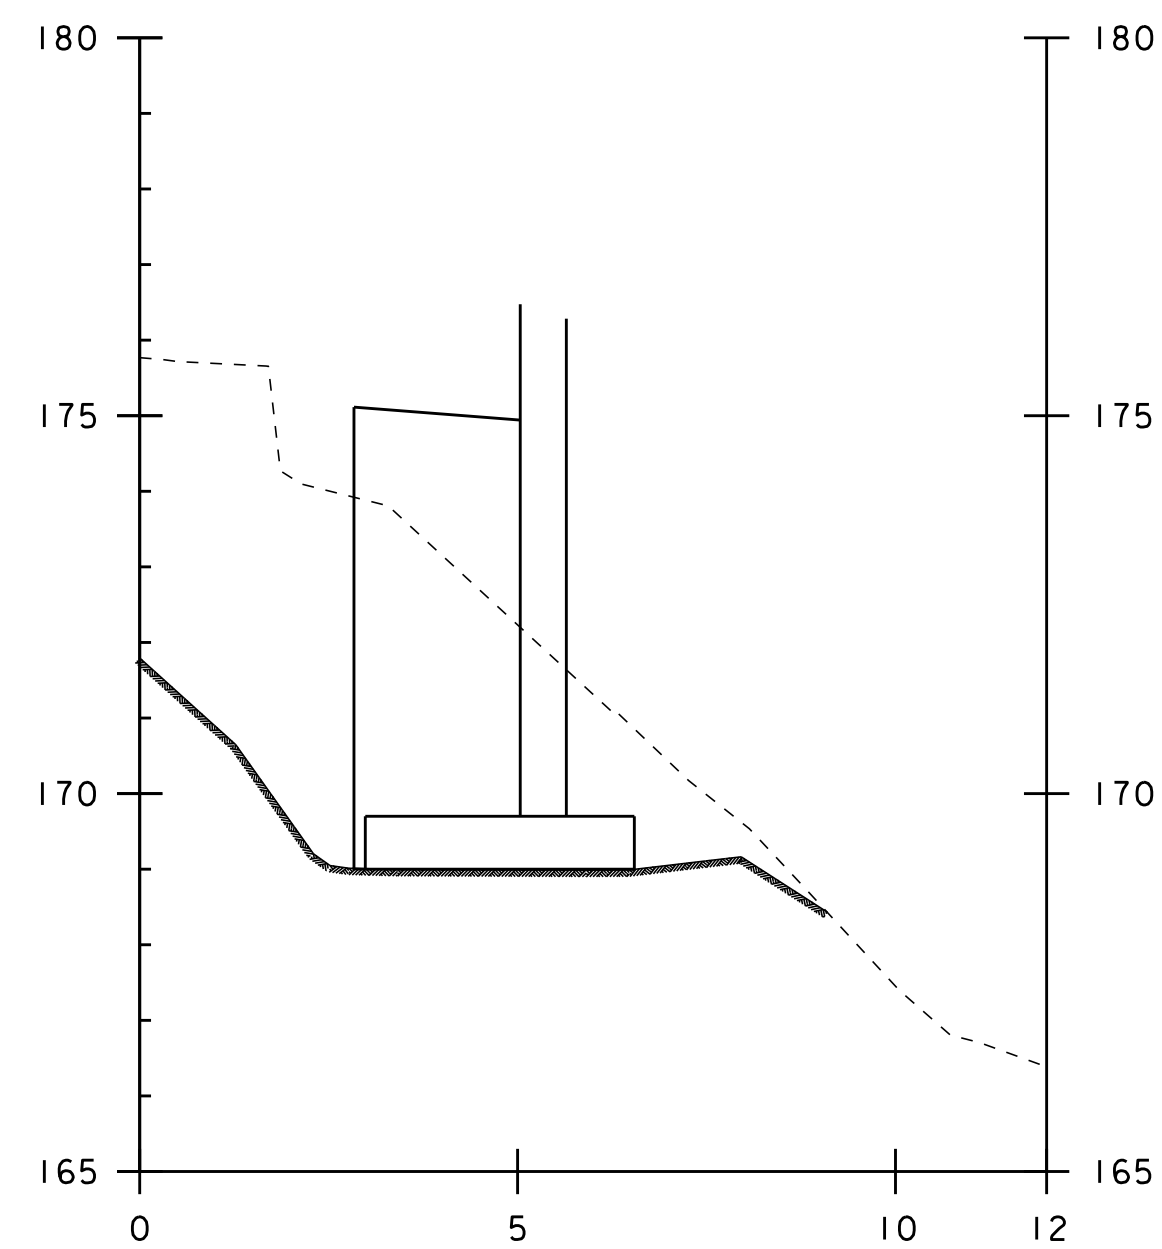


3+070.50

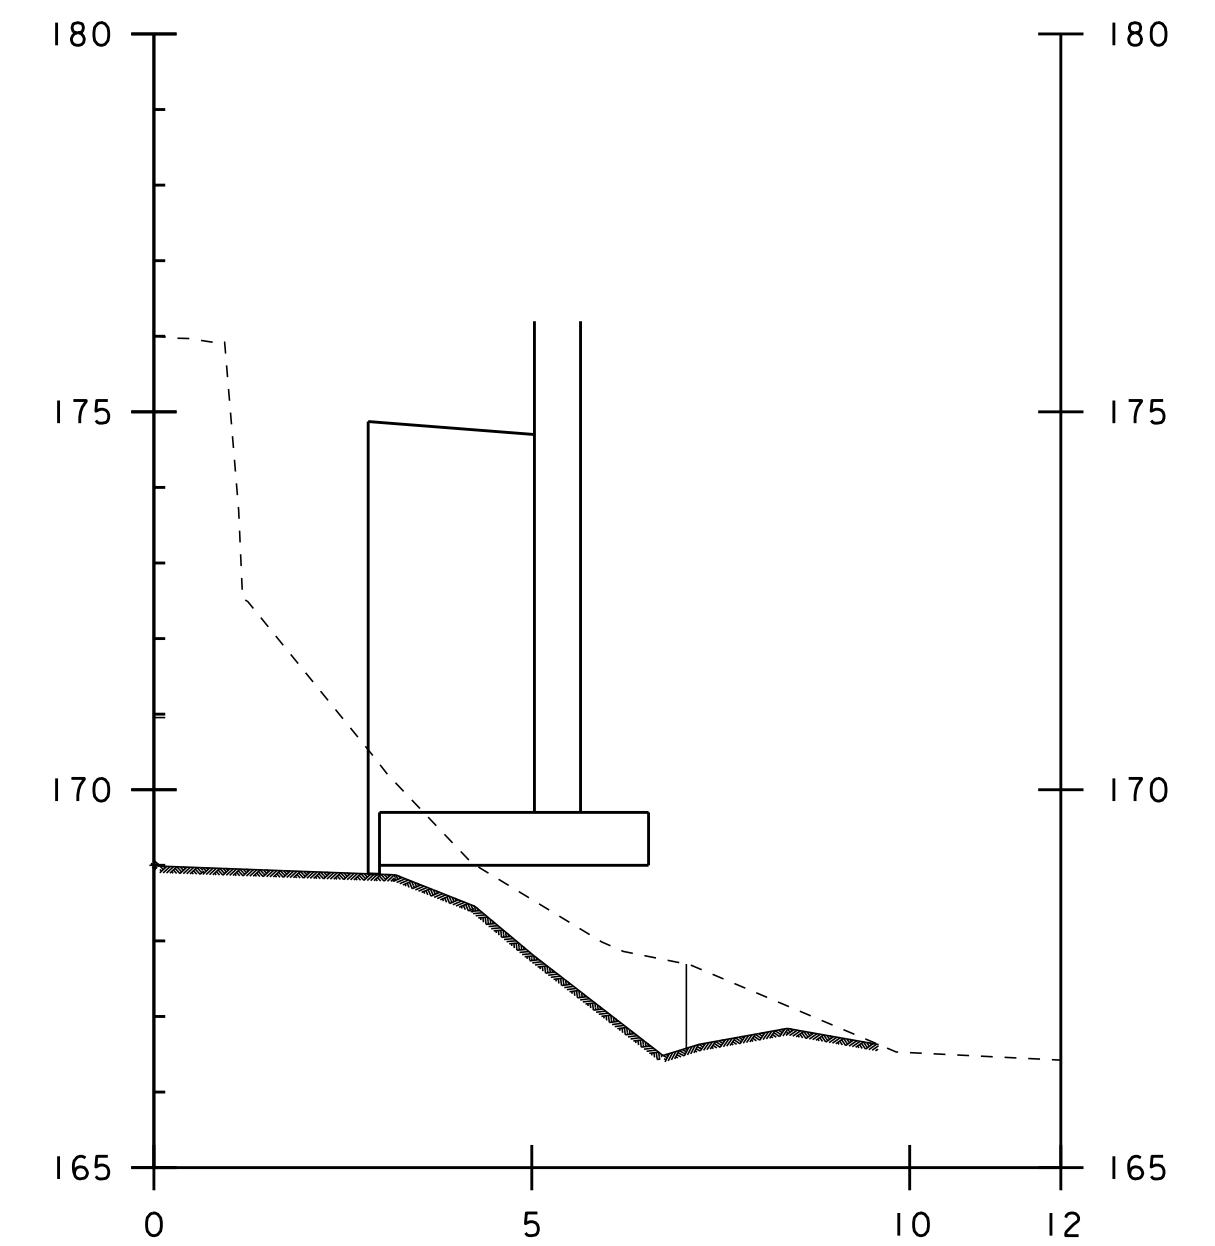


3+078.50

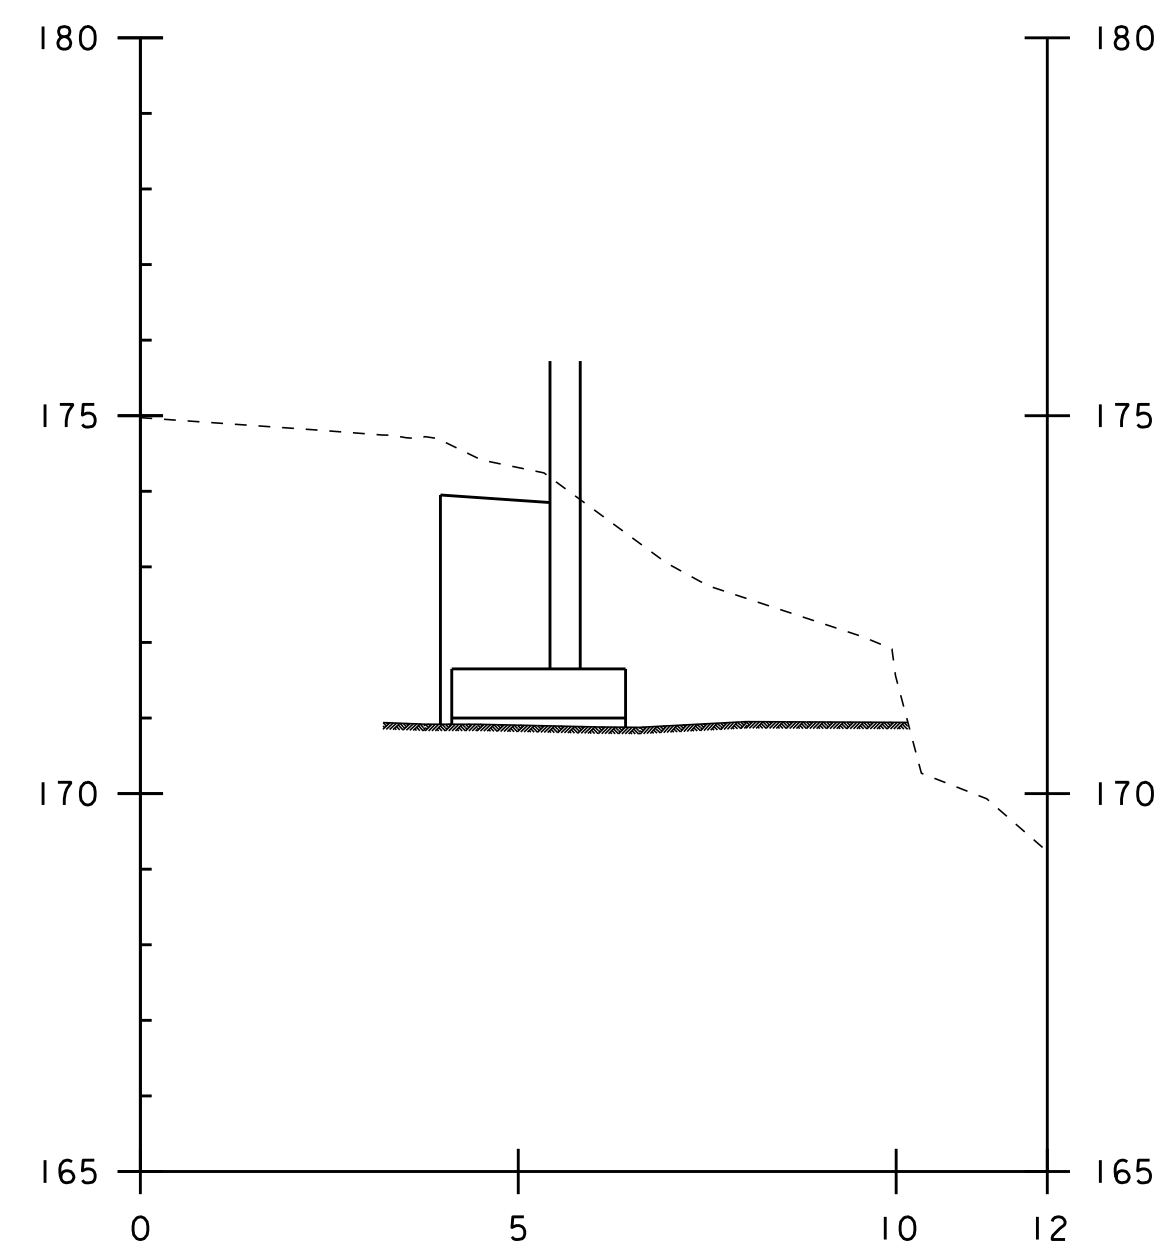

3+042.50

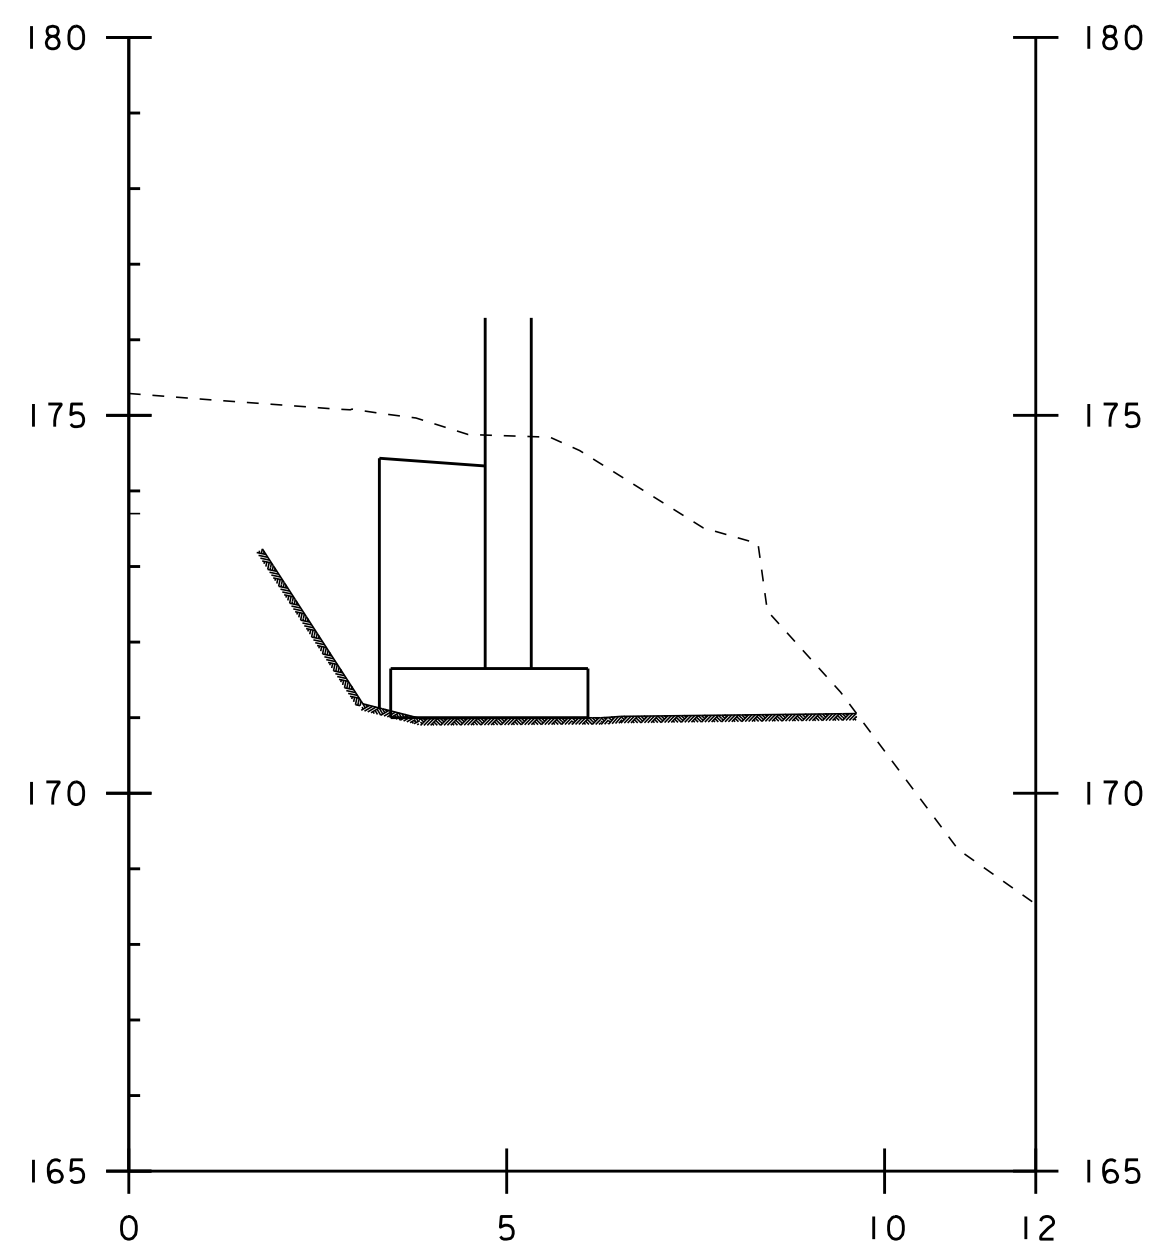

3+051.80

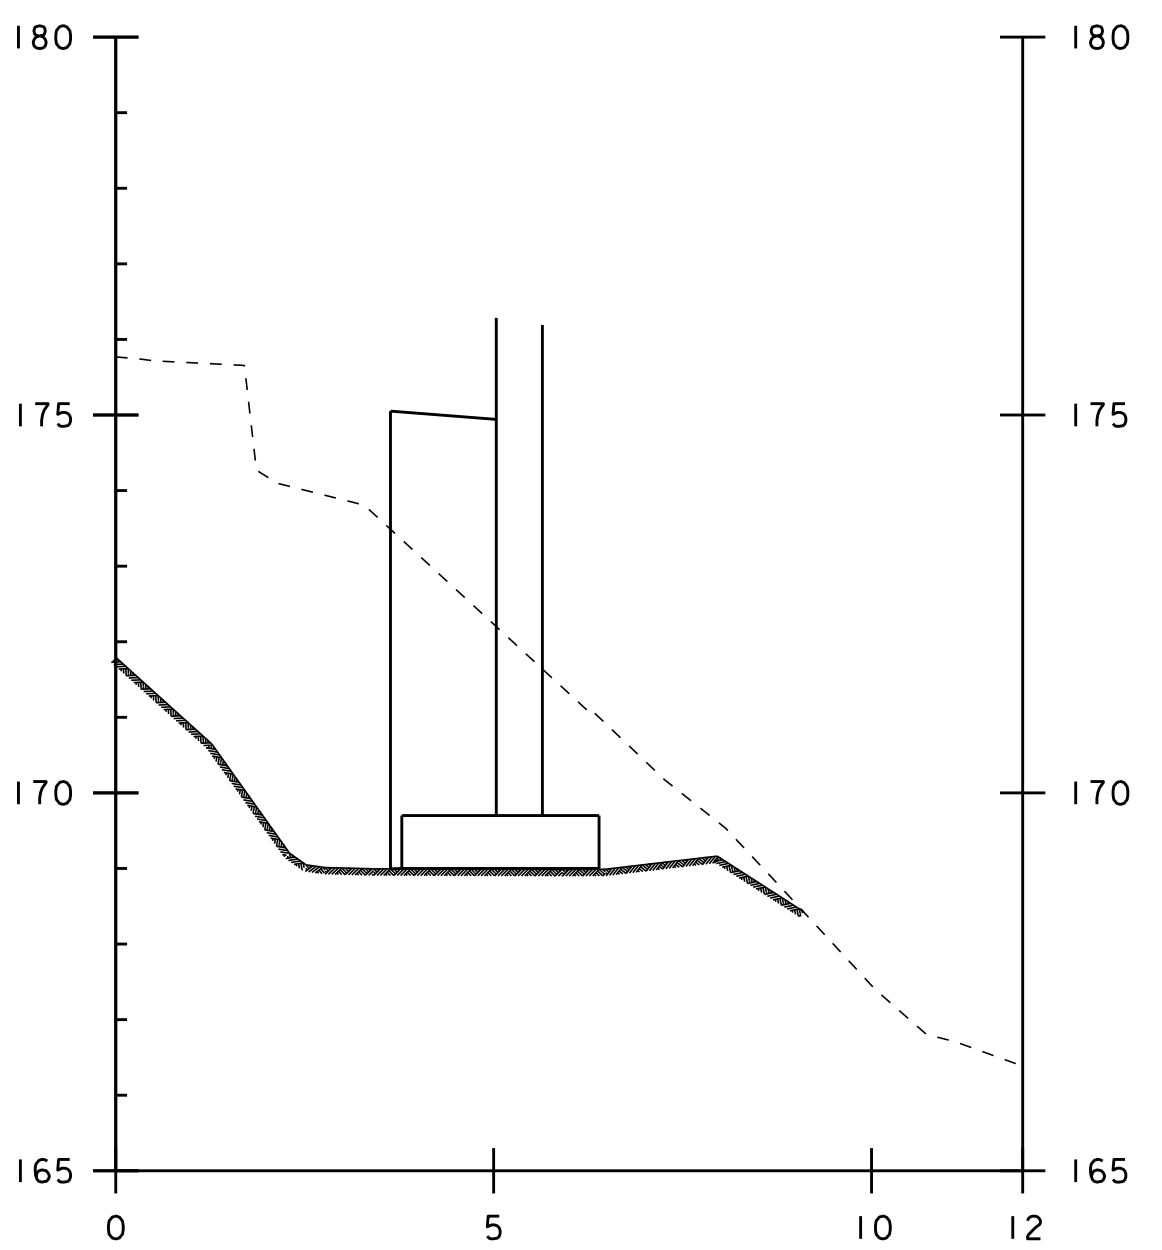

3+070.50

WINGWALL TWO
 GRANULAR BACKFILL FOR STRUCTURES

