




2+002.00

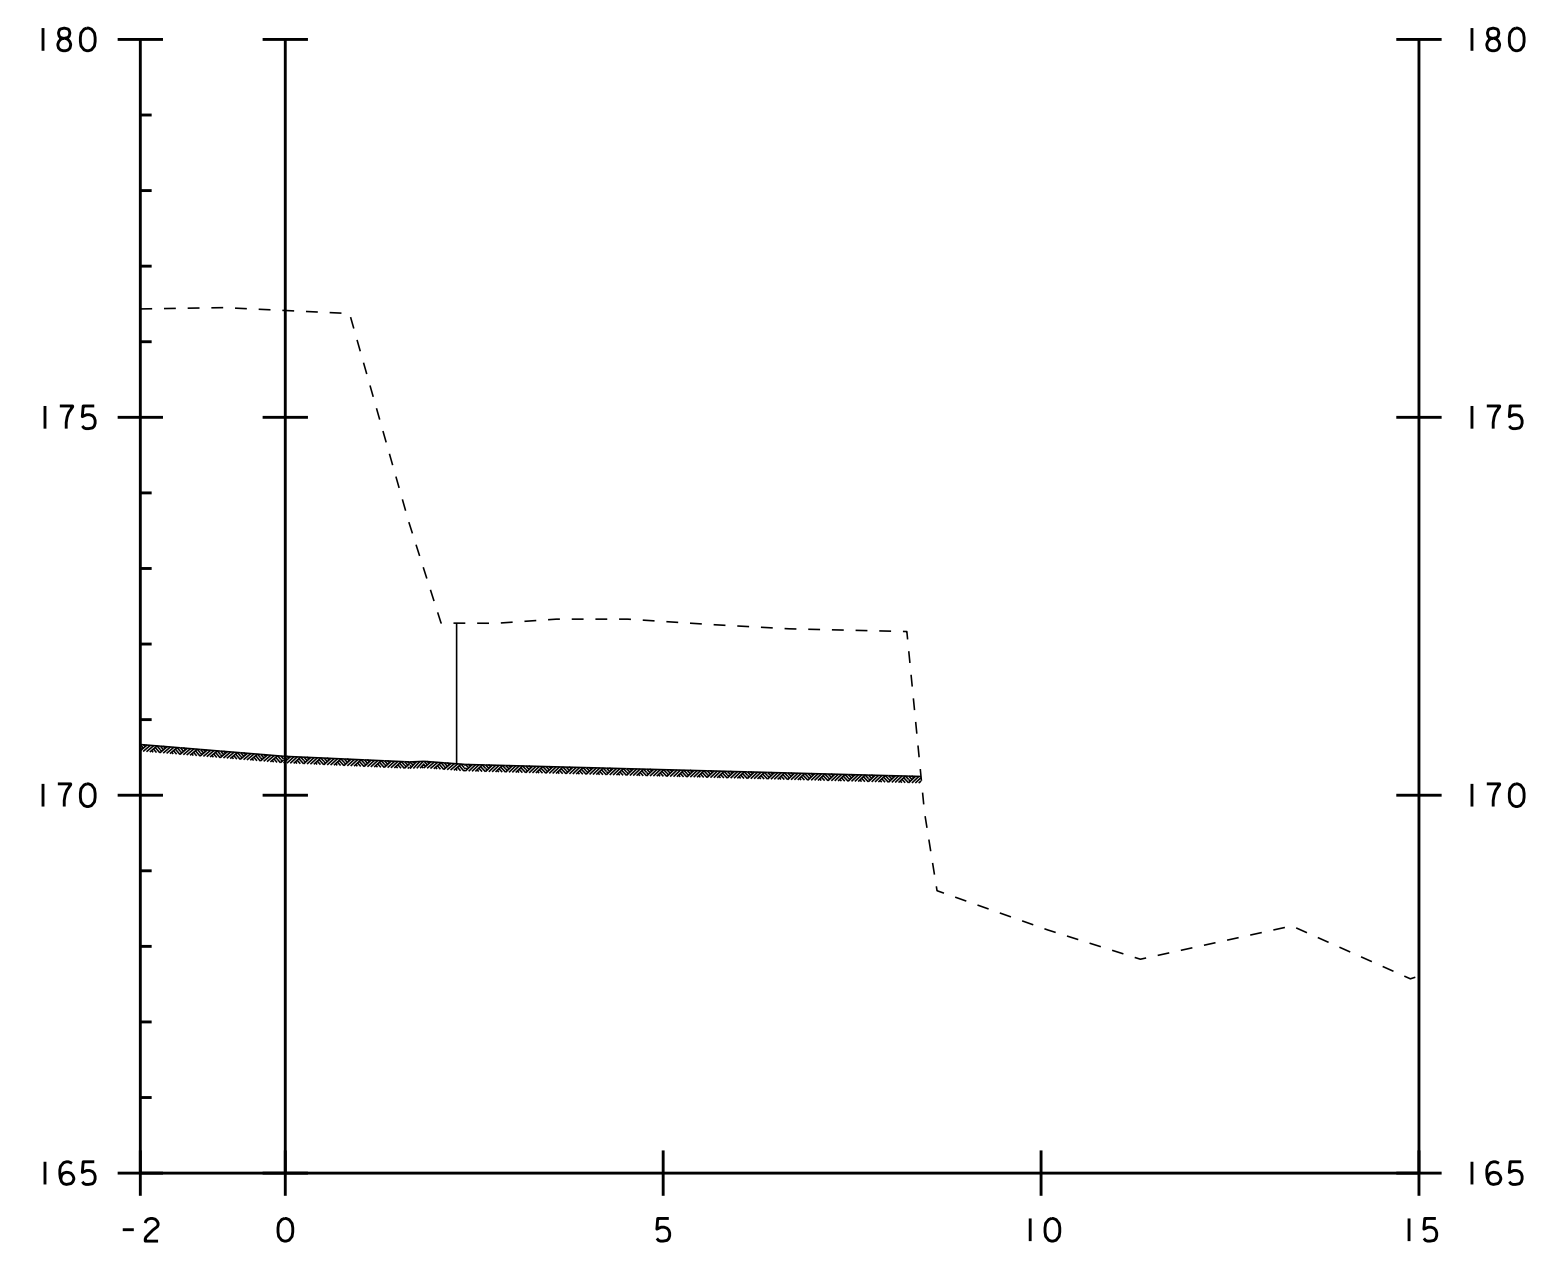


2+006.00

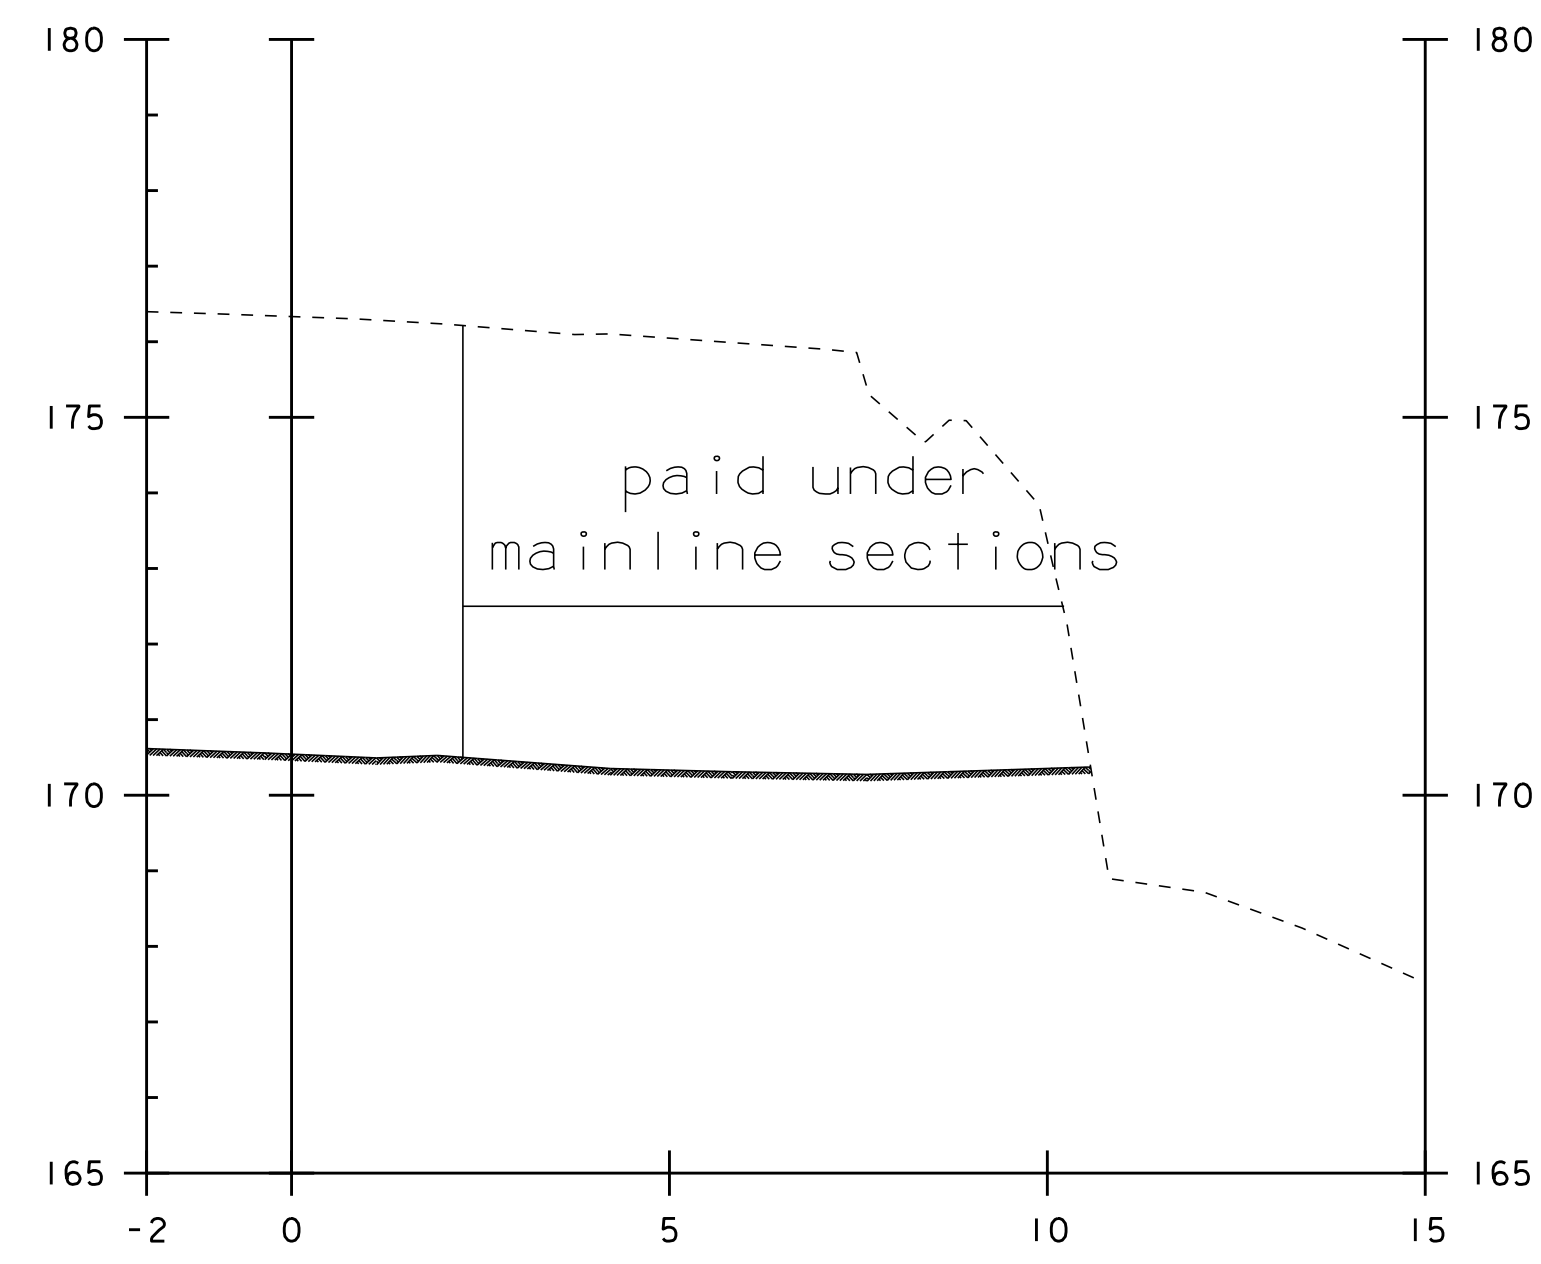


2+010.00

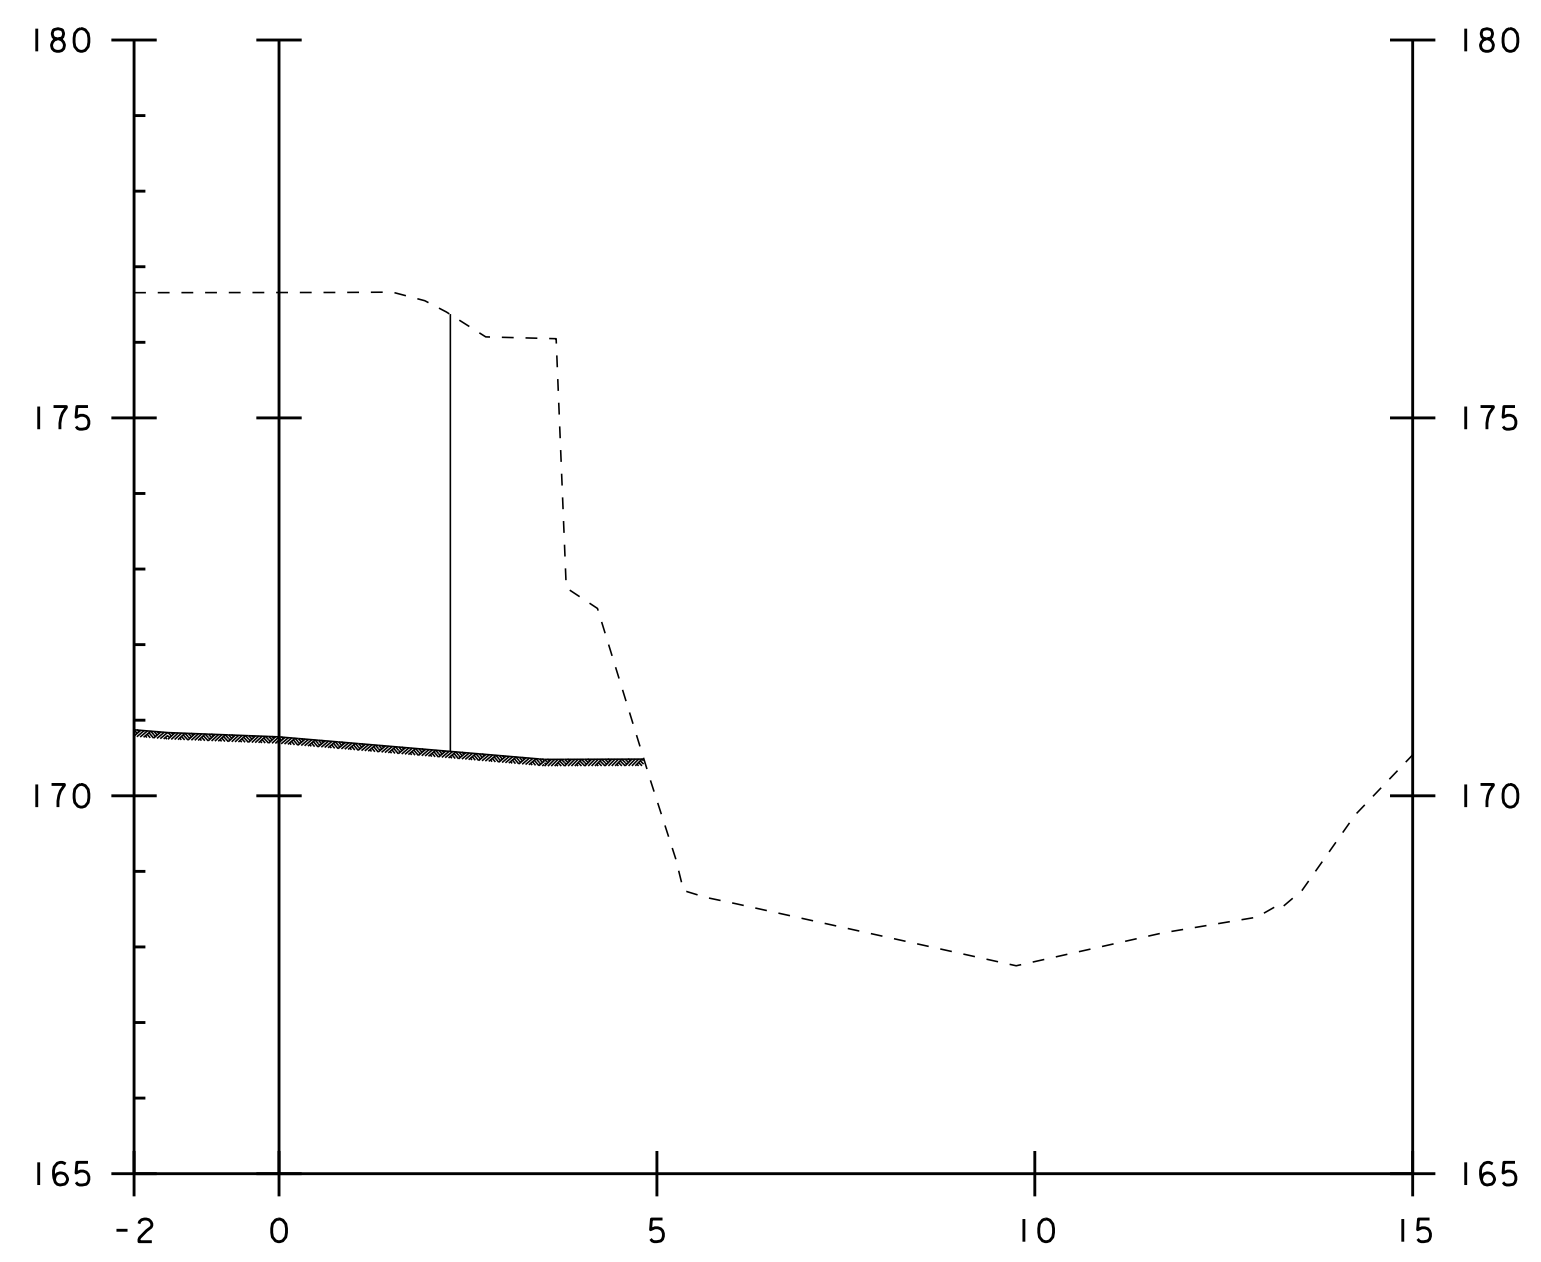

2+000.00

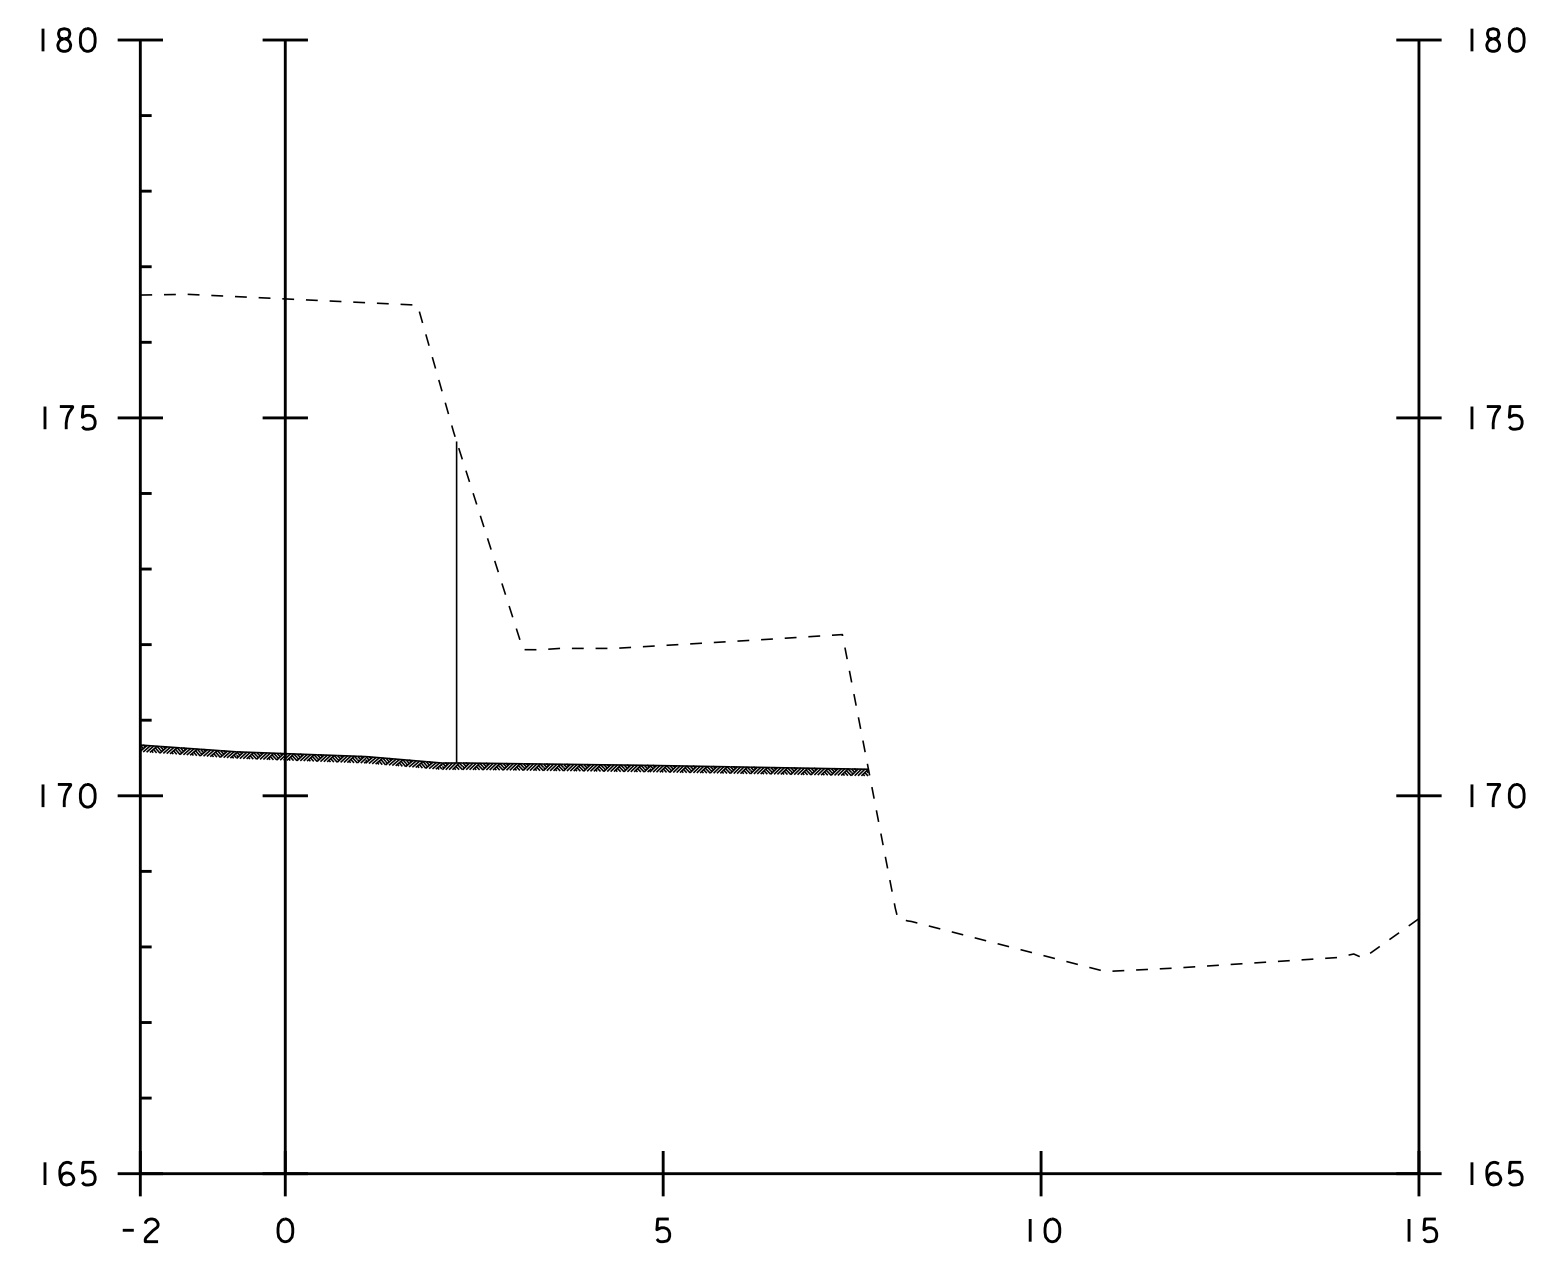

2+004.00

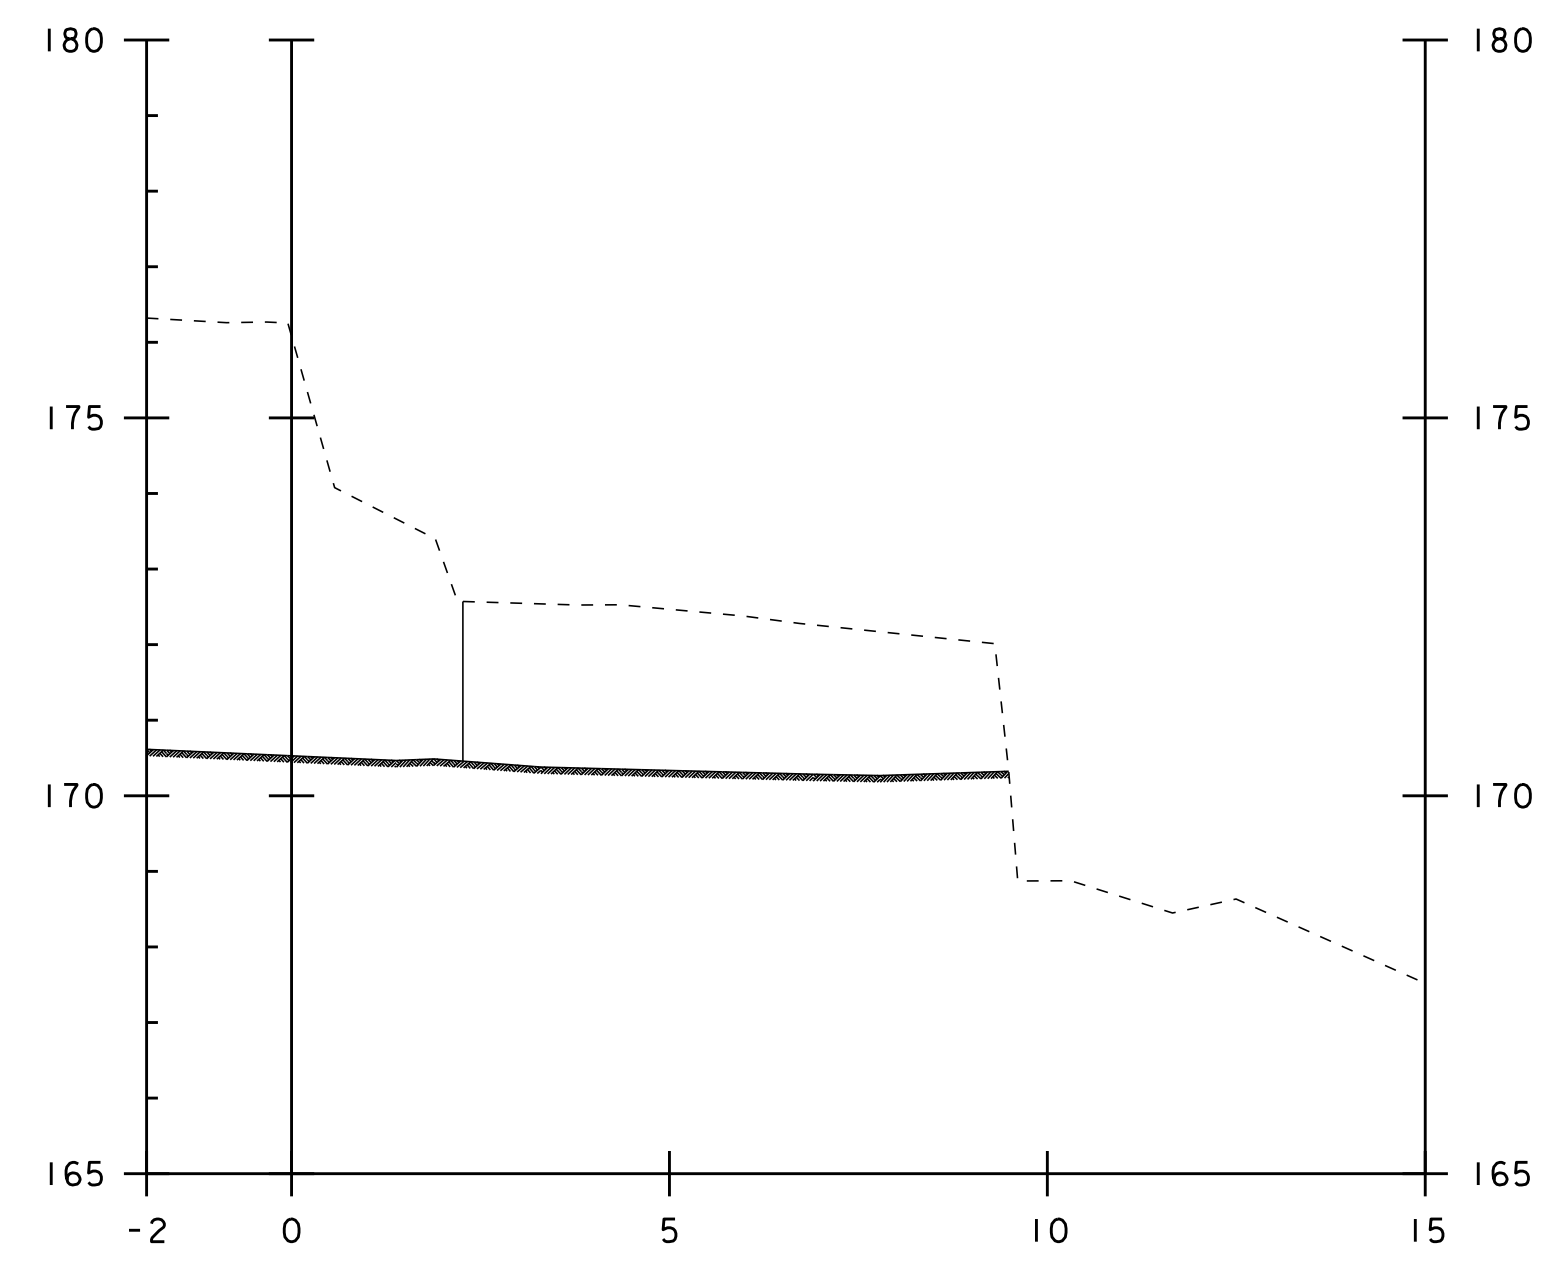

2+008.00

ABUTMENT TWO
 STRUCTURE EXCAVATION
 UNCLASSIFIED CHANNEL EXCAVATION

