


3+082.60



3+087.60

GIRDER I CLEARANCE
UNCLASSIFIED CHANNEL EXCAVATION

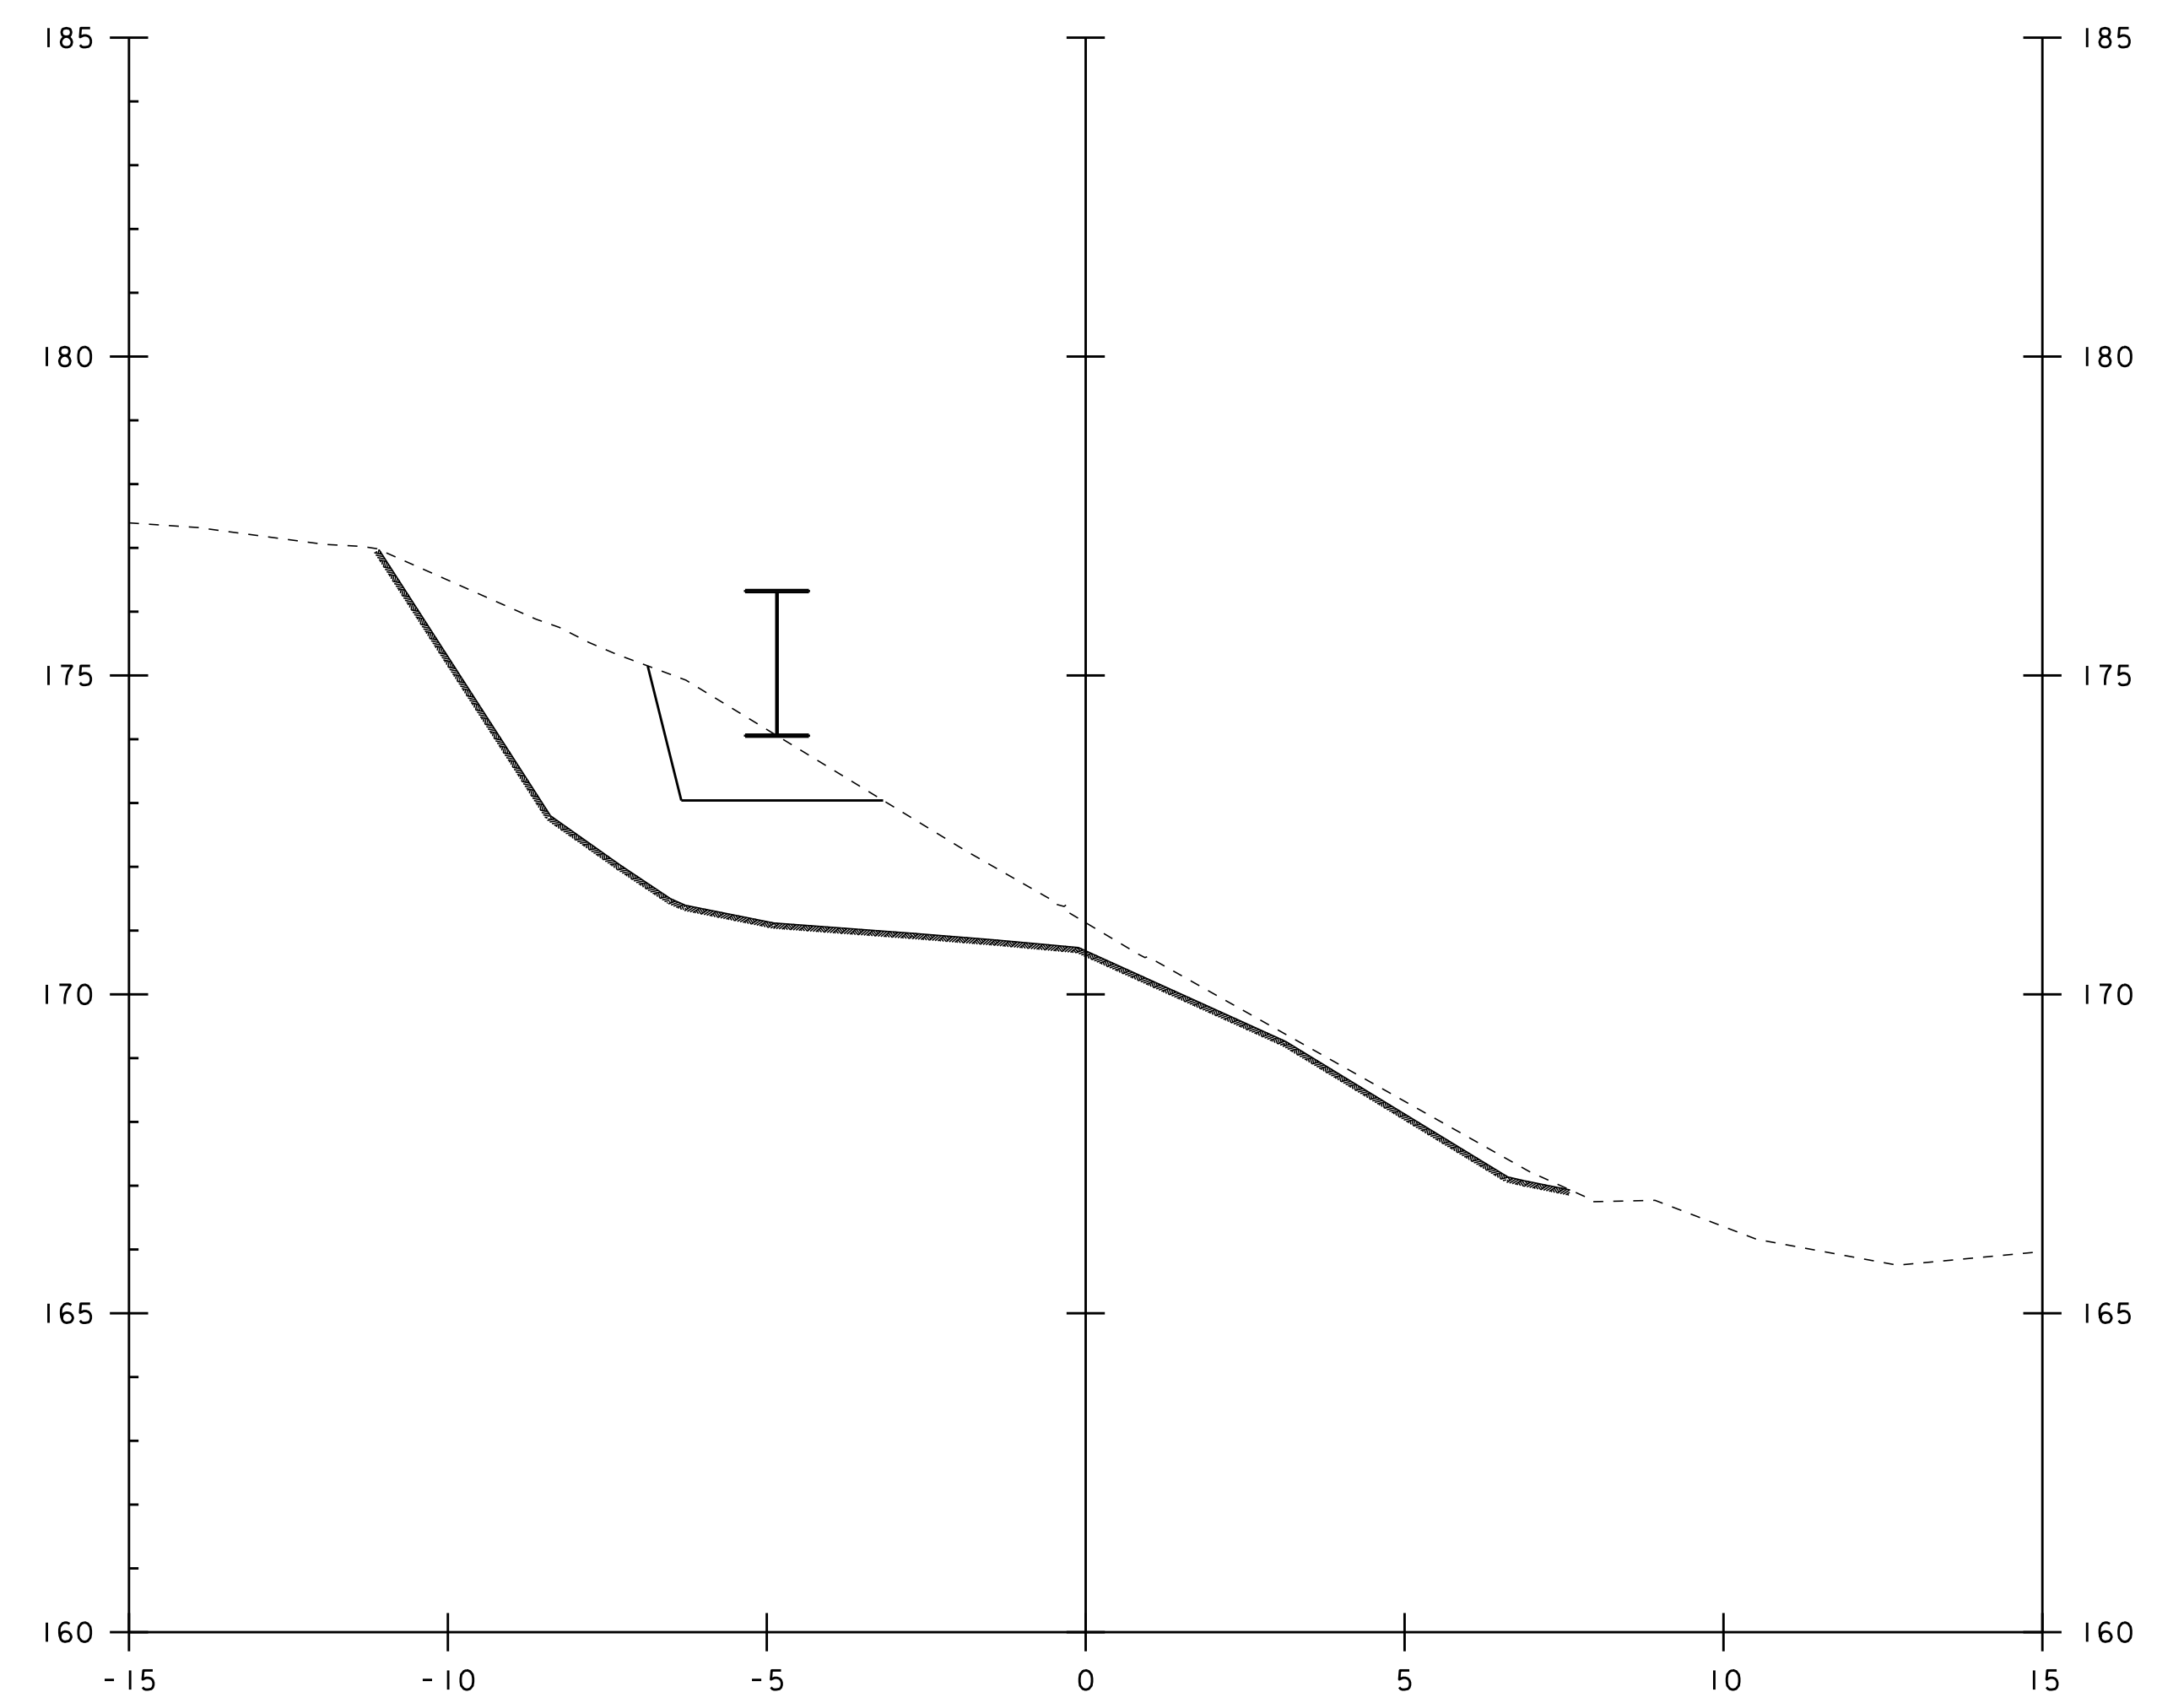