



3+067.80

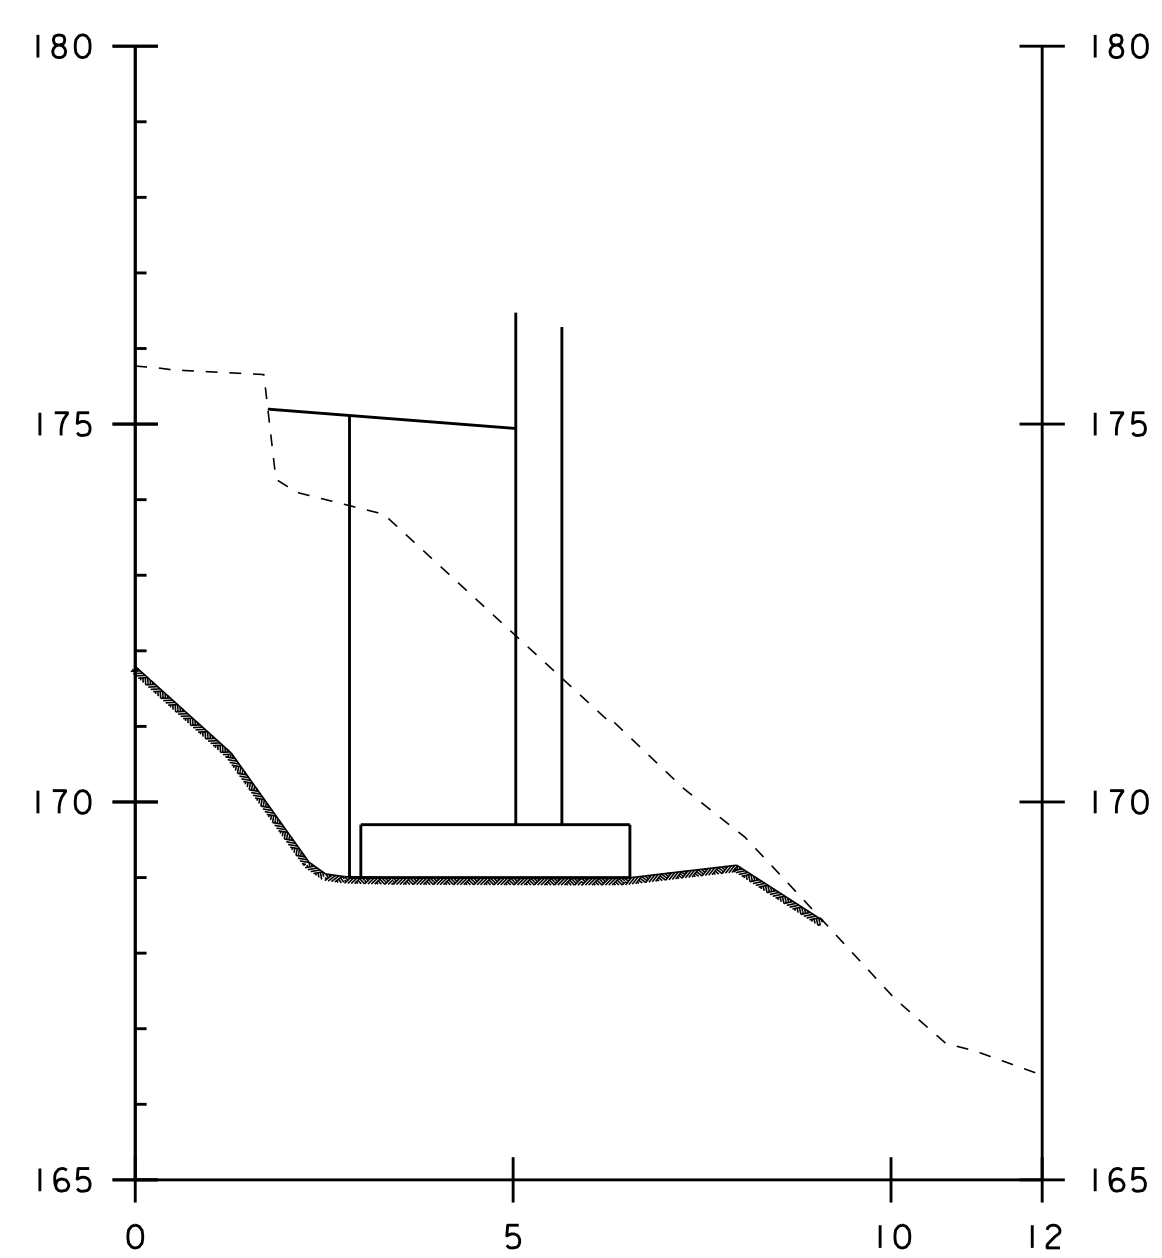

3+070.50

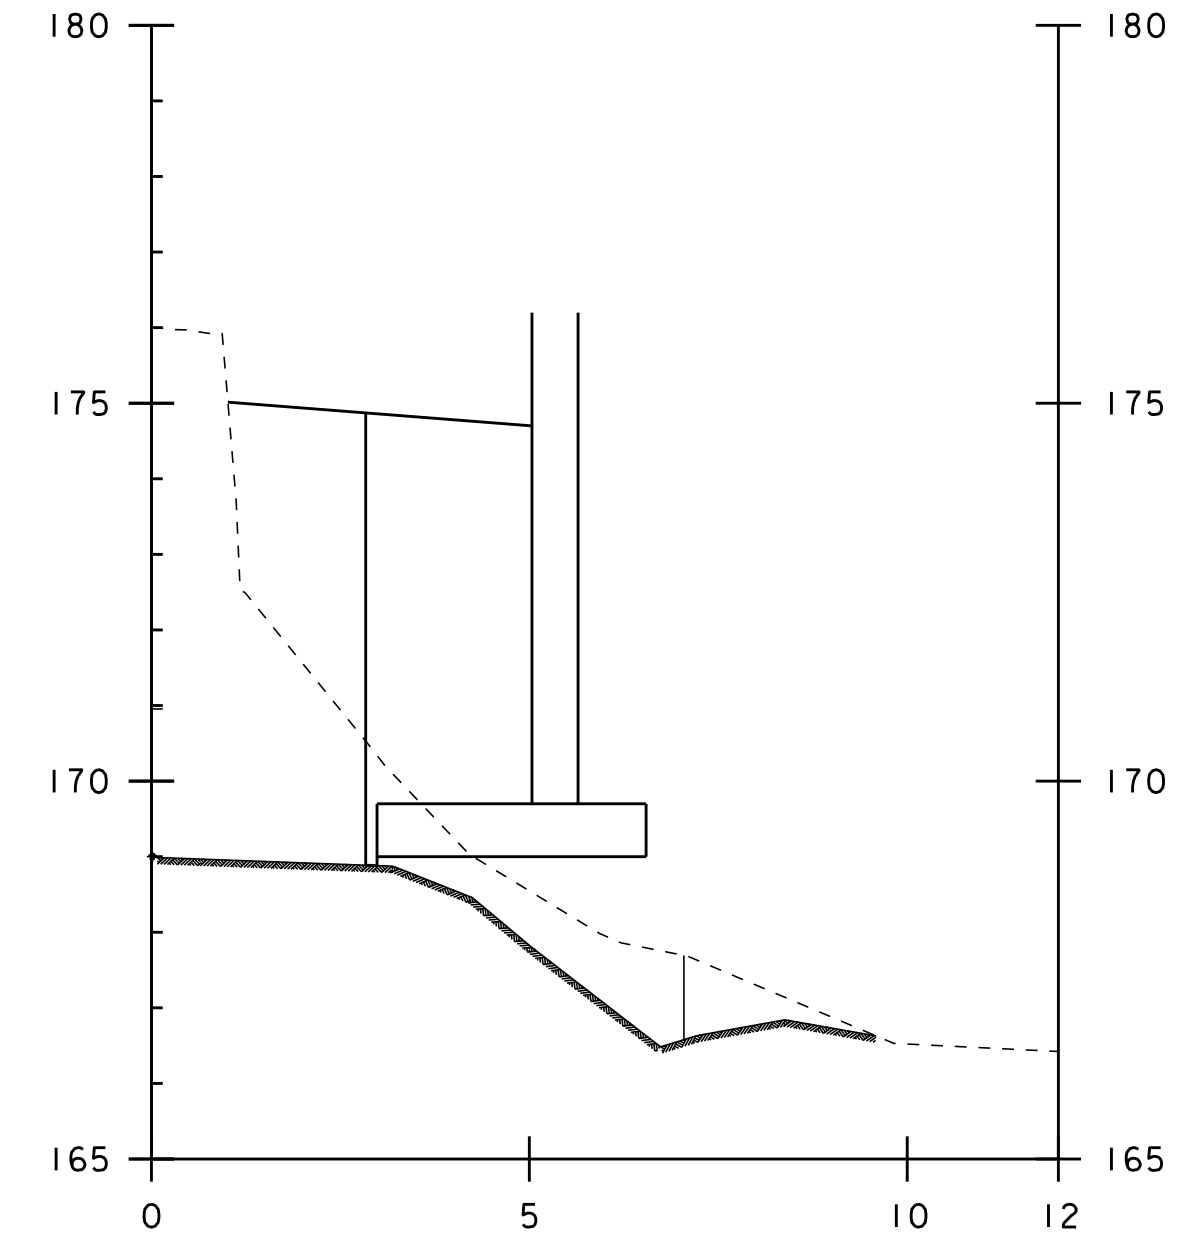

3+078.50

RT5 MAINLINE
GRANULAR BORROW

