




3+110.30

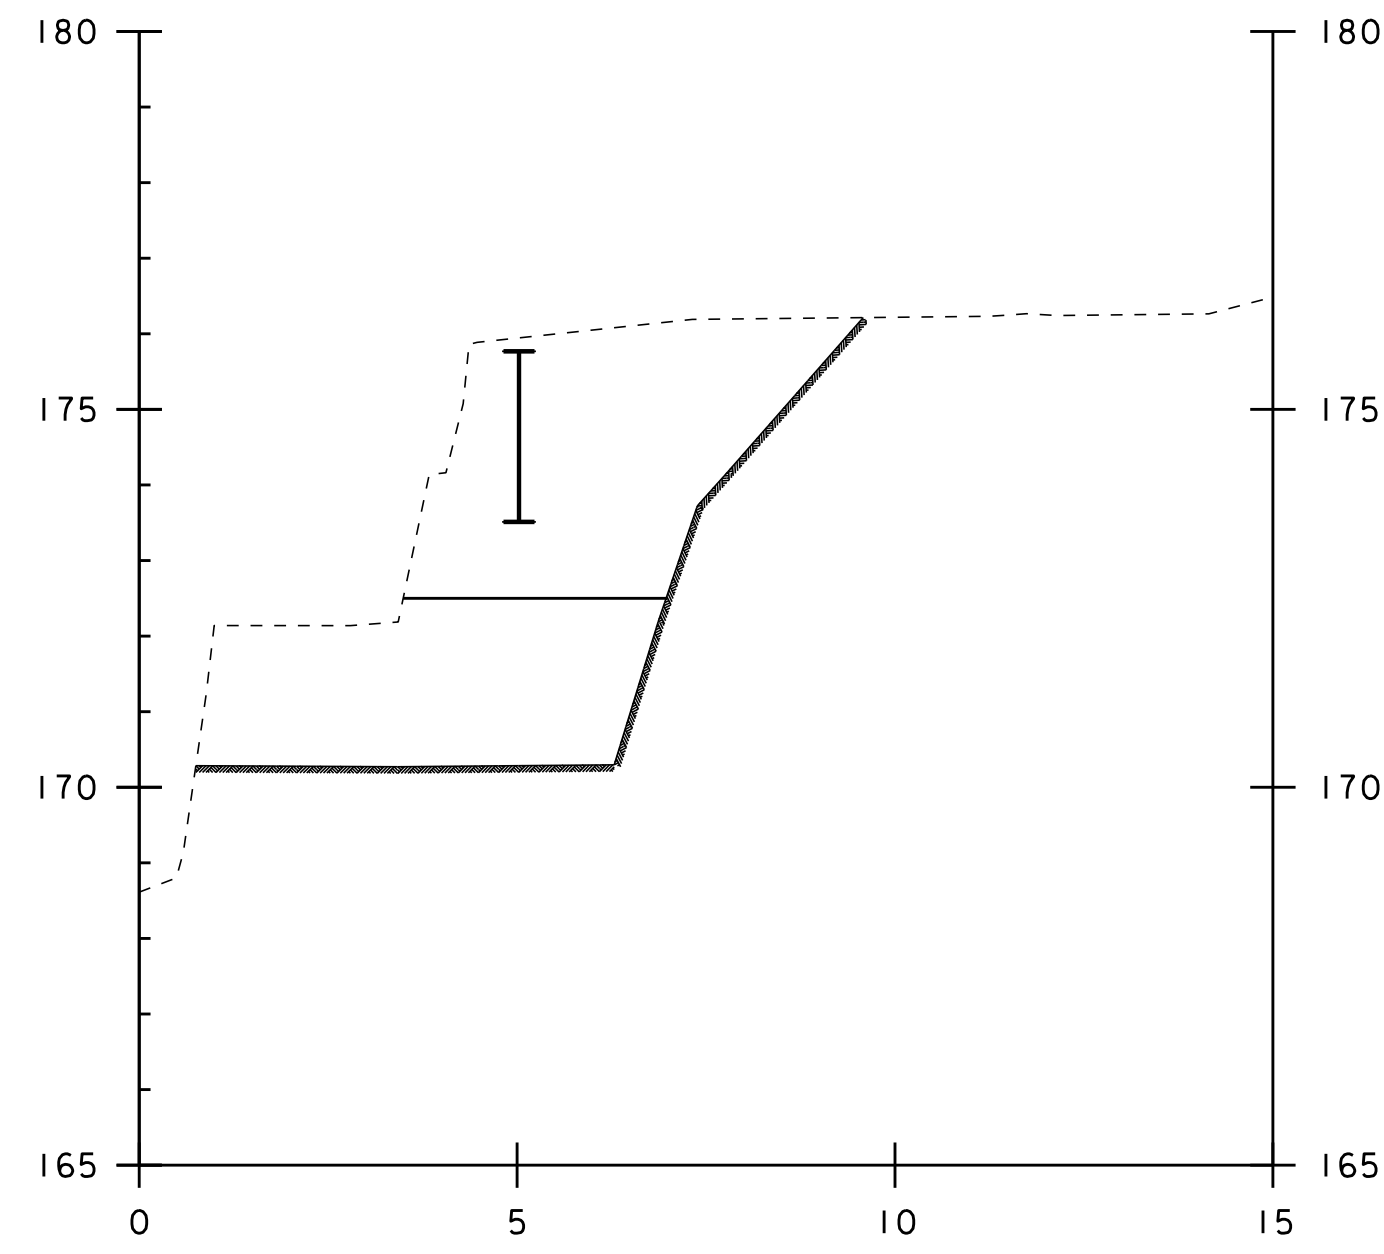


3+114.30

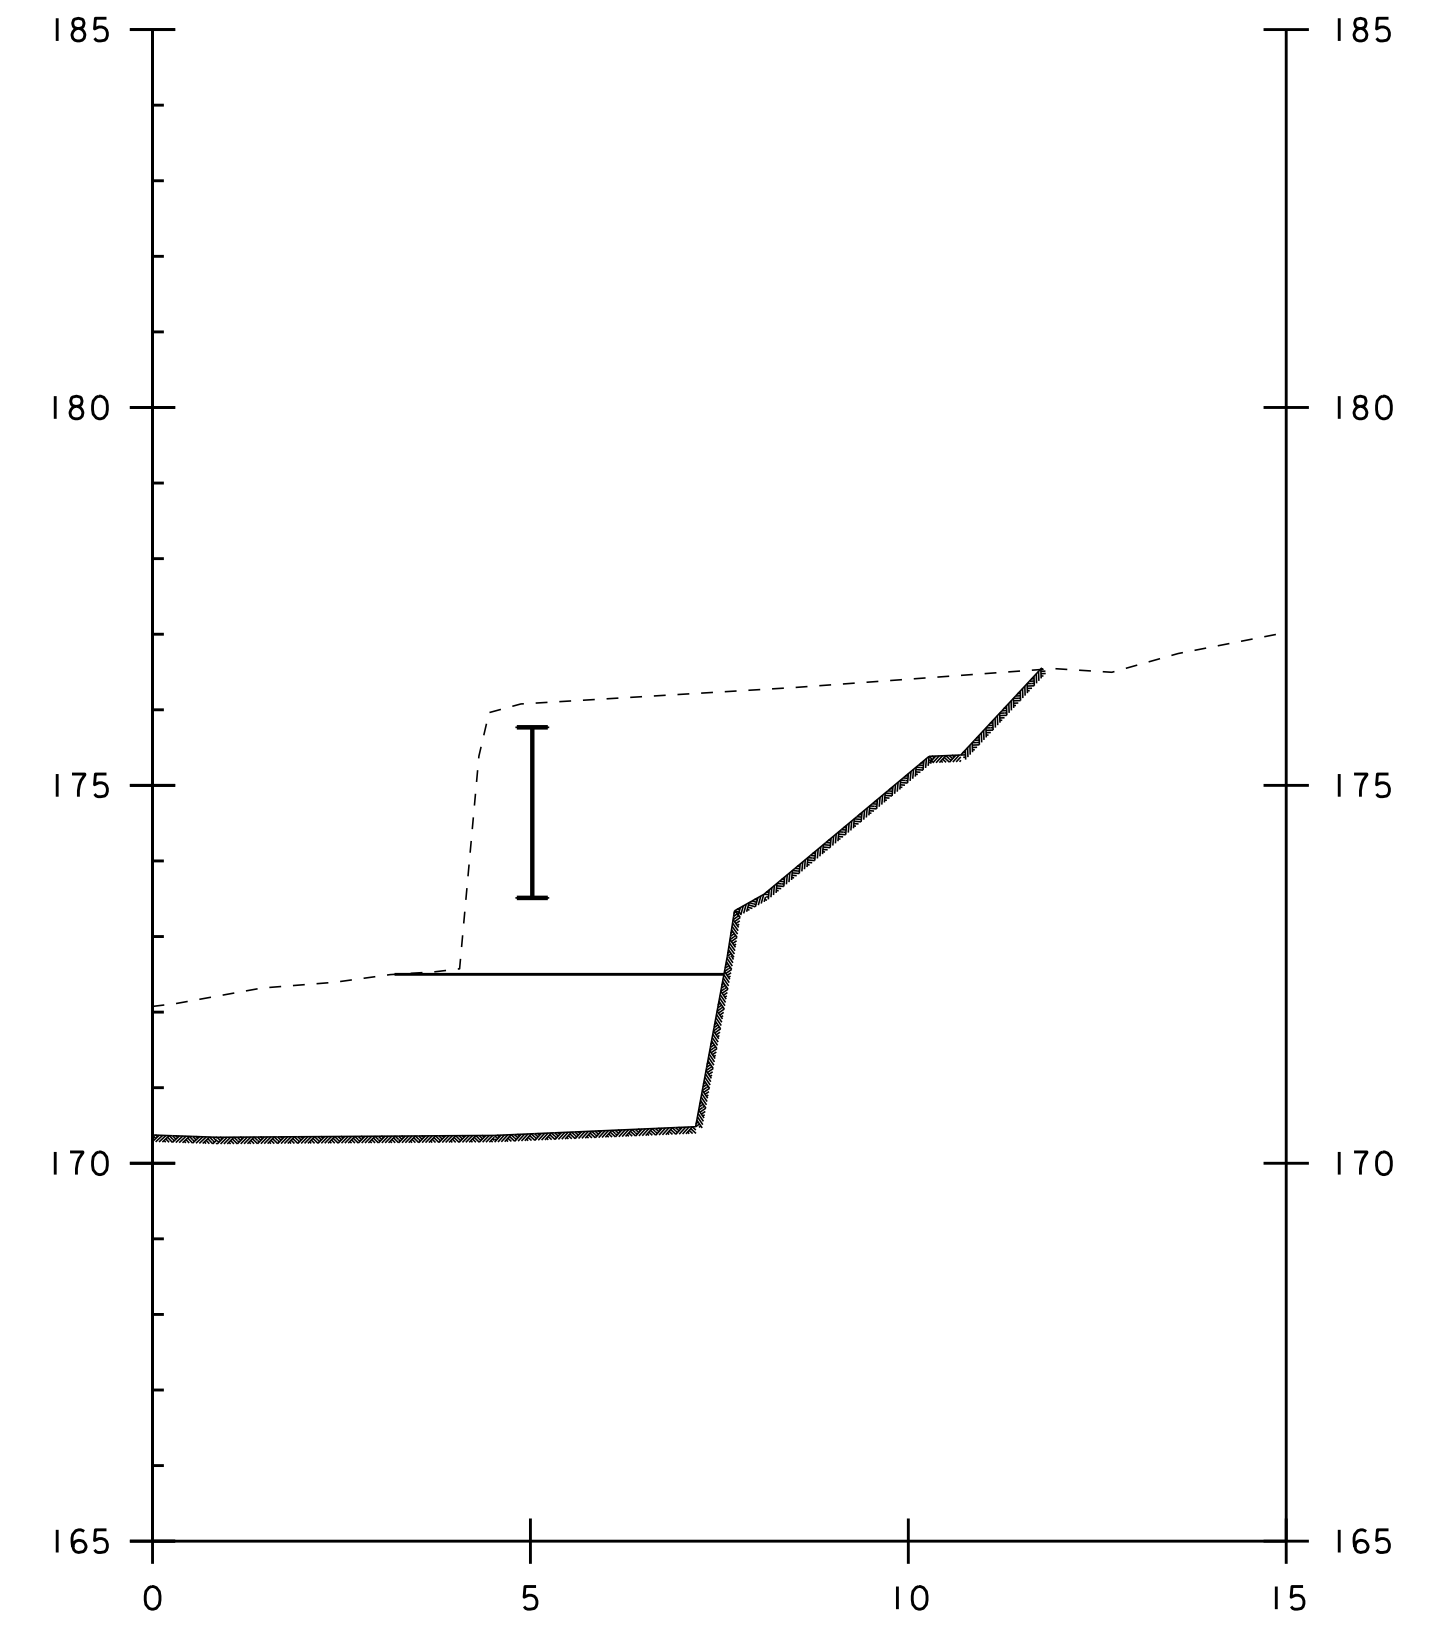


3+118.30

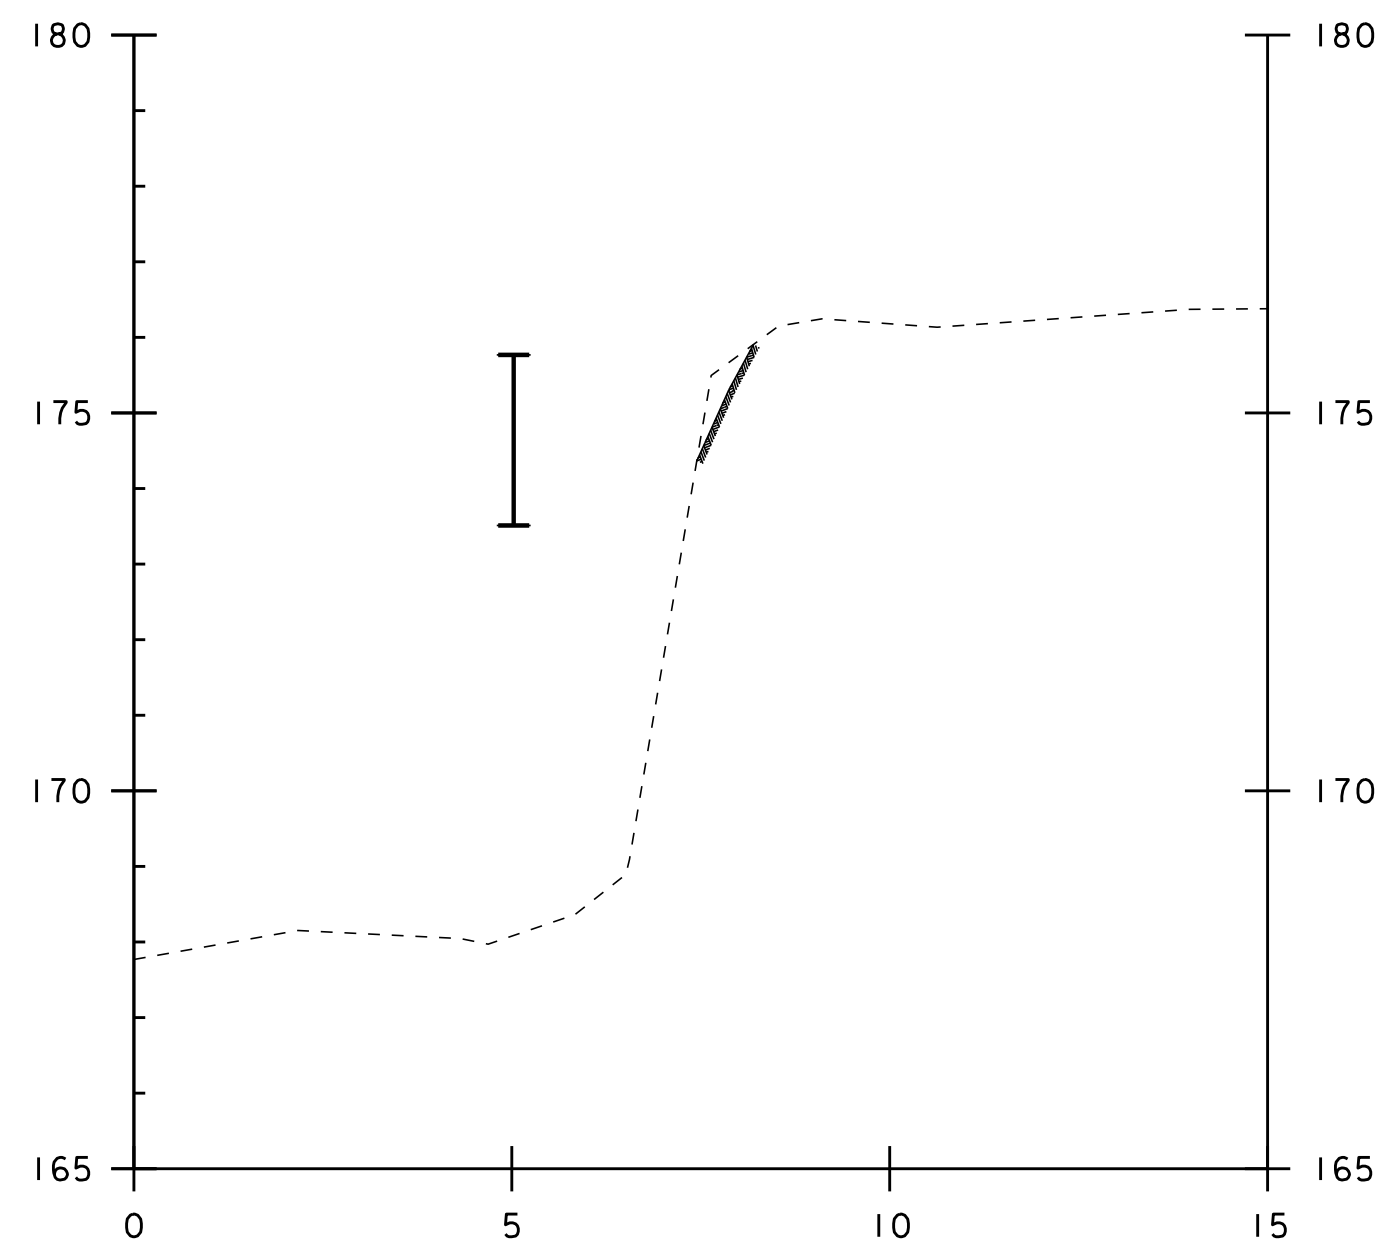

3+108.30

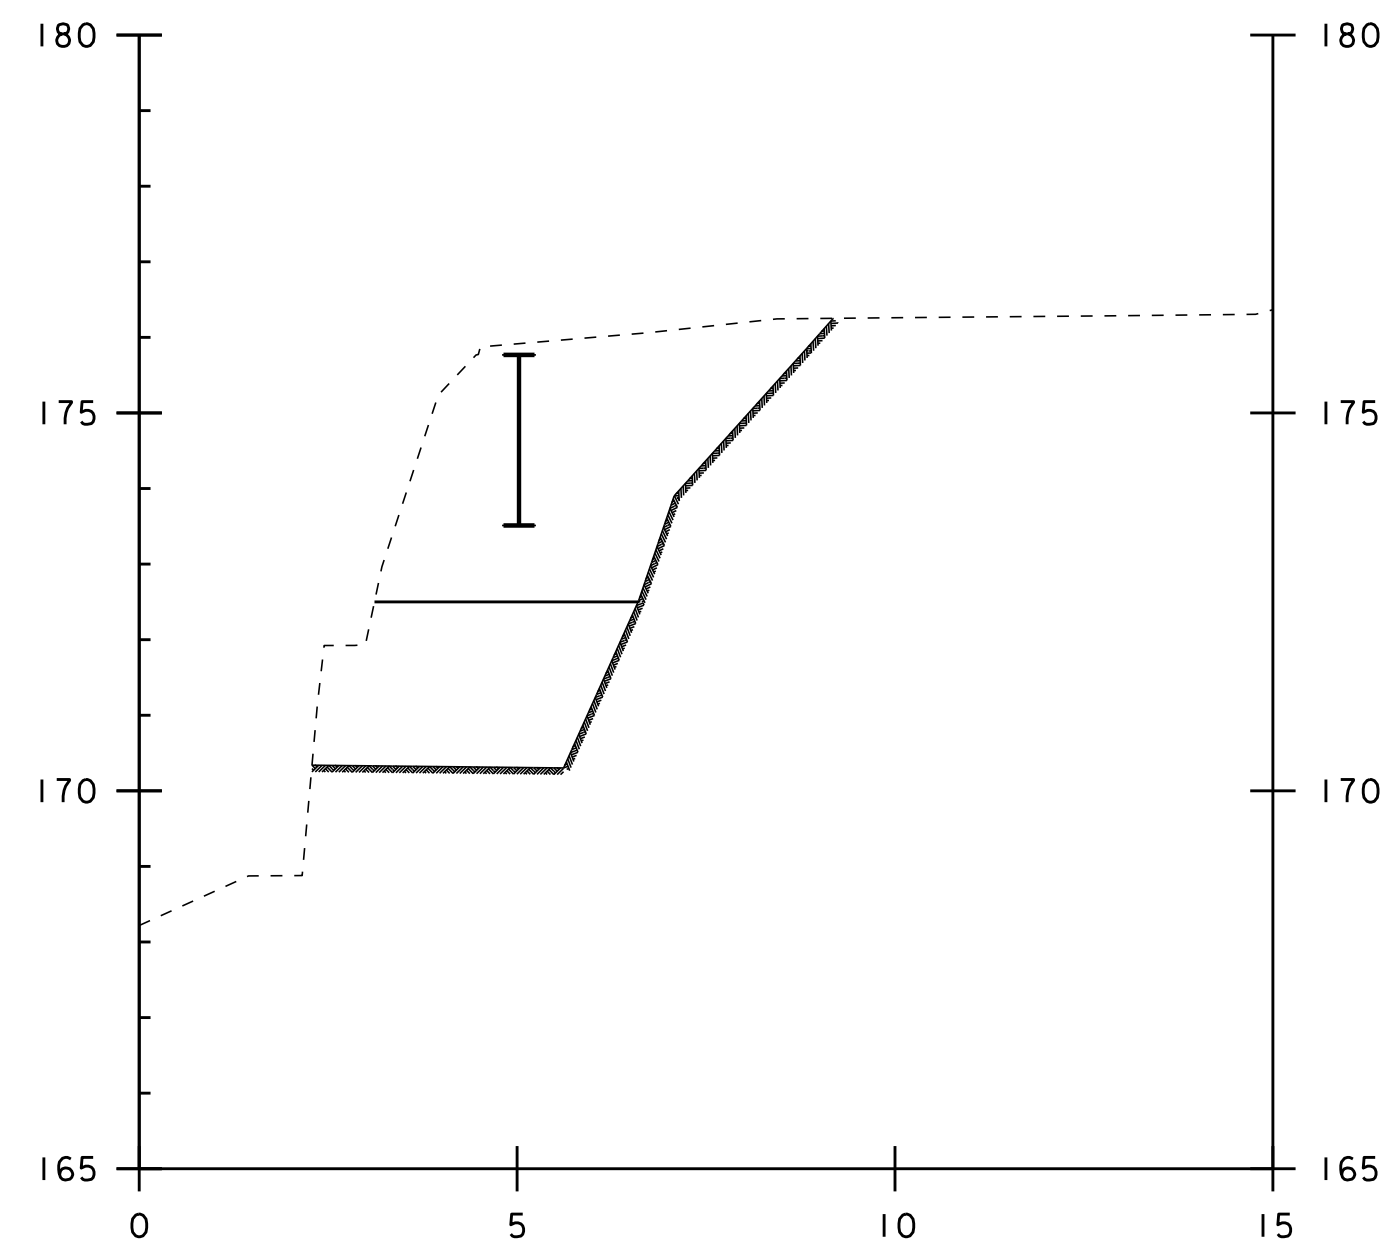

3+112.30

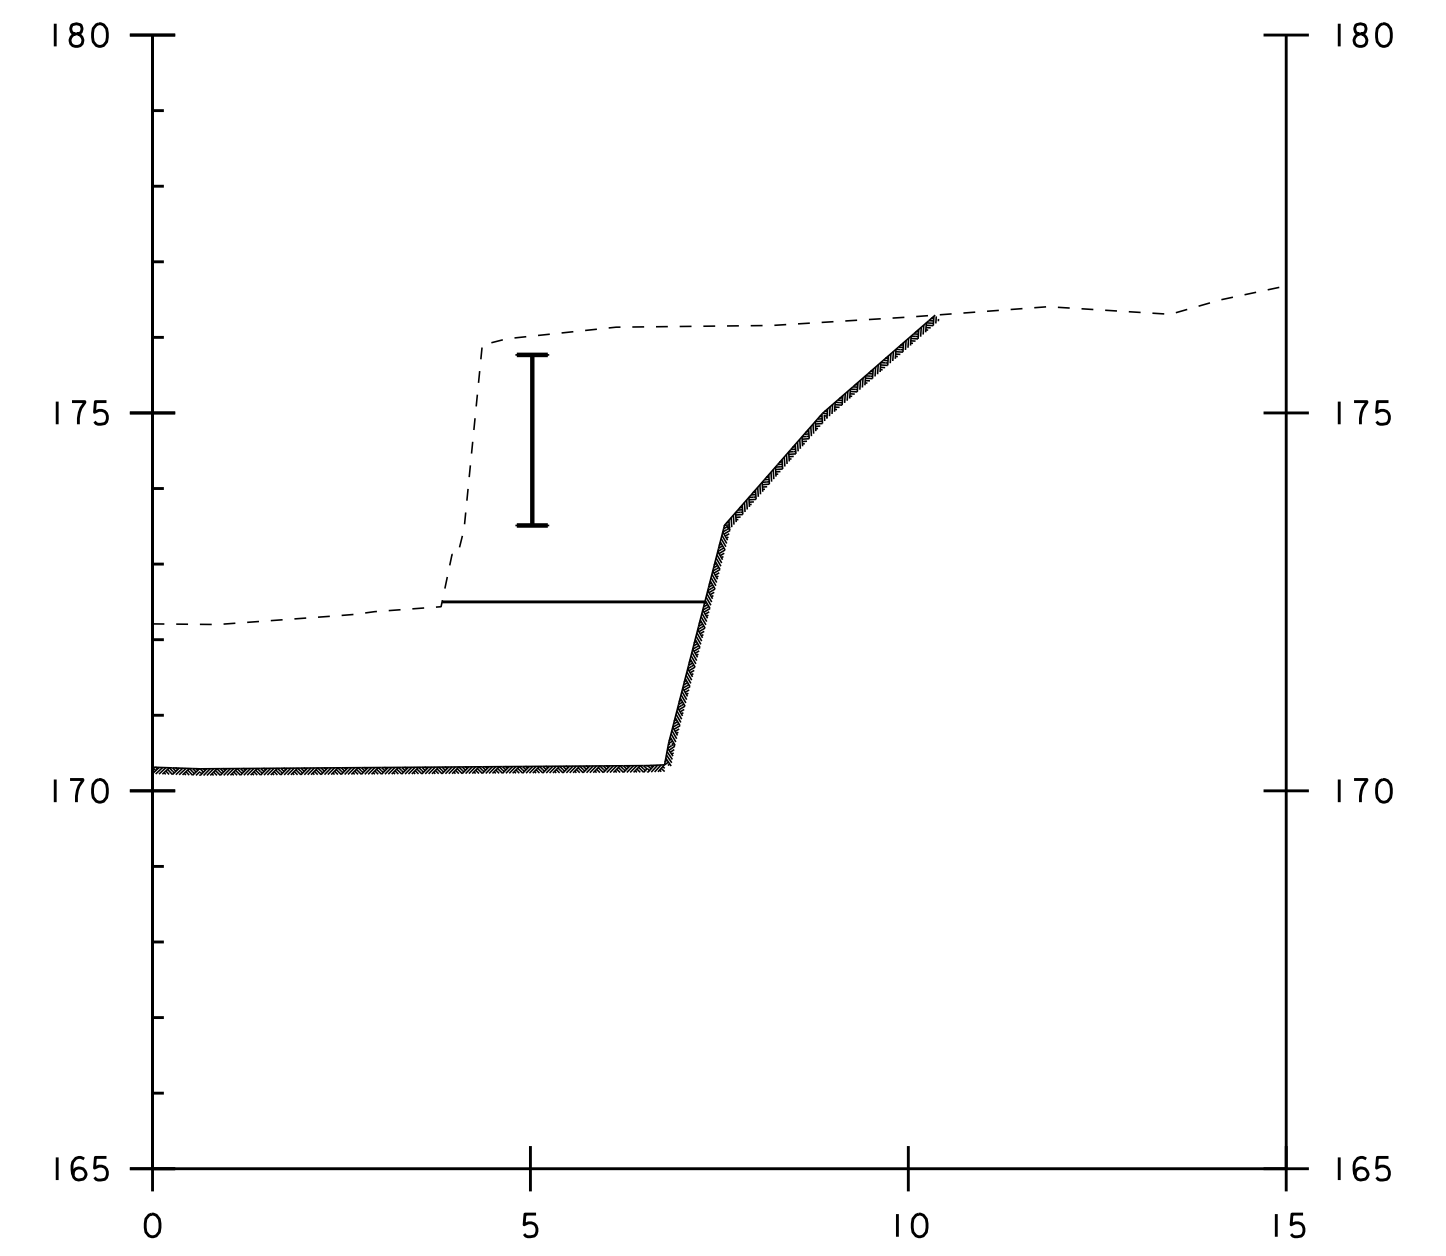

3+116.30

GIRDER 5 CLEARANCE
UNCLASSIFIED CHANNEL EXCAVATION

