




3+077.00

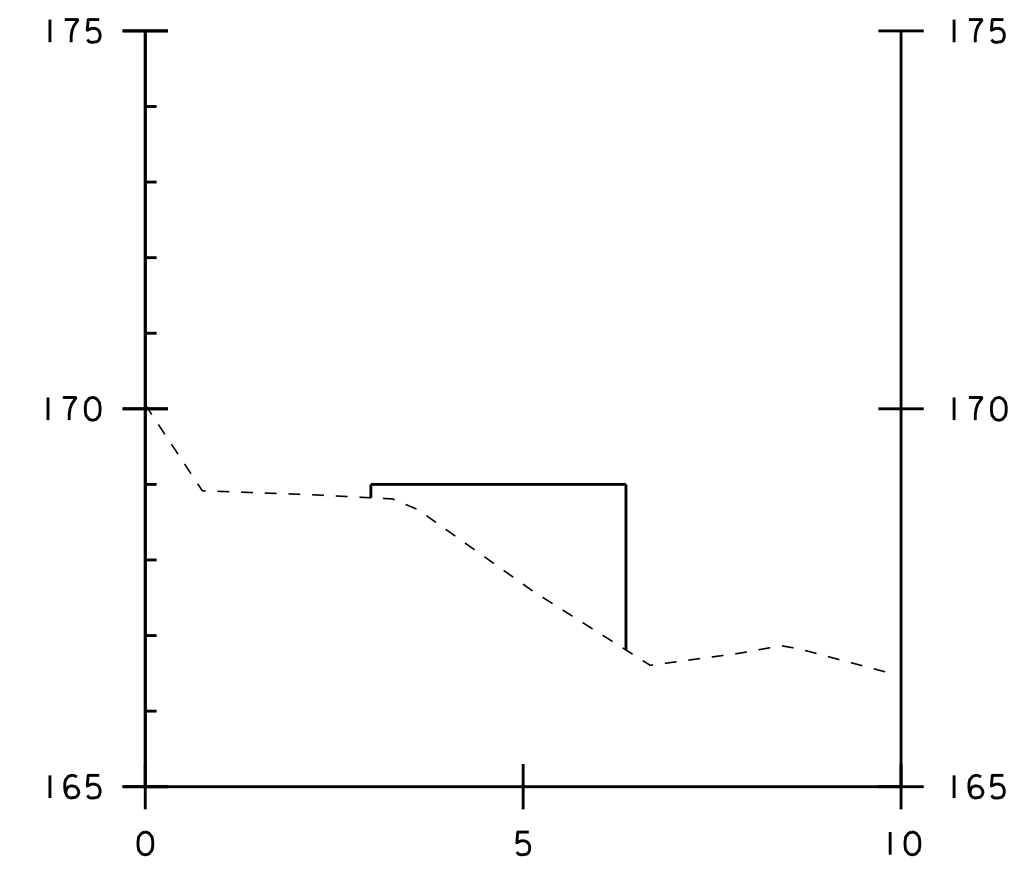


3+080.00

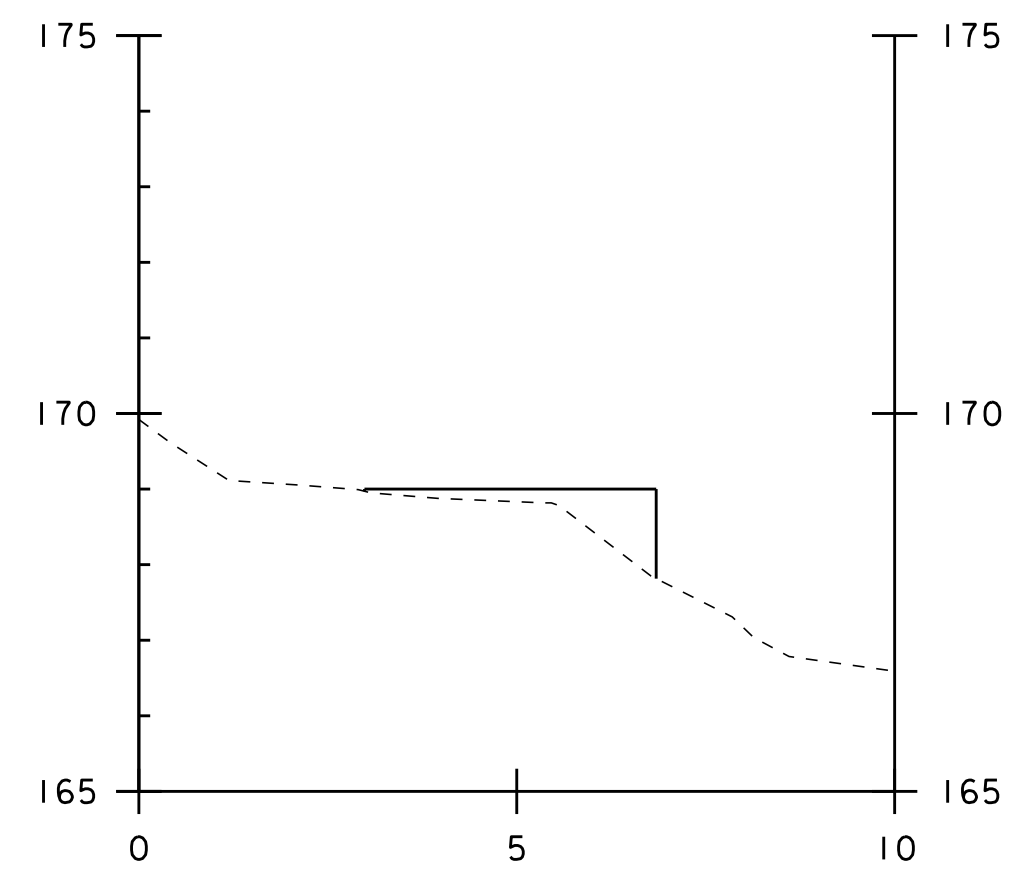


3+076.00

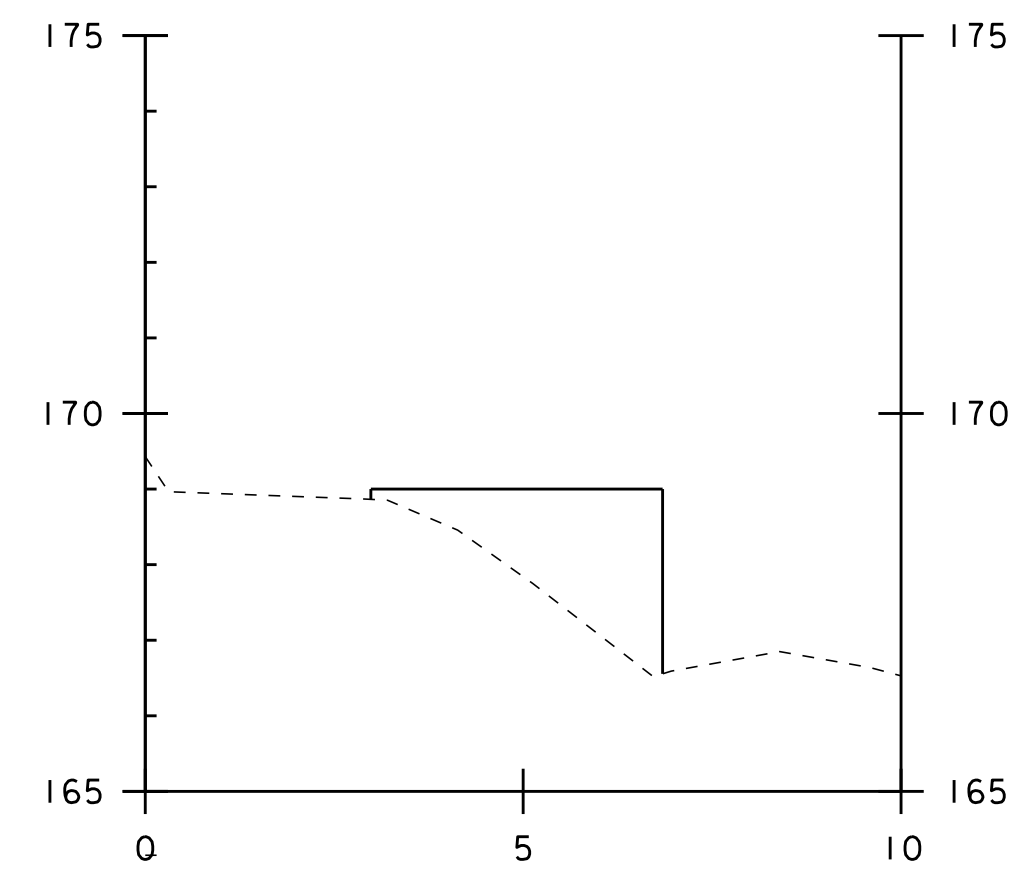


3+079.00

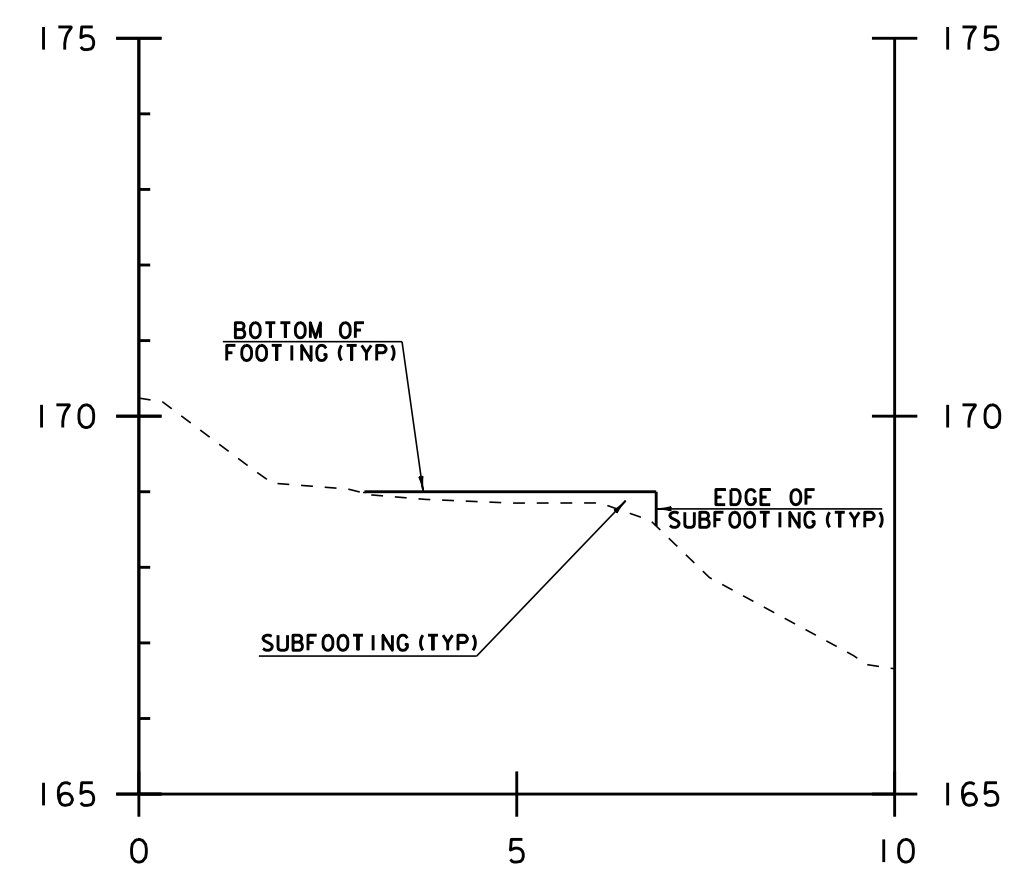

3+075.00

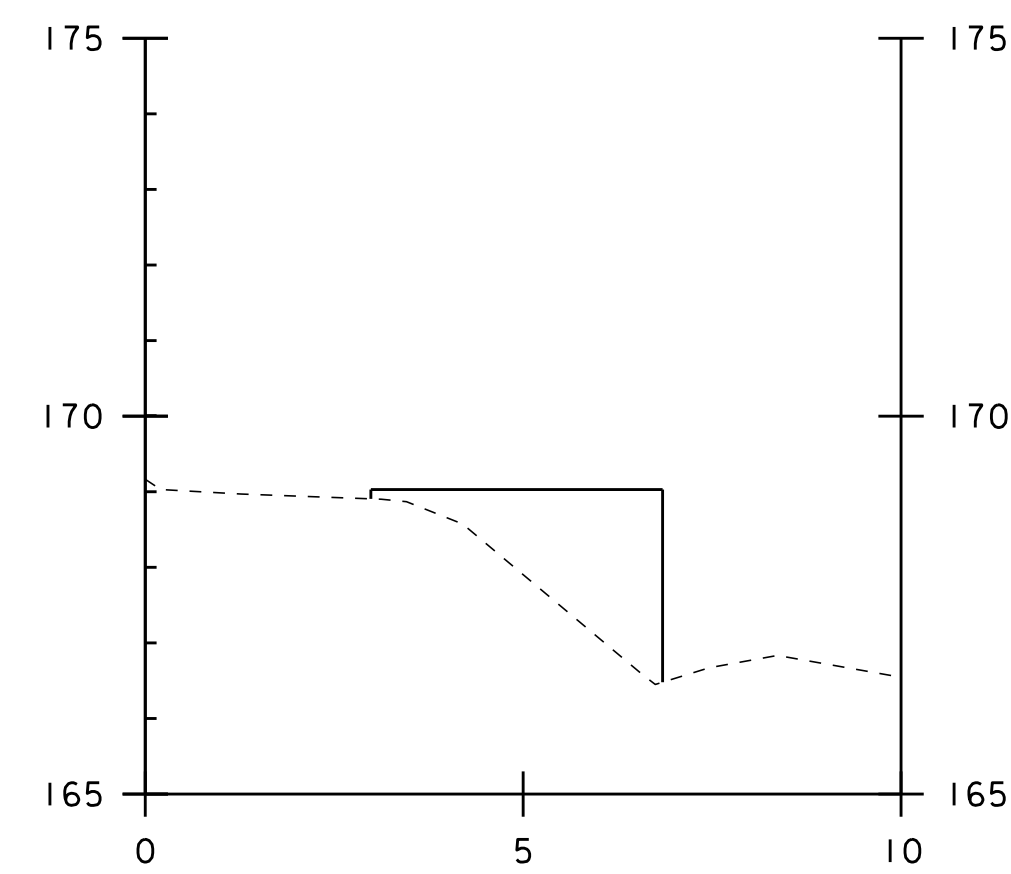

3+078.00

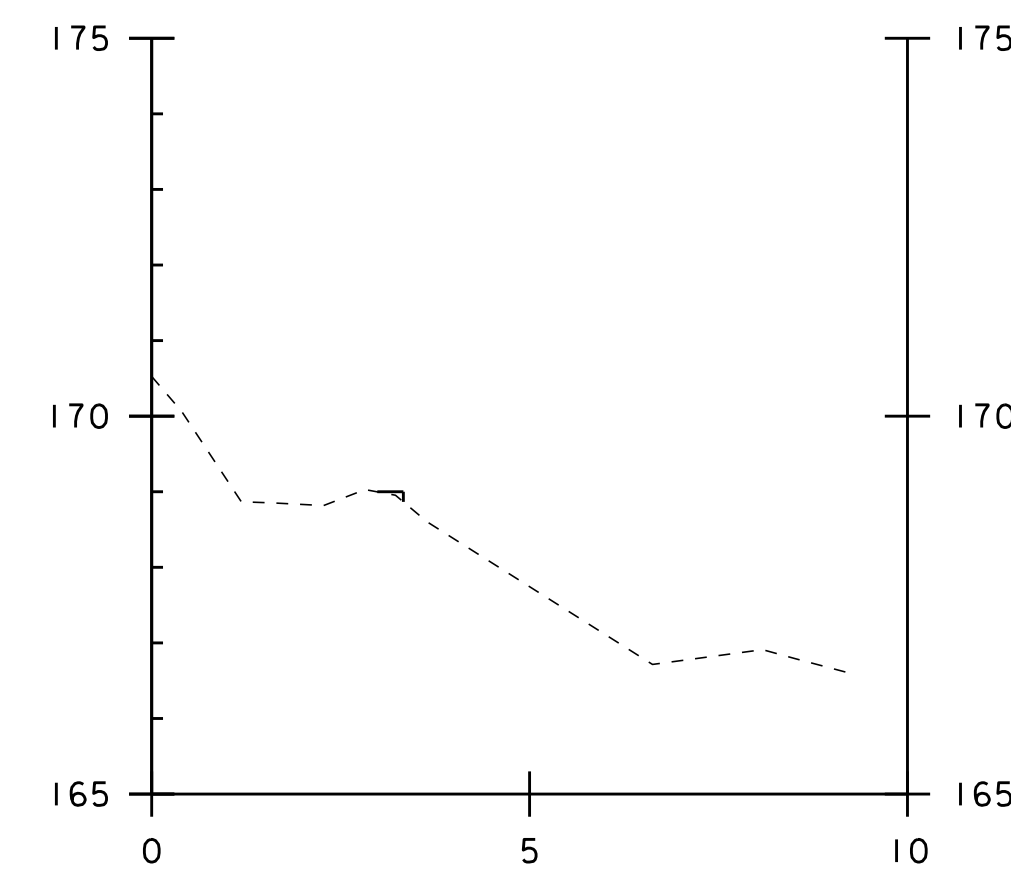

3+081.00

ABUTMENT ONE  
SUBFOOTING CONCRETE

