


3+011.00



3+134.00

TRENCH EXCAVATION OF EARTH
TRENCH EXCAVATION OF ROCK

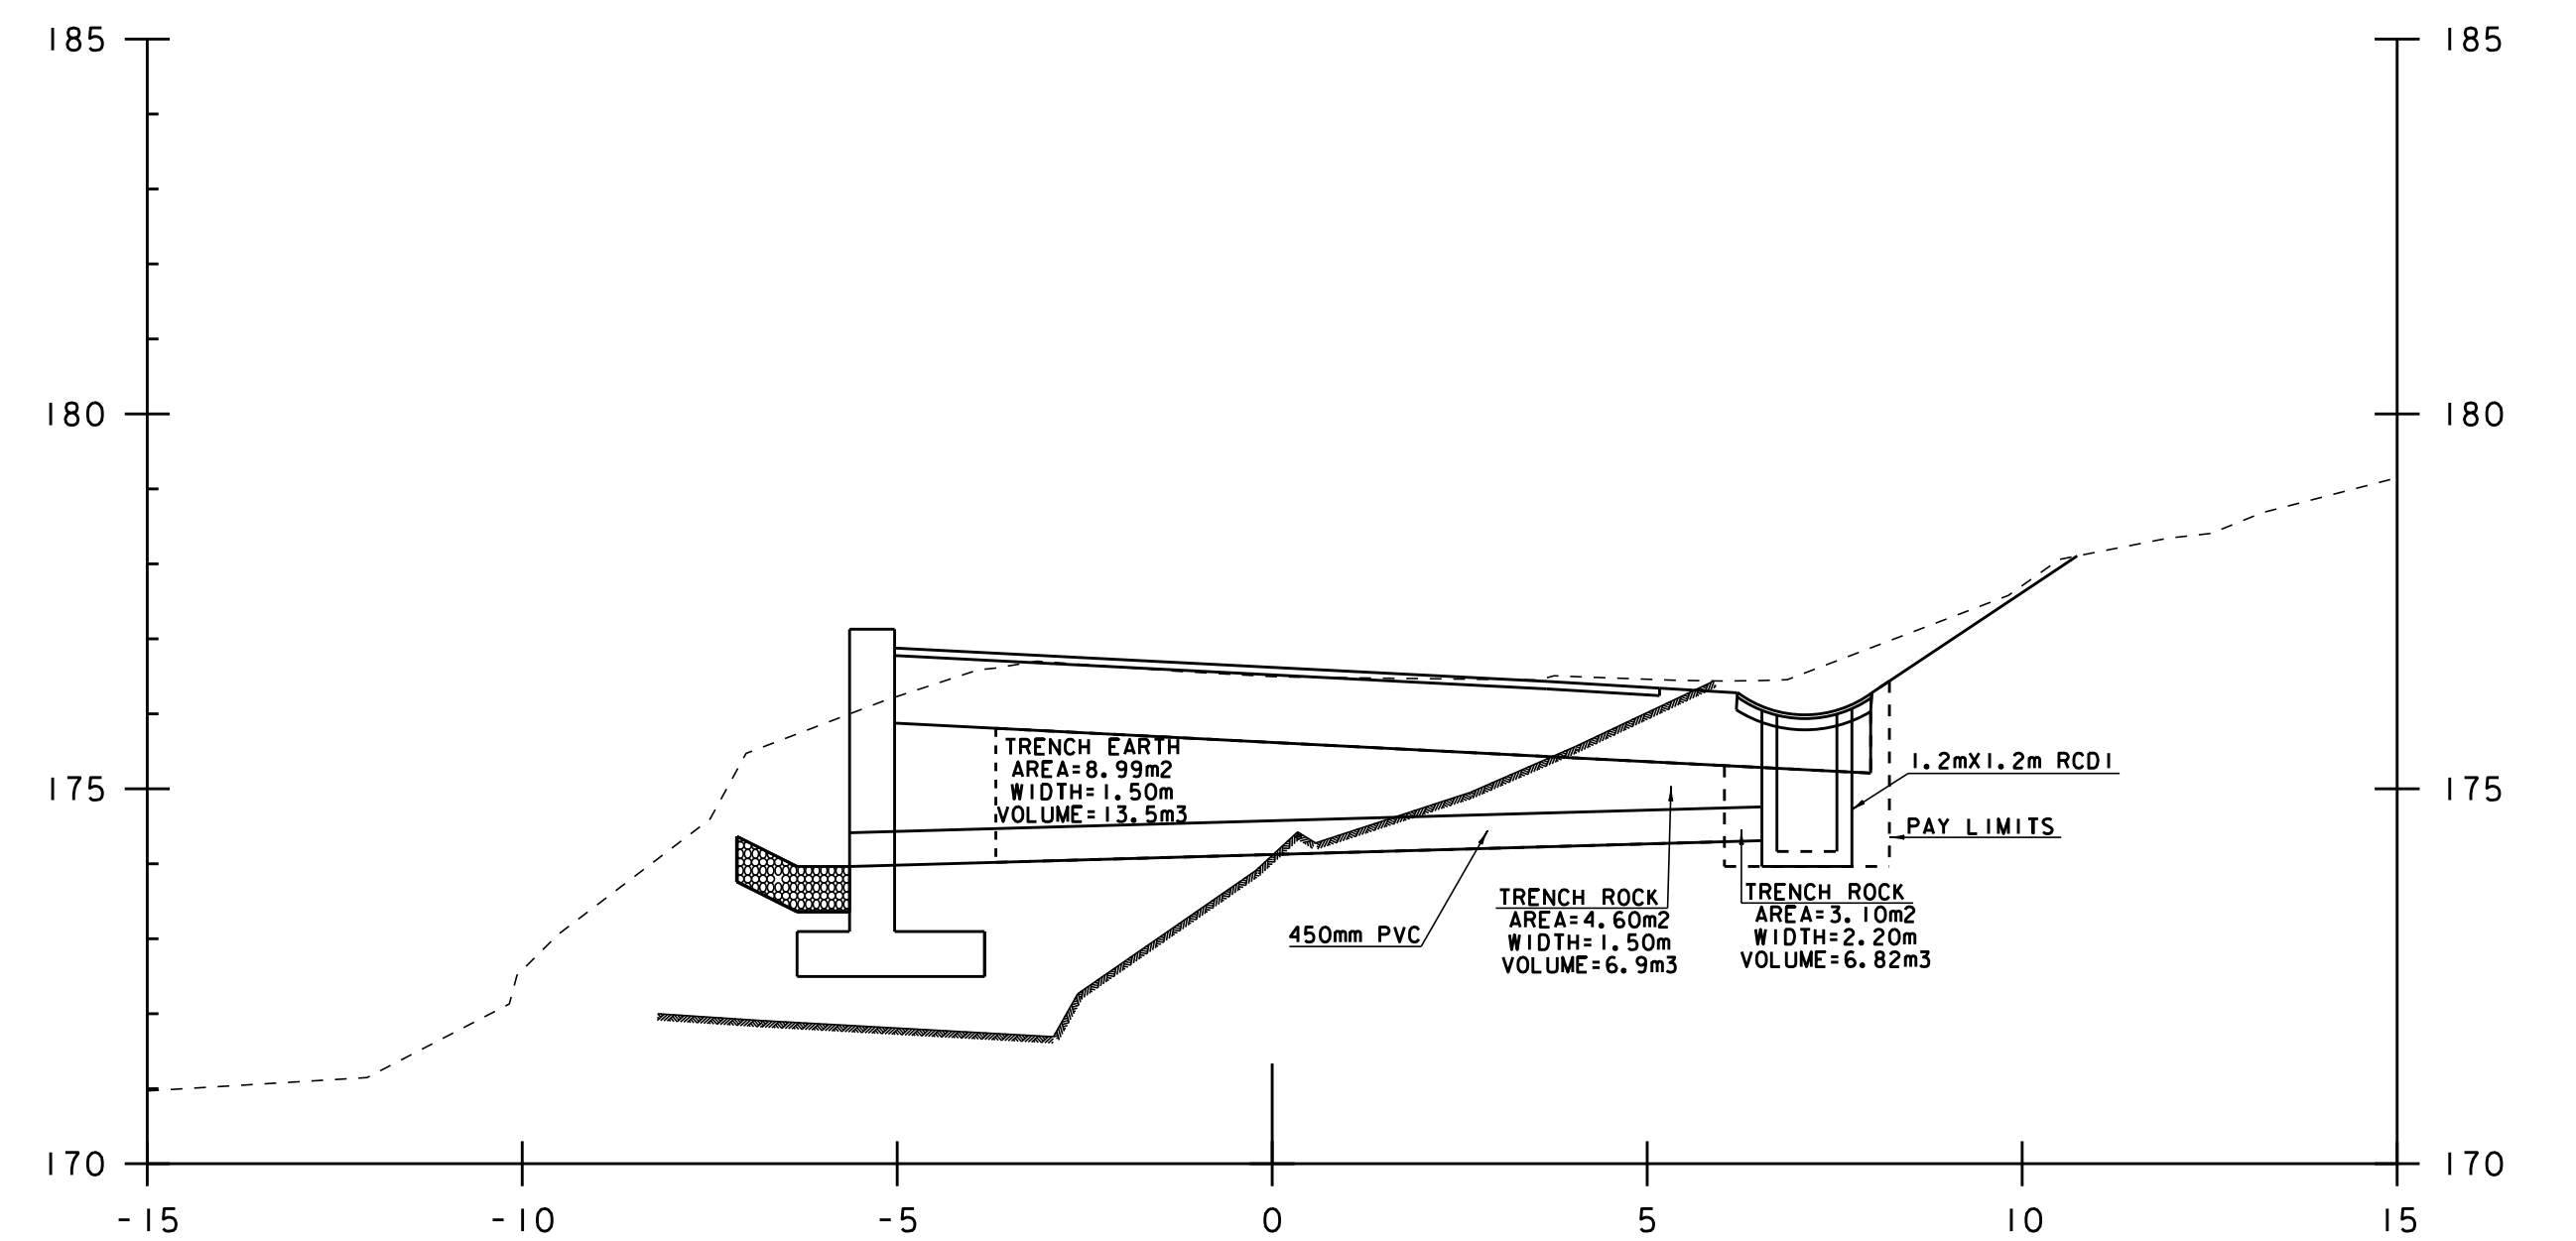