




3+044.50

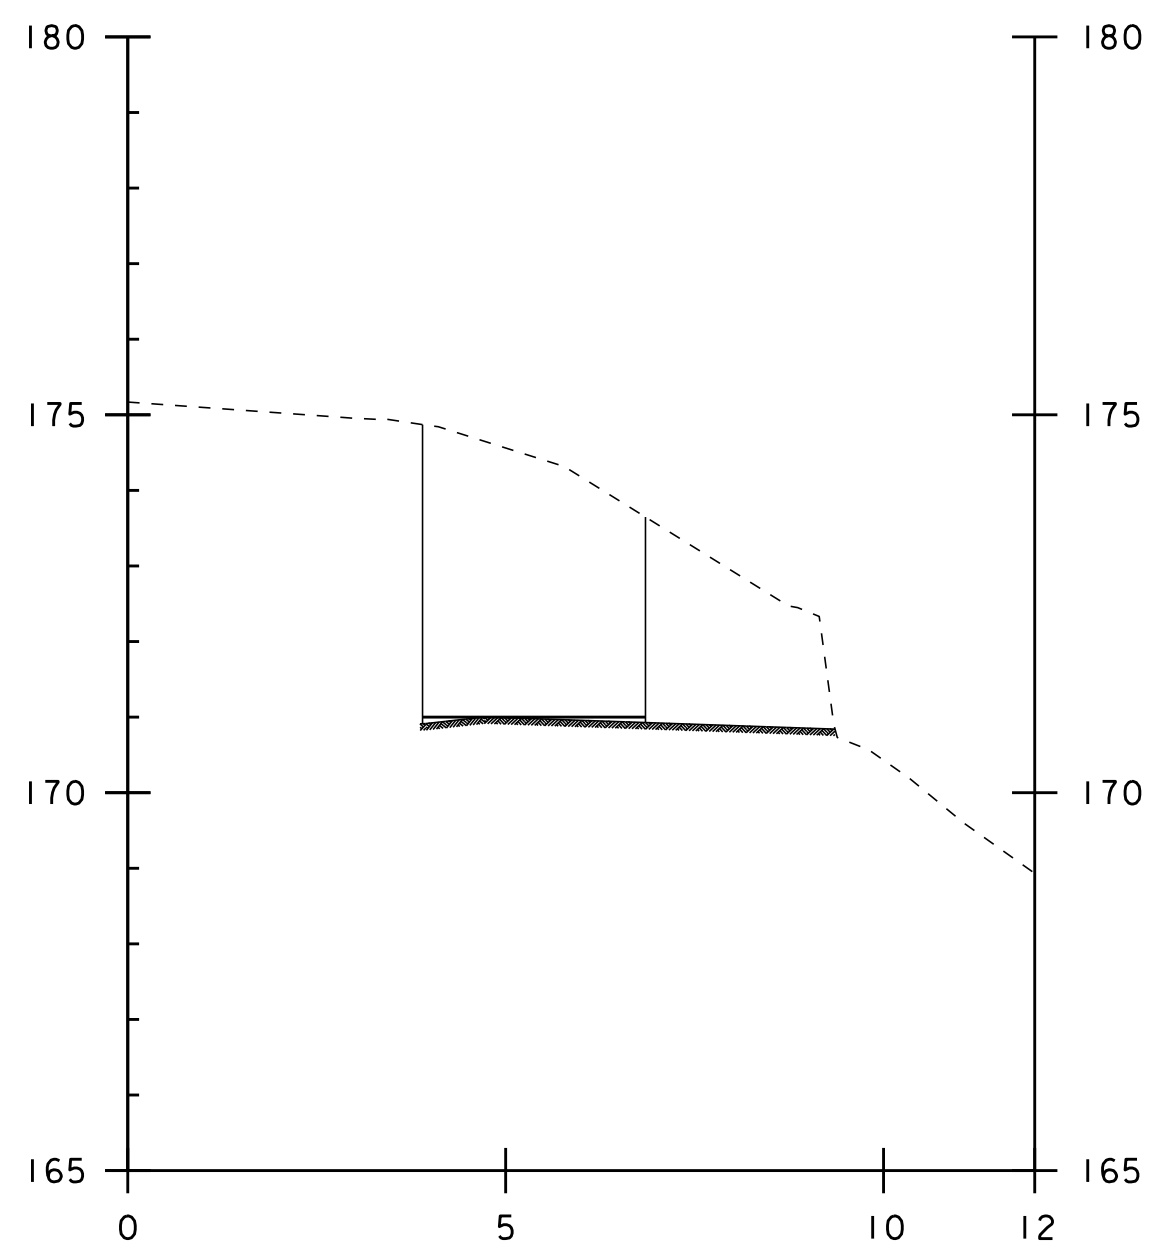


3+048.50

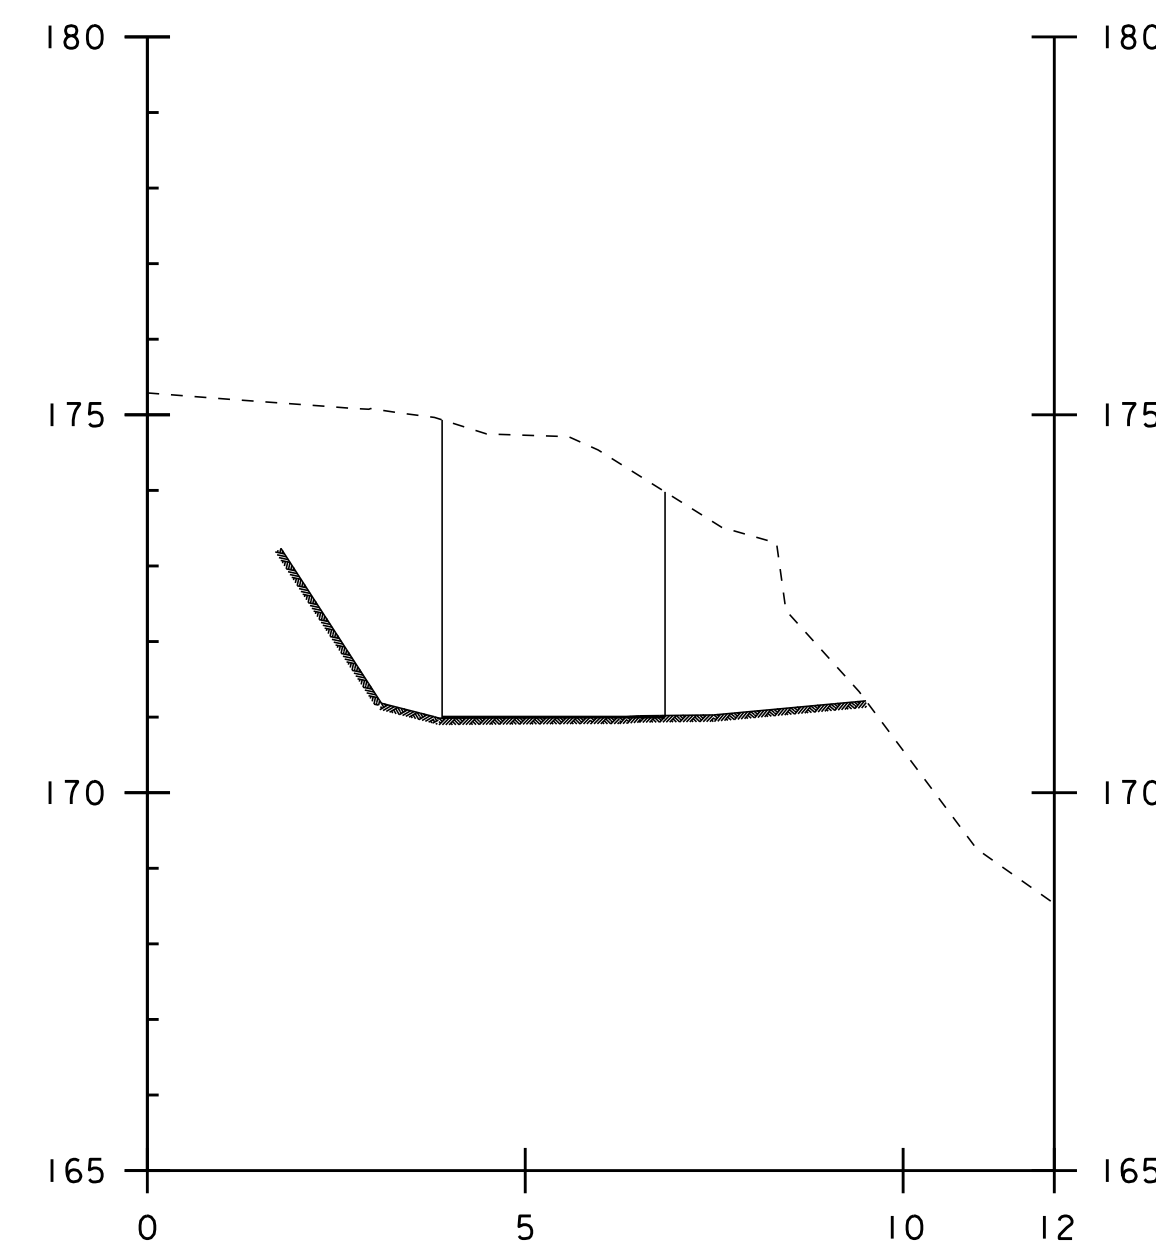


3+051.80

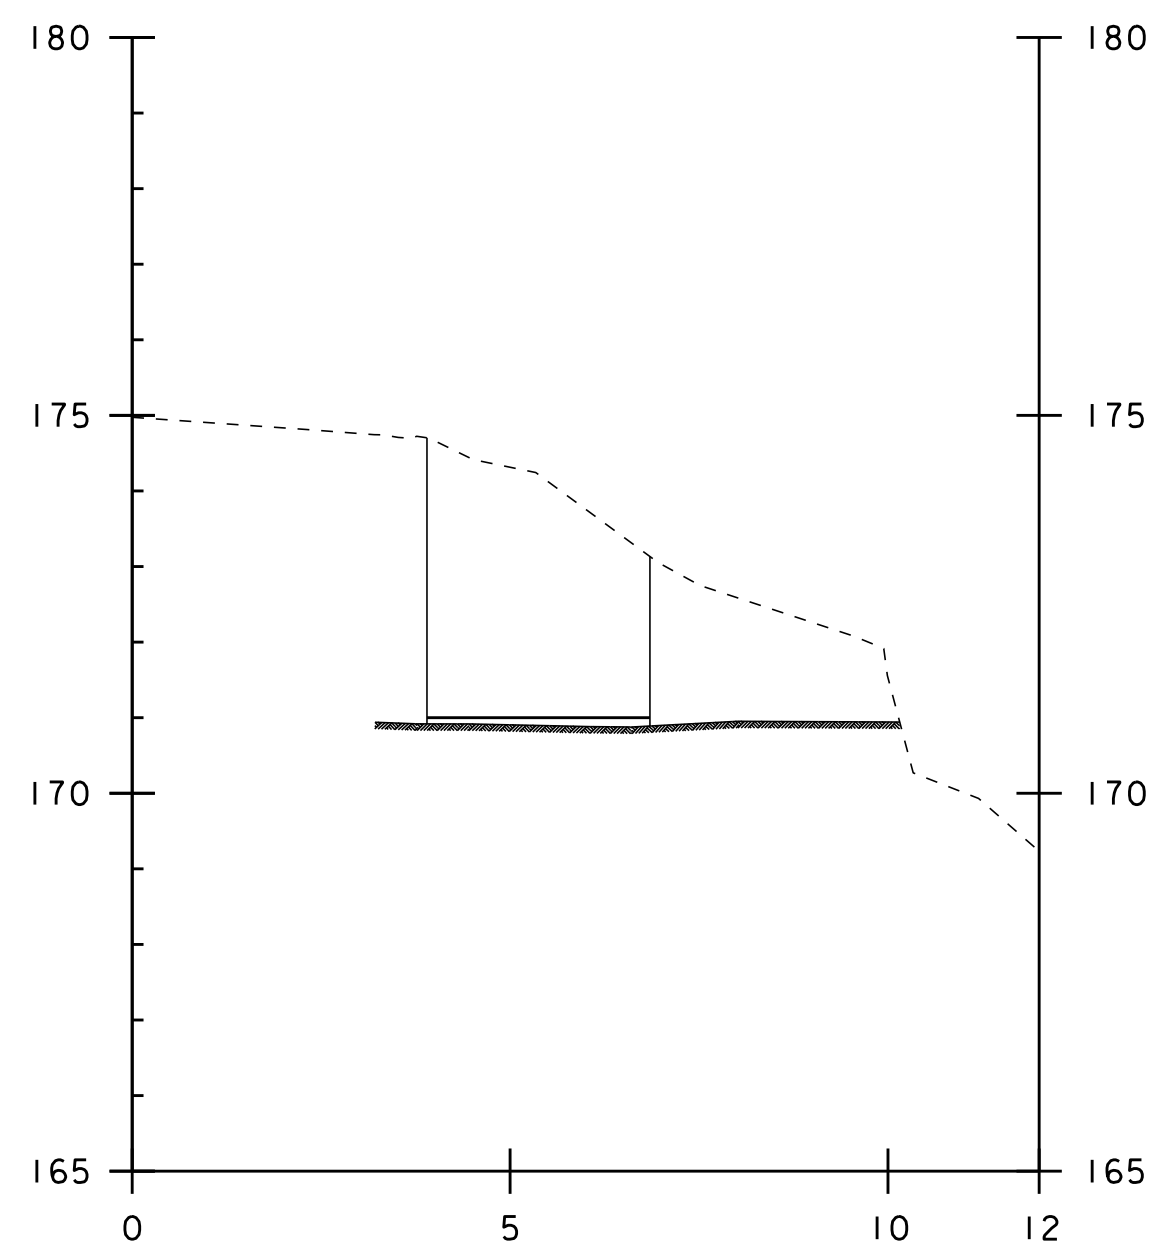

3+042.50

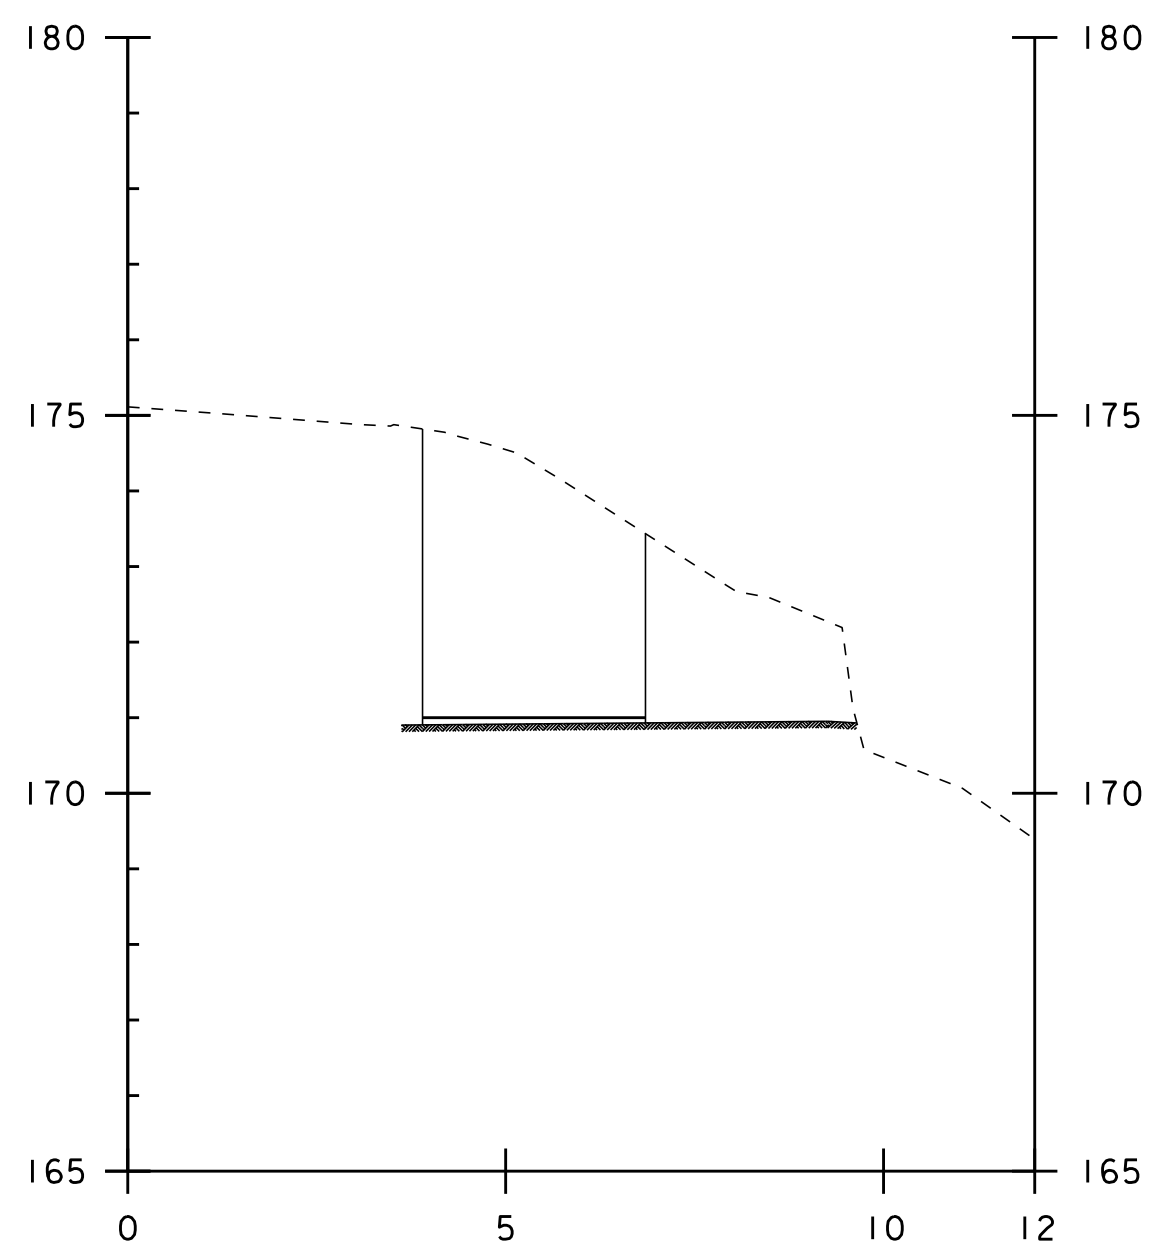

3+046.50

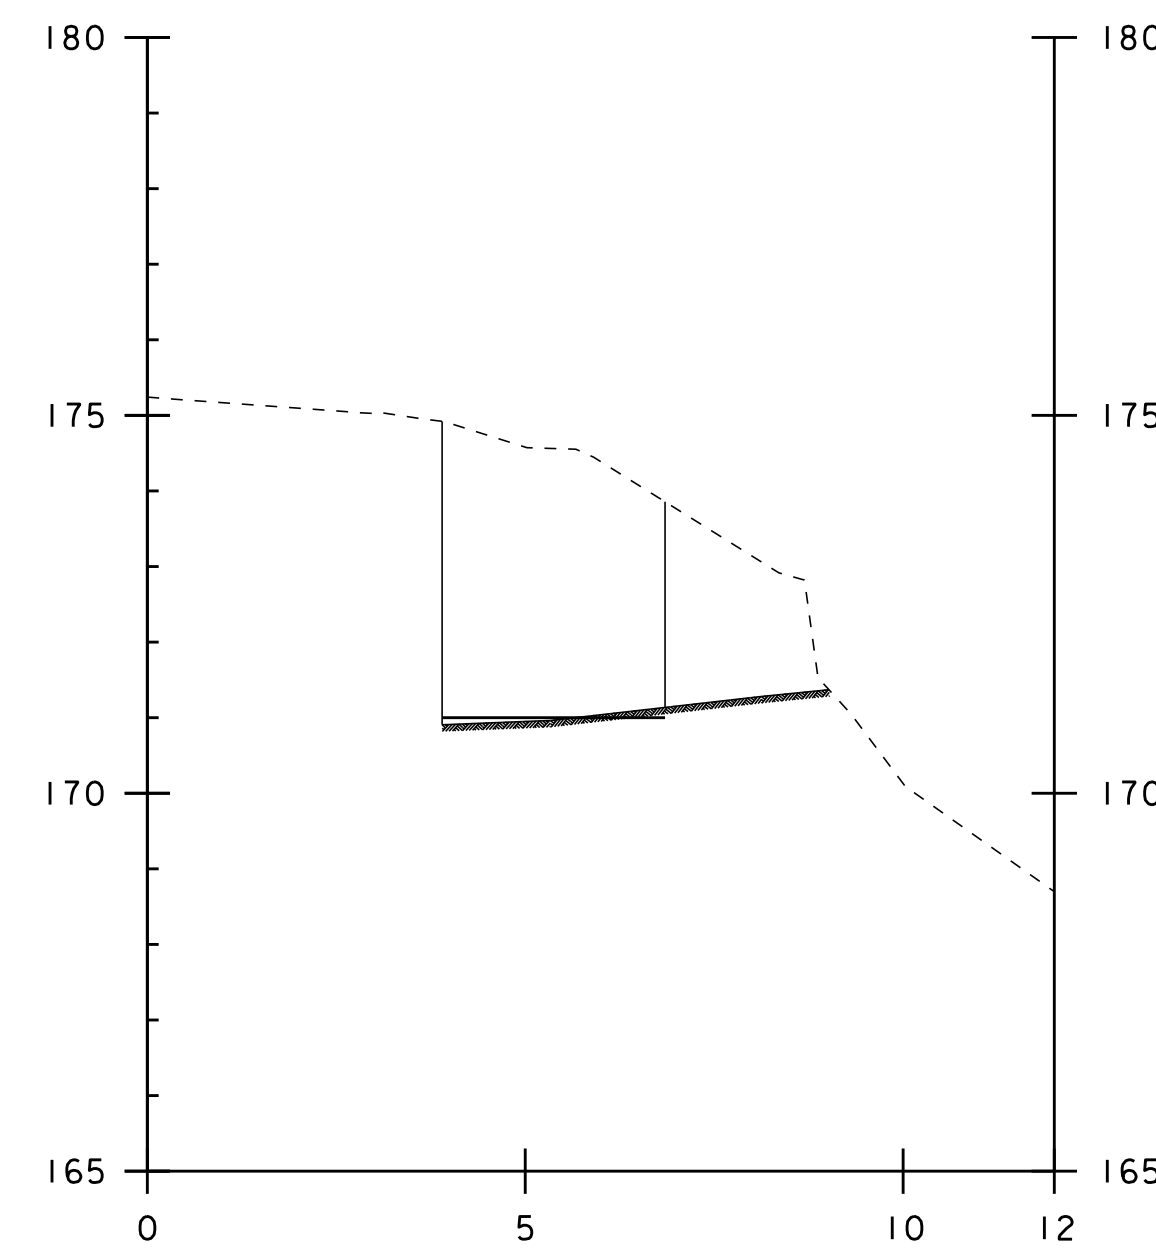

3+050.50

WINGWALL TWO  
 STRUCTURE EXCAVATION  
 UNCLASSIFIED CHANNEL EXCAVATION

