




3+053.80

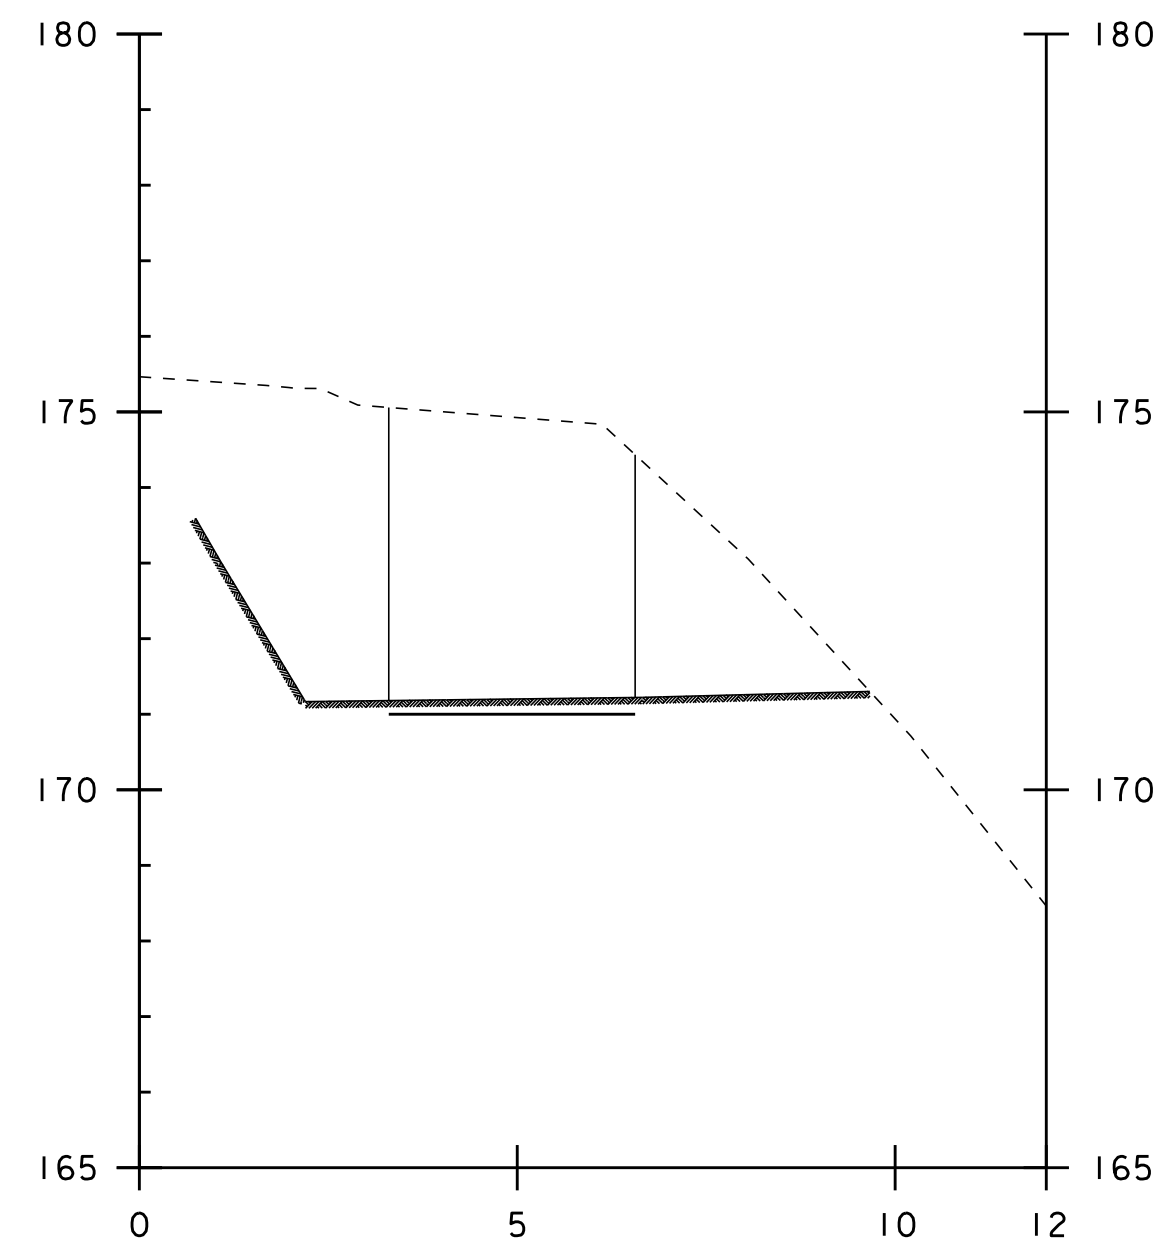


3+057.80

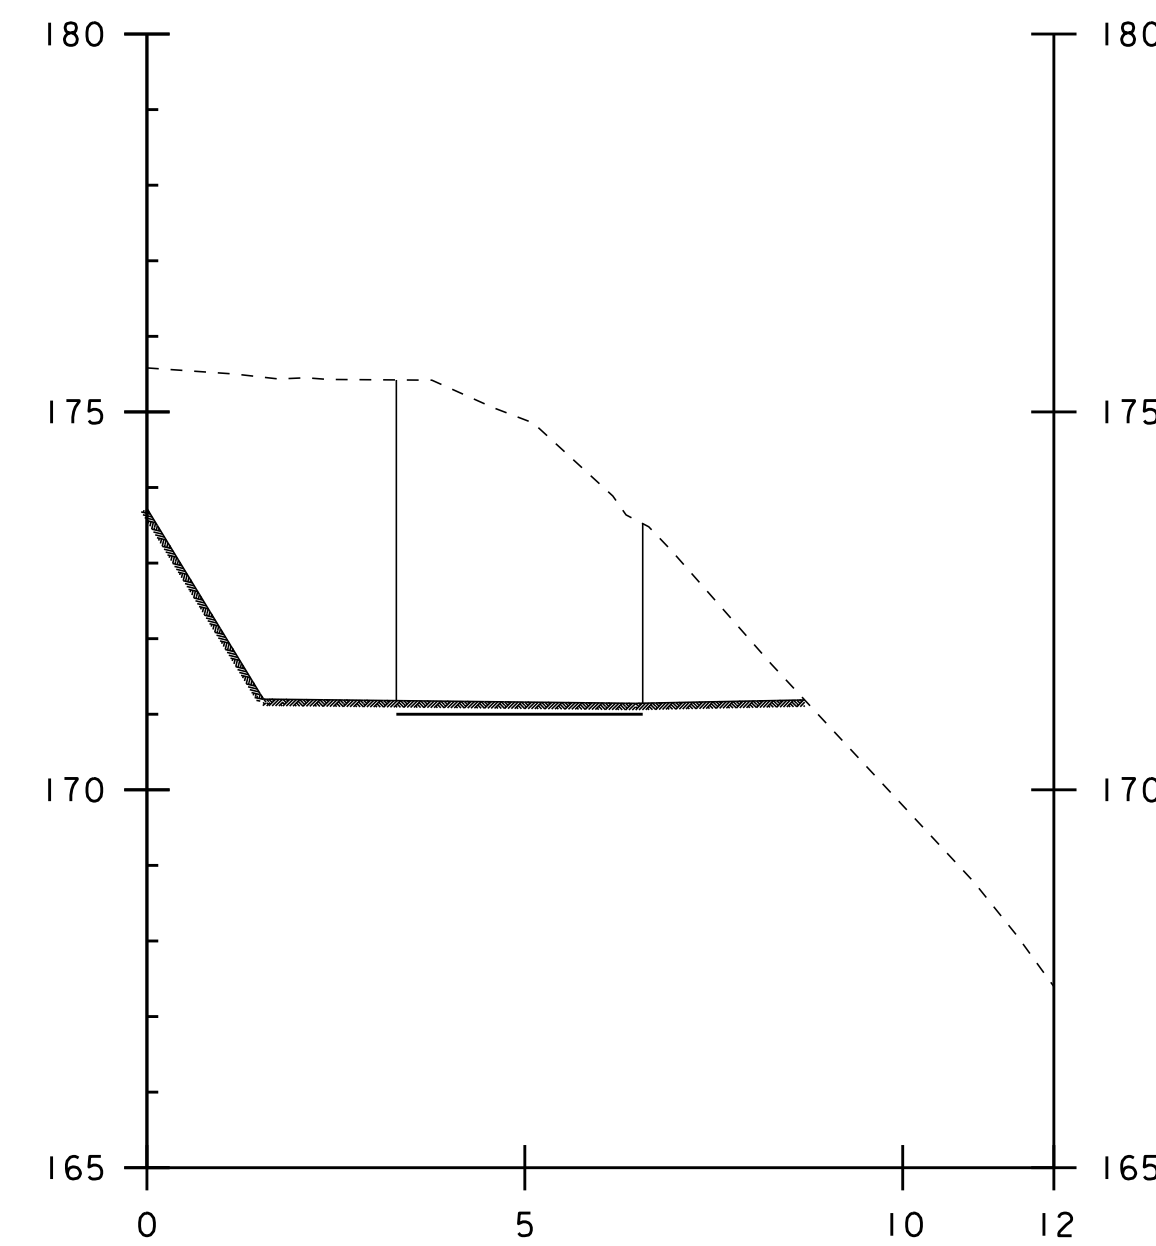


3+061.80

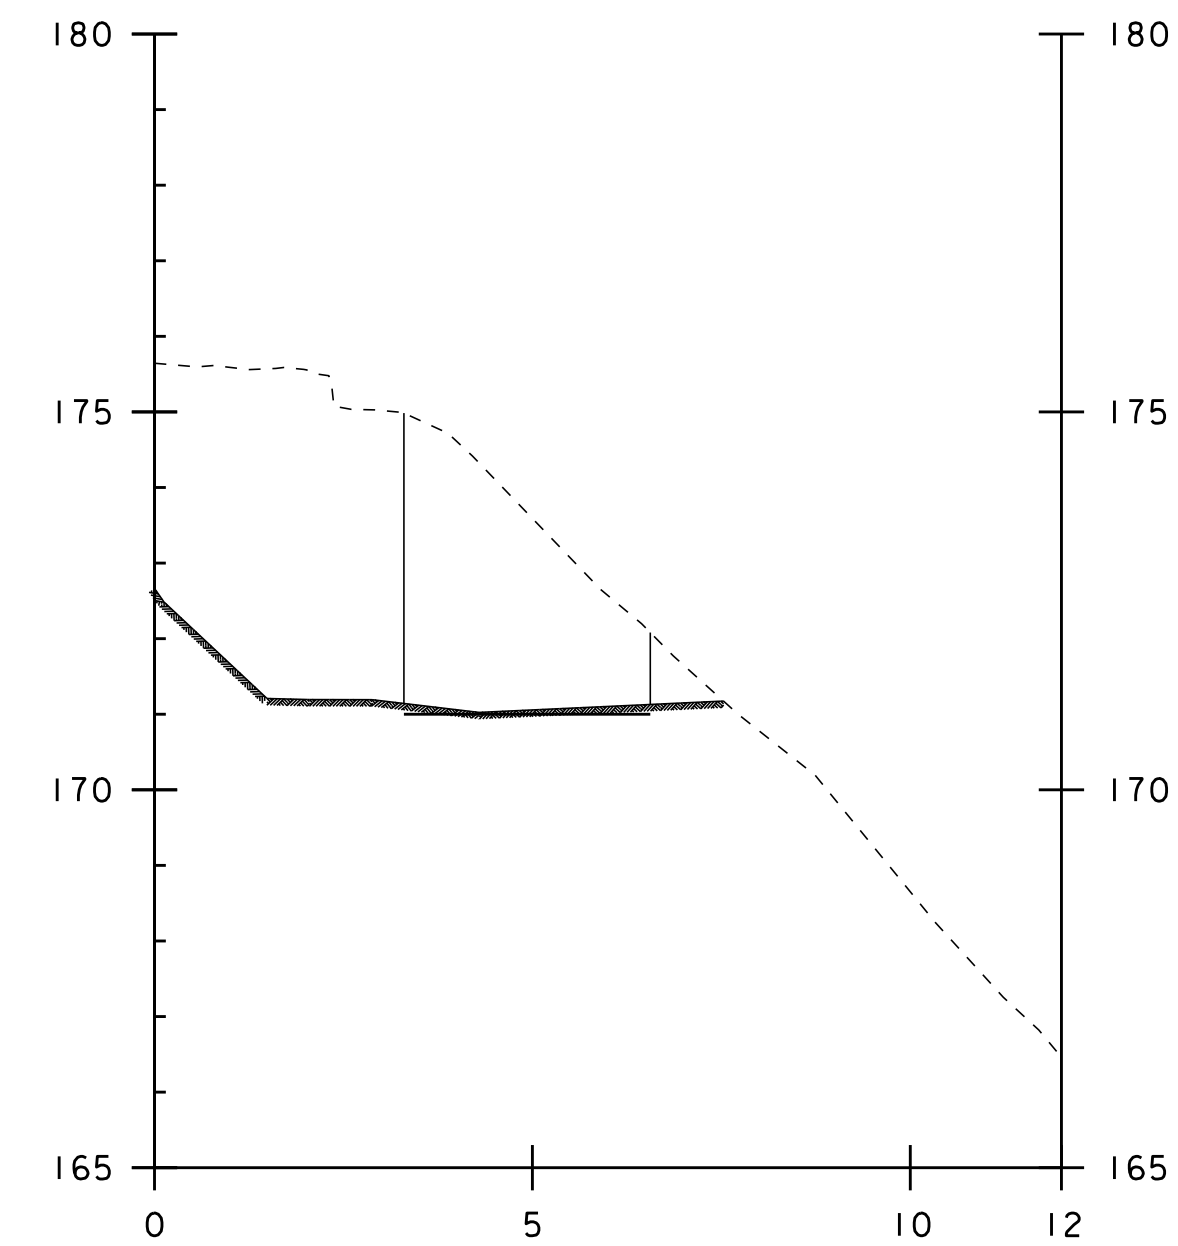


3+065.80

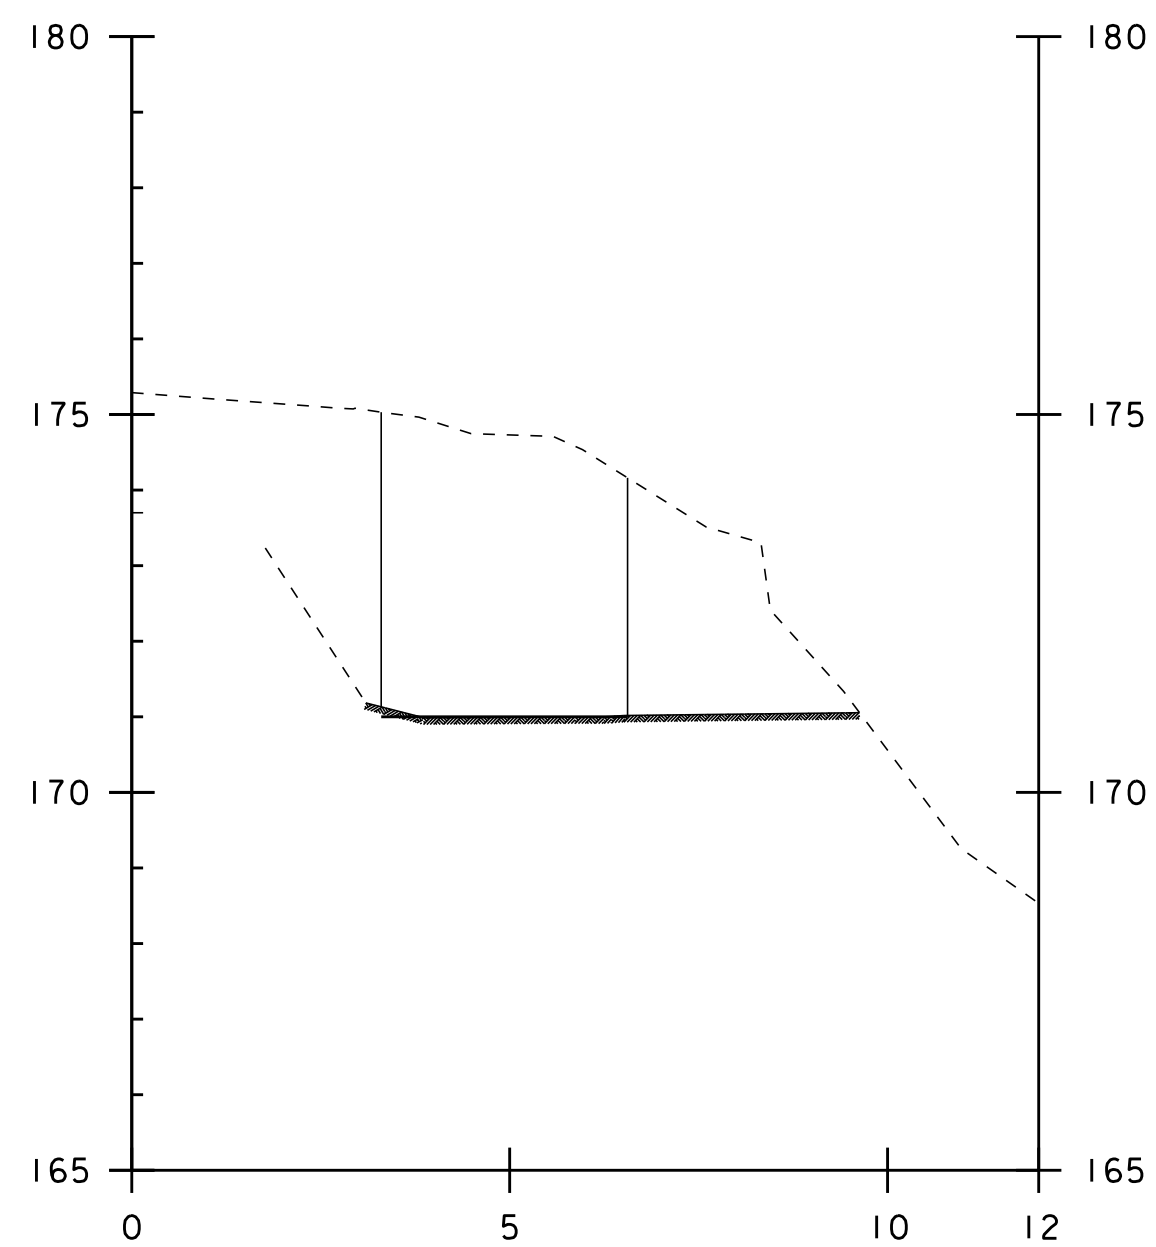


3+051.80

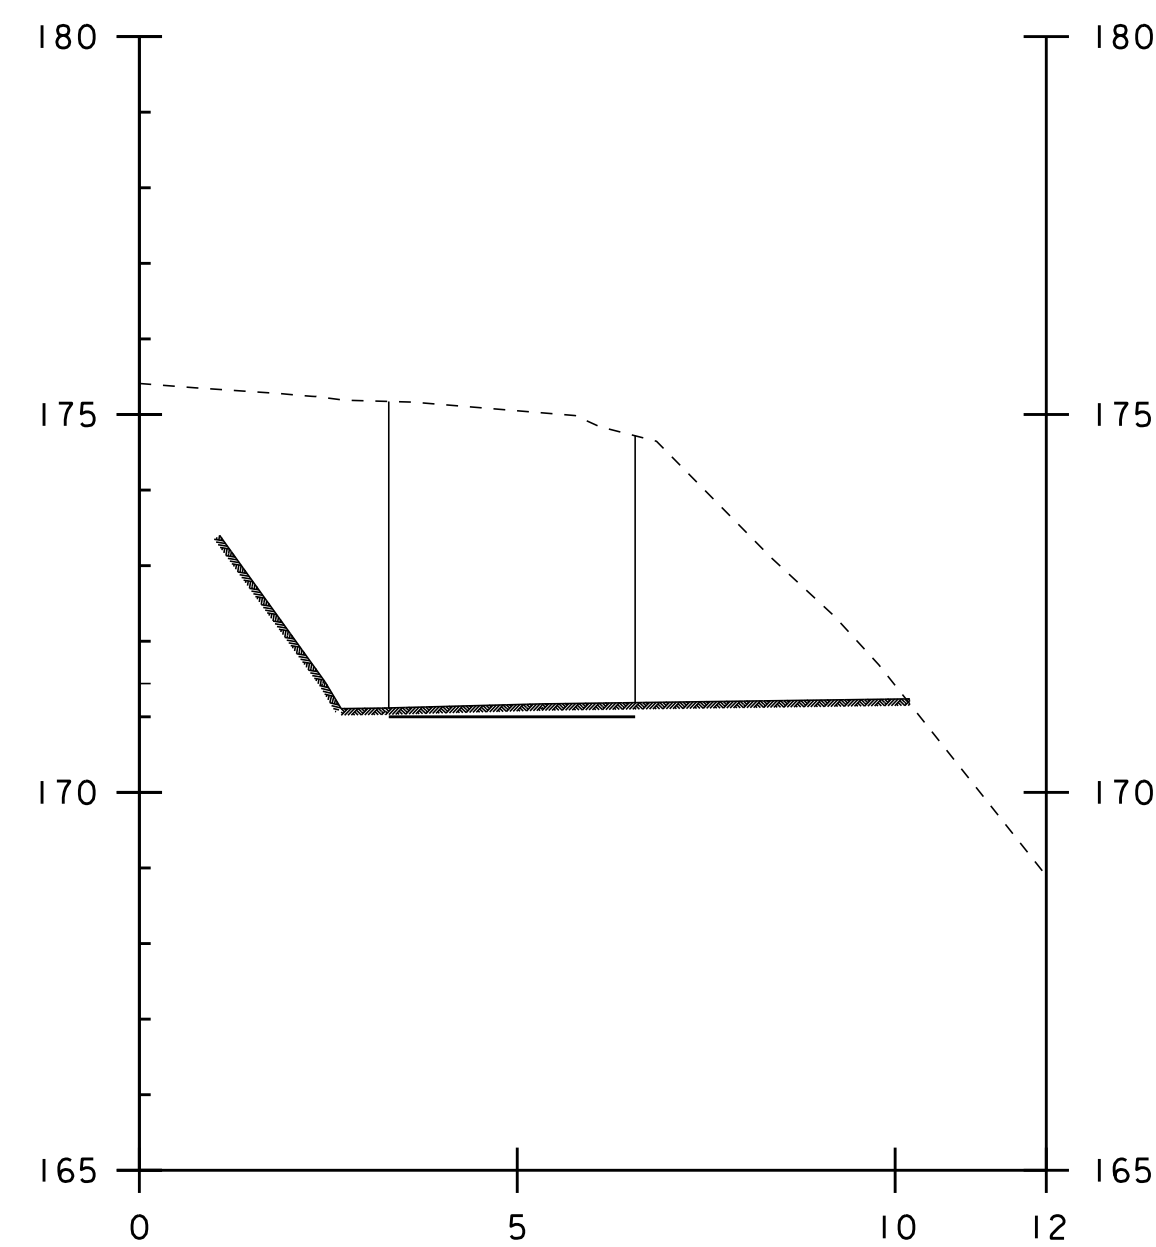

3+055.80

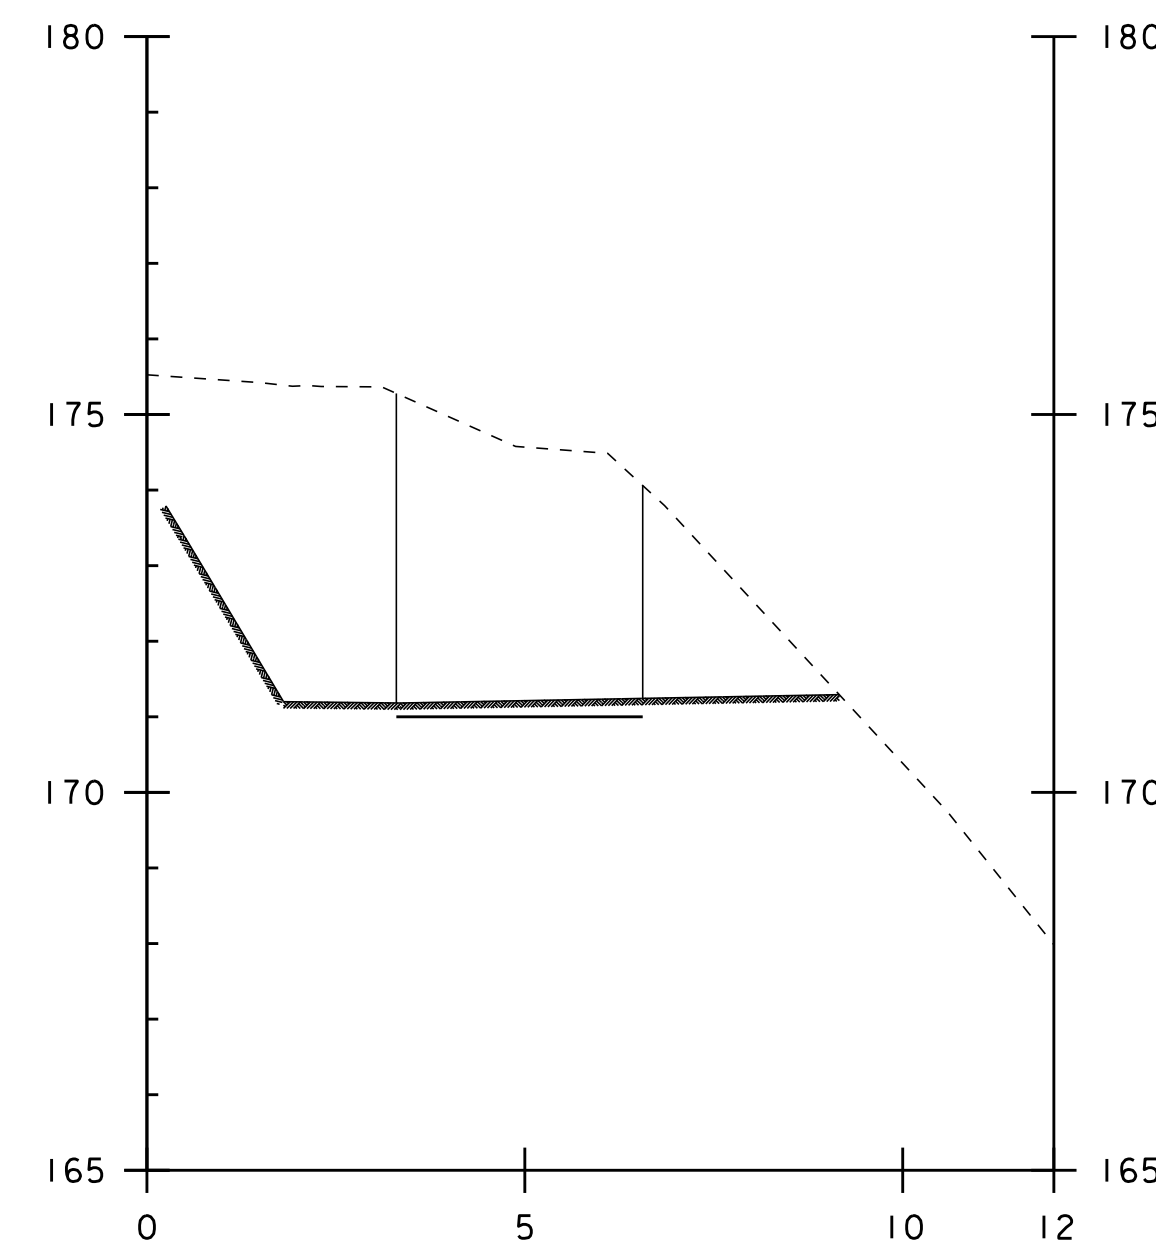

3+059.80

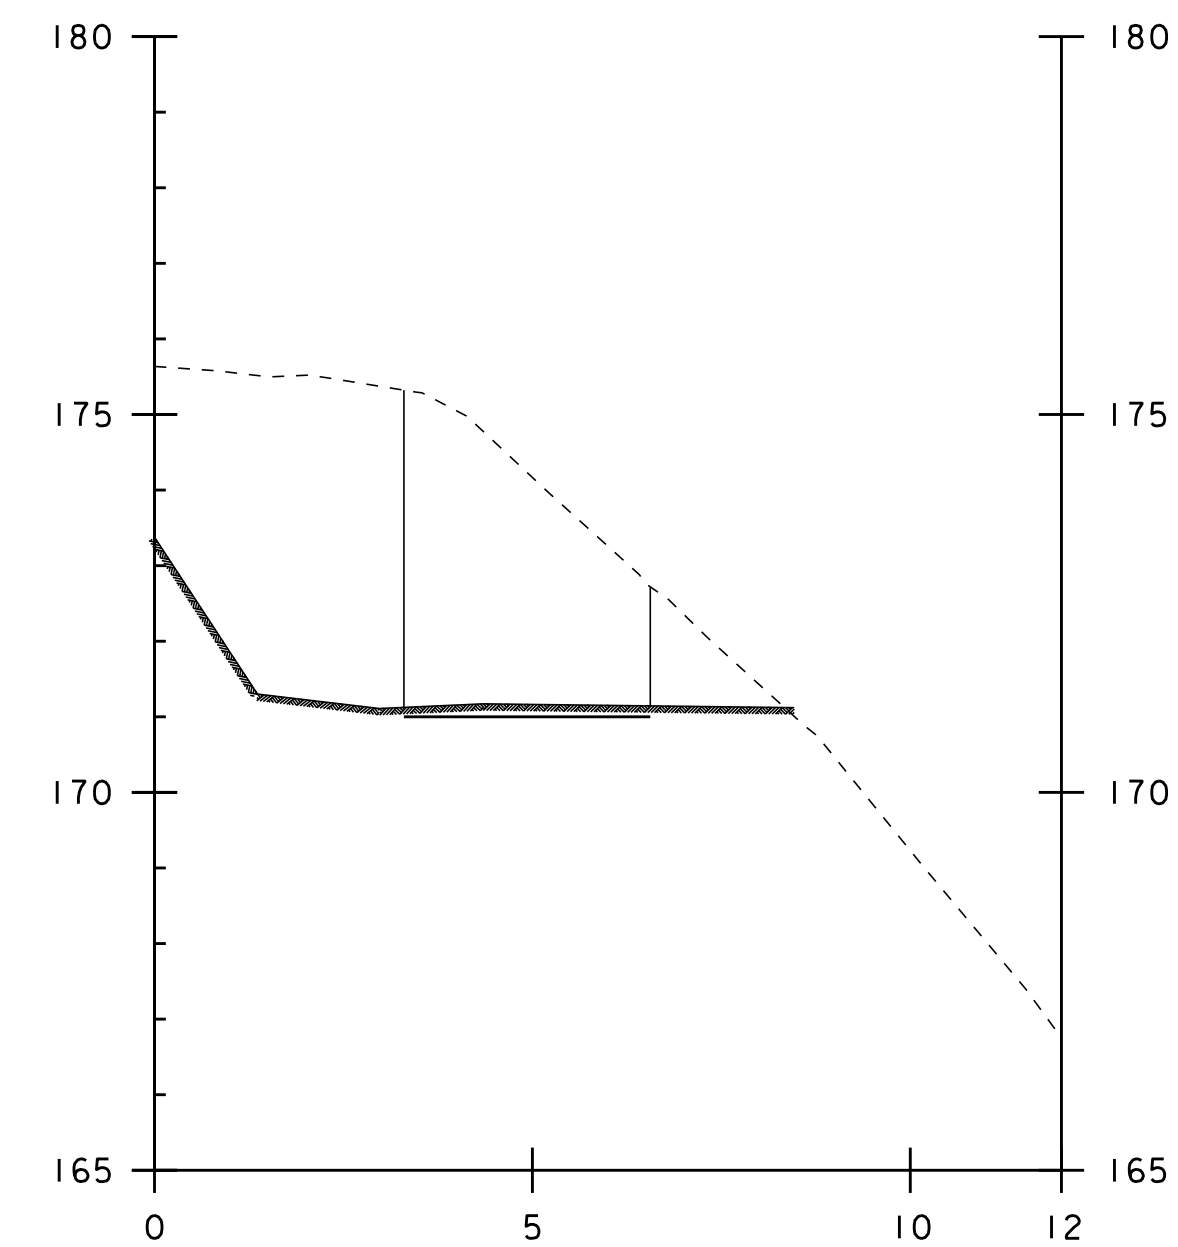

3+063.80

WINGWALL TWO
 STRUCTURE EXCAVATION
 UNCLASSIFIED CHANNEL EXCAVATION

