



3+069.80

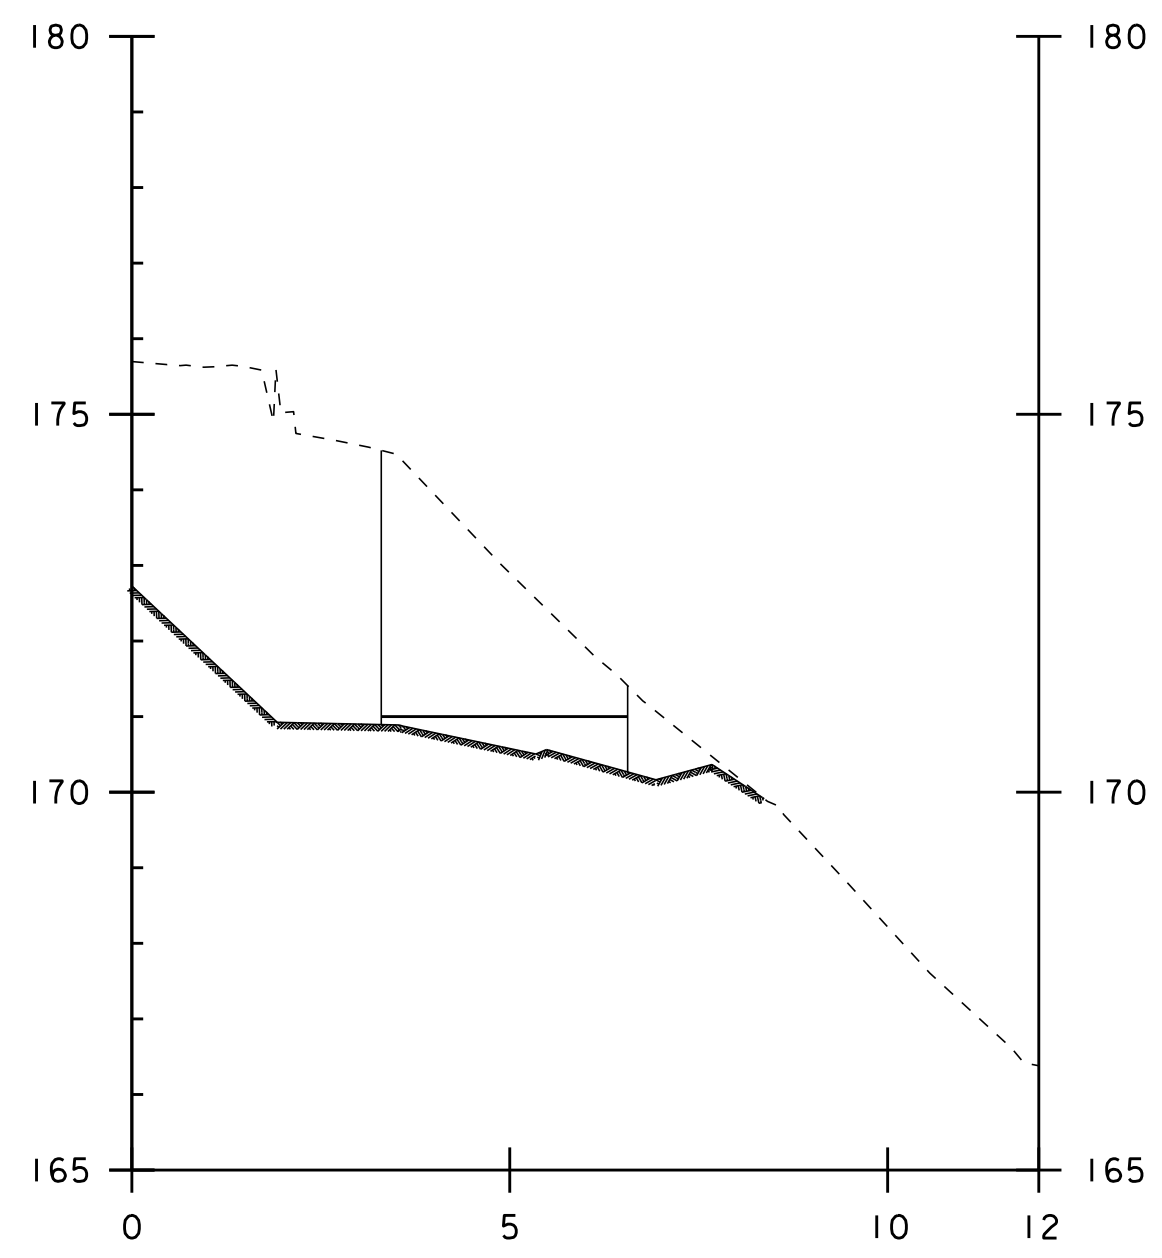

3+067.80

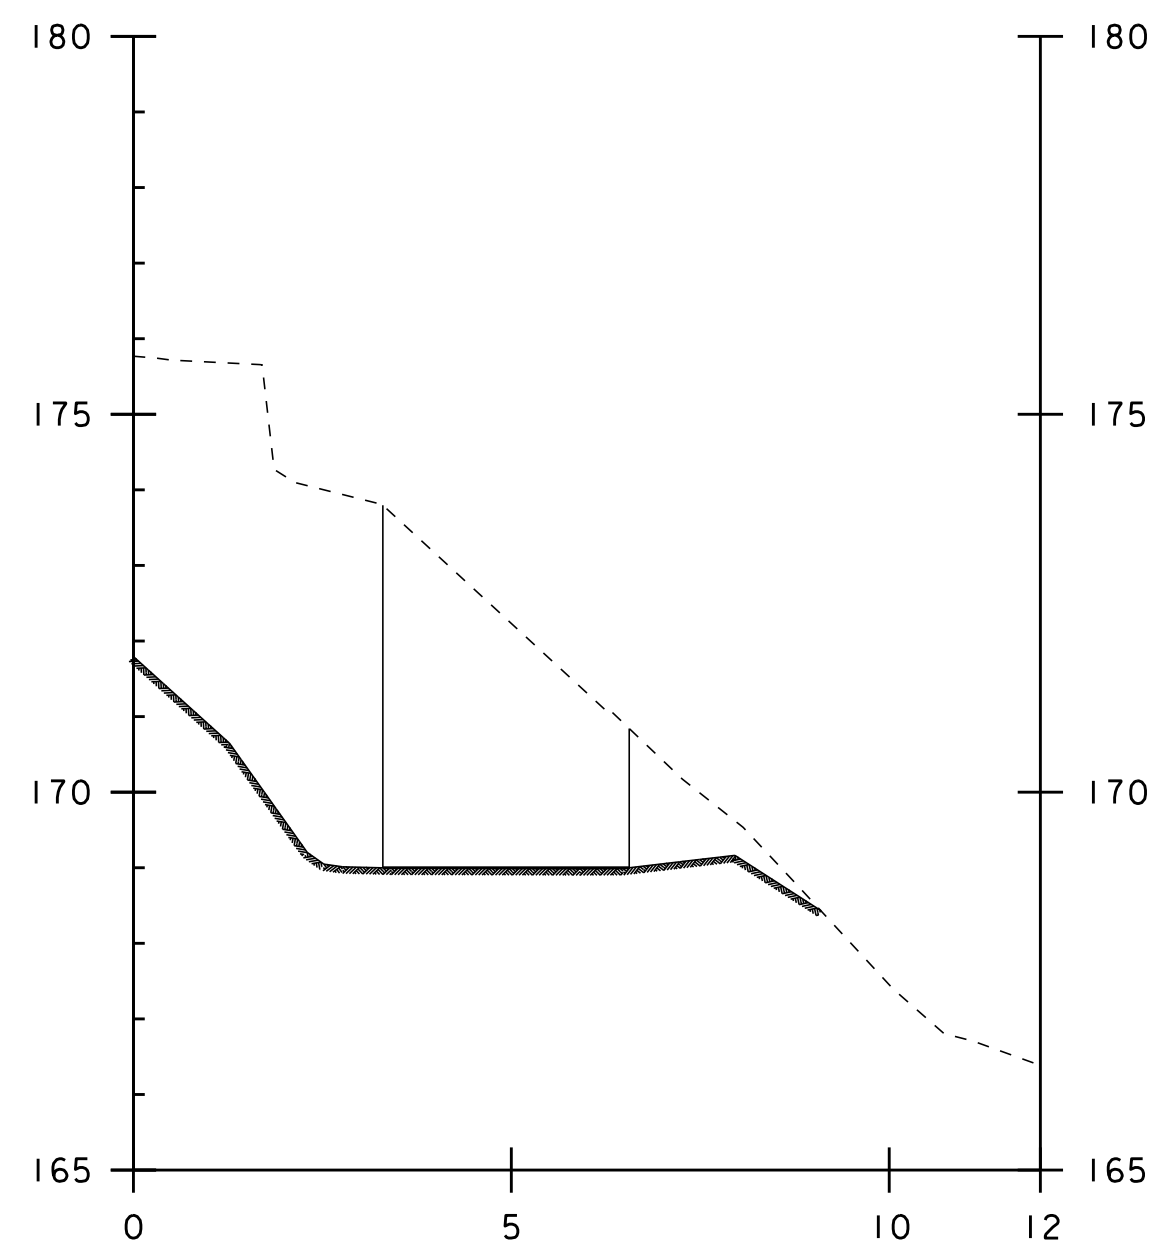

3+070.50

WINGWALL TWO
 STRUCTURE EXCAVATION
 UNCLASSIFIED CHANNEL EXCAVATION

