




3+072.50

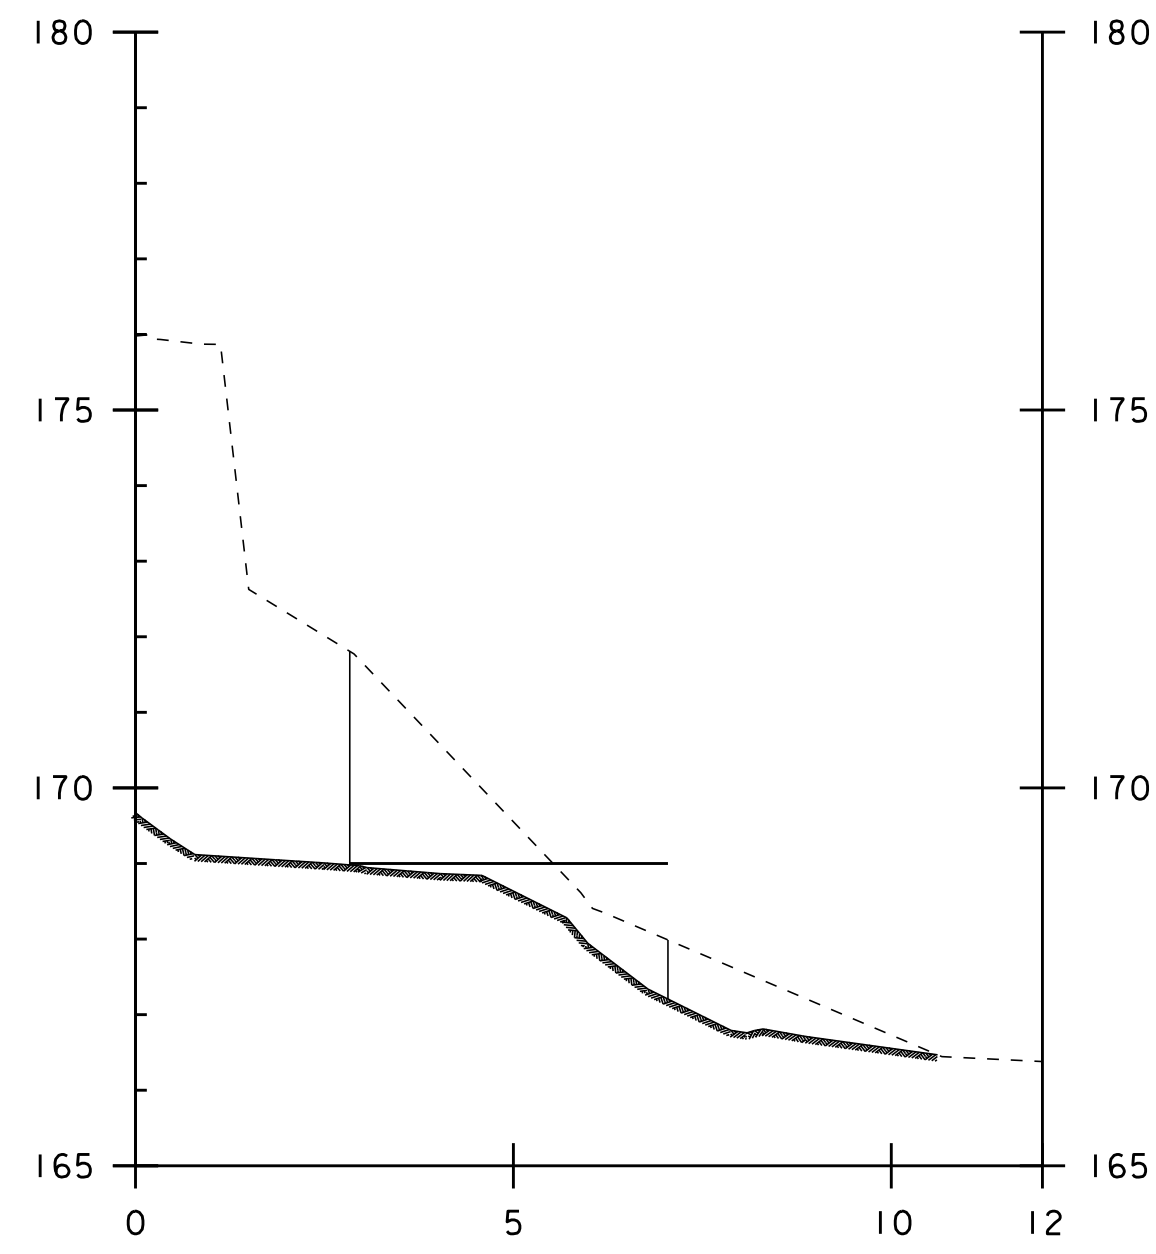


3+076.50

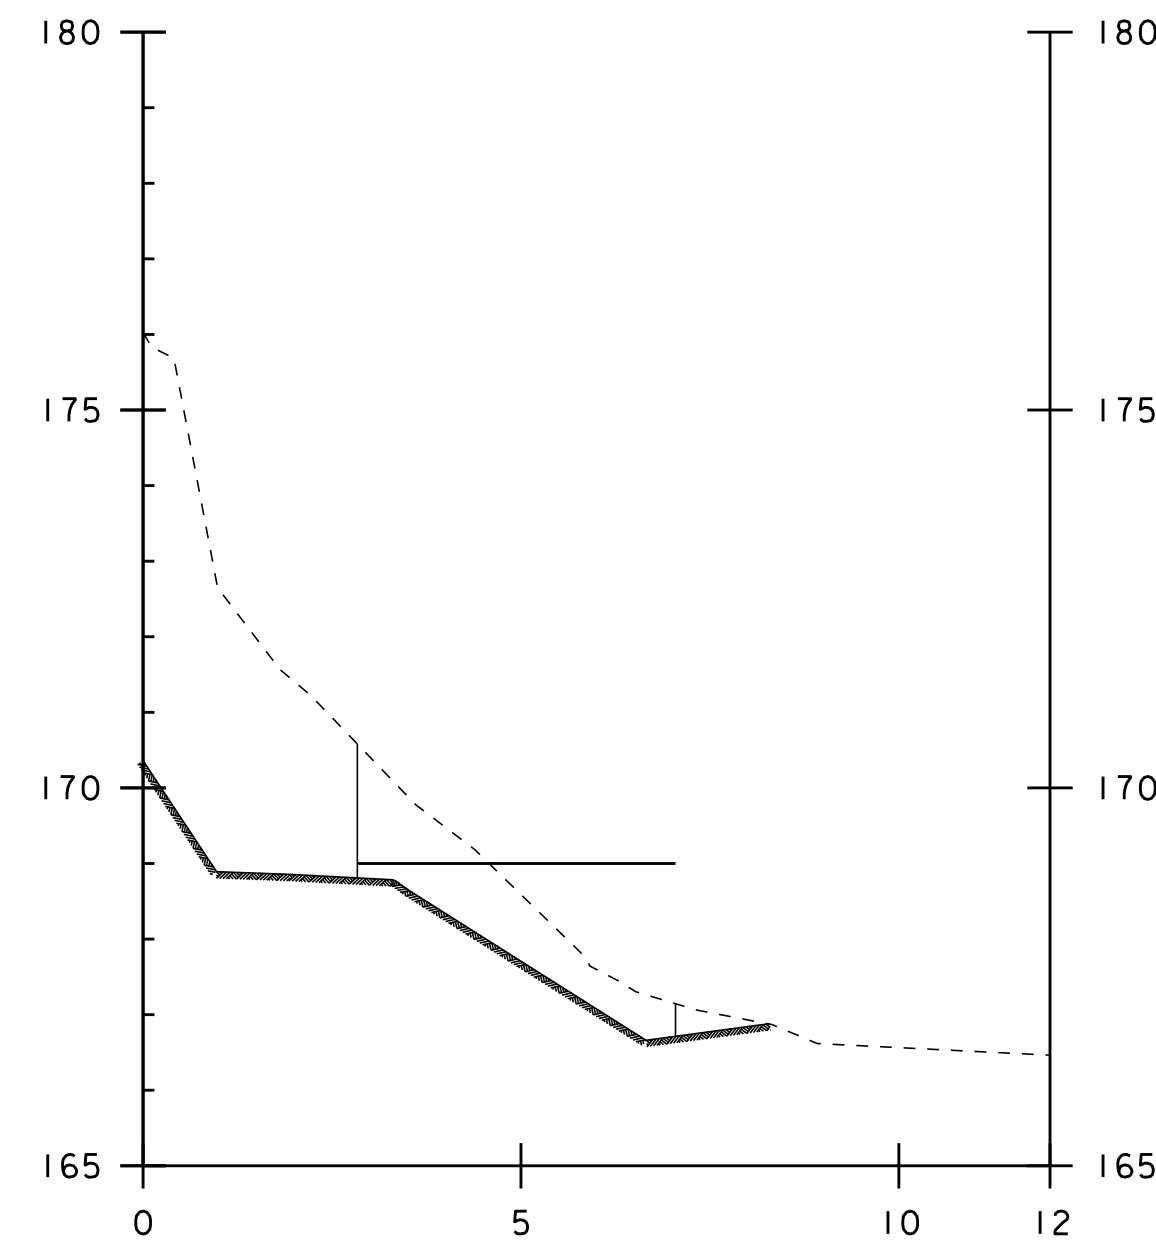


3+080.50

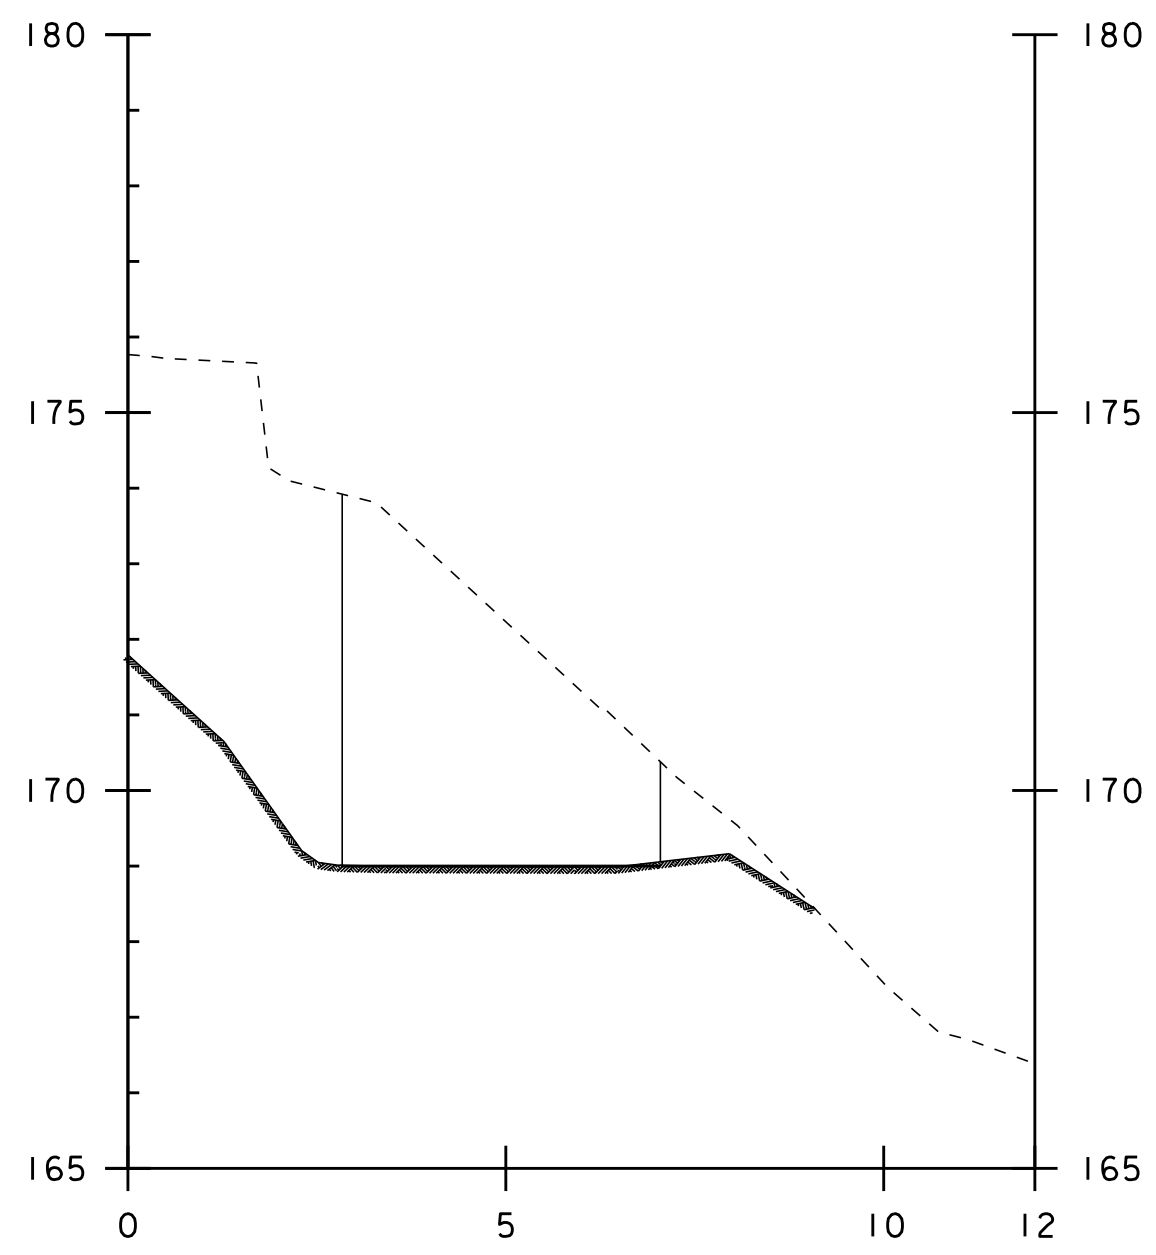


3+070.50

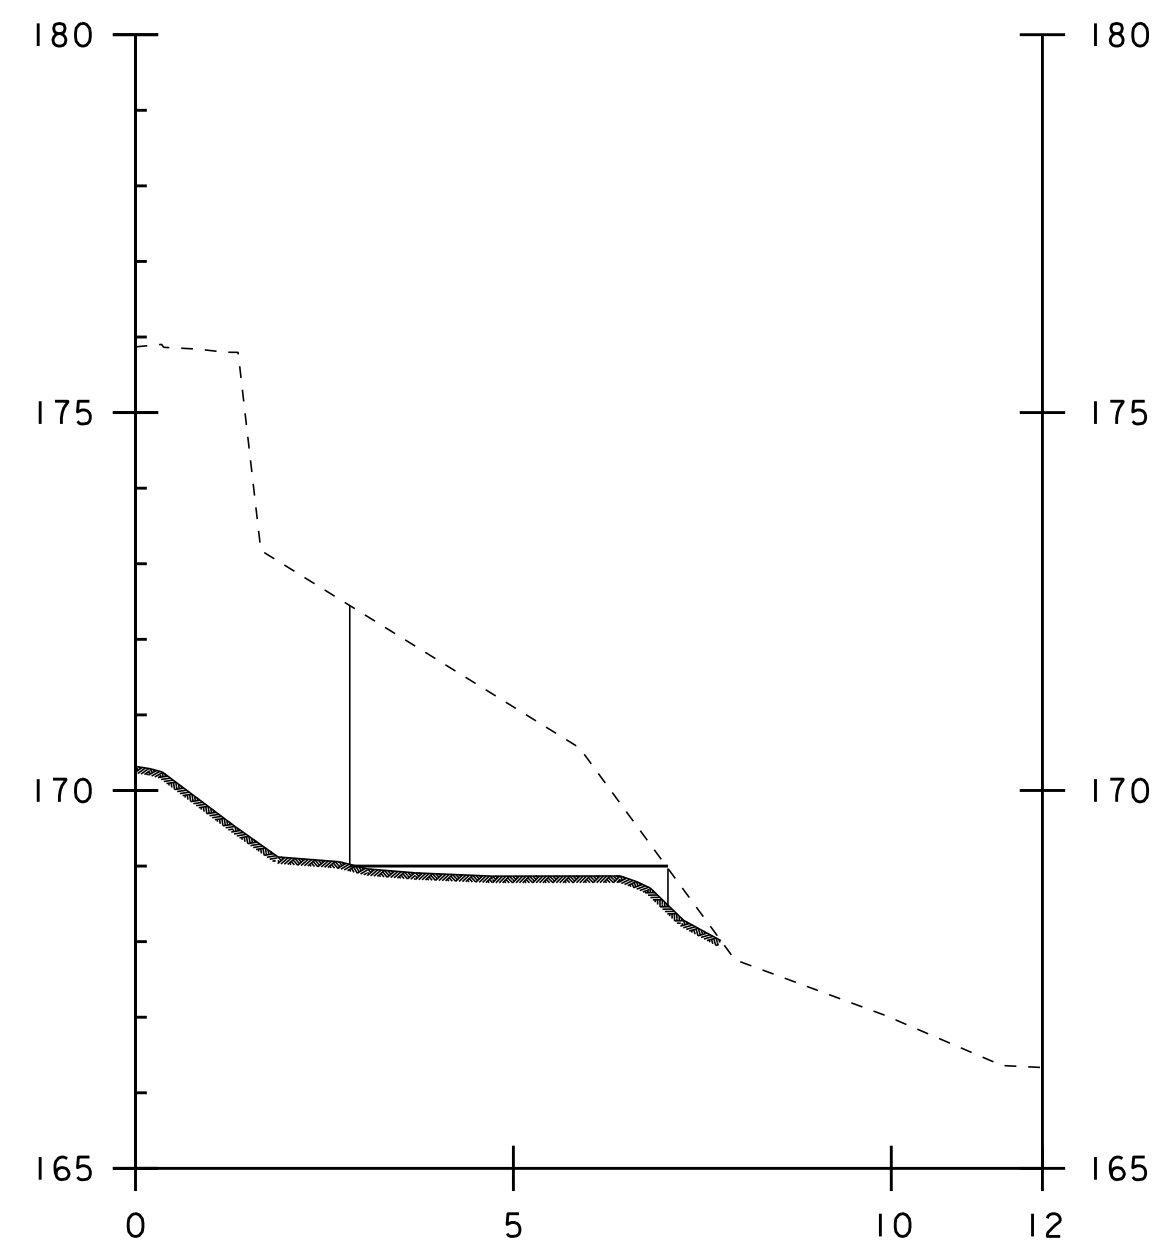

3+074.50

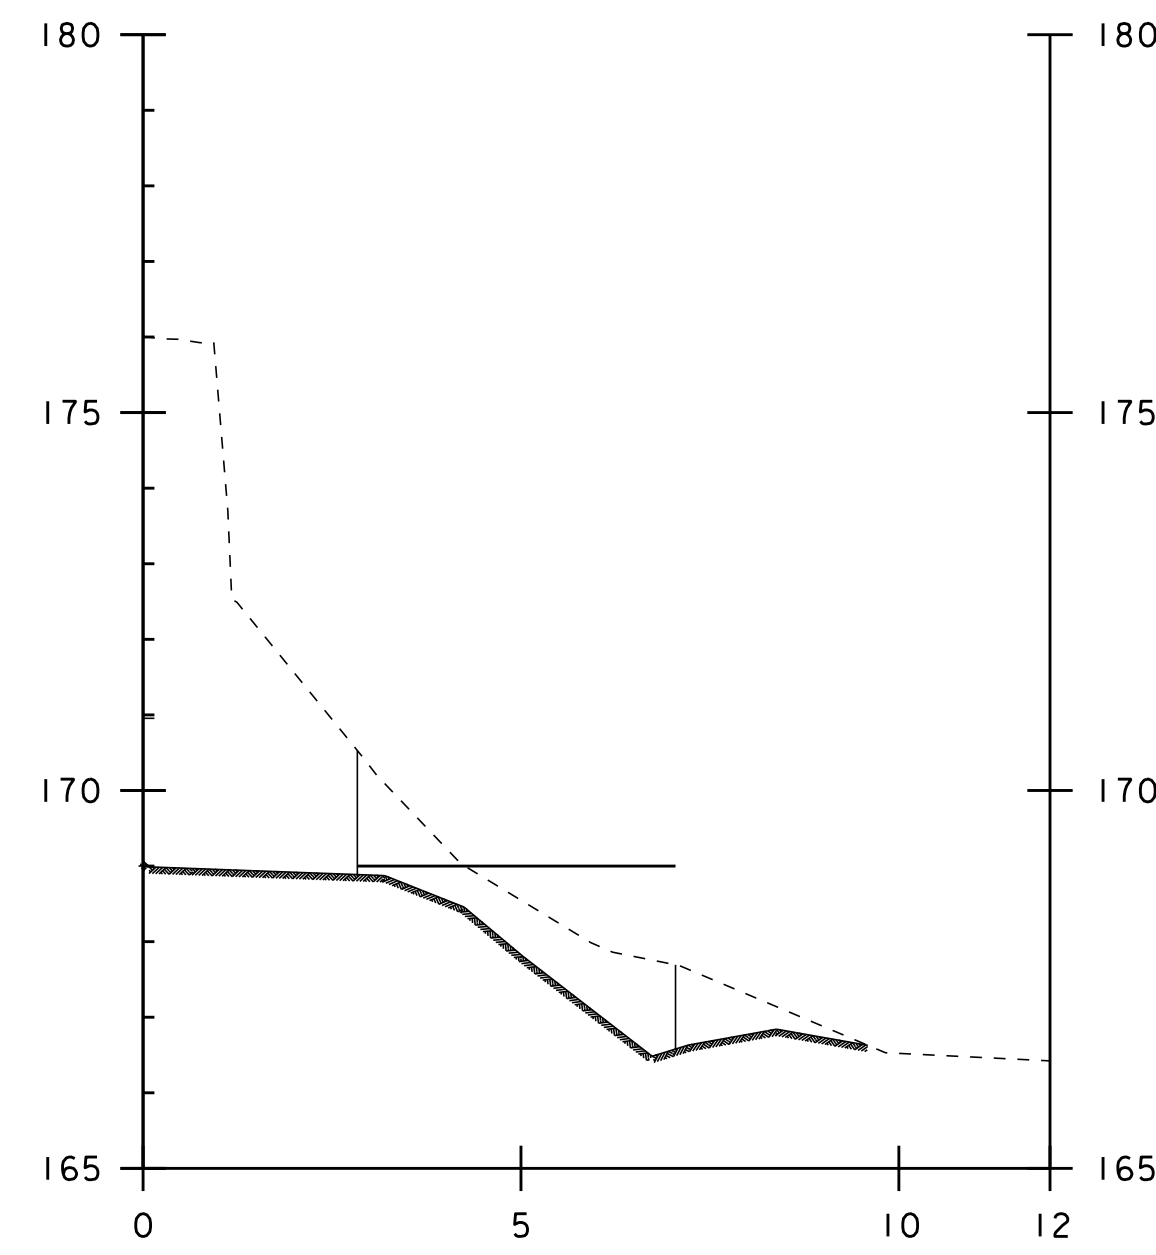

3+078.50

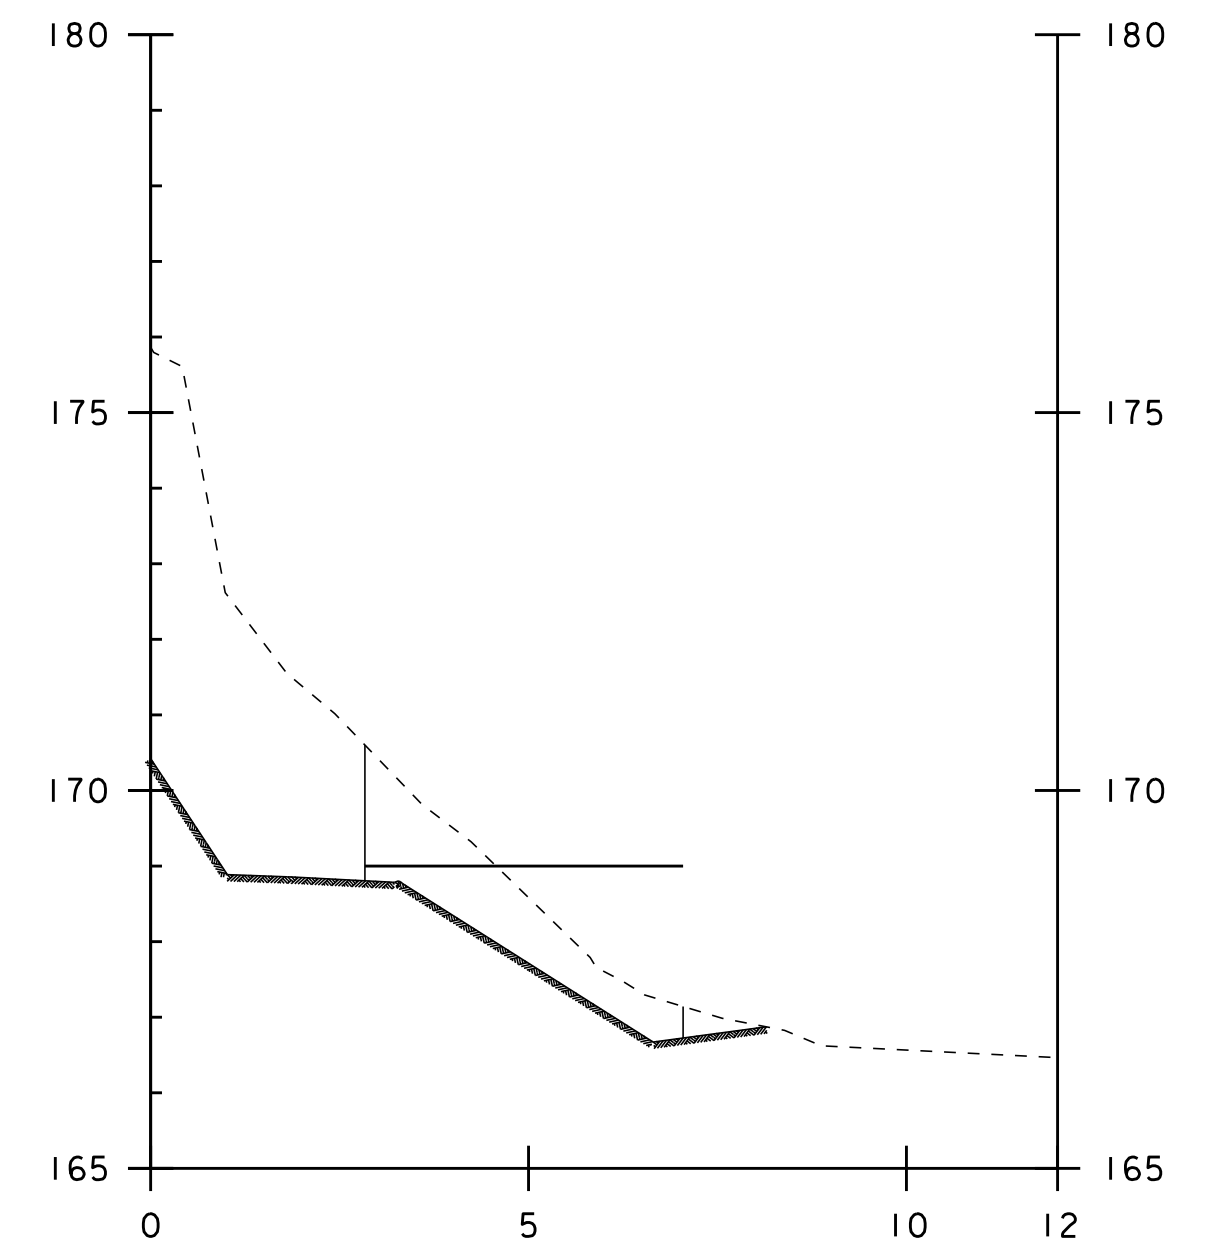

3+080.60

WINGWALL TWO  
 STRUCTURE EXCAVATION  
 UNCLASSIFIED CHANNEL EXCAVATION

