




3+124.65

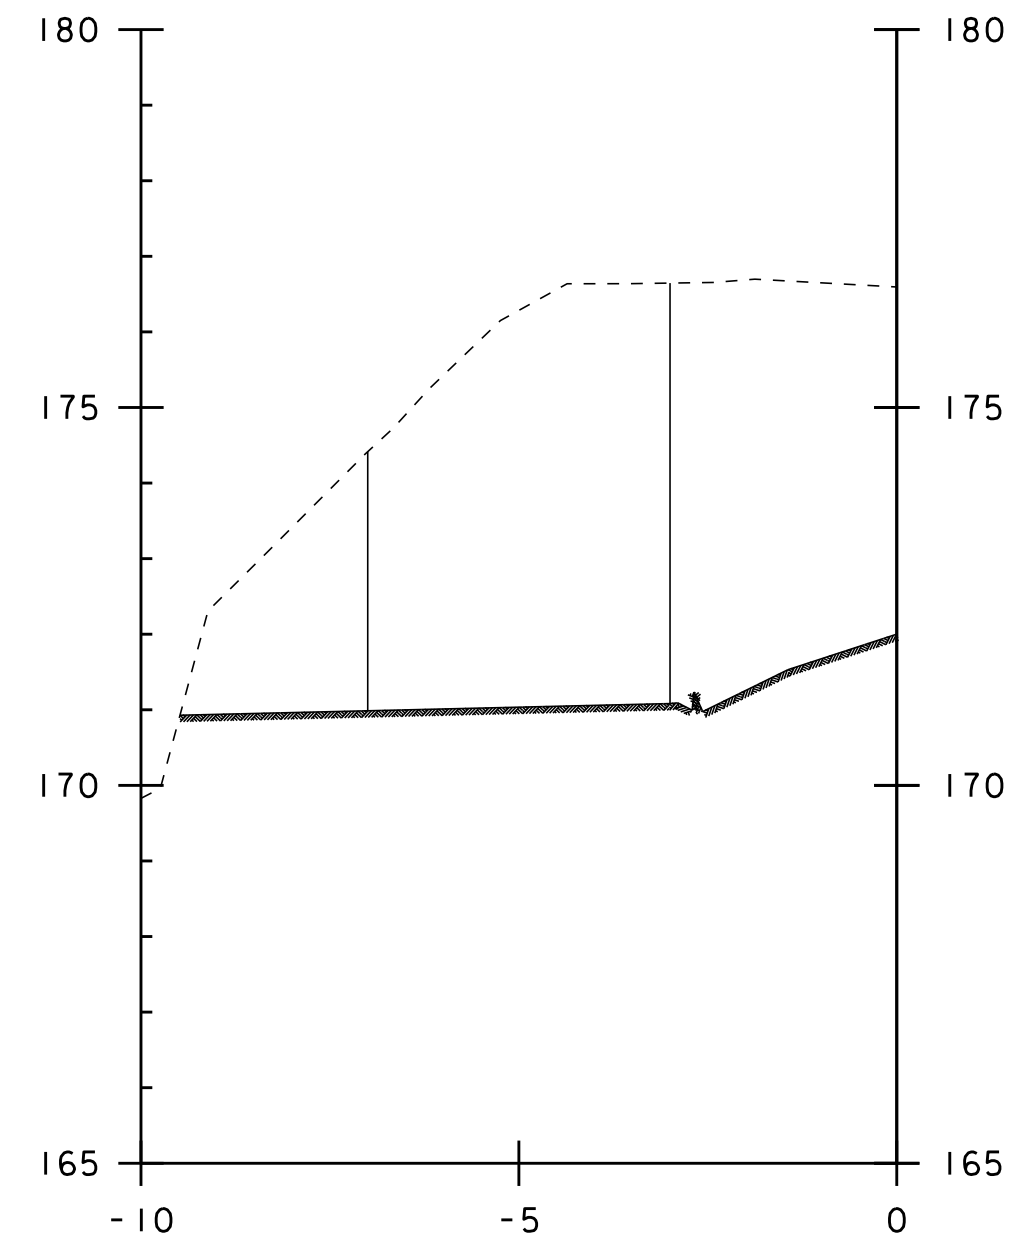


3+127.00

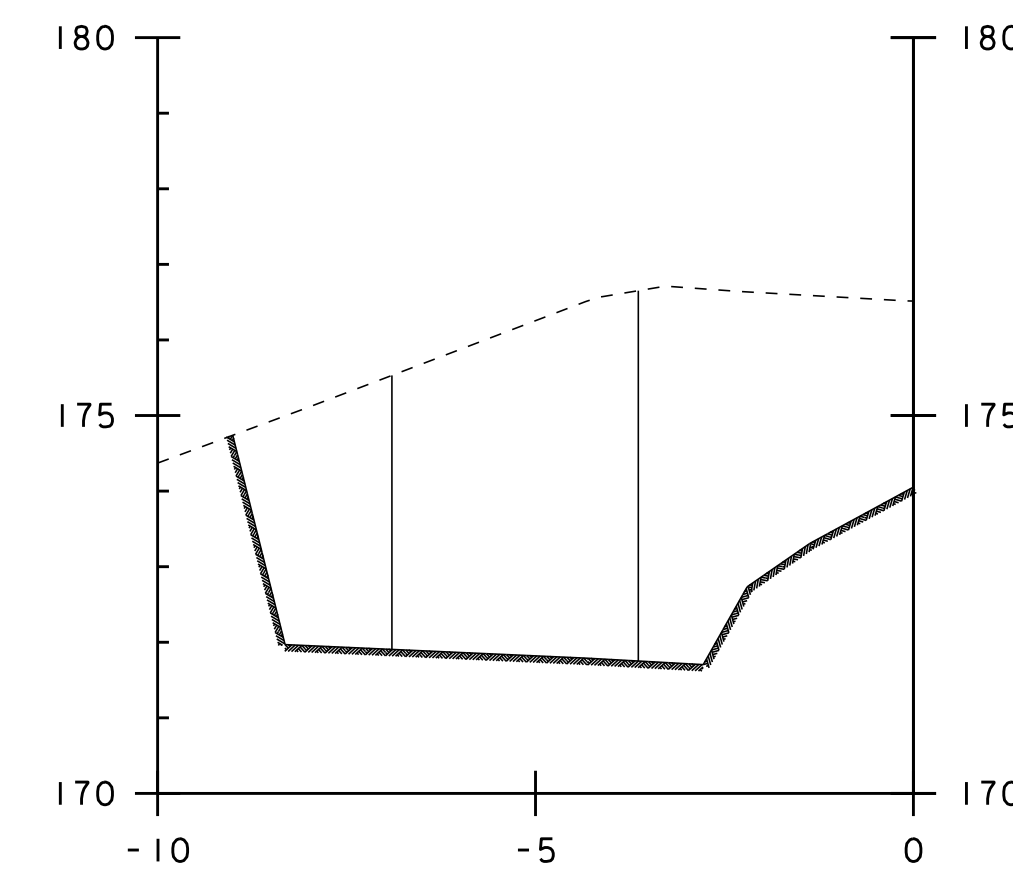


3+131.00

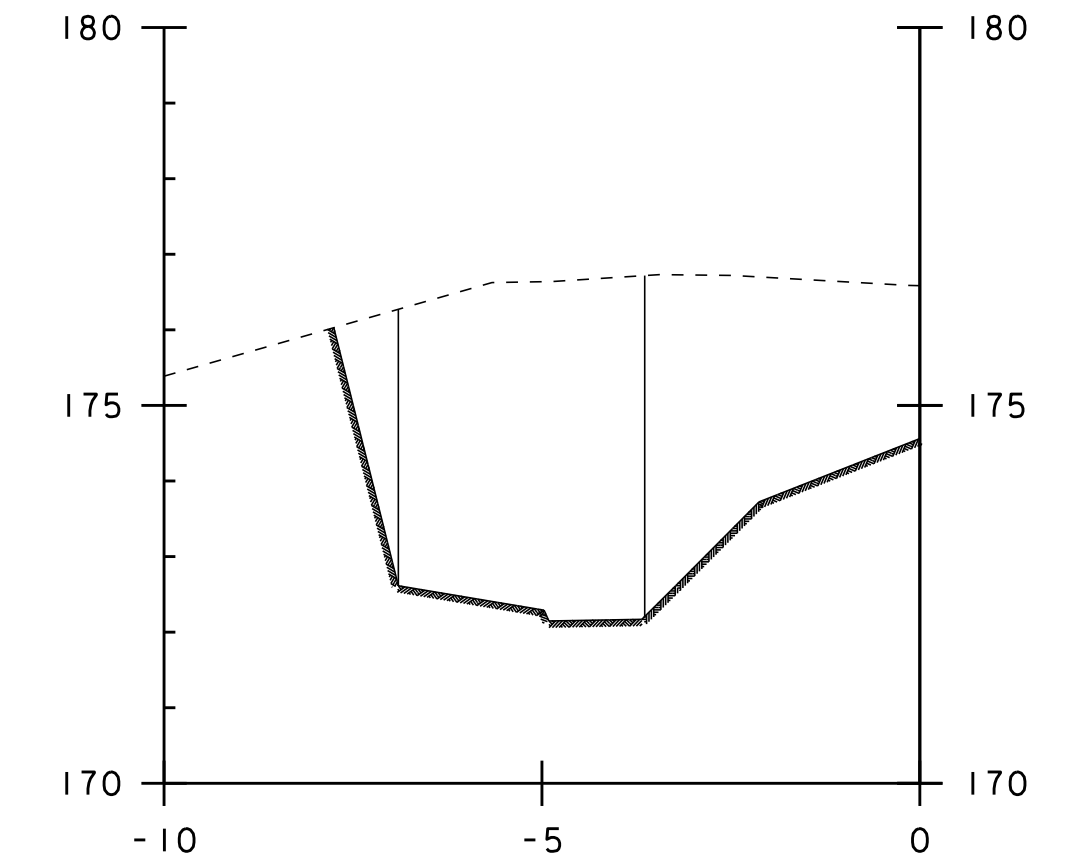


3+135.65

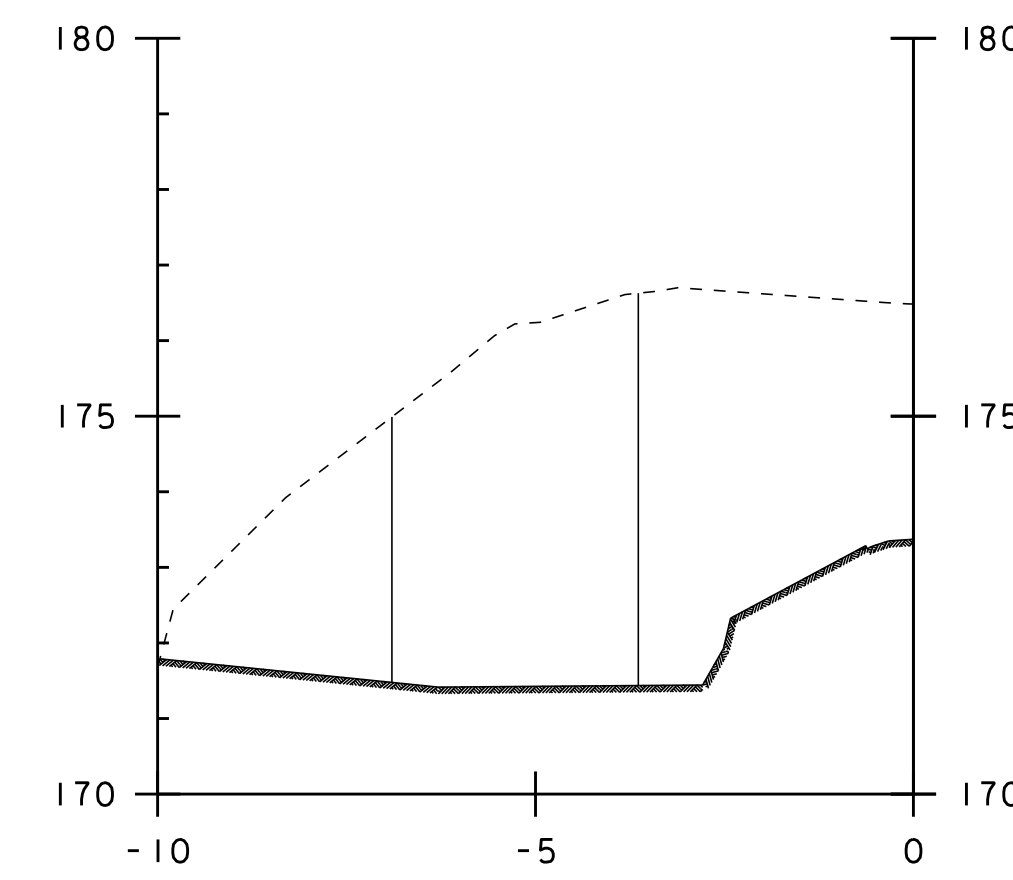


3+129.00

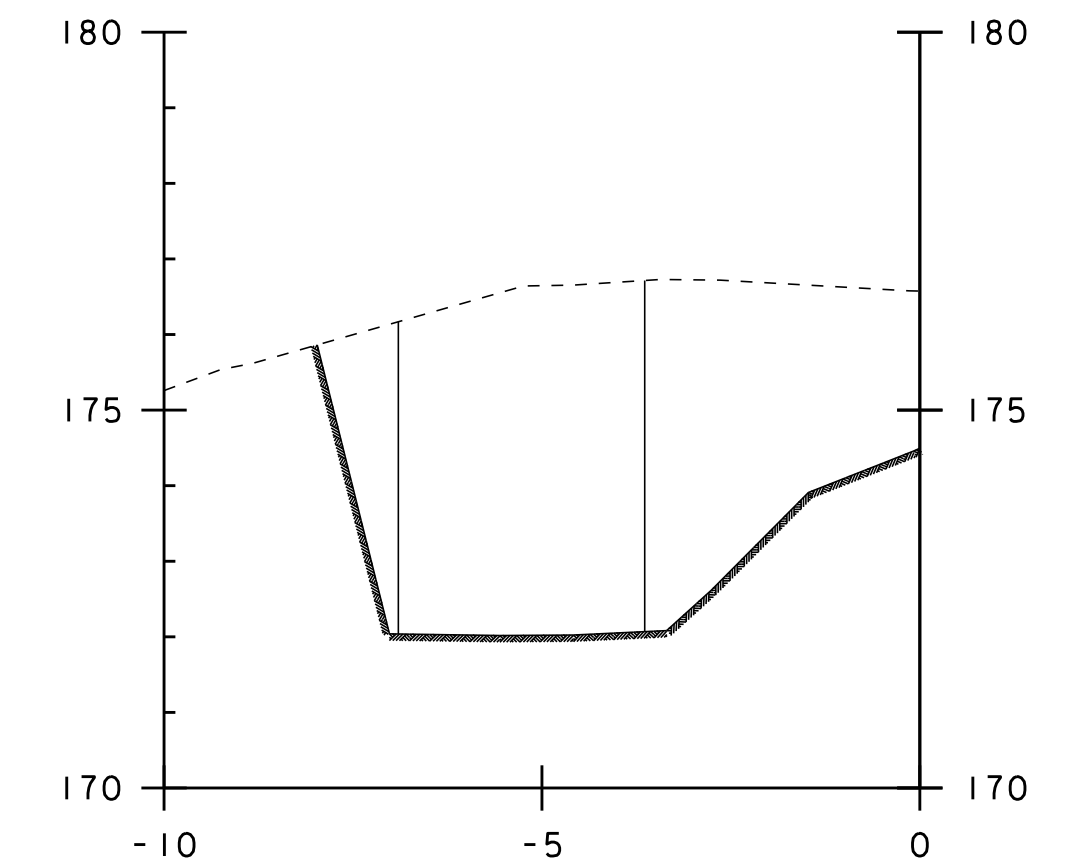


3+135.00

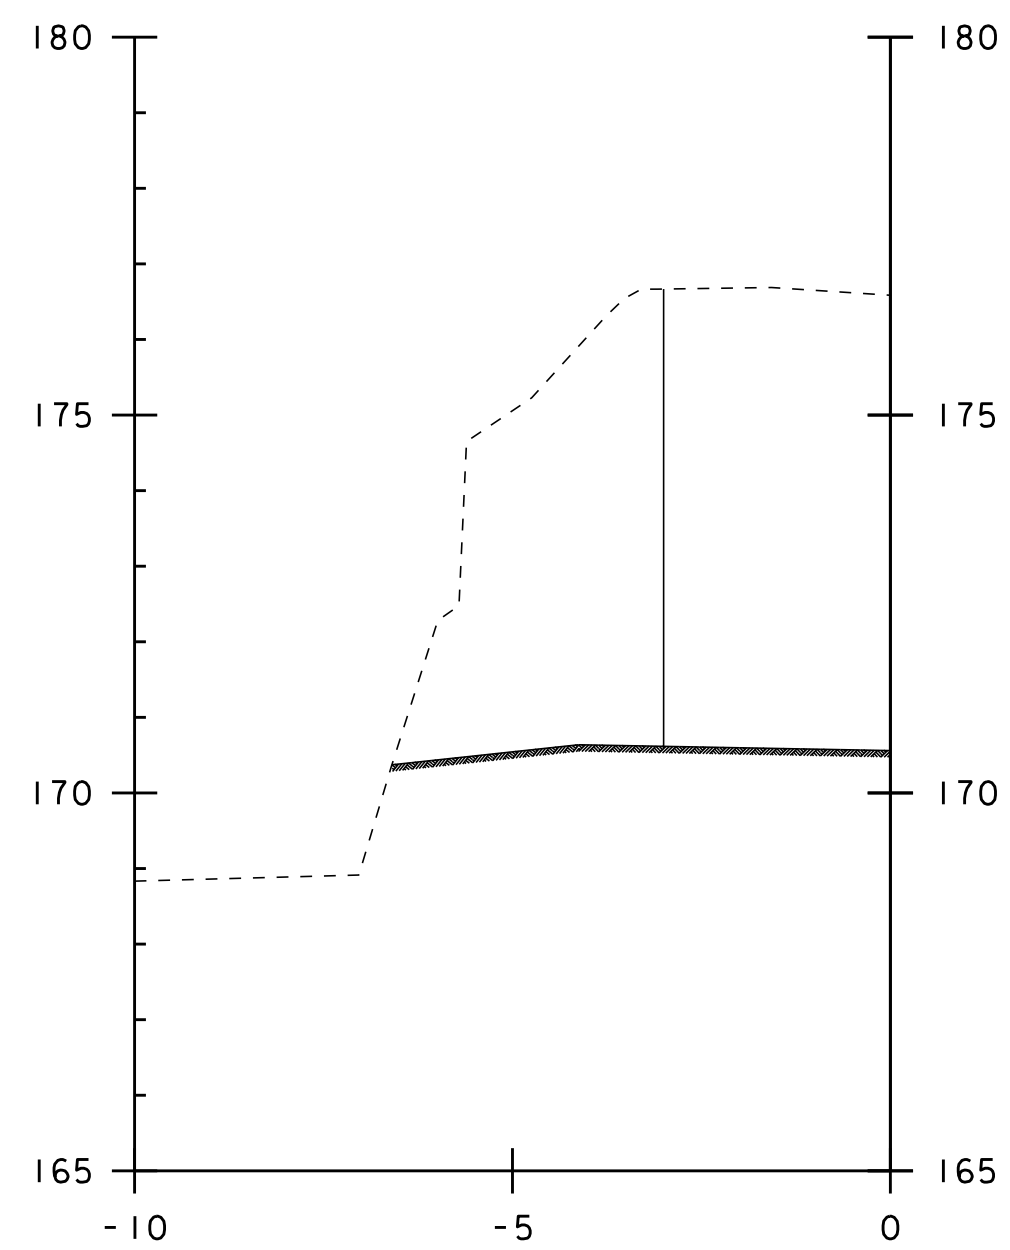


3+122.65

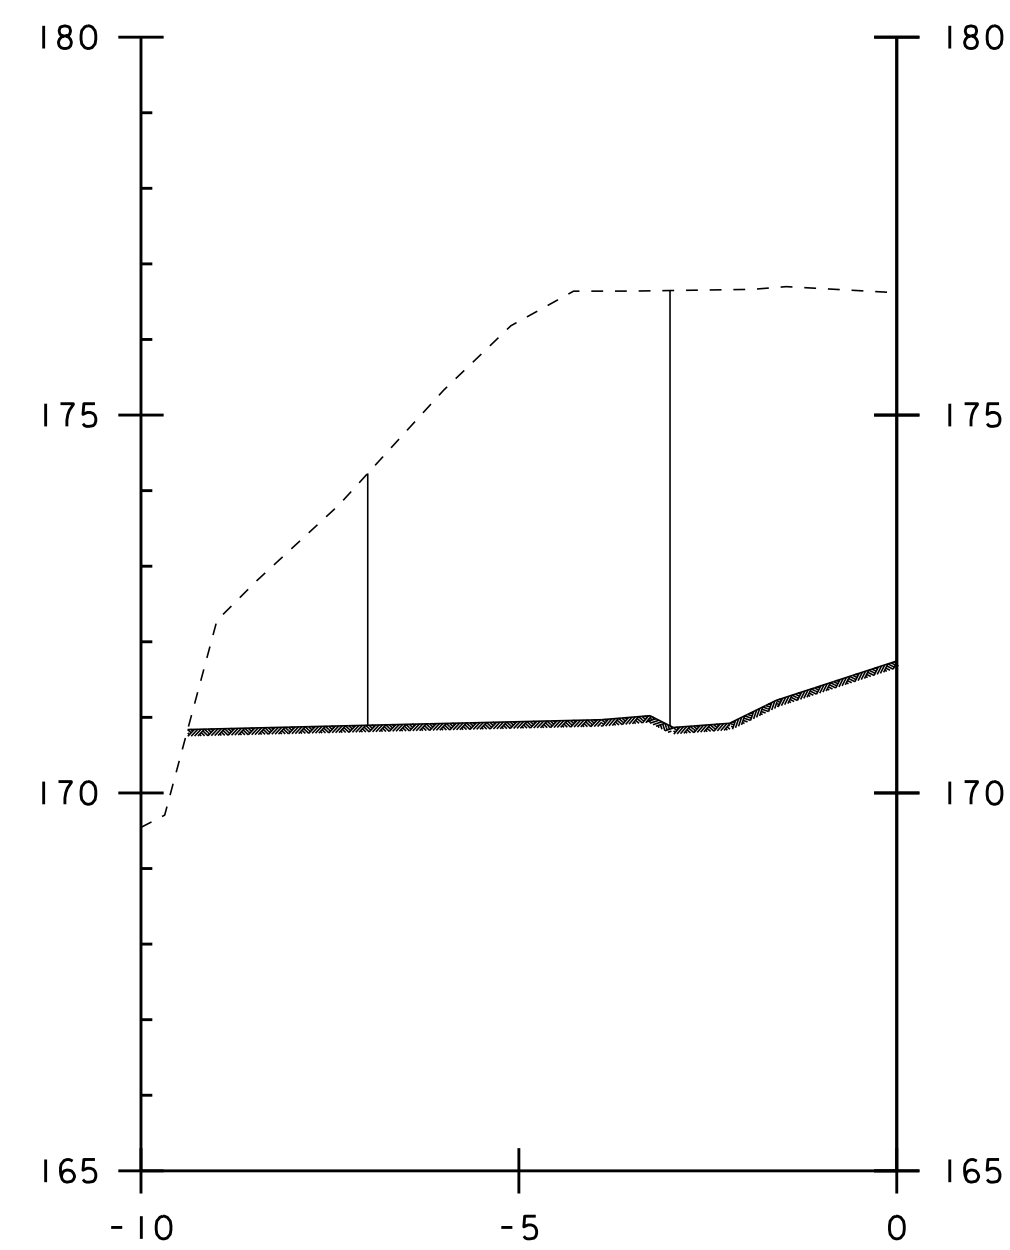

3+126.65

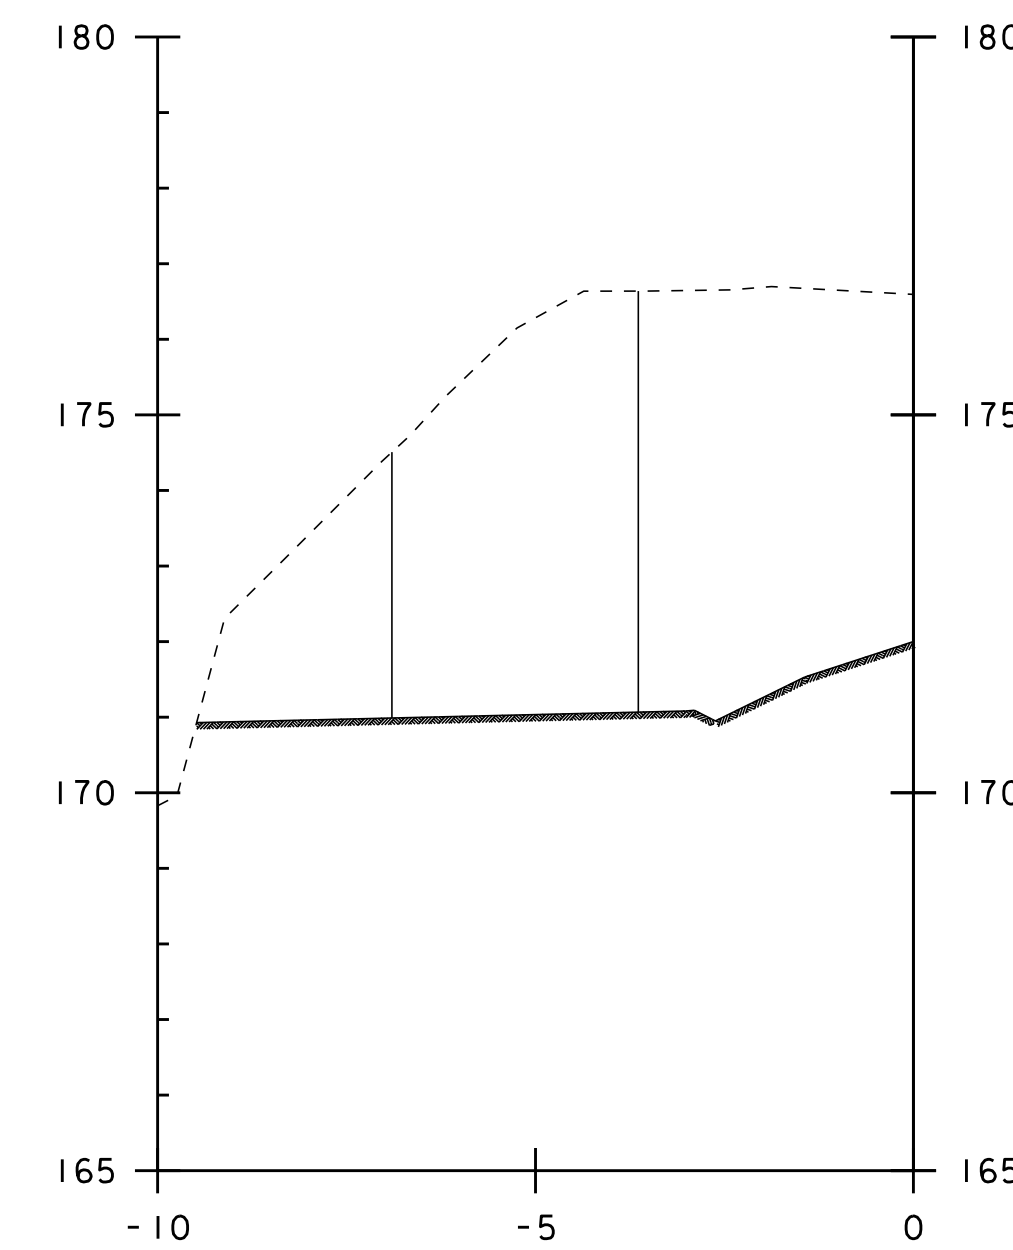

3+127.00

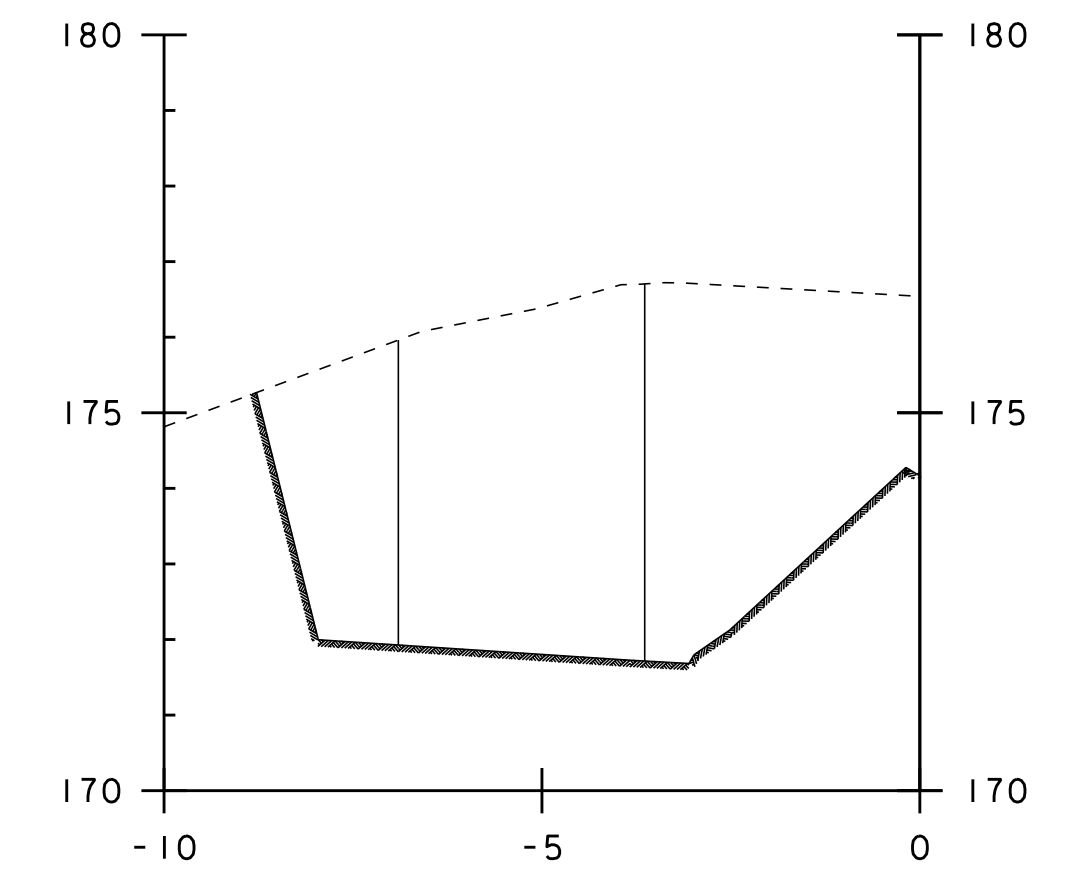

3+133.00

WINGWALL THREE
 STRUCTURE EXCAVATION
 UNCLASSIFIED CHANNEL EXCAVATION

