


222+32 Lt.
Begin Std. Steel Beam Guard Rail
w/ Wood Posts, Type II

222+07 ~ 222+32 Lt.
Breakaway Cable Terminal for
Std. Steel Beam Guard Rail
w/ Wood Posts, Type II


Std. Steel Beam G.R. w/
Wood Posts, Type II

31 1/2" Abrasive
See Std. Sheet 67A

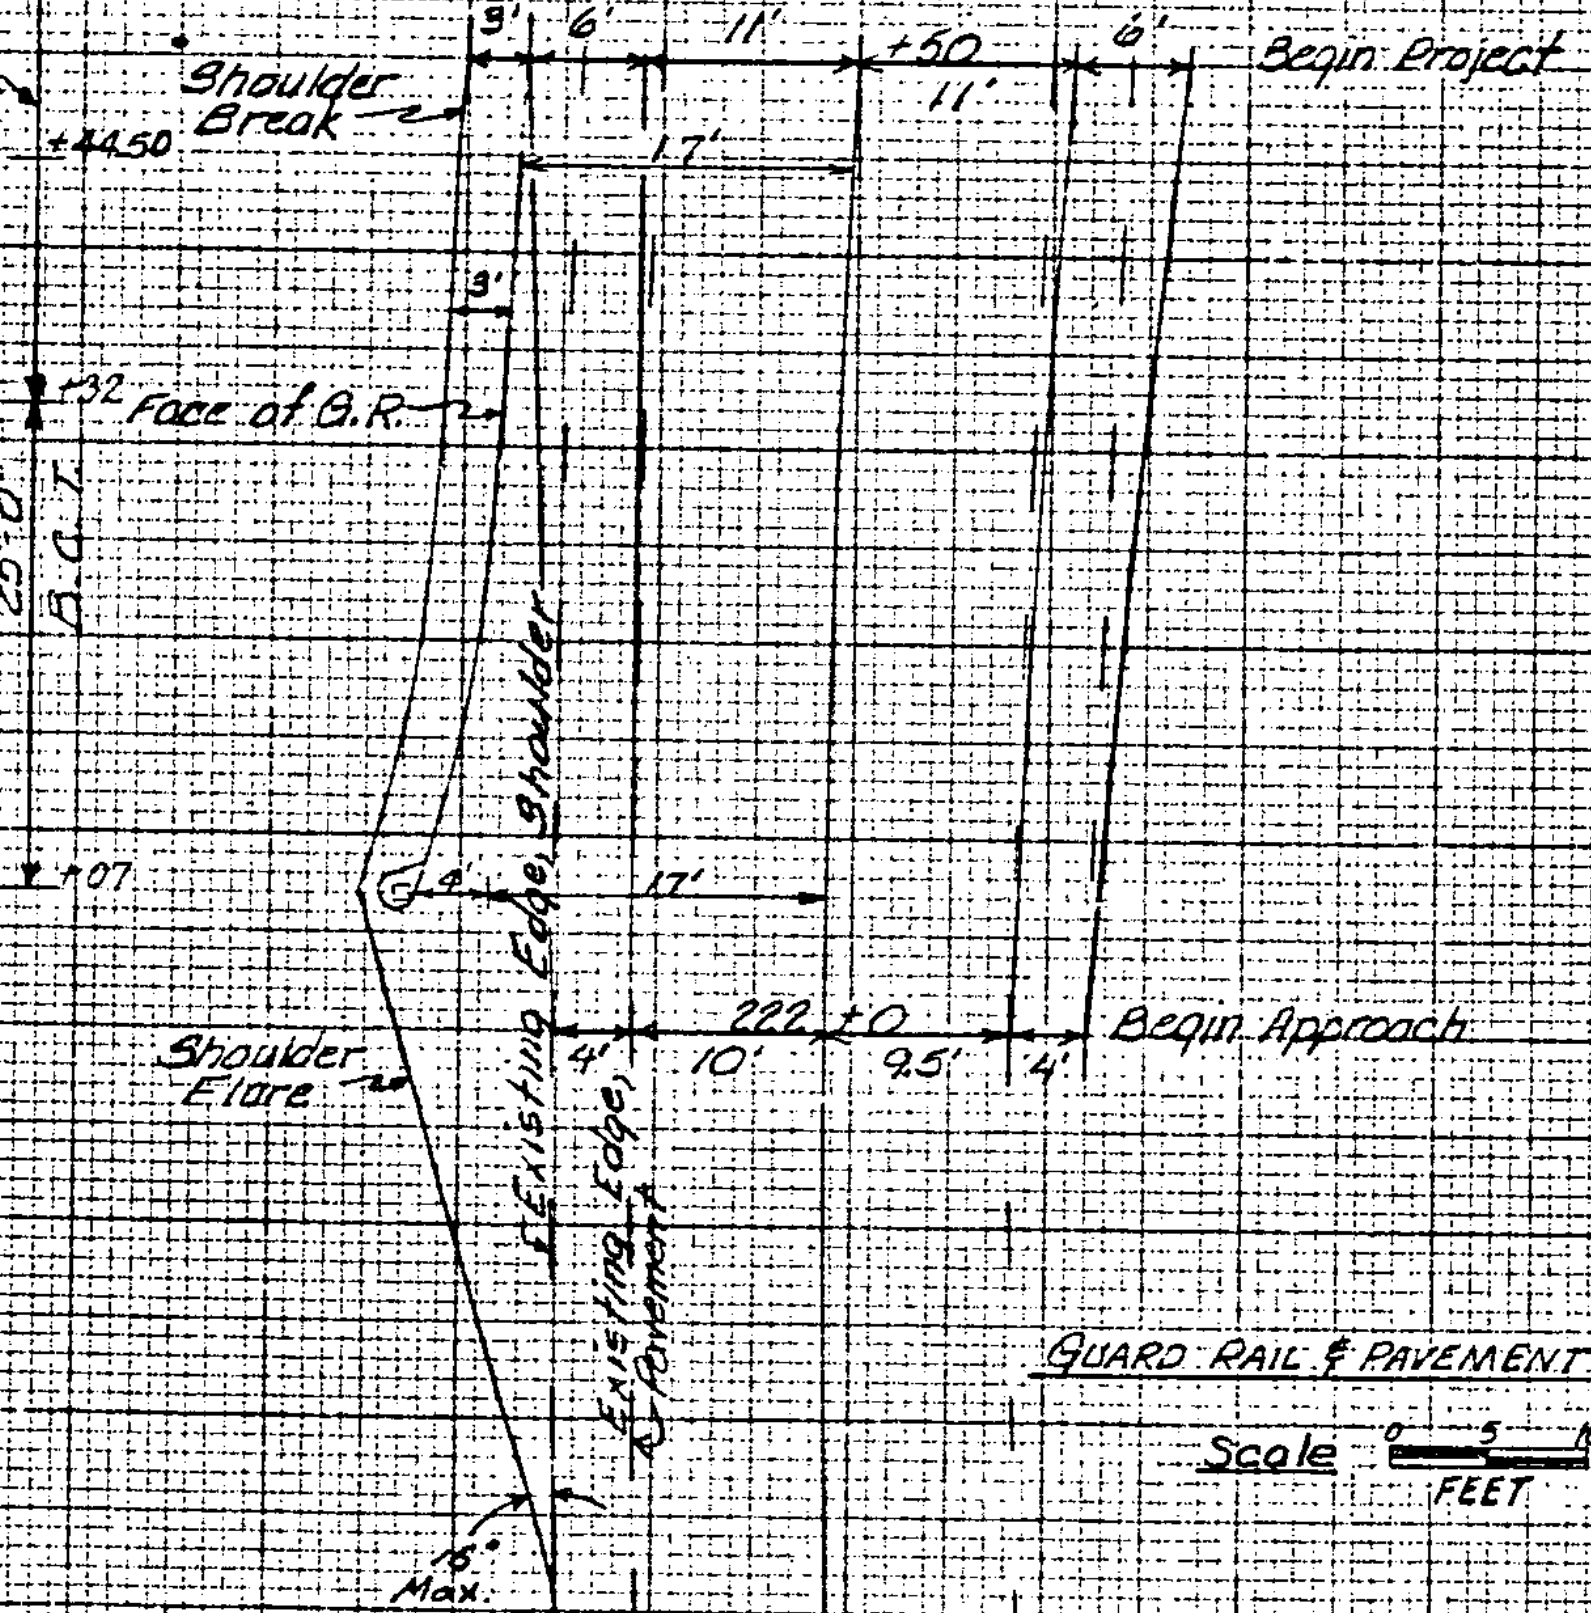

GUARD RAIL & PAVEMENT TRANSITION

Scale 1" = 3 FEET

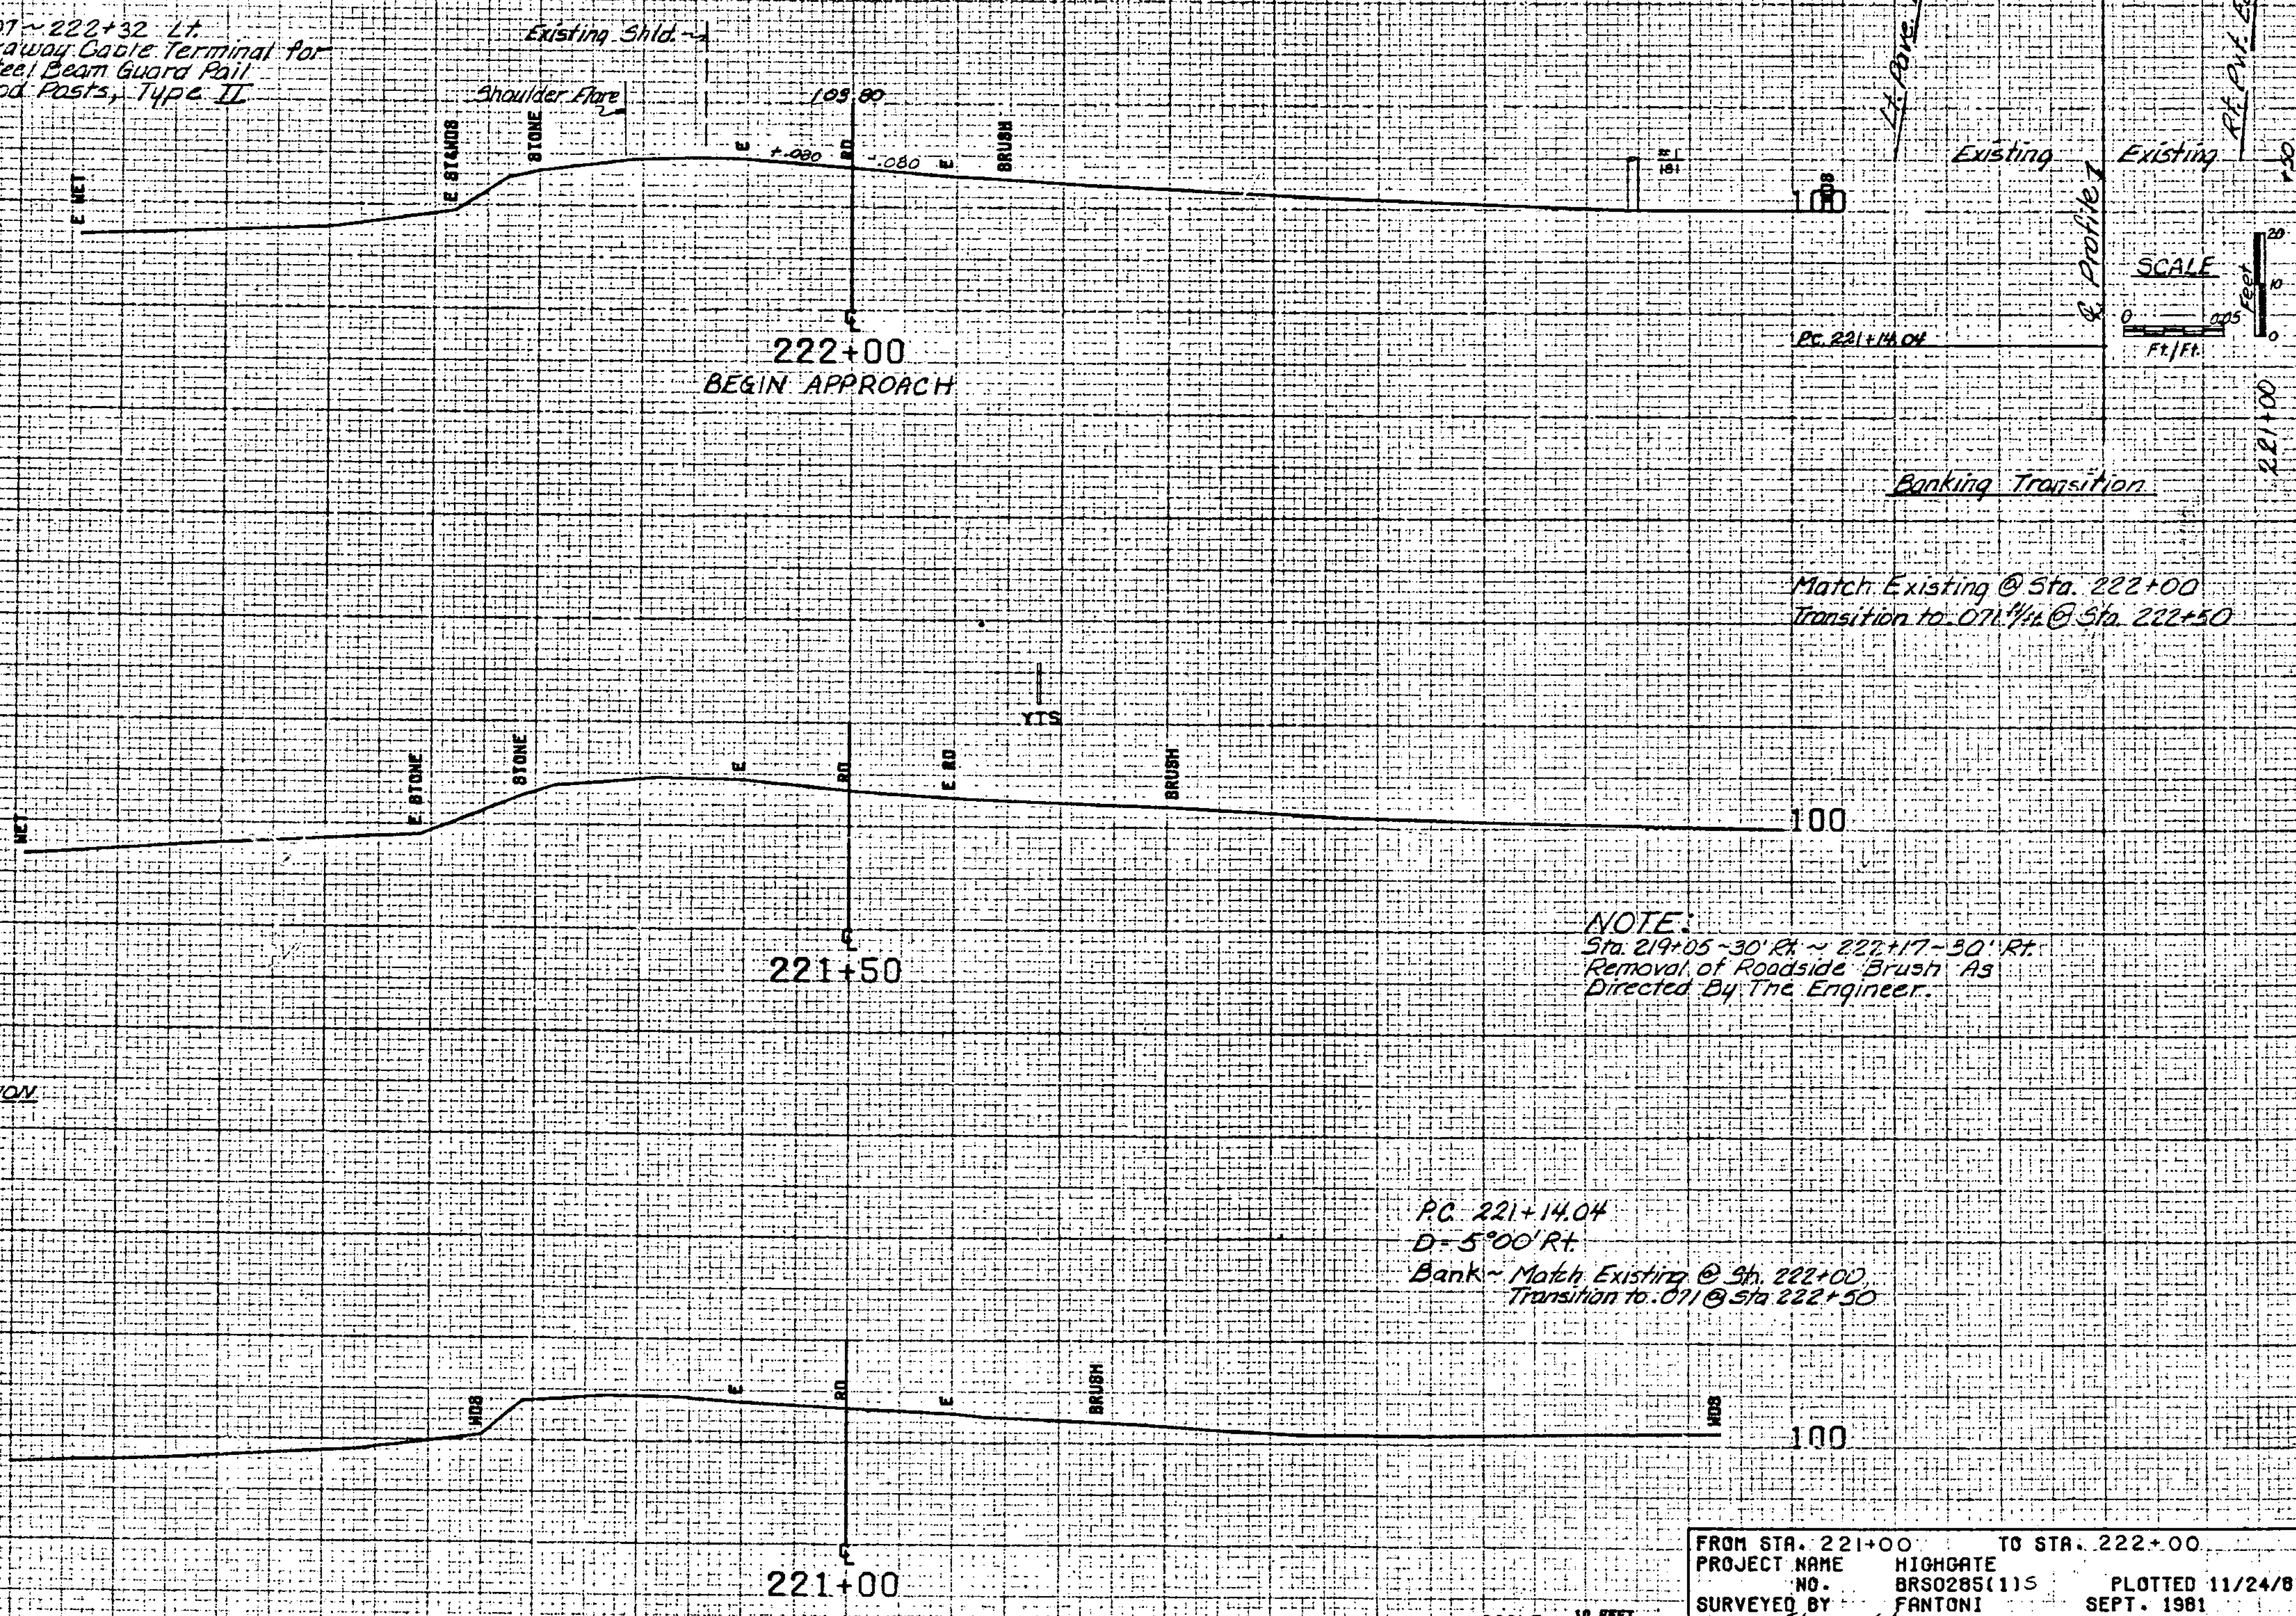

NOTE:
Sta. 219+05 ~ 30' Rt ~ 222+17 ~ 30' Rt.
Removal of Roadside Brush As
Directed By The Engineer.

PC 221+14.04
D=5°00' Rt.
Bank ~ Match Existing @ Sta. 222+00
Transition to 0.11 @ Sta. 222+50

| | |
|------------------|----------------|
| FROM STA. 221+00 | TO STA. 222+00 |
| PROJECT NAME | HIGHGATE |
| NO. | BR50285(115) |
| SURVEYED BY | FANTONI |
| SHEET 31 OF 64 | SHEETS |

PLOTTED 11/24/81
SEPT. 1981

SCALE 1" = 10 FEET