


For Guard Rail Details @
End of Bridge.
See Sheet 53 of 64 Sheets

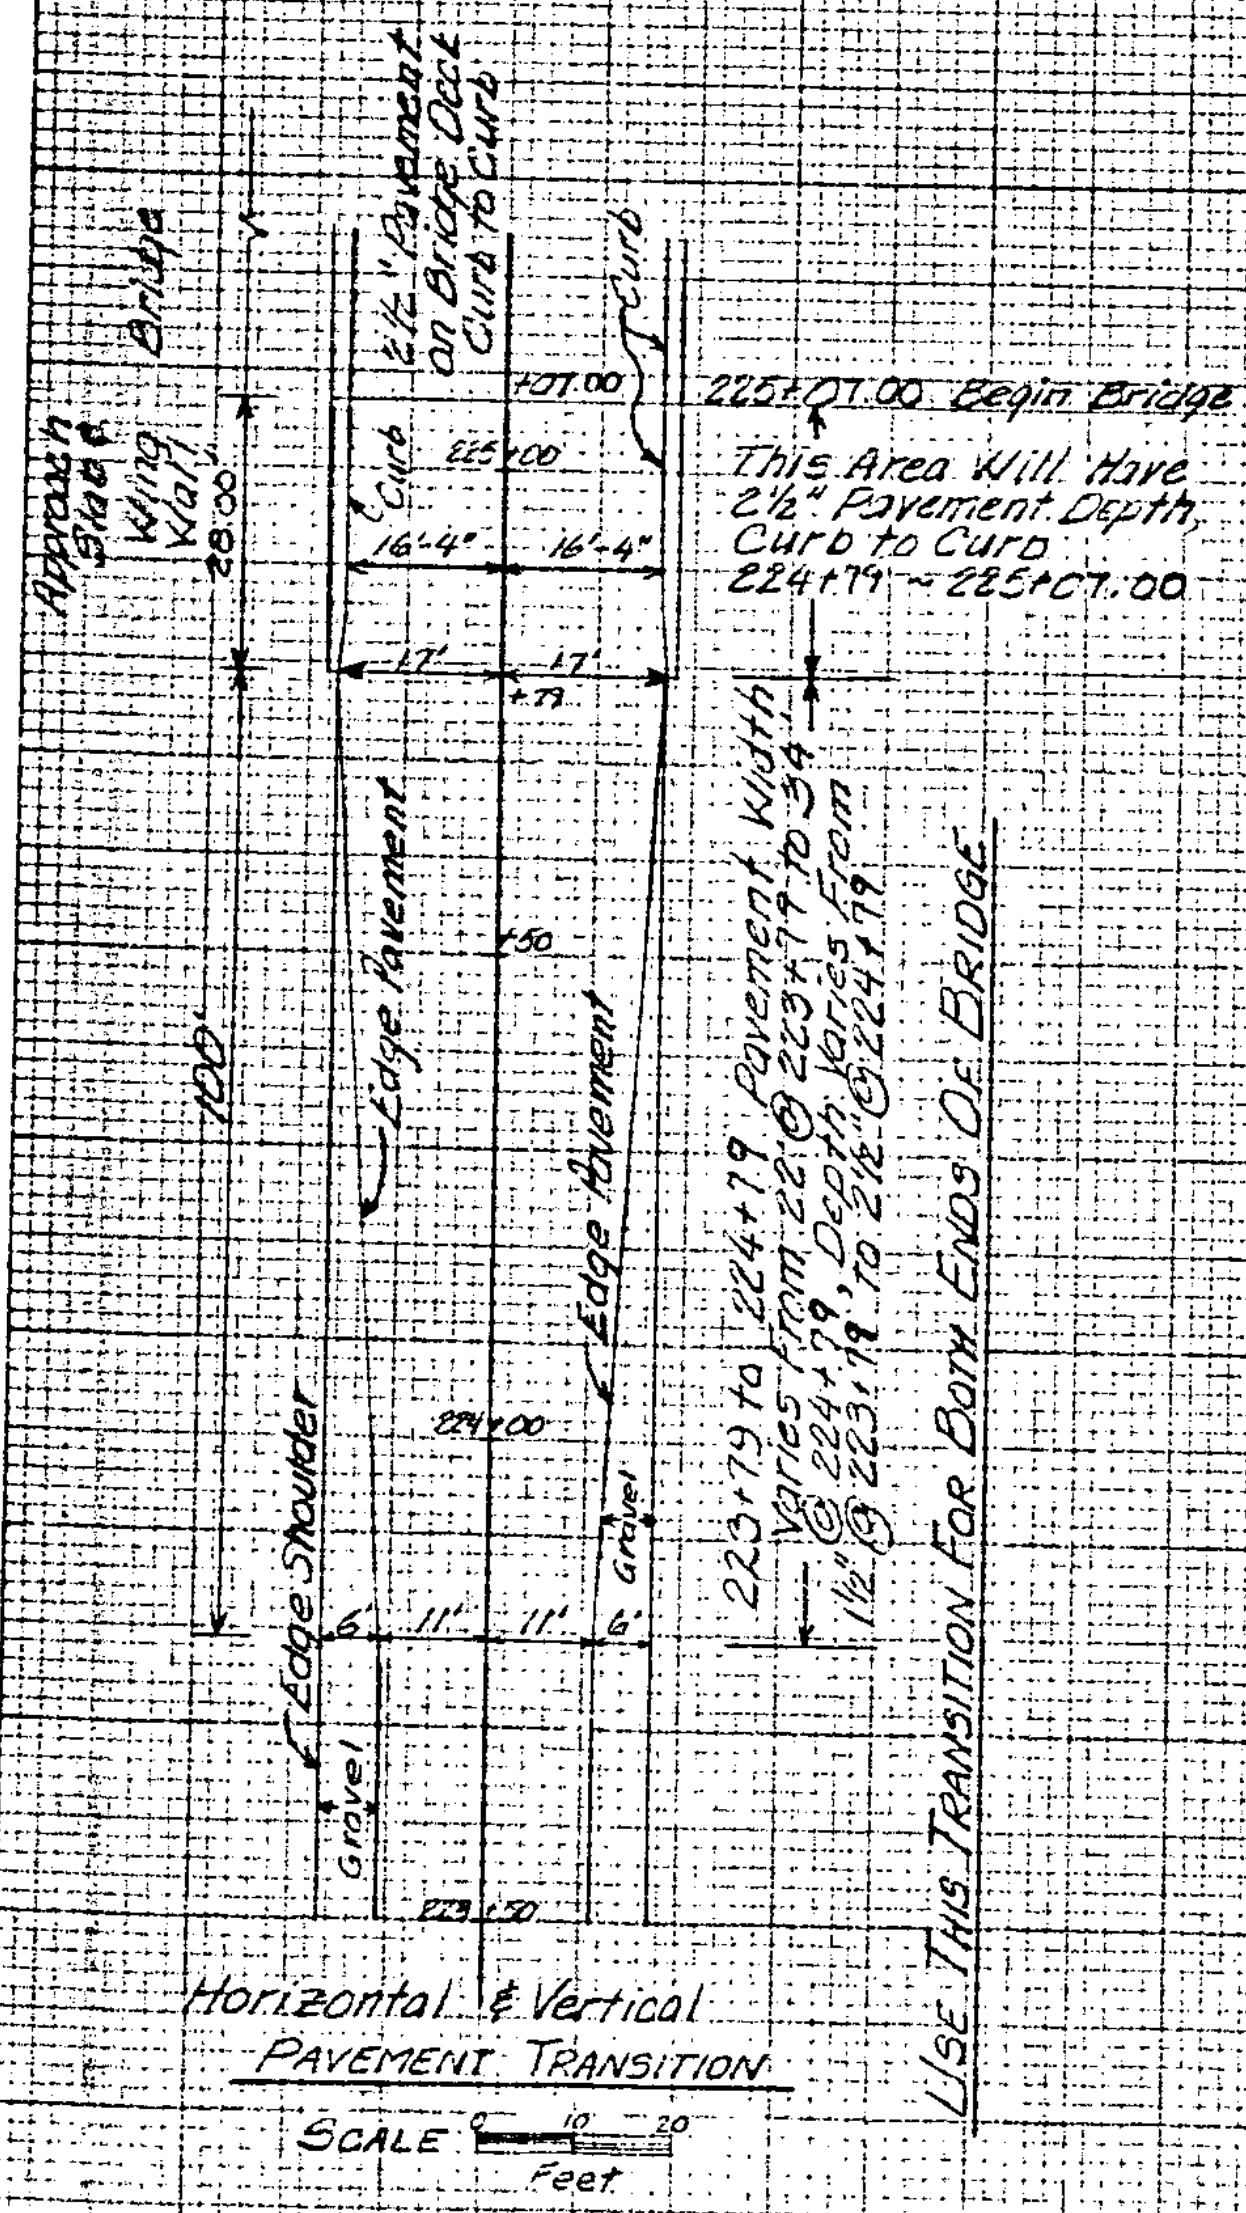

FROM STA. 224+00	TO STA. 225+00
PROJECT NAME	HIGHGATE
NO.	BR50285(1)S
SURVEYED BY	FANTONI
SHEET 53 OF 64 SHEETS	PLOTTED 11/24/81 SEPT. 1981