

Rev. PT 228+09.67


Rev. PG. 229+28.56

End App. (Match Exist.)

End Project

Banking Transition

228+50 Lt.
End Stone Fill, Type III
End Unclassified Channel Excavation
(For Stone Fill)

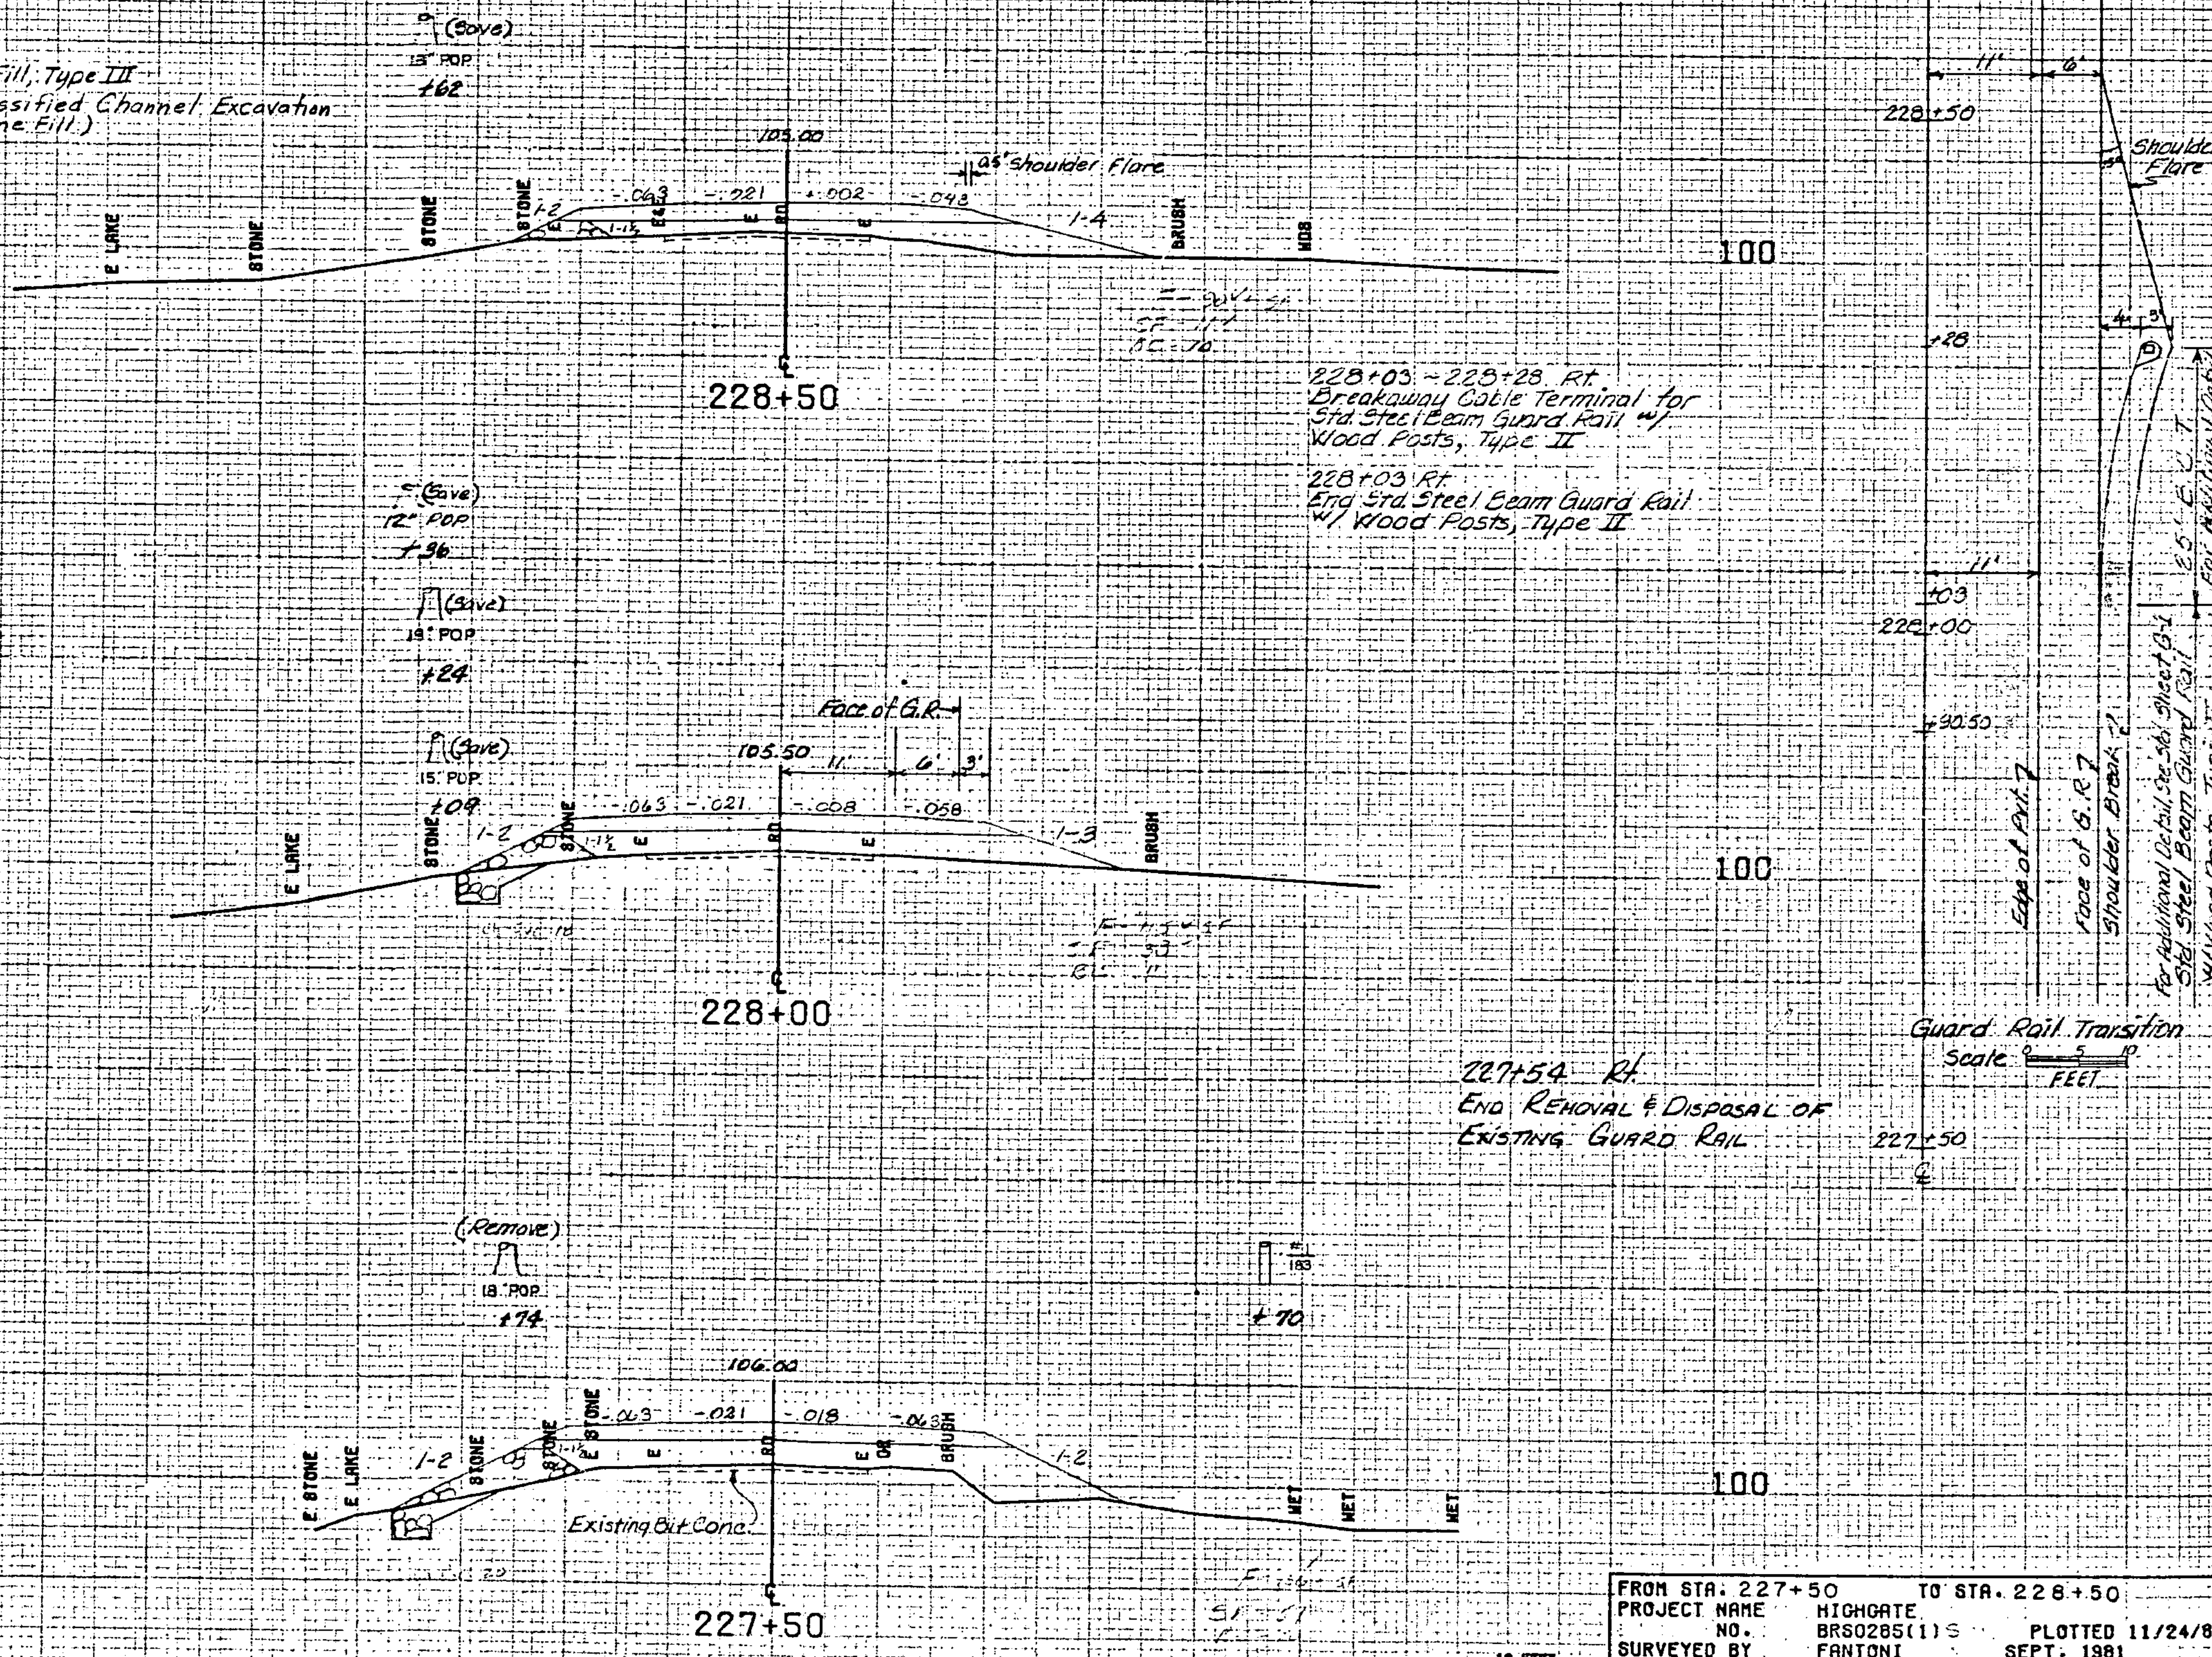

228+50

228+00

227+50

228+03 ~ 228+28 Rt.
Breakaway Cable Terminal for
Std. Steel Beam Guard Rail w/
Wood Posts, Type II

228+03 Rt.
End Std. Steel Beam Guard Rail
w/ Wood Posts, Type II

227+54 Rt.
END REMOVAL & DISPOSAL OF
EXISTING GUARD RAIL

Guard Rail Transition
Scale: 1" = 10'
FEET

FROM STA. 227+50 TO STA. 228+50
PROJECT NAME HIGHGATE
NO. BR50285(1)S PLOTTED 11/24/81
SURVEYED BY FANTONI SHEET 36 OF 64 SHEETS
SEPT. 1981

SCALE 1" = 10'
FEET