
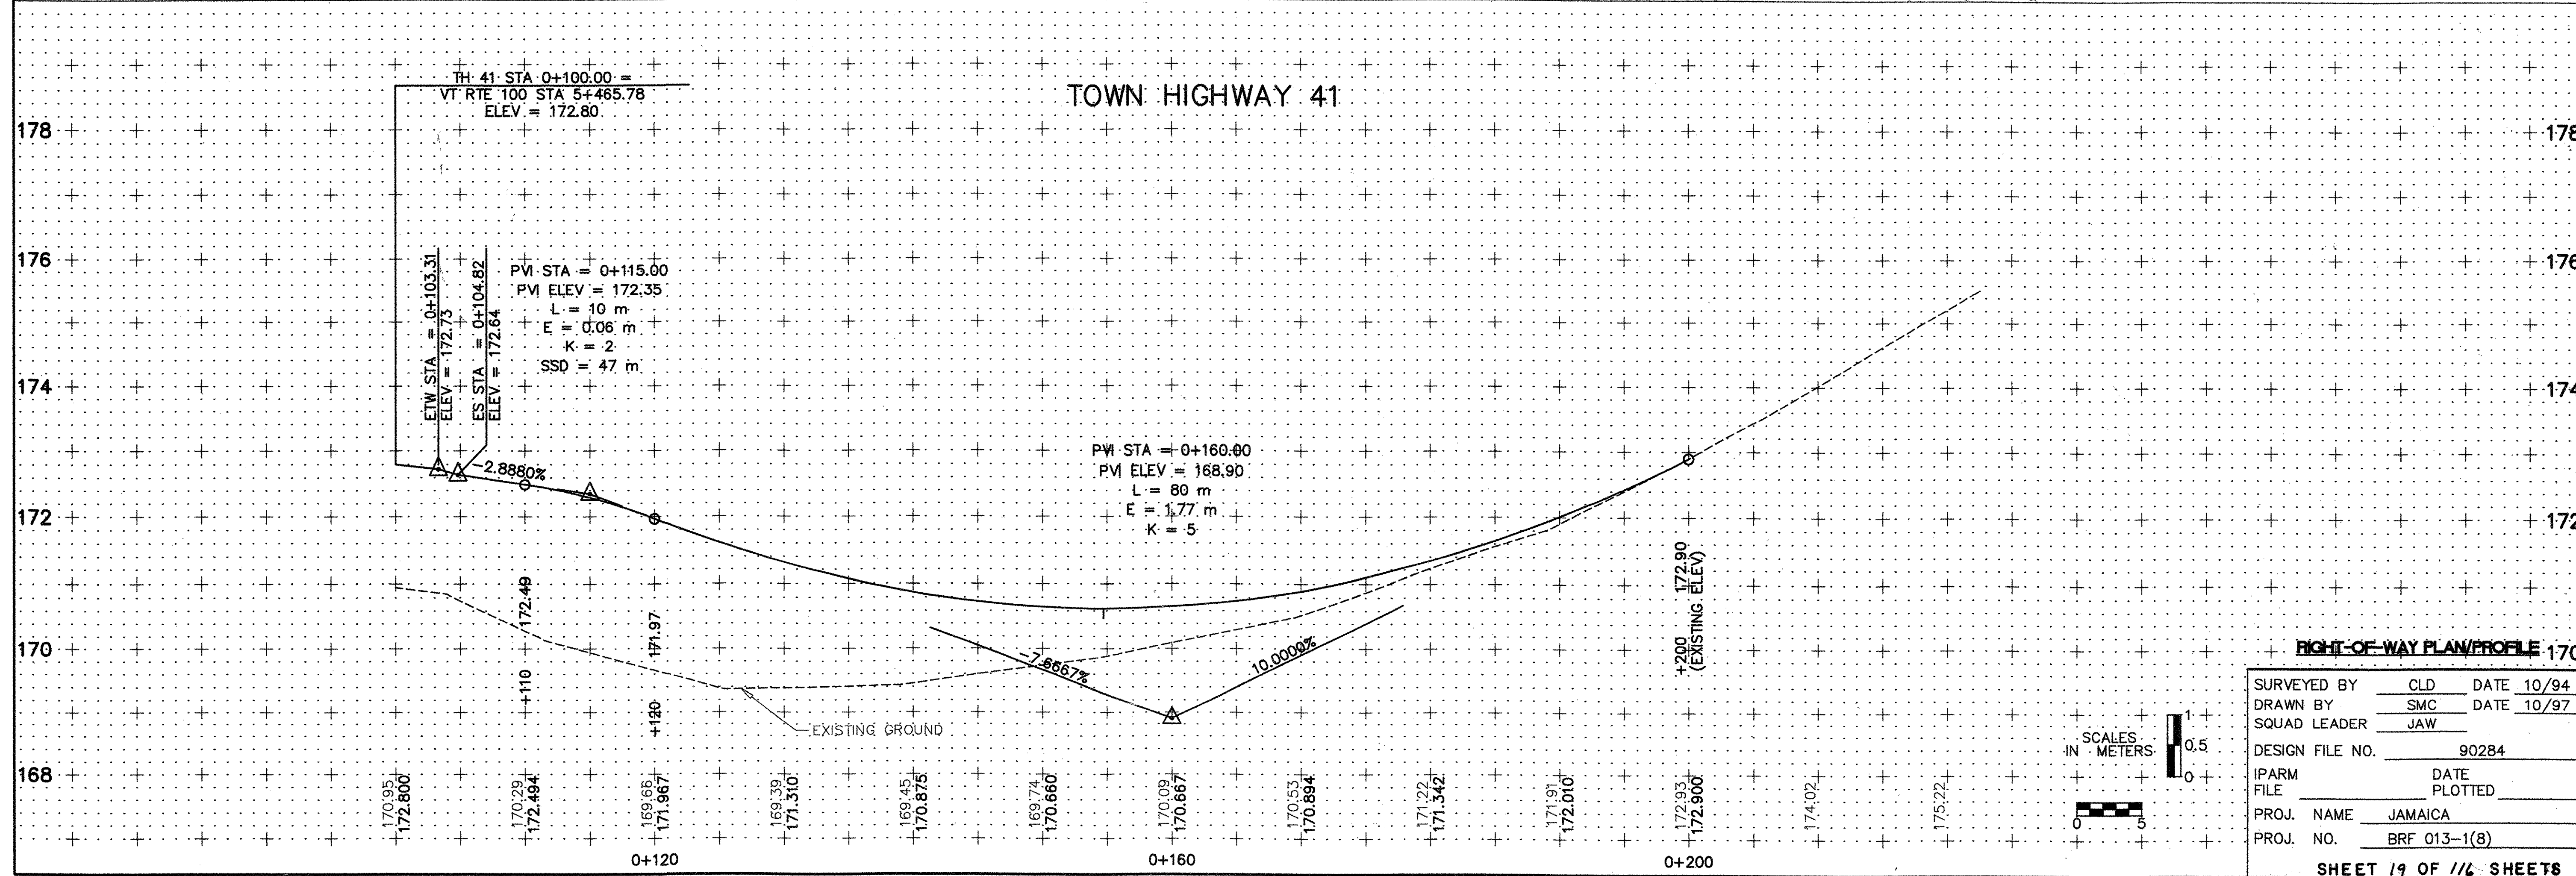


DATUM

VERTICAL	NGVD 1929
HORIZONTAL	N/A

POH — AERIAL RELOCATION OWNED BY CENTRAL VERMONT PUBLIC SERVICE AND VERIZON NEW ENGLAND, INC.

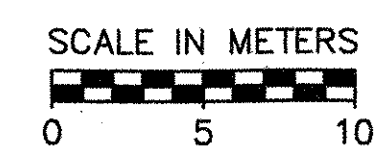

RIGHT-OF-WAY PLAN/PROFILE 170

SURVEYED BY	CLD	DATE	10/94
DRAWN BY	SMC	DATE	10/97
SQUAD LEADER	JAW		
DESIGN FILE NO.	90284		
IPARM FILE		DATE PLOTTED	
PROJ. NAME	JAMAICA		
PROJ. NO.	BRF 013-1(8)		

SHEET 19 OF 16 SHEETS