

**EXTRA DEPTH OF SUBBASE**  
 STA 5+462.5 TO 5+478.5  
 STA 5+559 TO 5+574

**GRANULAR BORROW**  
 STA 5+462.5 TO 5+478.5  
 STA 5+559 TO 5+574

**GUARDRAIL APPROACH SECTION, NETC 2 RAIL**  
 STA 0+109.6 RT (TH 41) TO STA 5+474.7 LT  
 STA 0+210.3 RT (TH 43) TO STA 5+474.7 RT  
 STA 5+563.0 TO 5+570.6 LT & RT

**SNOW FENCE (MODIFIED)**  
 STA 5+546 TO 5+586 RT  
 MARCH, ROBIN C.

**STEEL BEAM GUARDRAIL**  
 STA 5+420 TO 0+114.1 LT (TH 41)  
 STA 5+420 TO 0+215.8 RT (TH 43)  
 STA 5+570.6 TO 5+600 RT  
 STA 5+570.6 TO 5+600 LT  
 STA 0+109.6 TO 0+121.0 RT (TH 41)  
 STA 0+210.3 TO 0+240.0 LT (TH 43)

**REMOVAL & DISP. OF GUARDRAIL**  
 STA 5+420 TO 5+429 RT  
 STA 5+472 TO 5+482 LT  
 STA 5+478 TO 5+482 RT  
 STA 5+556 TO 5+592 RT  
 STA 5+556 LT TO 5+600 LT


**MODIFIED ECCENTRIC LOADER TERMINAL**  
 STA 0+114.1 TO 0+125.5 LT (TH 41)  
 STA 0+121.0 TO 0+132.4 RT (TH 41)  
 STA 0+215.8 TO 0+227.2 RT (TH 43)

**STONE FILL TYPE I**  
 VT RTE 100 STA 5+420 LT TO  
 TH 41 STA 0+120 LT-600 DEEP

**REMOVING AND RESETTING FENCE**  
 STA 5+420 RT TO 0+240 RT (TH 43)

KONOPAS, DOROTHY W.  
 WONDROFSKI, HERMAN F.

36

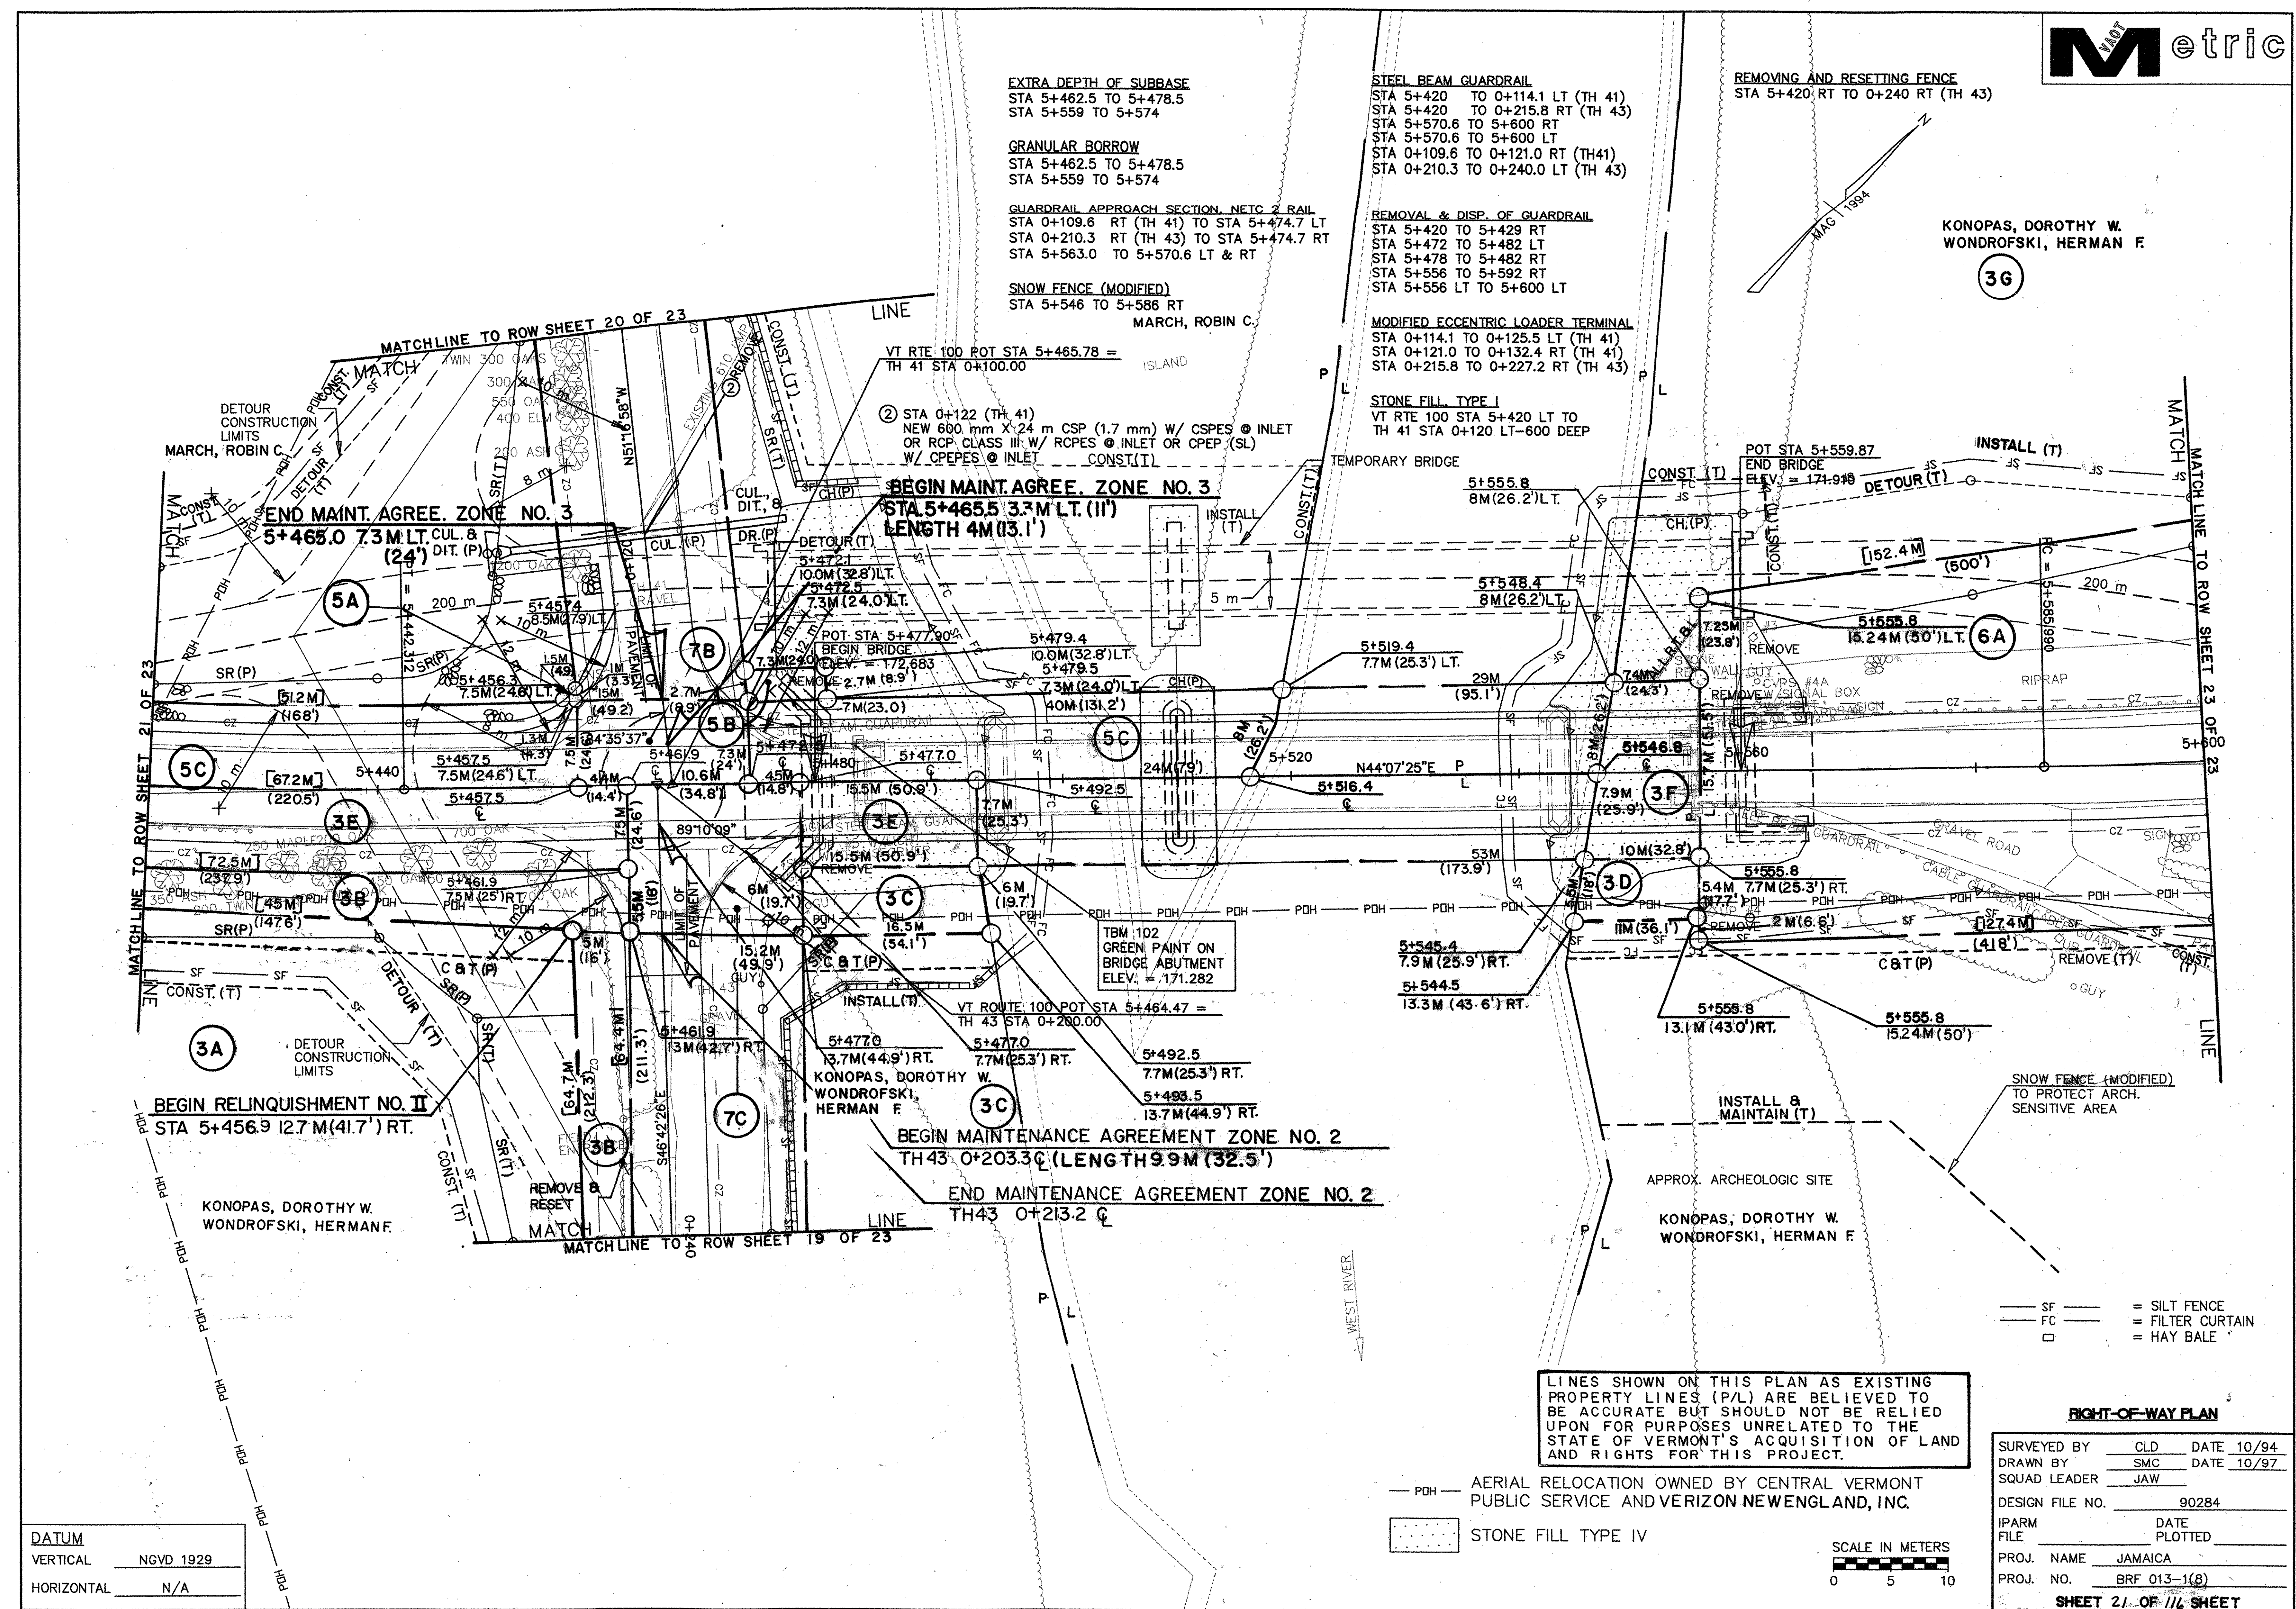

**DATUM**

VERTICAL	NGVD 1929
HORIZONTAL	N/A

LINES SHOWN ON THIS PLAN AS EXISTING PROPERTY LINES (P/L) ARE BELIEVED TO BE ACCURATE BUT SHOULD NOT BE RELIED UPON FOR PURPOSES UNRELATED TO THE STATE OF VERMONT'S ACQUISITION OF LAND AND RIGHTS FOR THIS PROJECT.

— PDH — AERIAL RELOCATION OWNED BY CENTRAL VERMONT PUBLIC SERVICE AND VERIZON NEWENGLAND, INC.

STONE FILL TYPE IV

SCALE IN METERS  
 0 5 10

**RIGHT-OF-WAY PLAN**

SURVEYED BY	CLD	DATE	10/94
DRAWN BY	SMC	DATE	10/97
SQUAD LEADER	JAW		
DESIGN FILE NO.	90284		
IPARM FILE	DATE PLOTTED		
PROJ. NAME	JAMAICA		
PROJ. NO.	BRF 013-1(B)		

**SHEET 21 OF 116 SHEET**