


DATUM  
 VERTICAL NGVD 1929  
 HORIZONTAL N/A

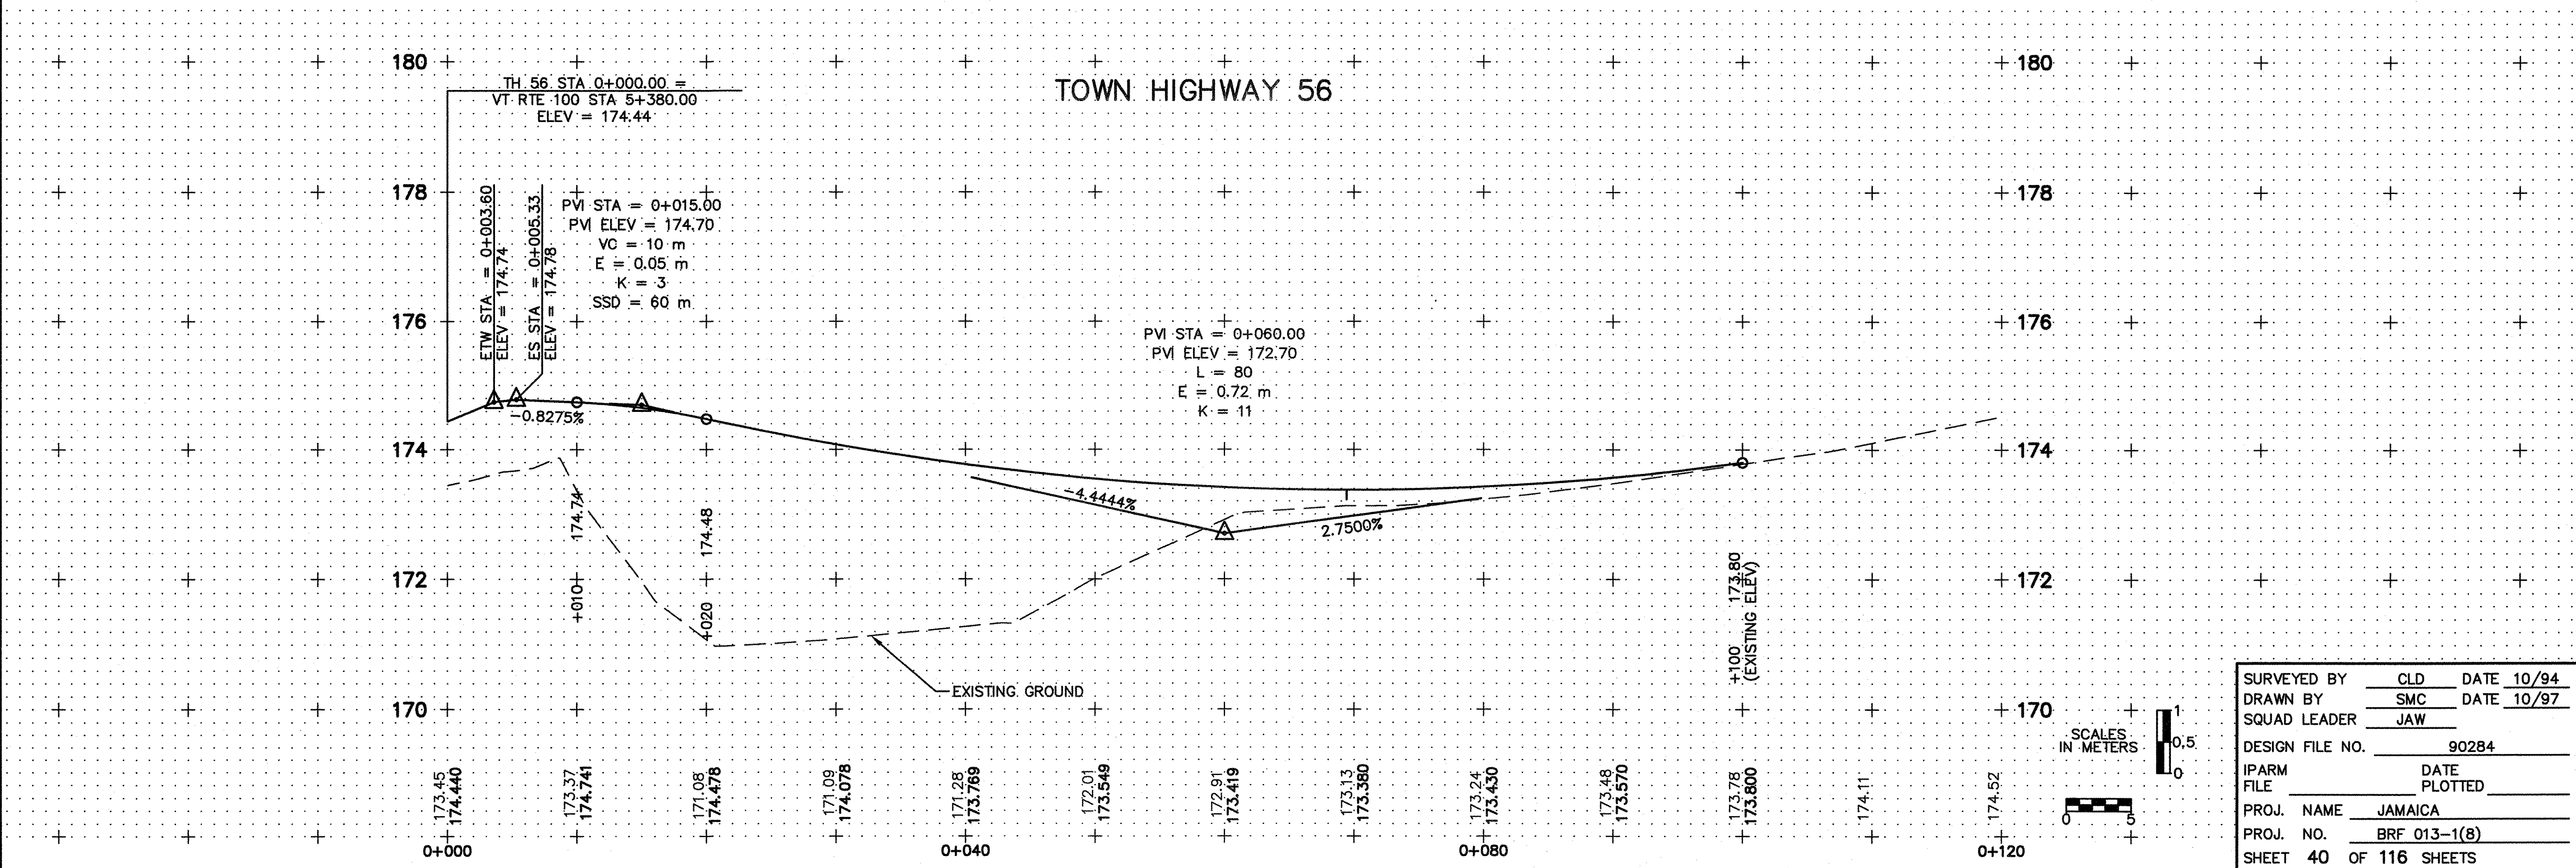

SURVEYED BY	CLD	DATE	10/94
DRAWN BY	SMC	DATE	10/97
SQUAD LEADER	JAW		
DESIGN FILE NO.	90284		
IPARM FILE		DATE PLOTTED	
PROJ. NAME	JAMAICA		
PROJ. NO.	BRF 013-1(8)		
SHEET	40 OF 116 SHEETS		