

**EXTRA DEPTH OF SUBBASE**  
 STA 5+462.5 TO 5+478.5 C/L  
 STA 5+559 TO 5+574 C/L

**GRANULAR BORROW**  
 STA 5+462.5 TO 5+478.5 C/L

**GUARDRAIL APPROACH SECTION, NETC 2 RAIL**  
 STA 0+109.7 RT (TH 41) TO STA 5+475.1 LT  
 STA 0+210.2 (TH 43) TO STA 5+475.1 RT  
 STA 5+567.3 TO 5+574.9 LT & RT

**SNOW FENCE (MODIFIED)**  
 STA 5+546 TO 5+586 RT



**STEEL BEAM GUARDRAIL**  
 STA 5+420 TO 0+125.5 LT (TH 41)  
 STA 5+420 TO 0+227.2 RT (TH 43)  
 STA 5+574.9 TO 5+600 RT  
 STA 5+574.9 TO 5+600 LT  
 STA 0+109.7 TO 0+132.4 RT (TH 41)  
 STA 0+210.2 TO 0+240.0 LT (TH 43)

**REMOVAL & DISP. OF GUARDRAIL**  
~~STA 5+420 TO 5+429 RT NOT THERE~~  
 STA 5+472 TO 5+482 LT  
 STA 5+478 TO 5+482 RT  
 STA 5+556 TO 5+592 RT  
 STA 5+556 TO 5+600 LT

**ANCHOR FOR STEEL BEAM RAIL**  
 STA 0+125.5 LT (TH 41)  
 STA 0+227.2 RT (TH 43)  
 STA 0+132.4 RT (TH 41)

**STONE FILL TYPE I**  
 VT RTE 100 STA 5+420 TO  
 TH 41 STA 0+120 LT-800 DEEP

**REMOVING AND RESETTING FENCE**  
 STA 5+420 TO 0+240 RT (TH 43)

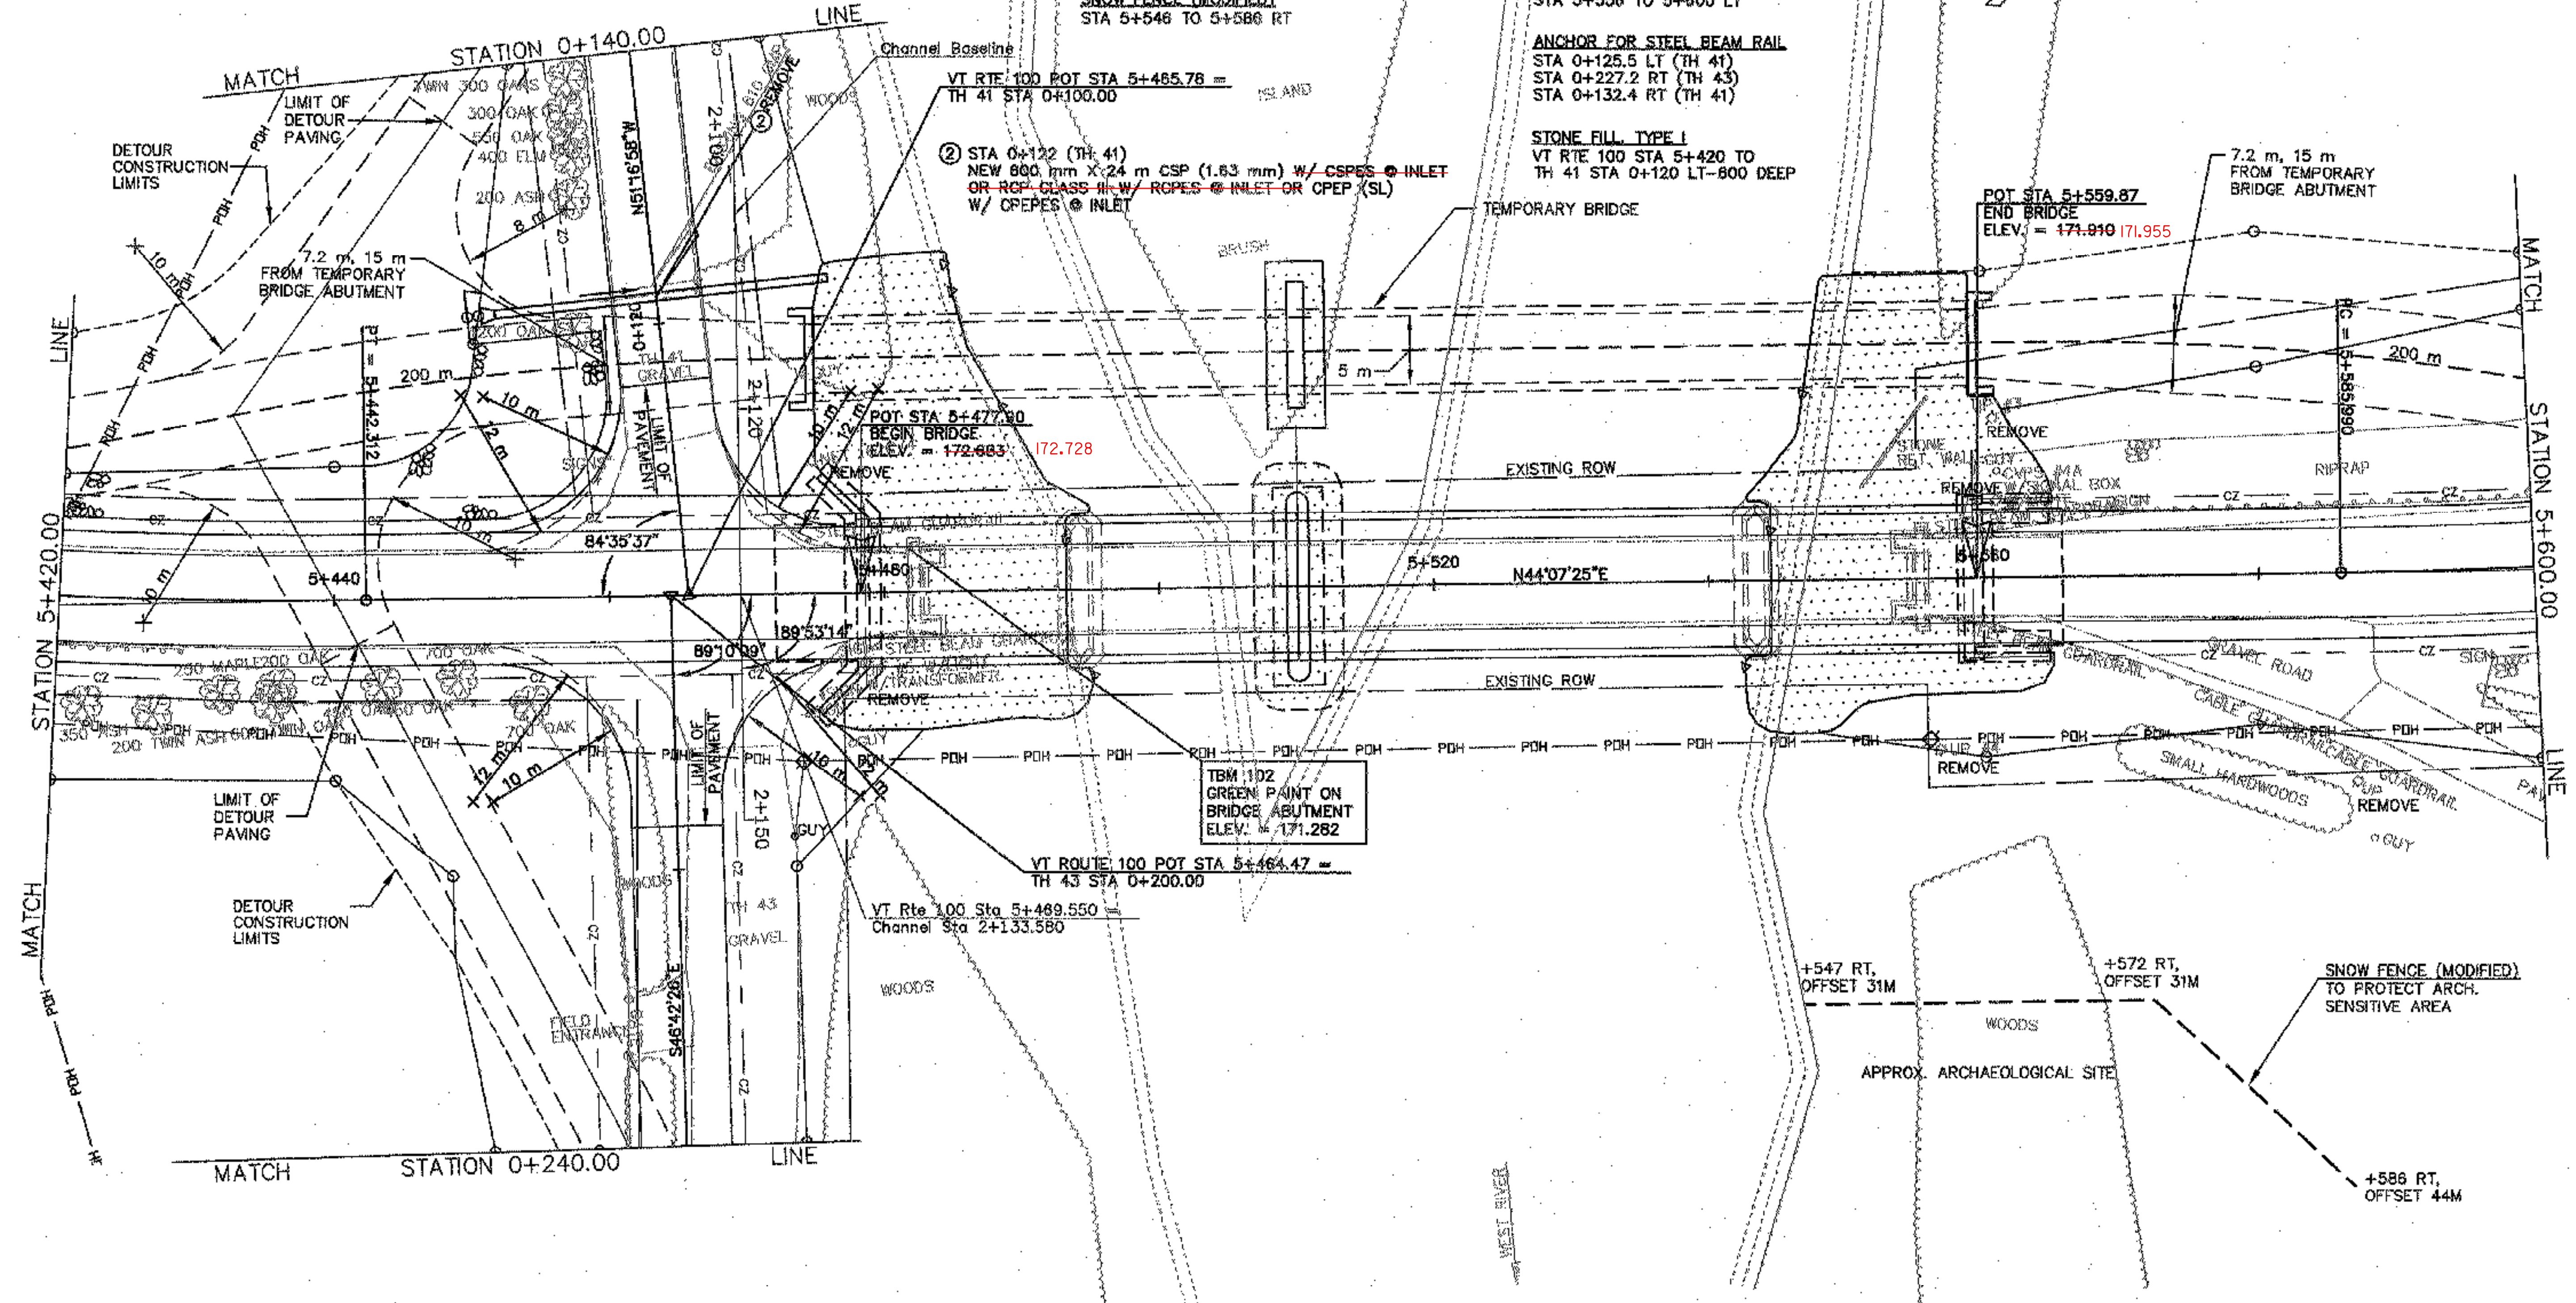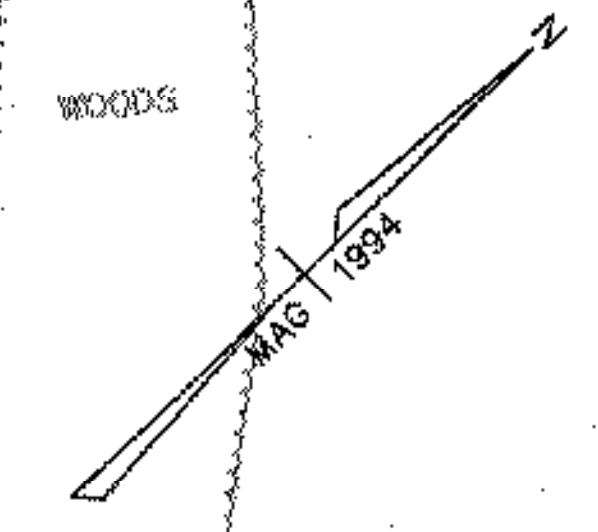


TBM 102  
 GREEN PAINT ON  
 BRIDGE ABUTMENT  
 ELEV. = 171.262

**GENERAL PLAN**

SURVEYED BY	CLD	DATE	10/94
DRAWN BY	SMC	DATE	10/97
SQUAD LEADER	JAW		
DESIGN FILE NO.	90284		
IPARM FILE	DATE PLOTTED		
PROJ. NAME	JAMAICA		
PROJ. NO.	BRF 013-1(8)		
SHEET	41 OF 116 SHEETS		

— PDH — AERIAL RELOCATION OWNED BY CENTRAL VERMONT PUBLIC SERVICE AND VERIZON

STONE FILL TYPE IV

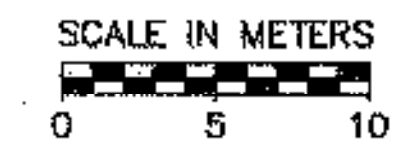

**DATUM**

VERTICAL	NGVD 1929
HORIZONTAL	N/A