


DATUM	
VERTICAL	NGVD 1929
HORIZONTAL	N/A

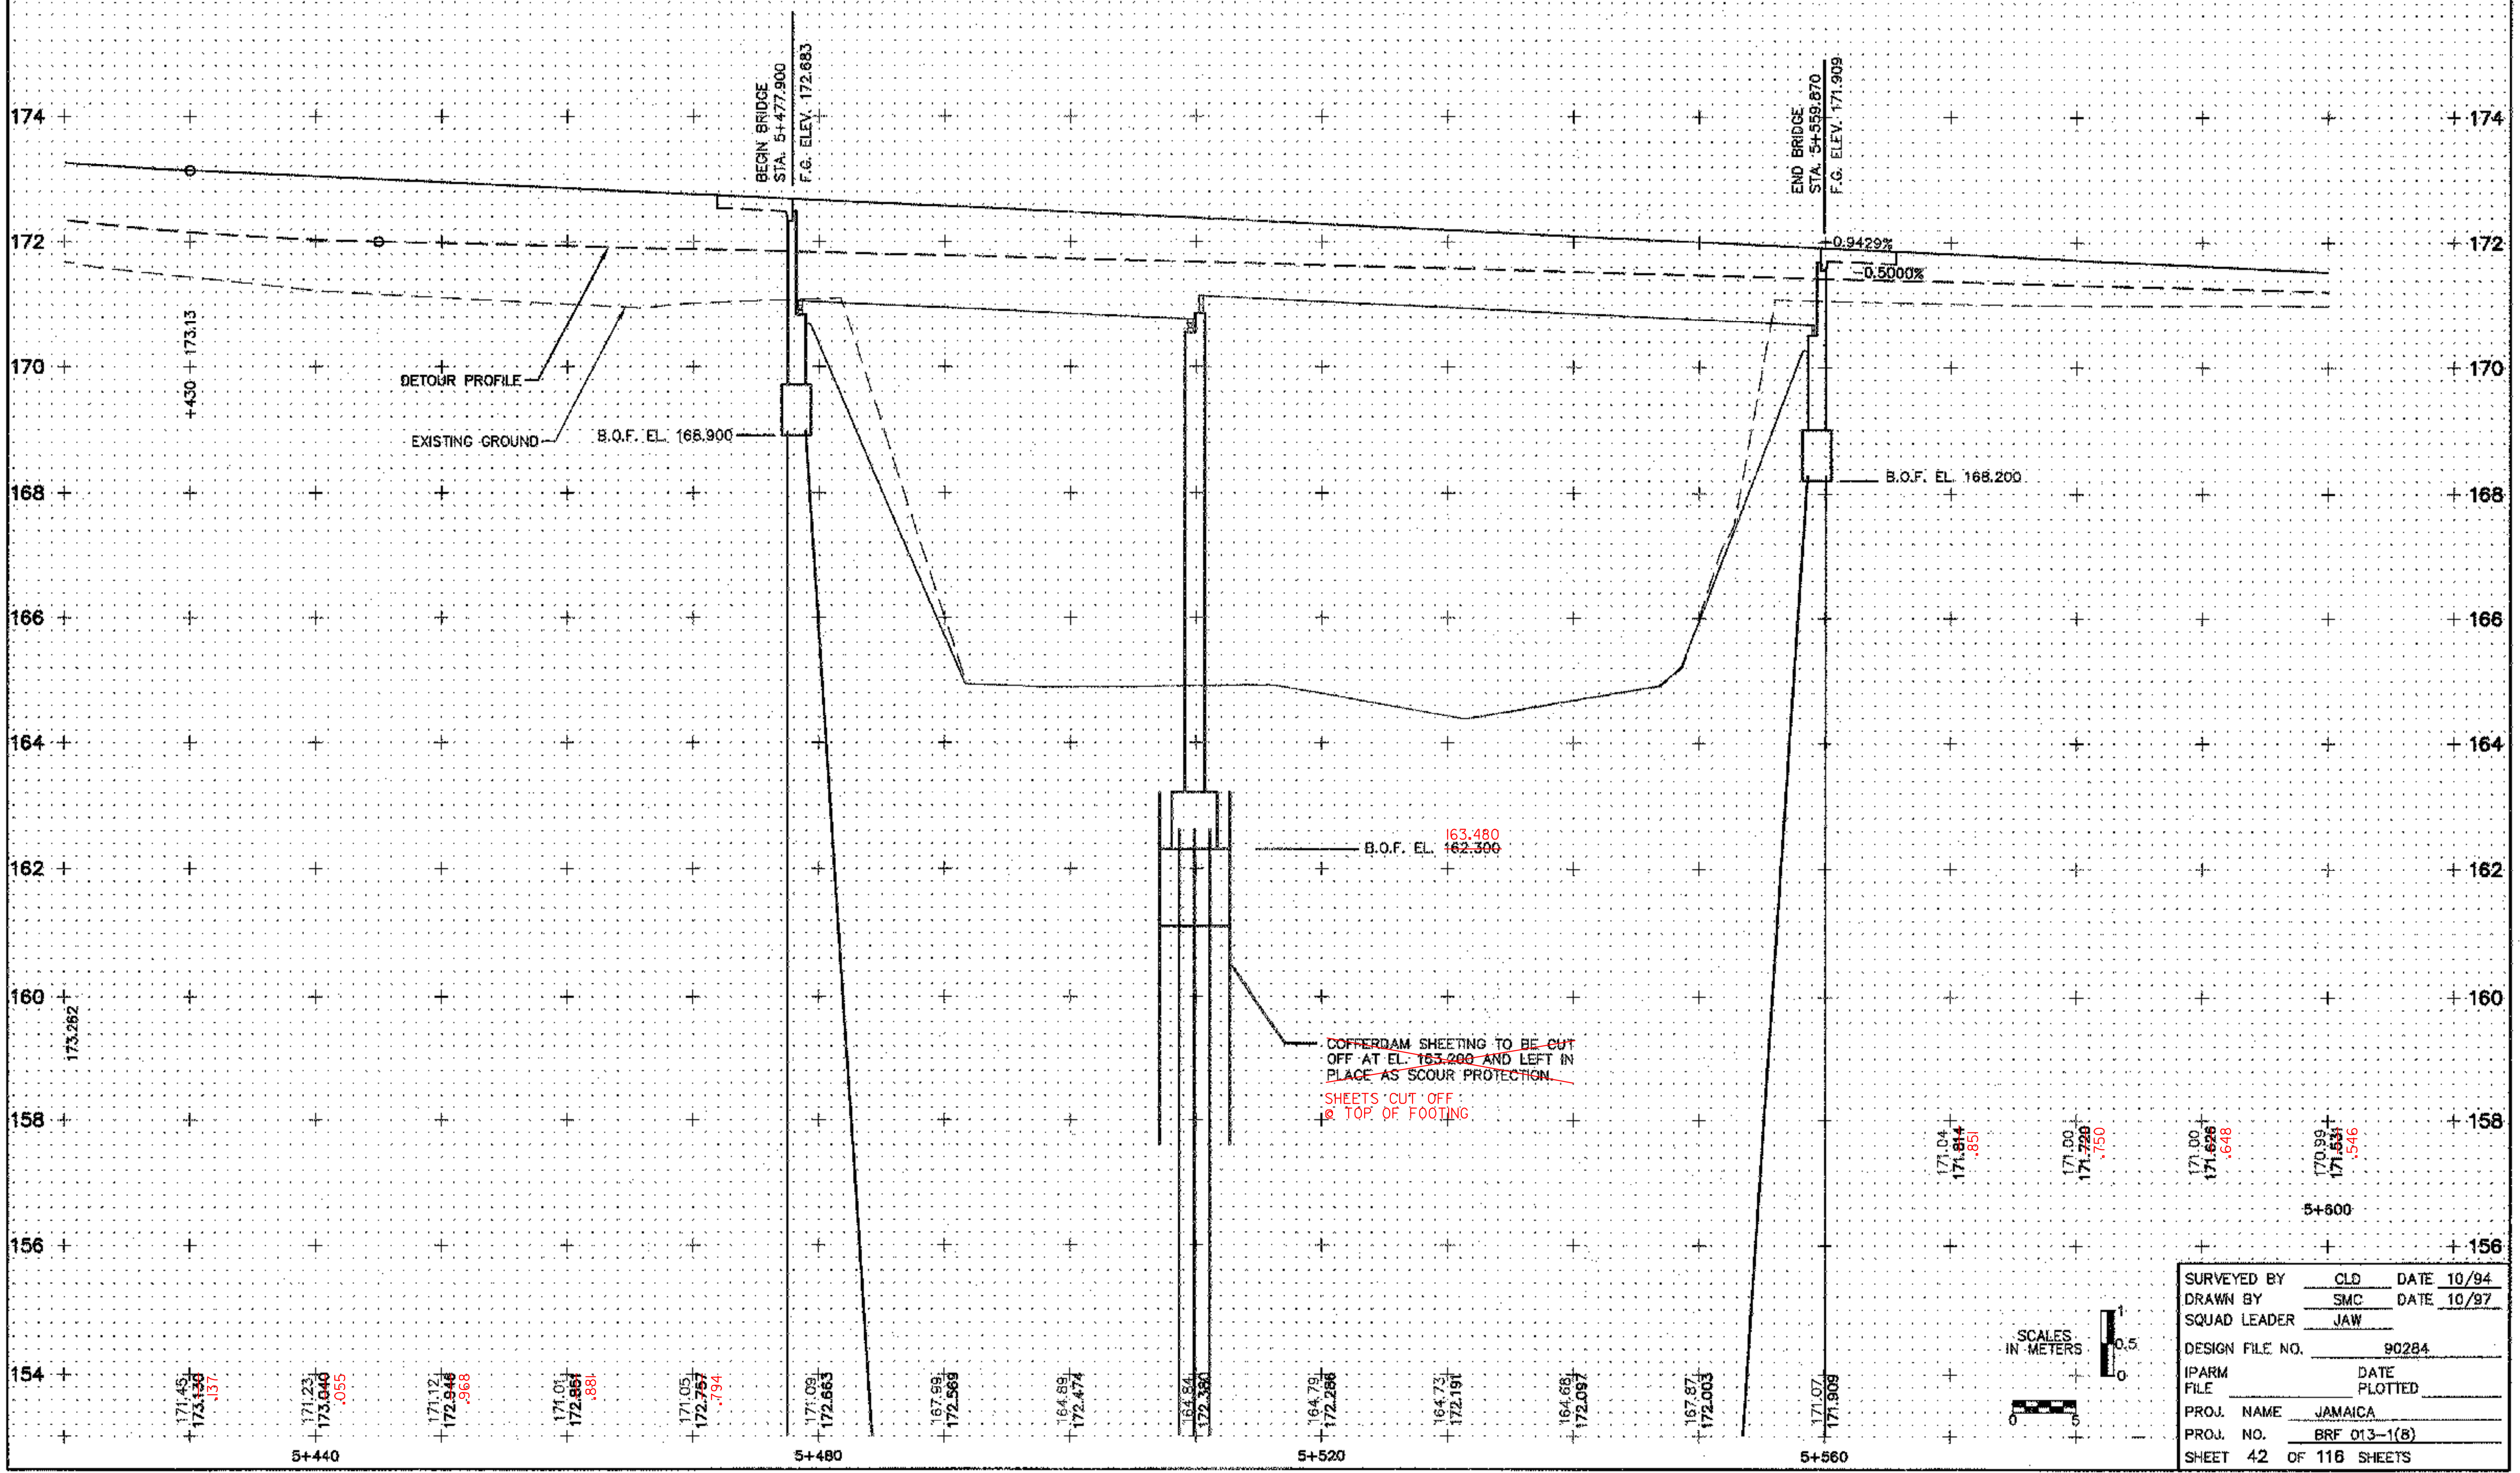

SURVEYED BY	CLD	DATE	10/94
DRAWN BY	SMC	DATE	10/97
SQUAD LEADER	JAW		
DESIGN FILE NO.	90284		
IPARM FILE	DATE PLOTTED		
PROJ. NAME	JAMAICA		
PROJ. NO.	BRF 013-1(8)		
SHEET	42	OF 116 SHEETS	