
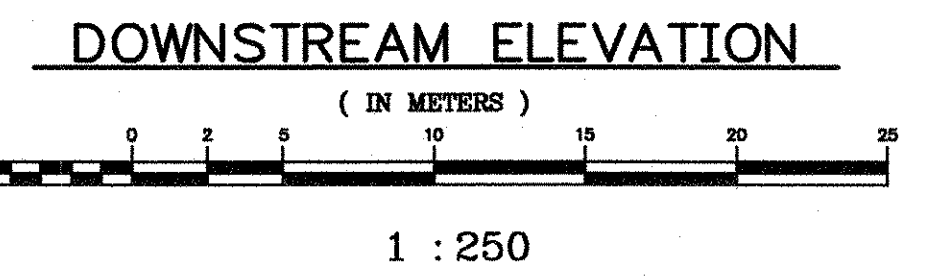


—LIMIT OF STONE FILL, TYPE IV

LOCATION	ENDPOST DIST. TO DECK END	APPROACH RAIL LENGTH	RADIUS
⊙ WW #1	1100	7620	10 000
⊙ WW #2	1100	7620	10 000
⊙ WW #3	1470*	7620	0
⊙ WW #4	1470*	7620	0

* END POST DISTANCE TO WW END

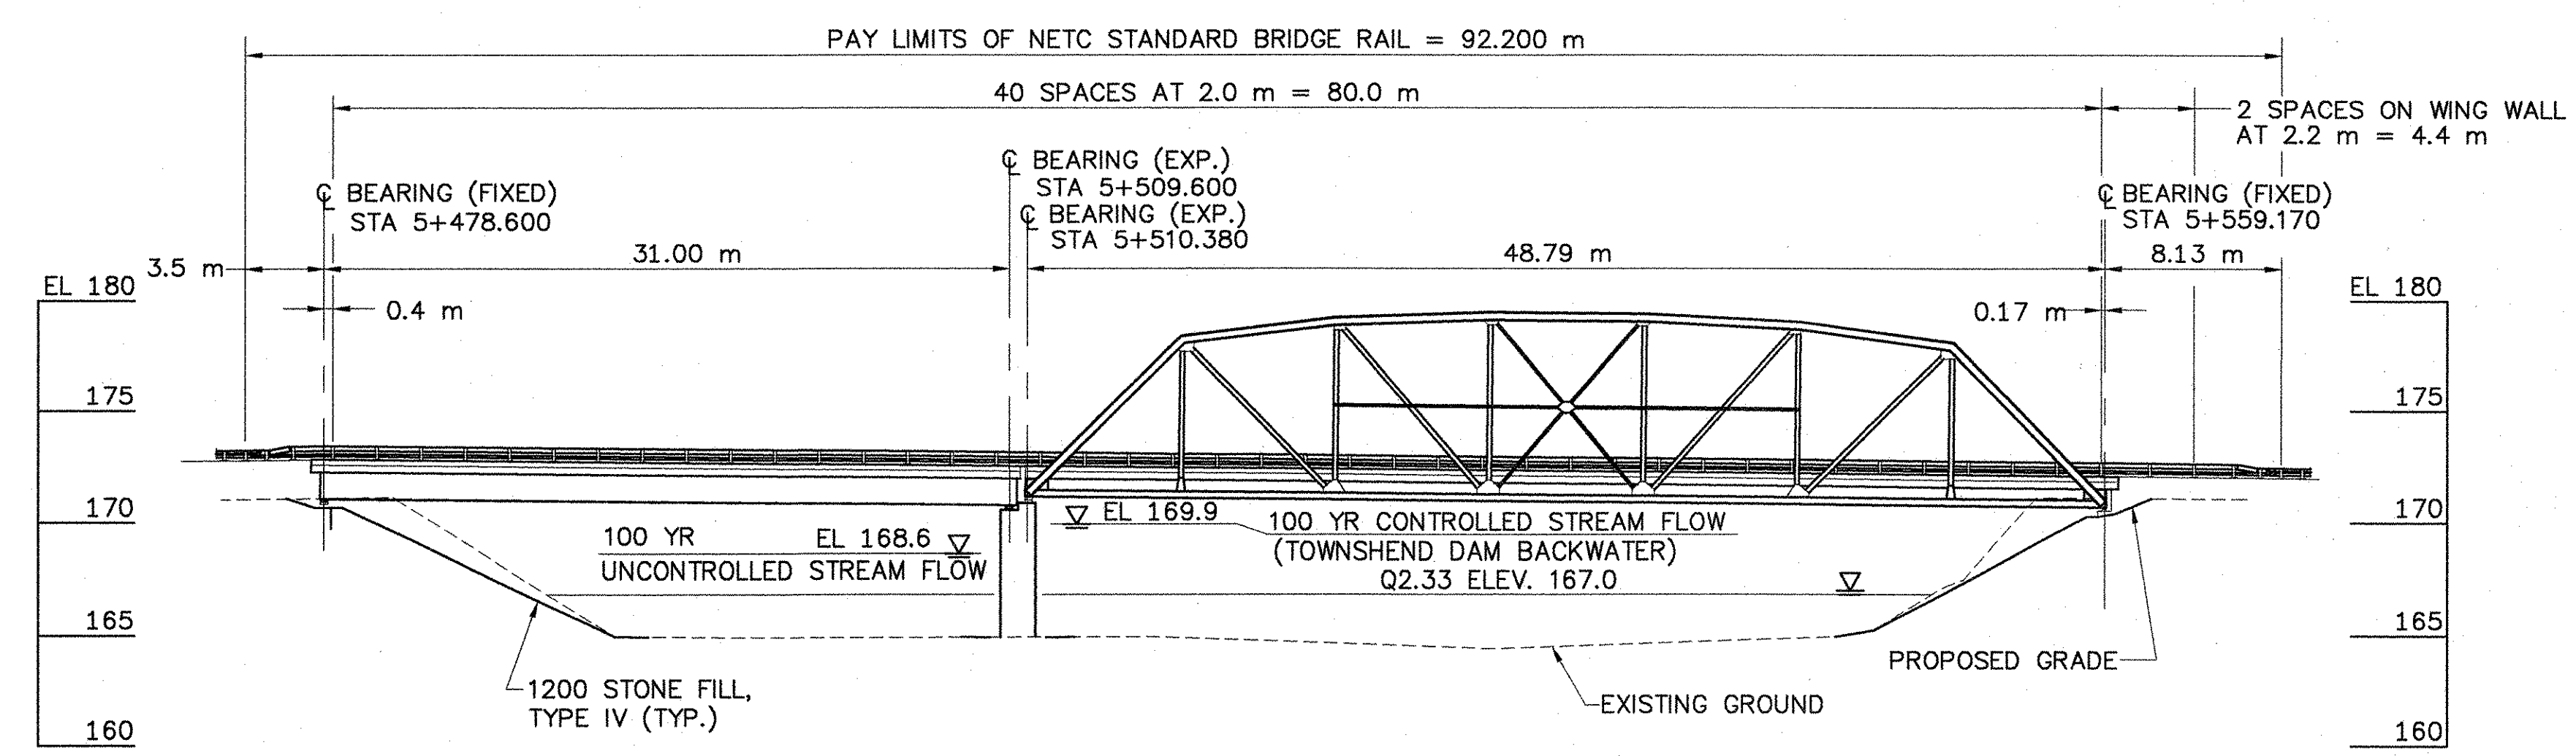

STATE OF VERMONT AGENCY OF TRANSPORTATION			
Town Of	JAMAICA	Bridge No.	80
Highway No.	VT. ROUTE 100	Log Sta.	
		Surv. Sta.	
VT. ROUTE 100 OVER THE WEST RIVER			
PLAN AND ELEVATION			
Designed By	LMM/LKP/JH	Drawn By	GFB
Checked By	Date	Bridge Design Supervisor	
LMM	2/02	LMM	Date 2/02
PROJECT	JAMAICA	PROJECT NO.	BRF 013-1(8)
I.G.C. Info.			
Bridge Sheet No.		Sheet	60 Of 116

540 Commercial St.
Manchester, NH 03101
PH: (603) 668-8223
FAX: (603) 668-8802
E-MAIL: CLD@CLDENGINEERS.COM