



FRAMING PLAN
SCALE 1:50

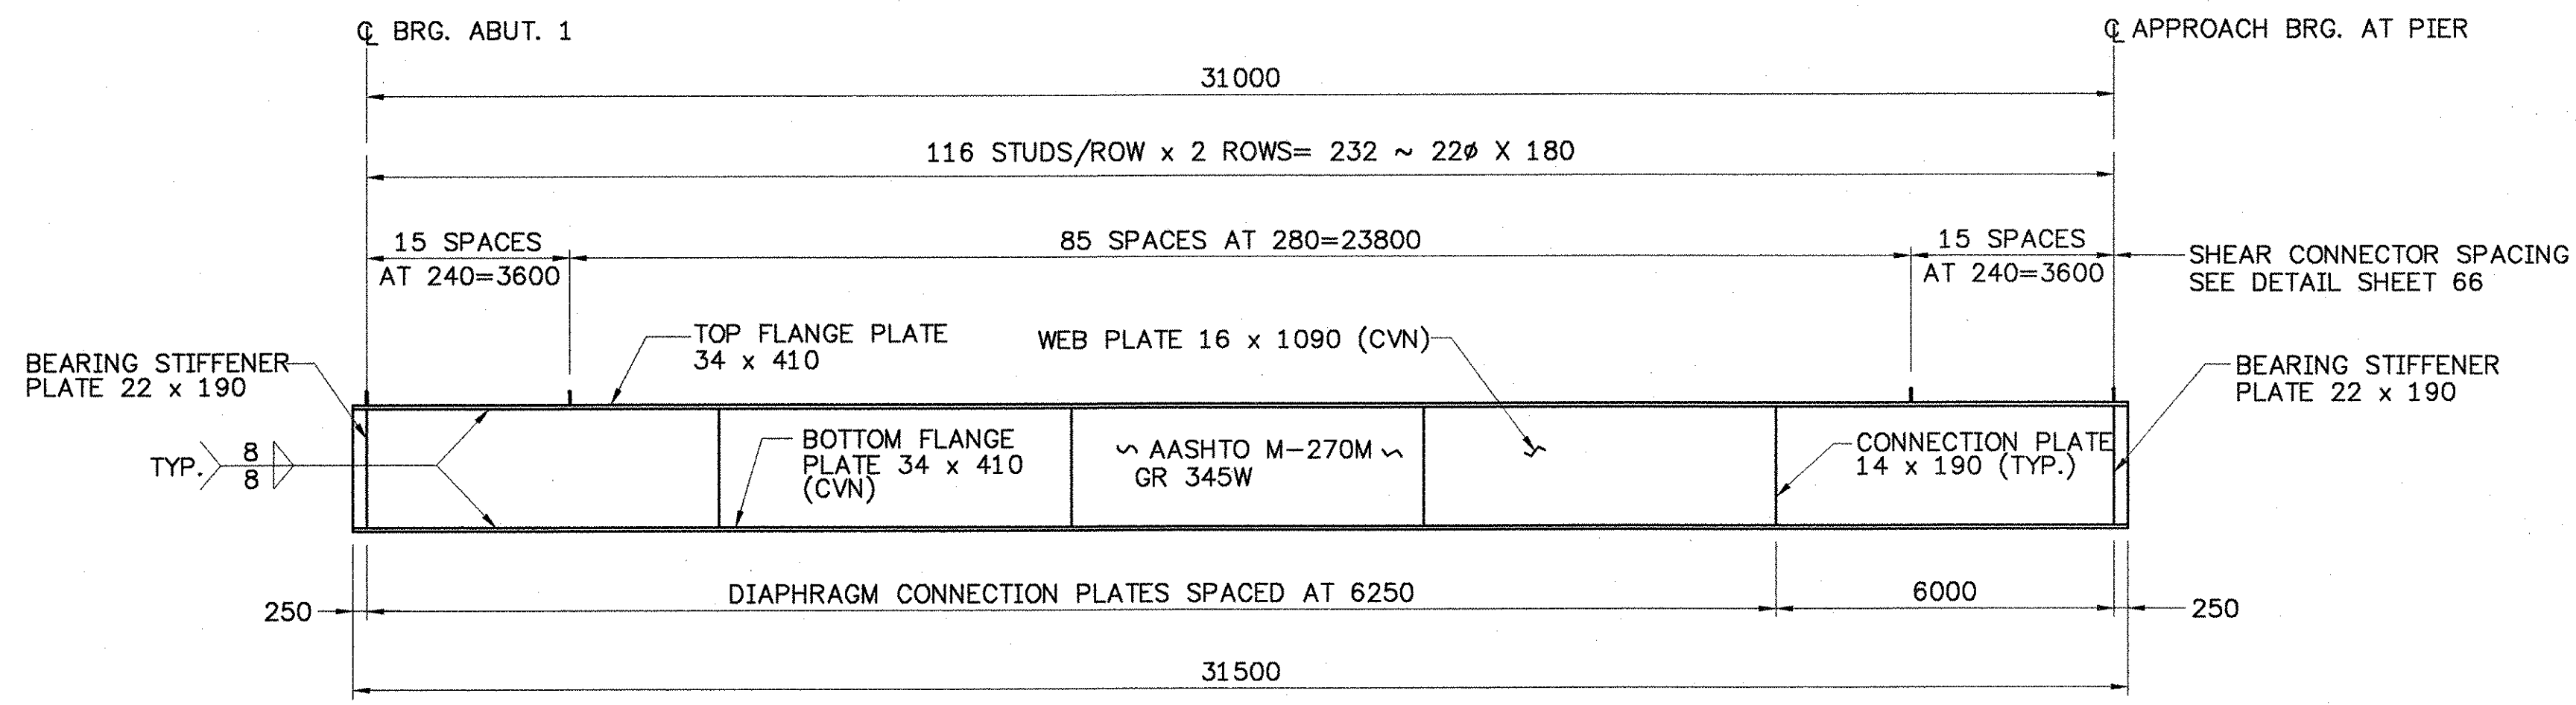

TYPICAL GIRDER ELEVATION


SCALE: HORIZONTAL 1:100
VERTICAL 1:50

NOTE: THE CHARPY V-NOTCH TEST SHALL BE REQUIRED FOR ALL PLATES LABELED WITH CVN. SEE SECTION 714.01 OF THE STANDARD SPECIFICATIONS.

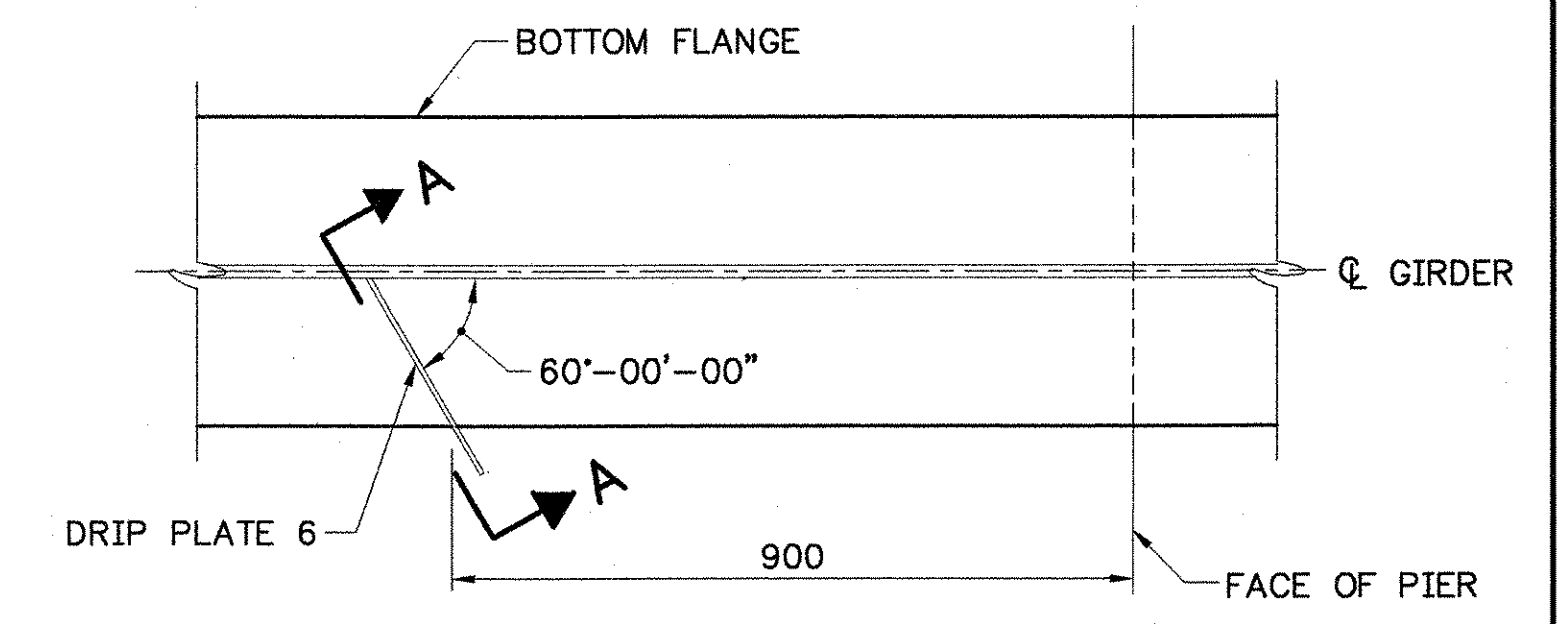

PLAN DRIP PLATE

SCALE 1:10

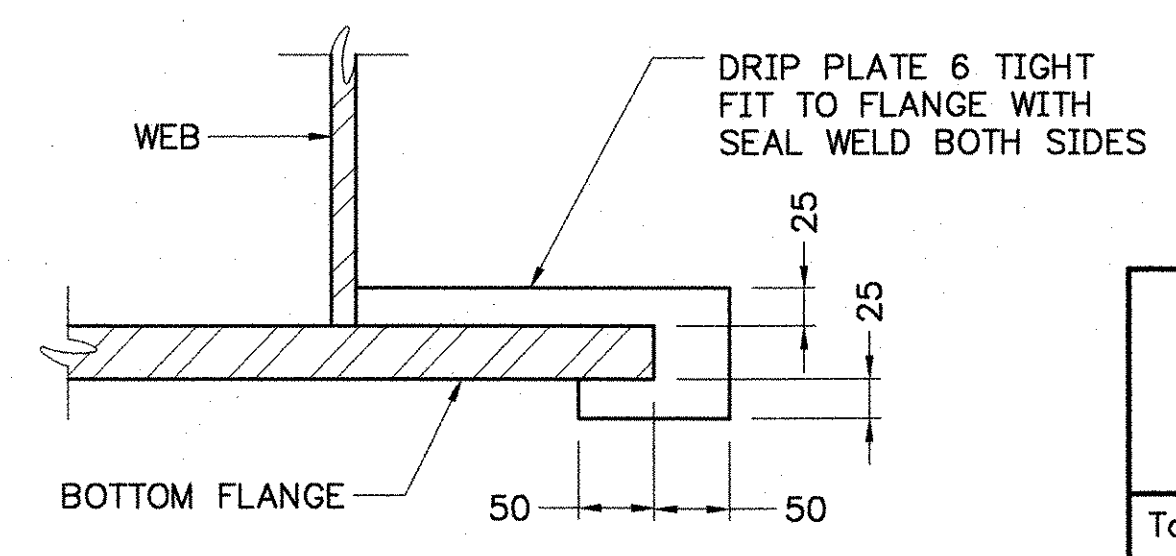

SECTION A-A

SCALE 1:5

STATE OF VERMONT AGENCY OF TRANSPORTATION			
Town Of	JAMAICA	Bridge No.	80
		Log Sta.	
Highway No.	VT. ROUTE 100	Surv. Sta.	
VT. ROUTE 100 OVER THE WEST RIVER FRAMING PLAN AND GIRDER ELEVATION			
Designed By	JH	Drawn By.	MWS
Checked By	RMR	Bridge Design Supervisor	LMM
	Date 2/02	Date	2/02
PROJECT	JAMAICA	PROJECT NO.	BRF 013-1(8)
I.G.C. Info.			
Bridge Sheet No.	Sheet 63 Of 116		