



**M2 PANEL POINT  
CONNECTION DETAIL**

SCALE 1:5

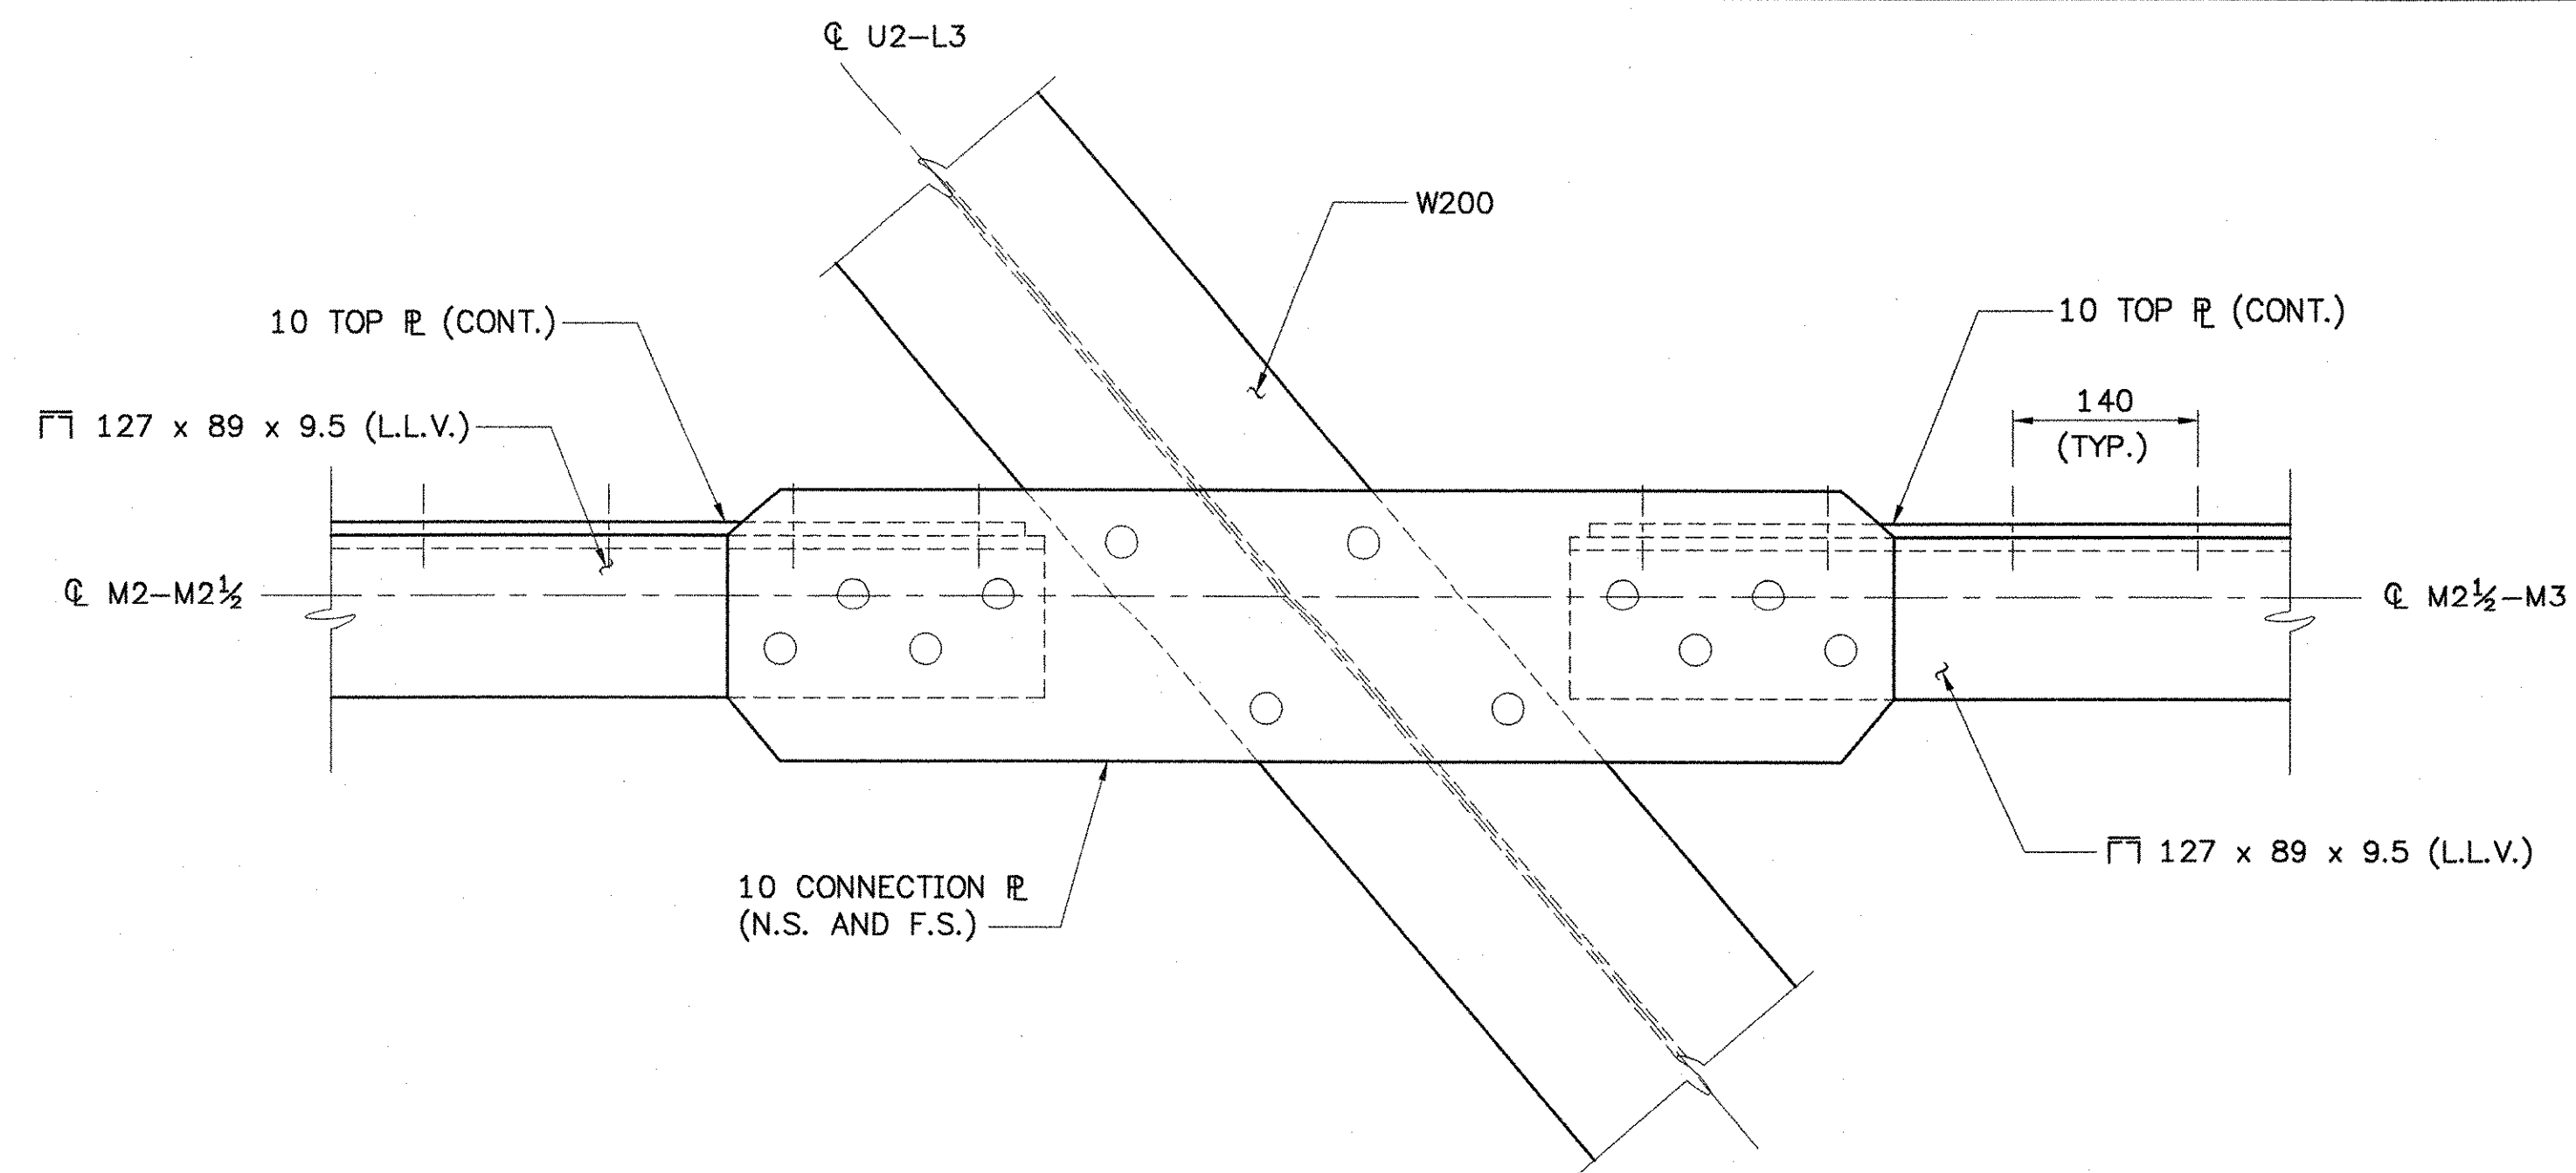


**M2.5 PANEL POINT  
CONNECTION DETAIL**

SCALE 1:5

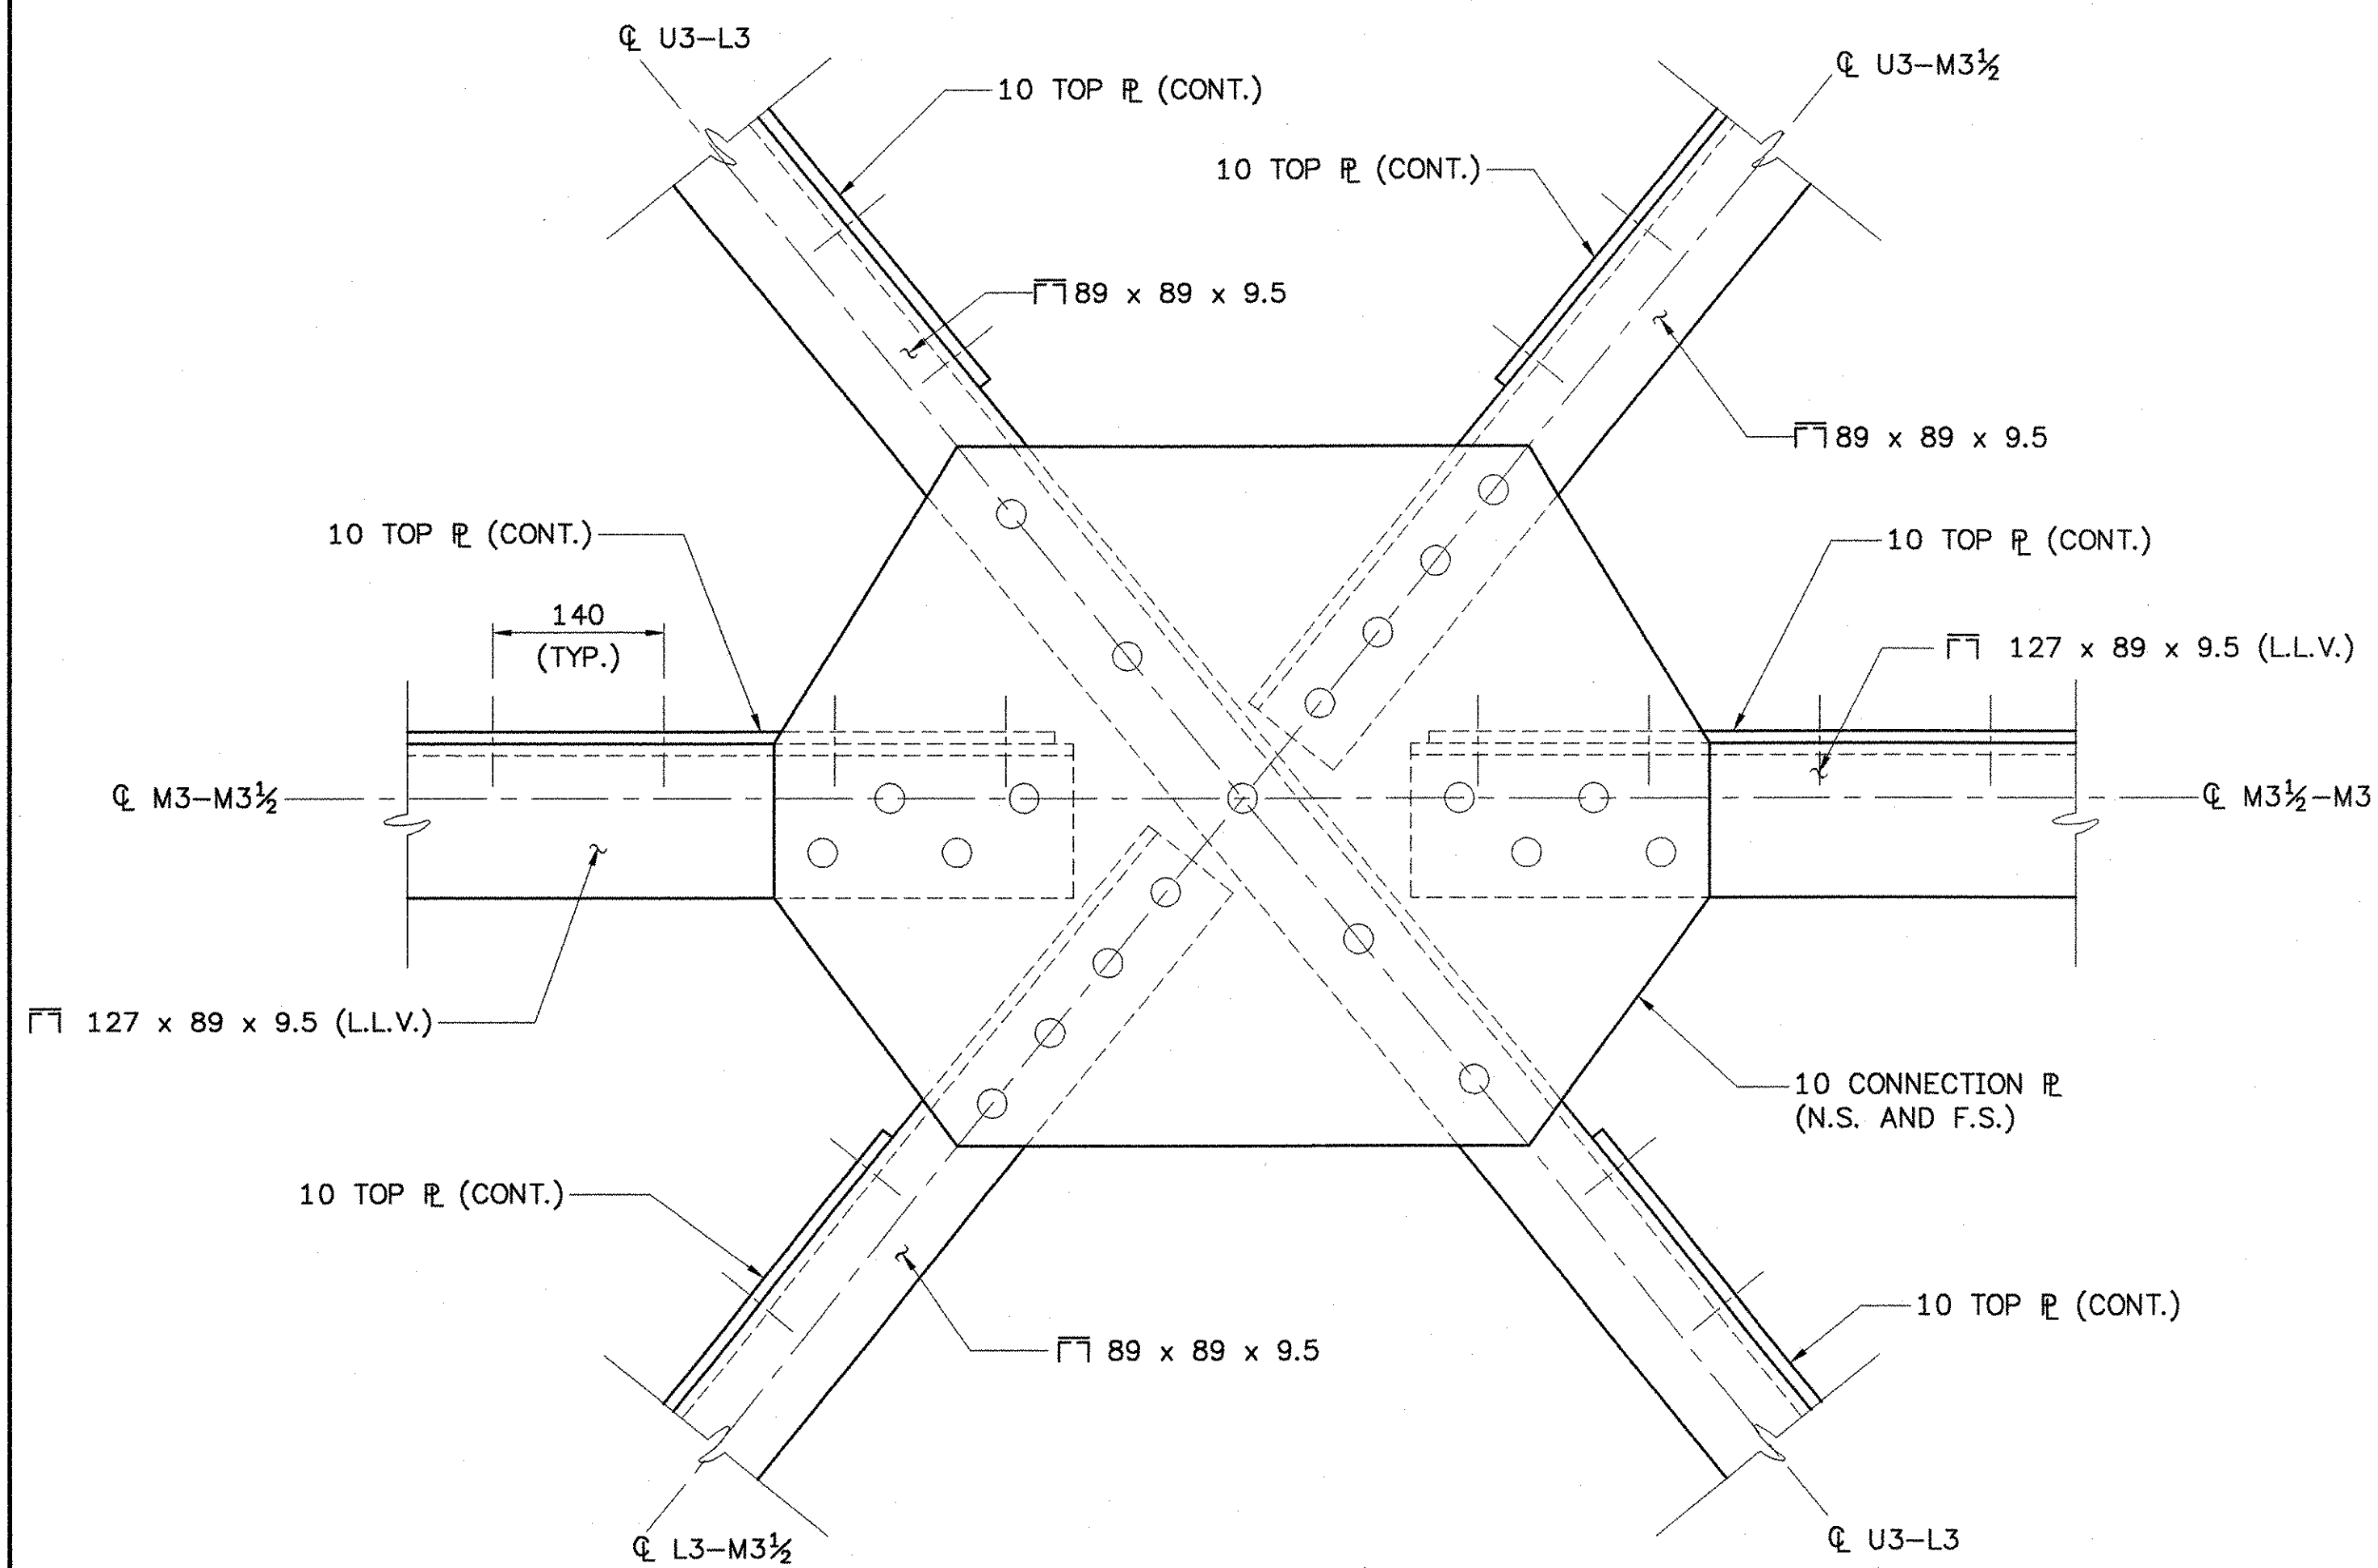

**M3.5 PANEL POINT  
CONNECTION DETAIL**

SCALE 1:5

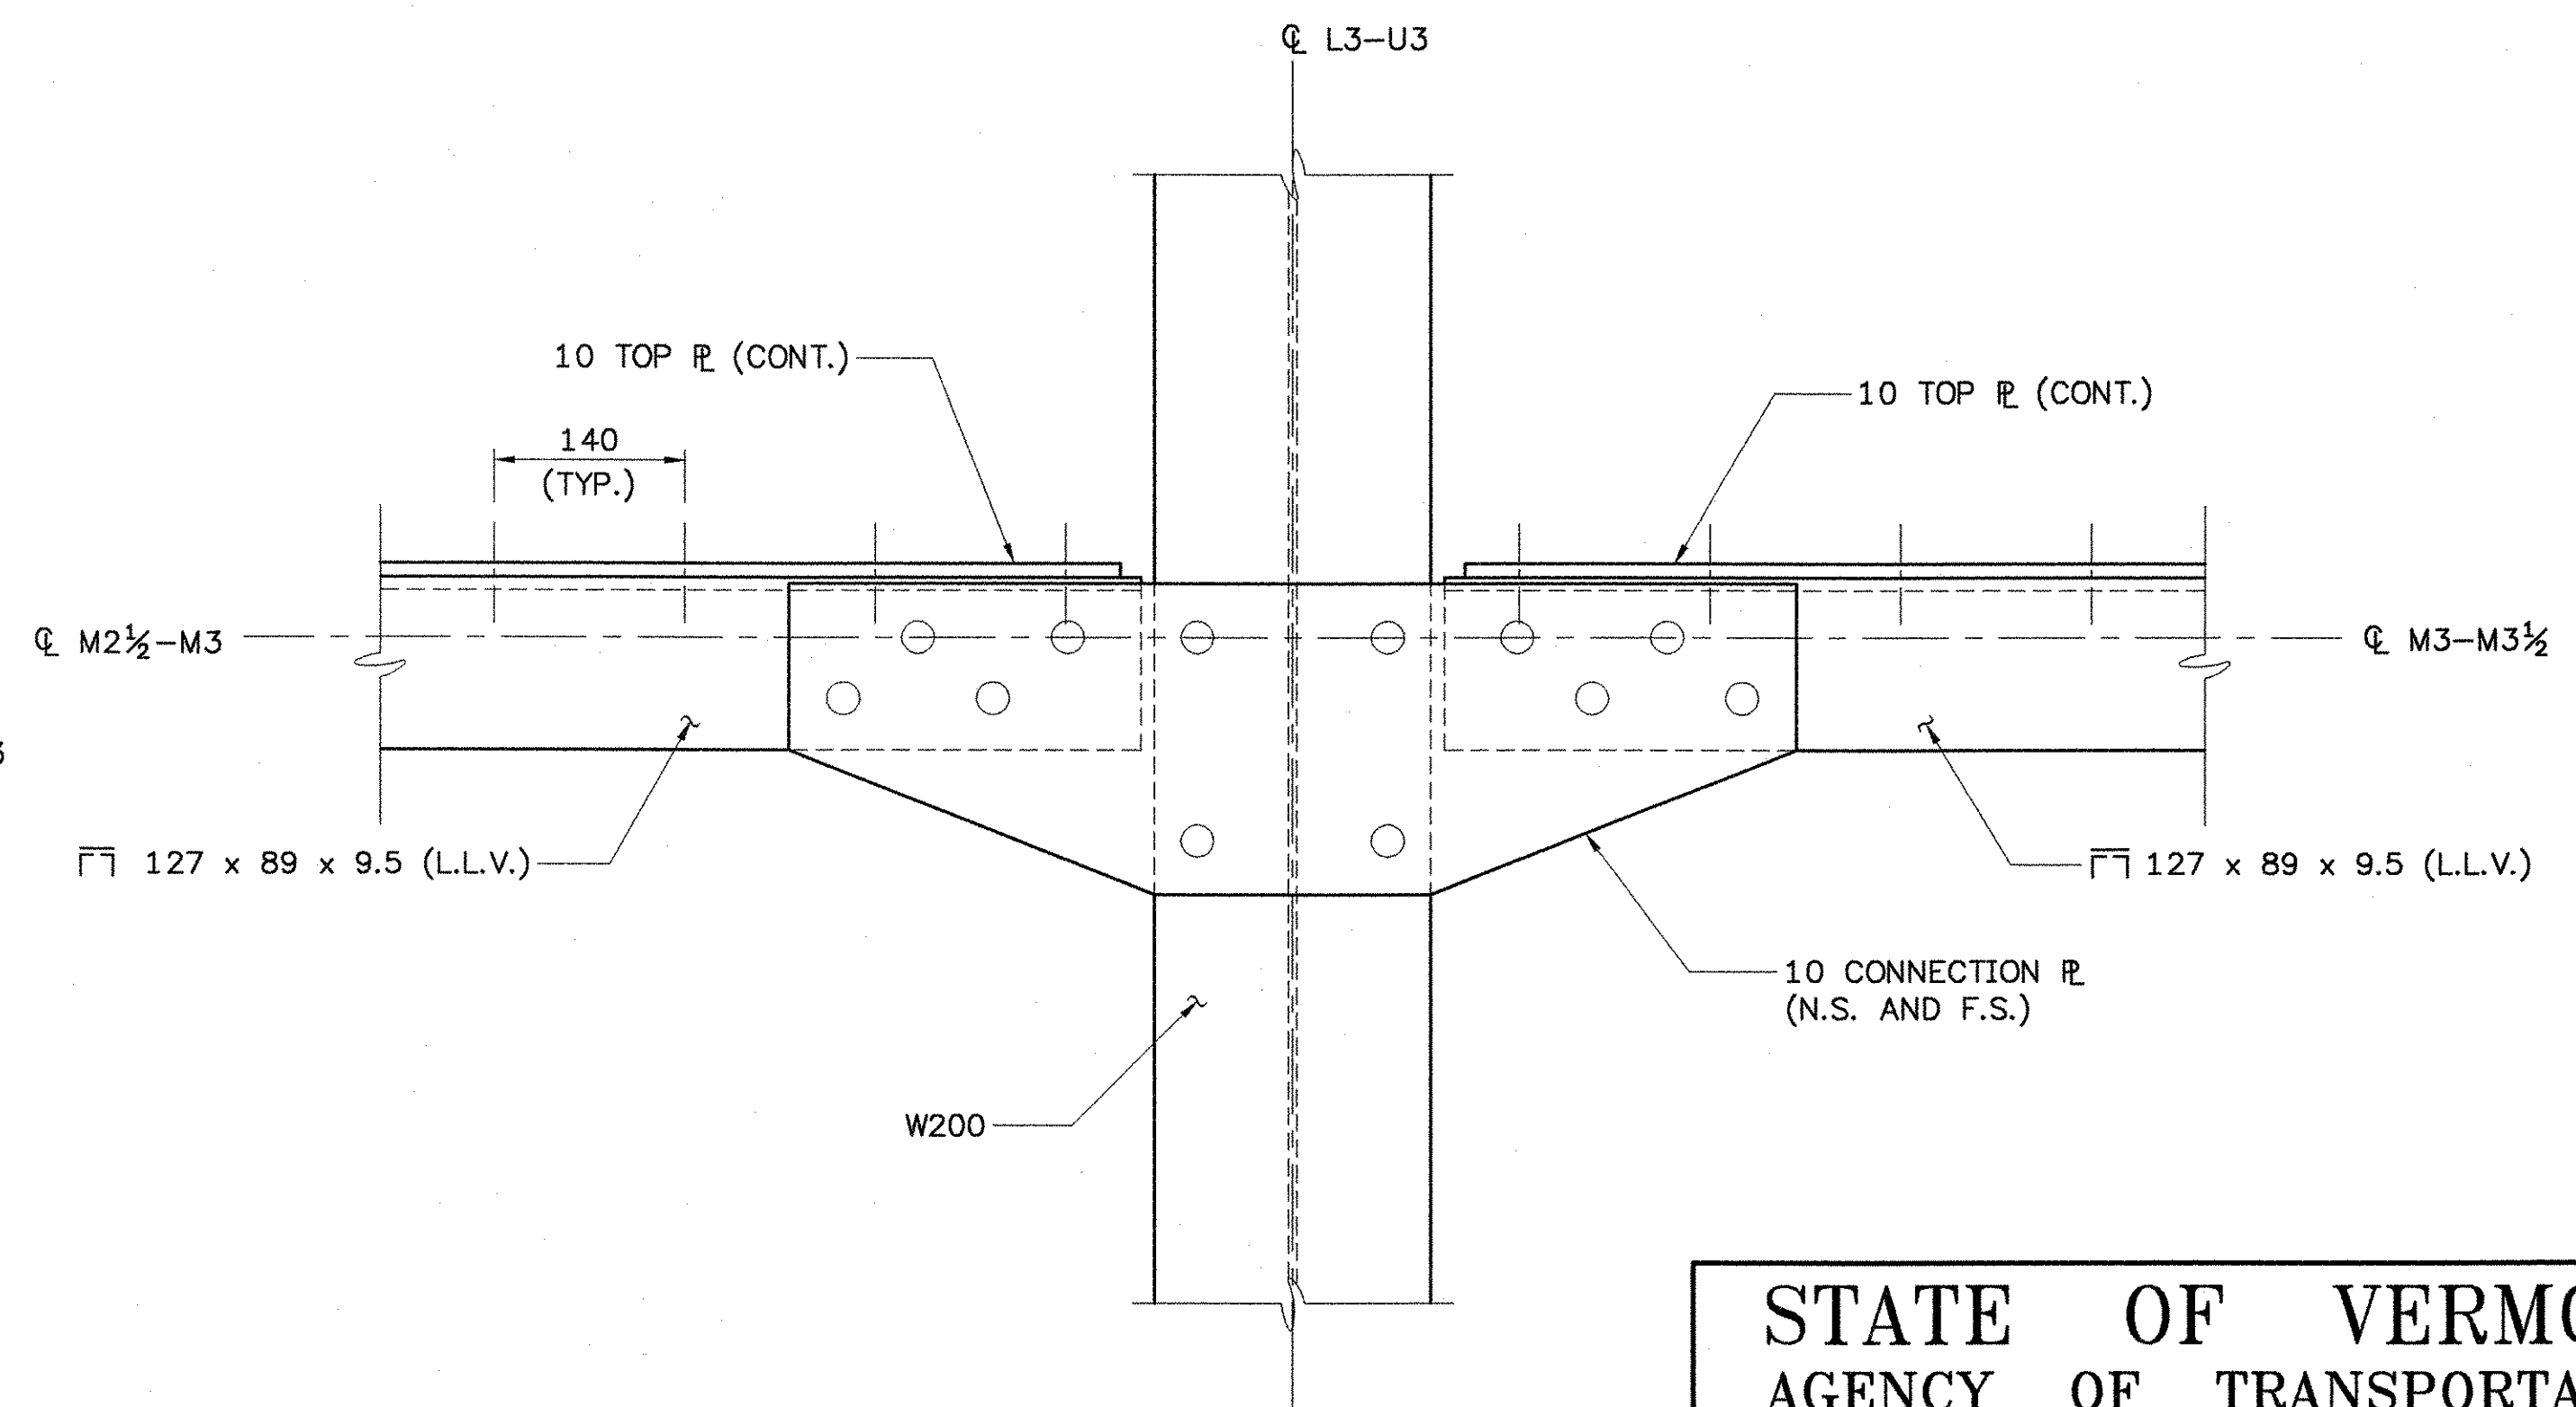


**M3 PANEL POINT  
CONNECTION DETAIL**

SCALE 1:5

**NOTE**

- N.S. = NEAR SIDE
- F.S. = FAR SIDE
- L.L.V. = LONG LEG VERTICAL
- L.L.H. = LONG LEG HORIZONTAL

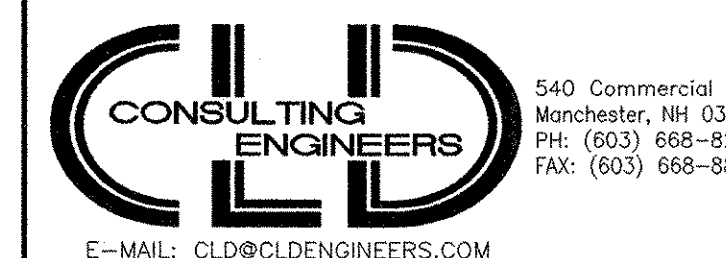

**STATE OF VERMONT  
AGENCY OF TRANSPORTATION**

Town Of	JAMAICA	Bridge No.	80
Highway No.	VT. ROUTE 100	Log Sta.	
VT. ROUTE 100 OVER THE WEST RIVER		Surv. Sta.	
TRUSS DETAILS (3 OF 4)			
Designed By	LKP	Drawn By	MWS
Checked By	Date	Bridge Design Supervisor	Date
LMM	2/02	LMM	2/02
PROJECT	JAMAICA	PROJECT NO.	BRF 013-1(8)
I.G.C. Info.			
Bridge Sheet No.	Sheet 72 Of 116		