



ABUTMENT NO. 1 PLAN (FIXED)
SCALE 1:40

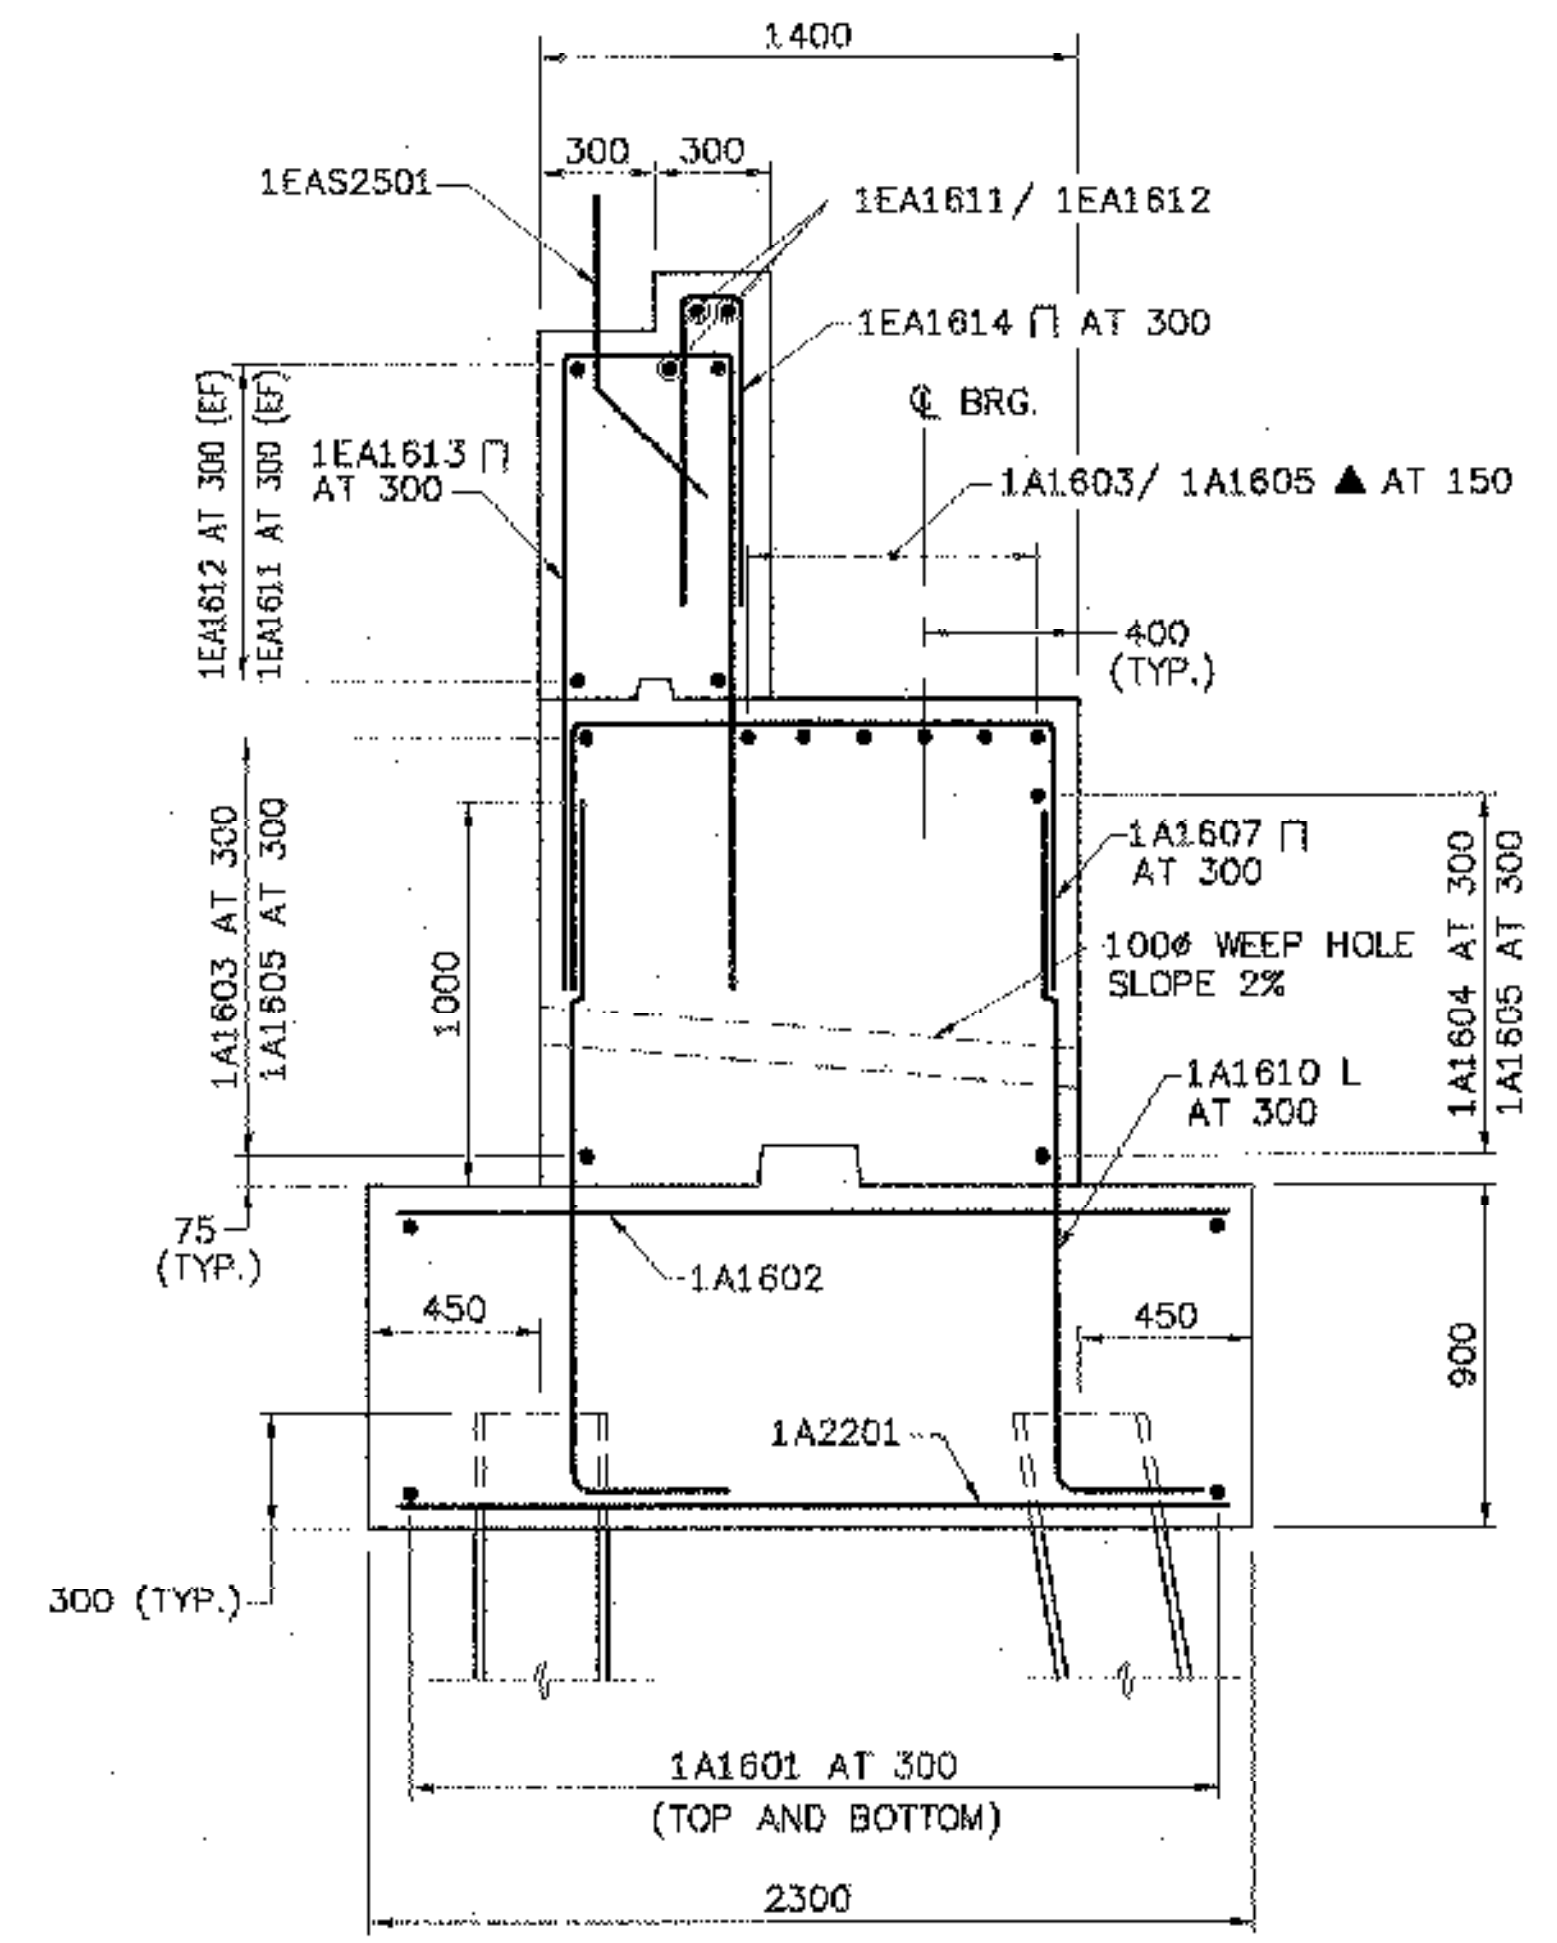

TYPICAL ABUTMENT NO. 1 SECTION (FIXED)
SCALE 1:20

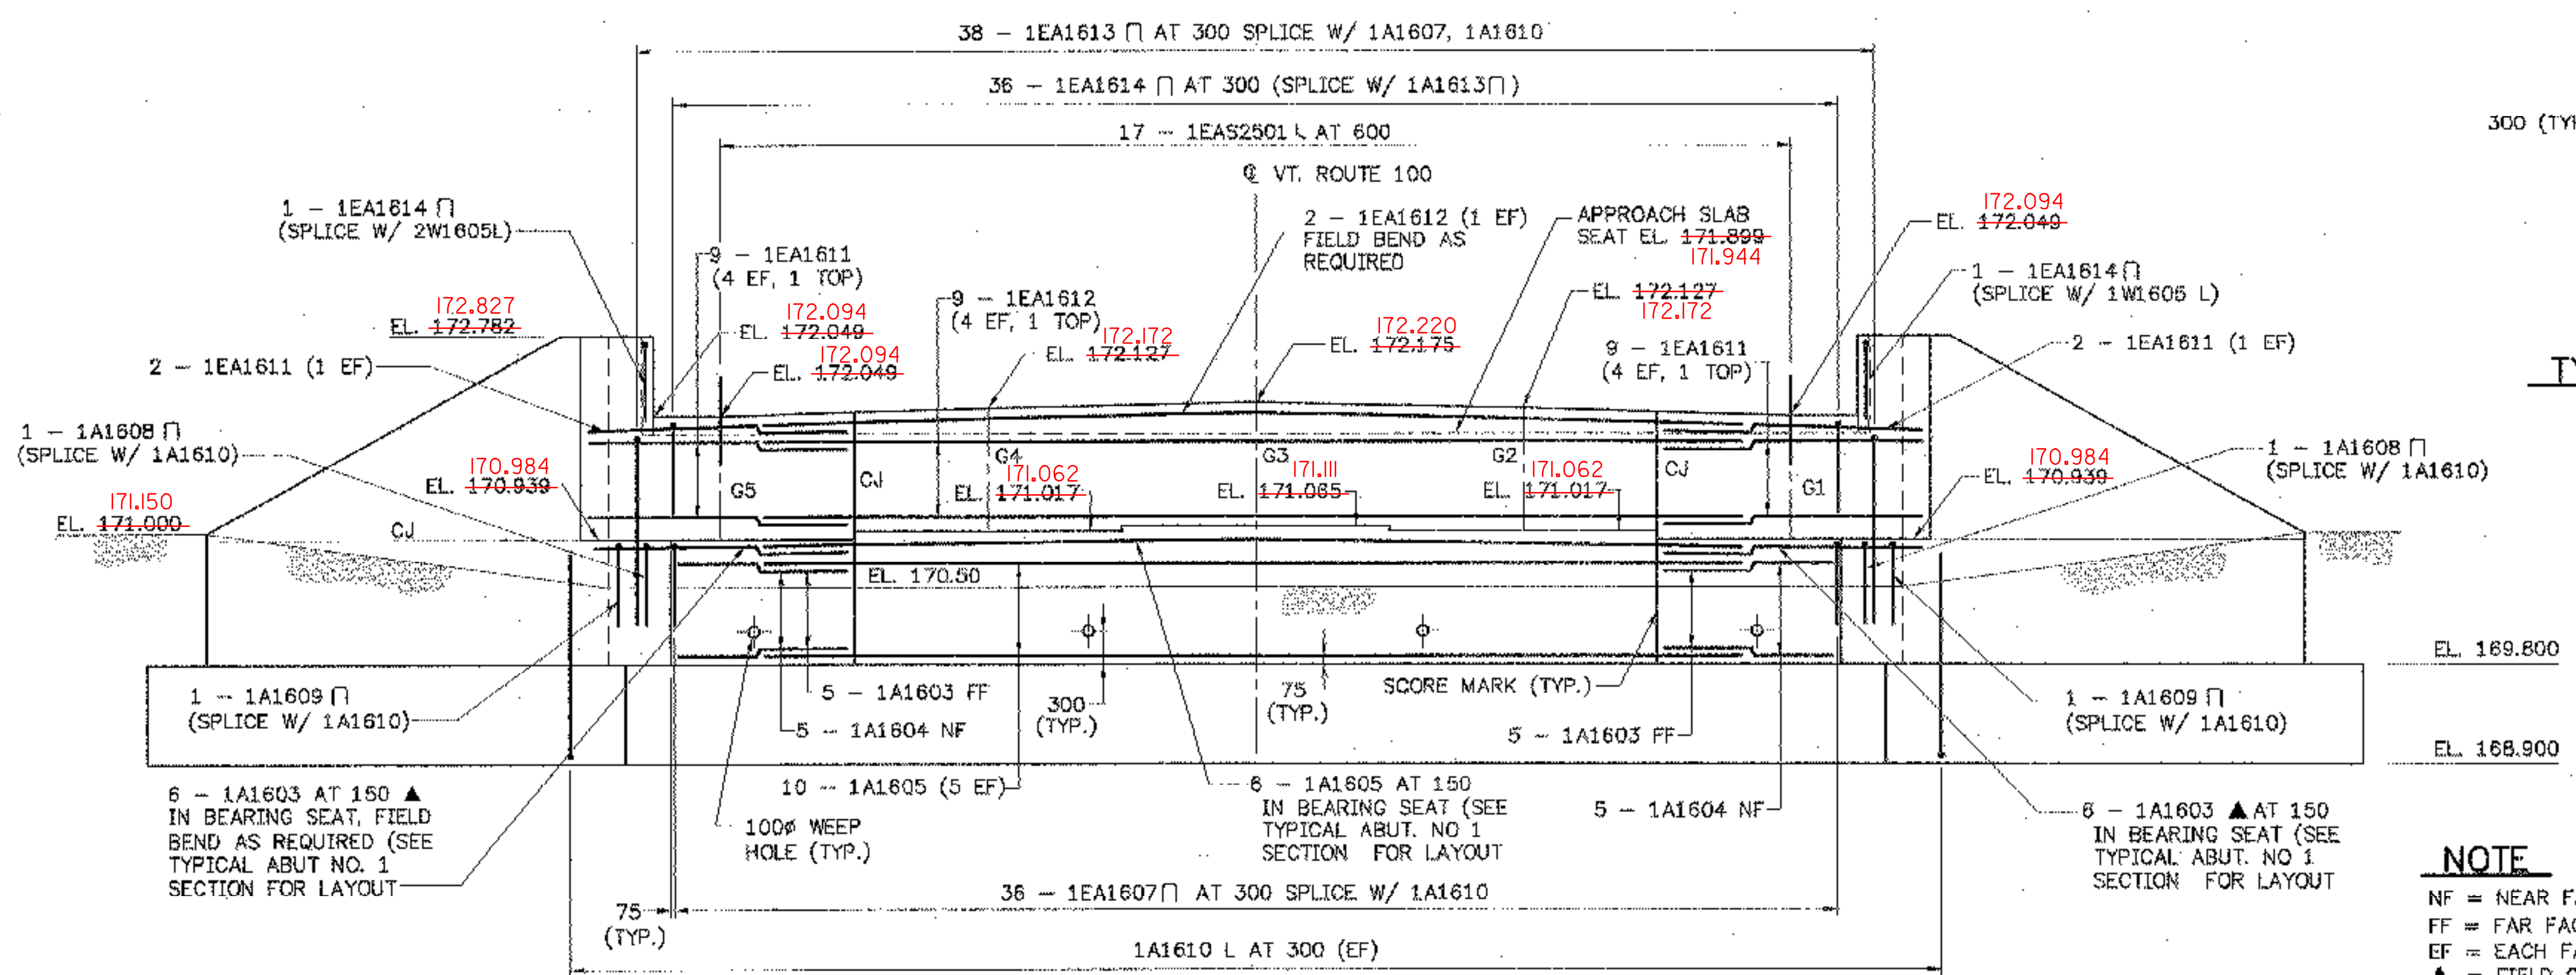

ABUTMENT NO. 1 ELEVATION (FIXED)
SCALE 1:40

NOTE
 NF = NEAR FACE
 FF = FAR FACE
 EF = EACH FACE
 ▲ = FIELD CUT

STATE OF VERMONT		AGENCY OF TRANSPORTATION	
Town Of	JAMAICA	Bridge No.	80
Highway No.	VT. ROUTE 100	Lag Sta.	
VT. ROUTE 100 OVER THE WEST RIVER		Surv. Sta.	
ABUTMENT NO. 1 DETAILS			
Designed By	JH	Drawn By	MWS
Checked By	Date	Bridge Design Supervisor	Date
LMM	2/02	LMM	2/02
PROJECT	JAMAICA	PROJECT NO.	BRF 013-1(B)
I.C.C. Info.			
Bridge Sheet No.			Sheet 86 Of 116



90254-ABUT-1.dwg