



TYPICAL SECTION-WINGWALL NO.2

SCALE 1:20

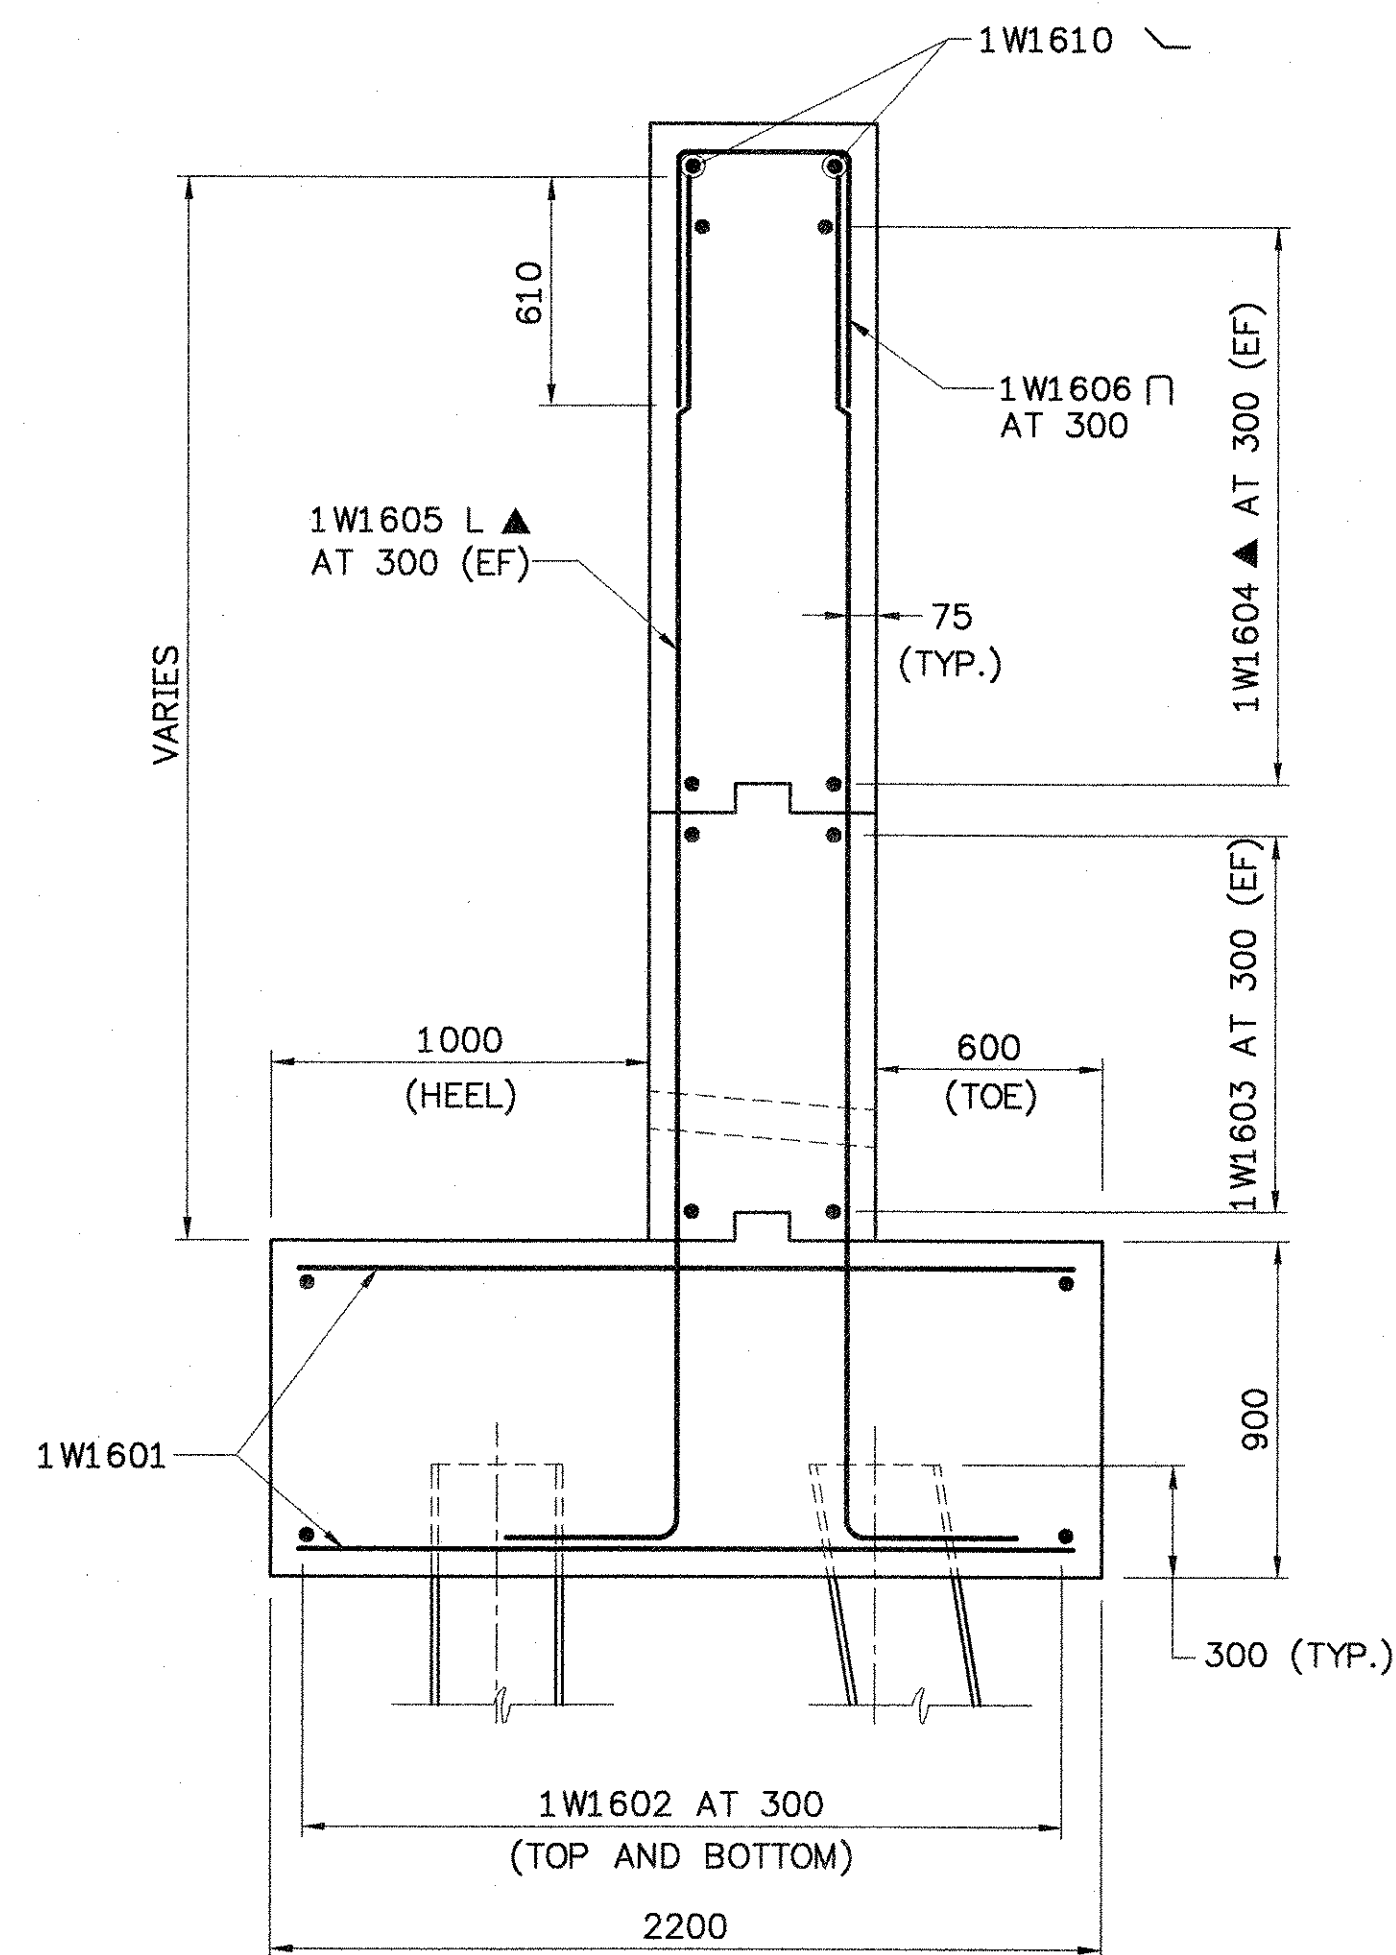


TYPICAL SECTION-WINGWALL NO.1

SCALE 1:20

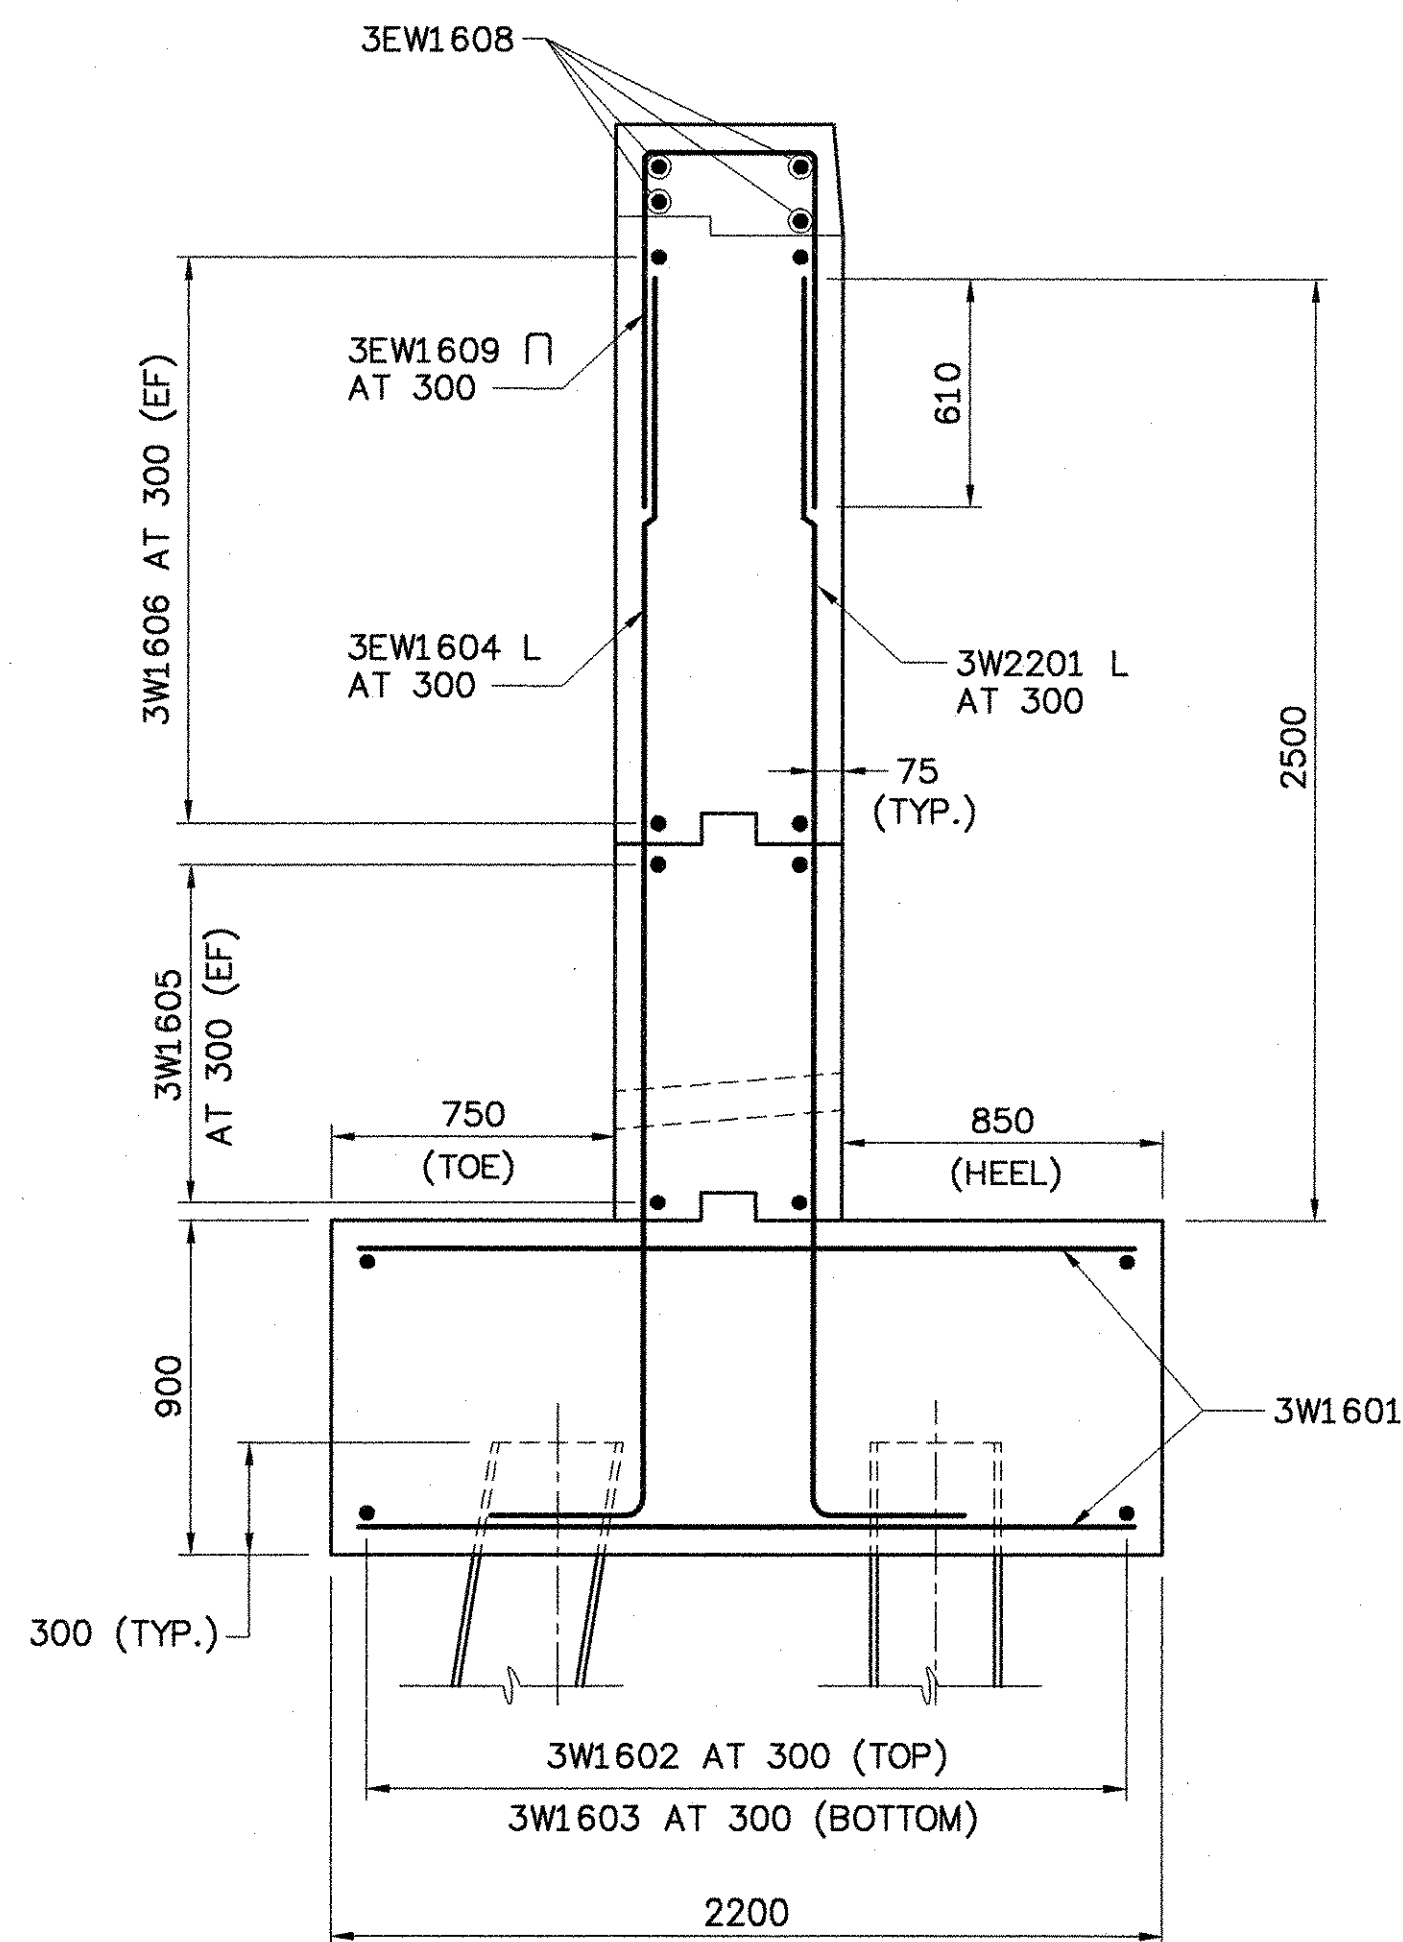

TYPICAL SECTION-WINGWALL NO.3

SCALE 1:20

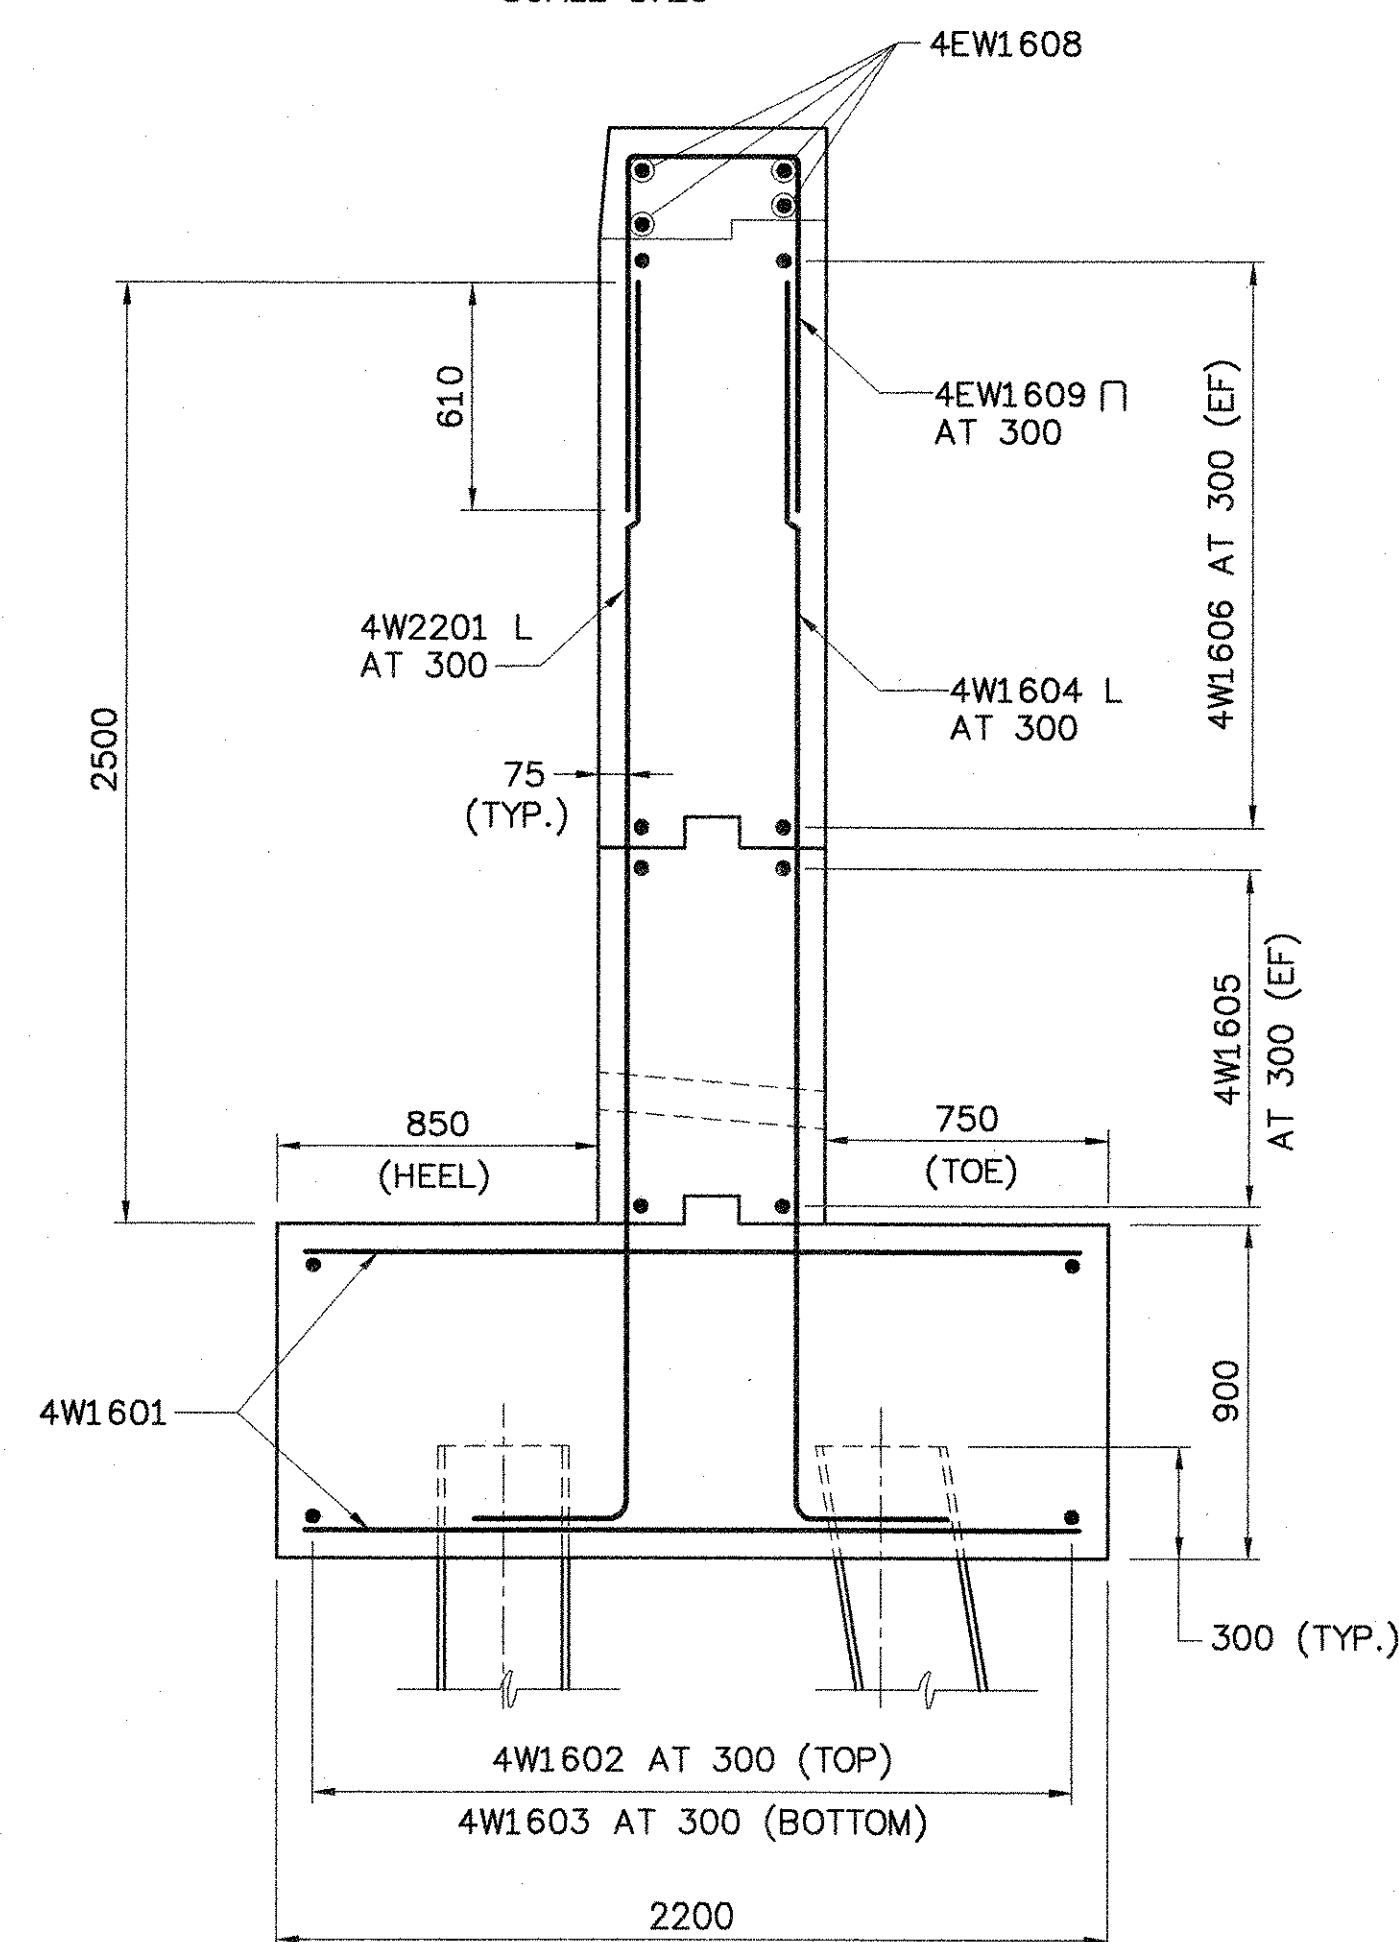

TYPICAL SECTION-WINGWALL NO.4

SCALE 1:20

**NOTE**

NF = NEAR FACE  
 FF = FAR FACE  
 EF = EACH FACE  
 ▲ = FIELD CUT

**STATE OF VERMONT  
 AGENCY OF TRANSPORTATION**

Town Of	JAMAICA	Bridge No.	80
Highway No.	VT. ROUTE 100	Log Sta.	
VT. ROUTE 100 OVER THE WEST RIVER		Surv. Sta.	
WINGWALL SECTIONS			
Designed By	JH	Drawn By.	MWS
Checked By	Date	Bridge Design Supervisor	
LMM	2/02	LMM	Date 2/02
PROJECT	JAMAICA	PROJECT NO.	BRF 013_1(8)
I.G.C. Info.			
Bridge Sheet No.		Sheet	88 Of 116



540 Commercial St.  
 Manchester, NH 03101  
 PH: (603) 668-8223  
 FAX: (603) 668-8802

E-MAIL: CLD@CLDENGINEERS.COM