
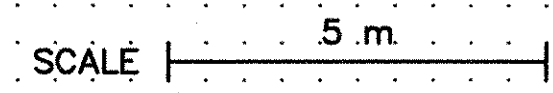
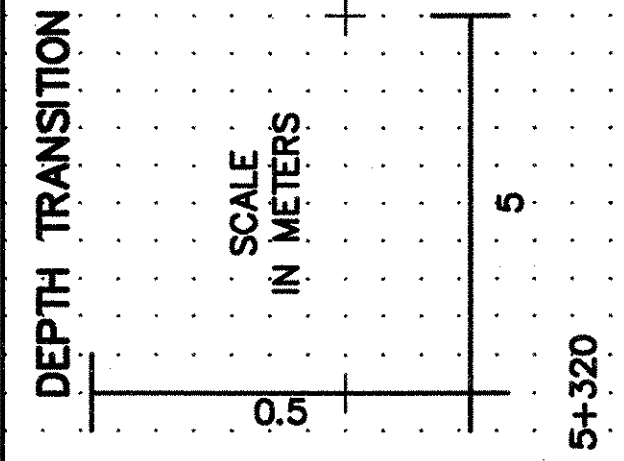
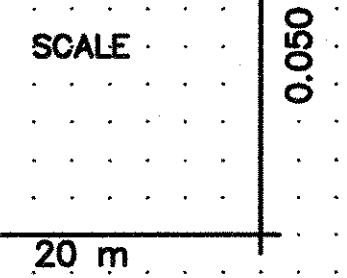


DATE	
BY	
ORIGINAL SURVEY NO.	
REVISED SURVEY NO.	
DATE	
BY	
NOTED	
DATE	
BY	
NO.	
CHECKED	
DATE	
BY	

DATE	
BY	
ORIGINAL SURVEY NO.	
REVISED SURVEY NO.	
DATE	
BY	
NOTED	
DATE	
BY	
NO.	
CHECKED	
DATE	
BY	

CVPS # 7/9
+349 NET #9 W/TELE

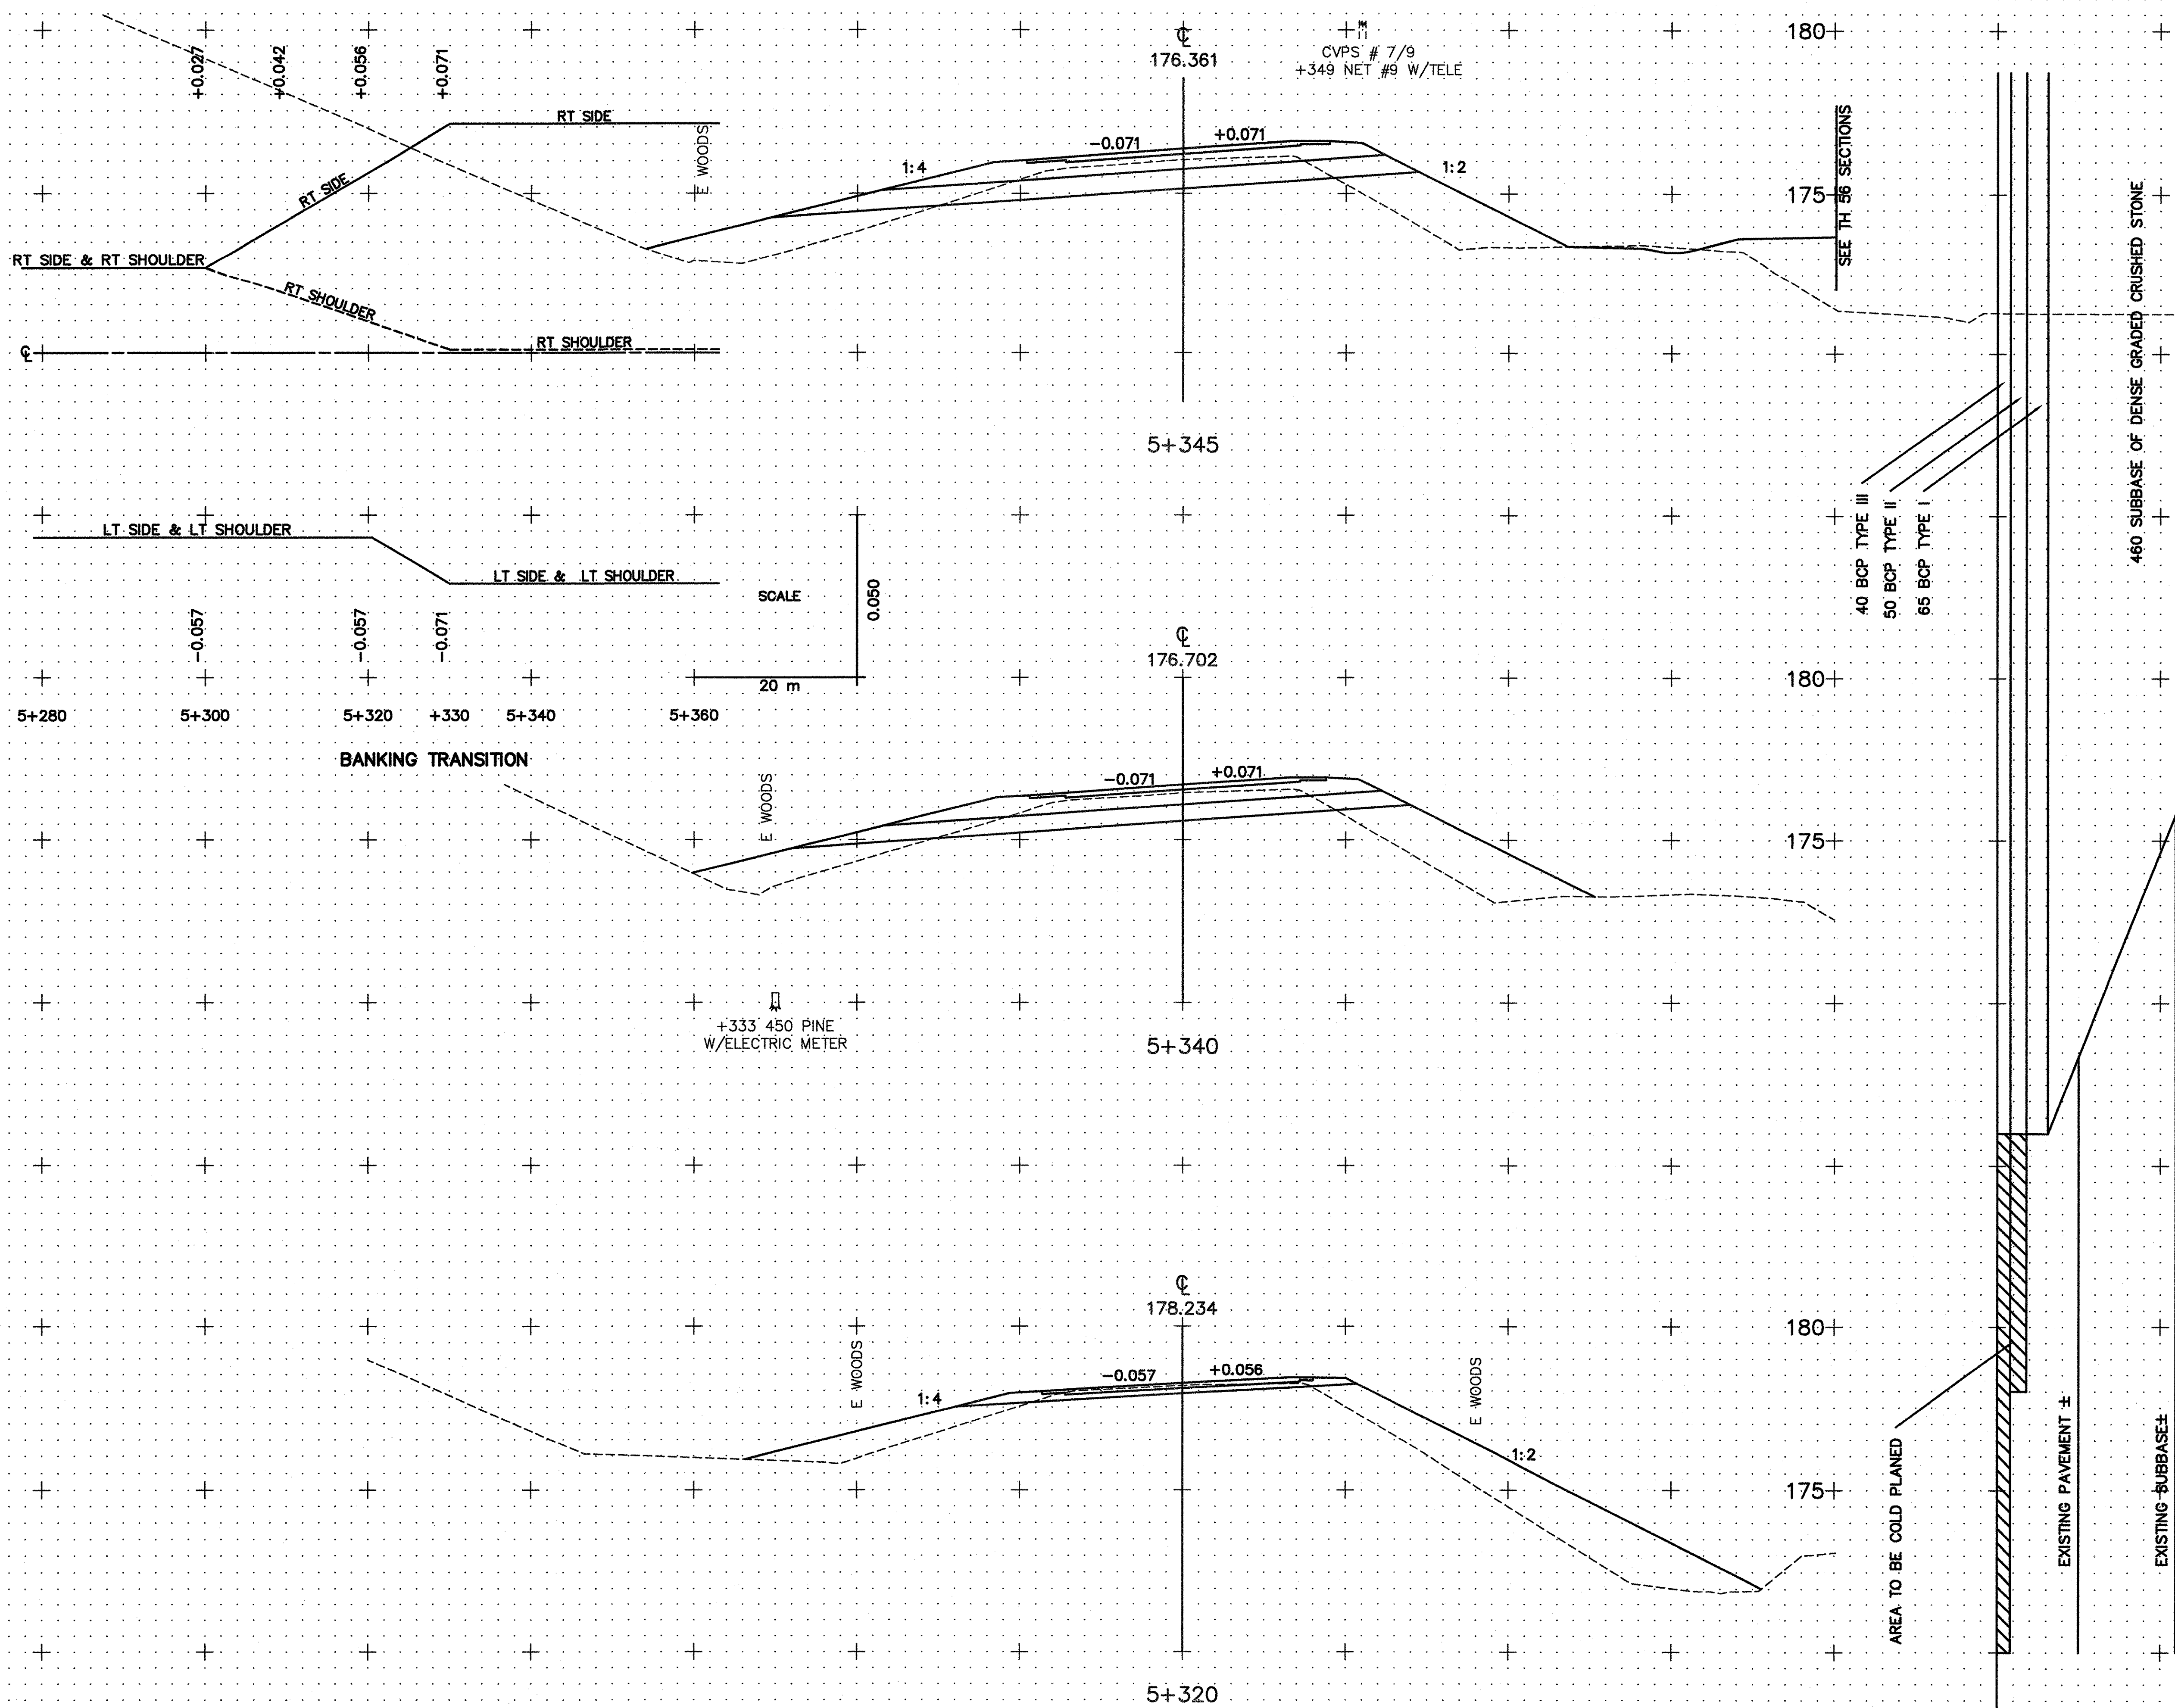

SEE TH 86 SECTIONS

- 40 BCP TYPE III
- 50 BCP TYPE II
- 65 BCP TYPE I

AREA TO BE COLD PLANED

FROM STA.	5+320	TO STA.	5+345
PROJECT NAME	JAMAICA MAIN LINE		
NO.	BRF 013-1(8)	PLOTTED	11/06/97
SURVEYED BY	CLD	DATE	OCT. 1995
SHEET	96	OF	116 SHEETS

