


FINAL SURVEY	DATE
NOTED	
NO	

ORIGINAL SURVEY	DATE
NOTED	
NO	

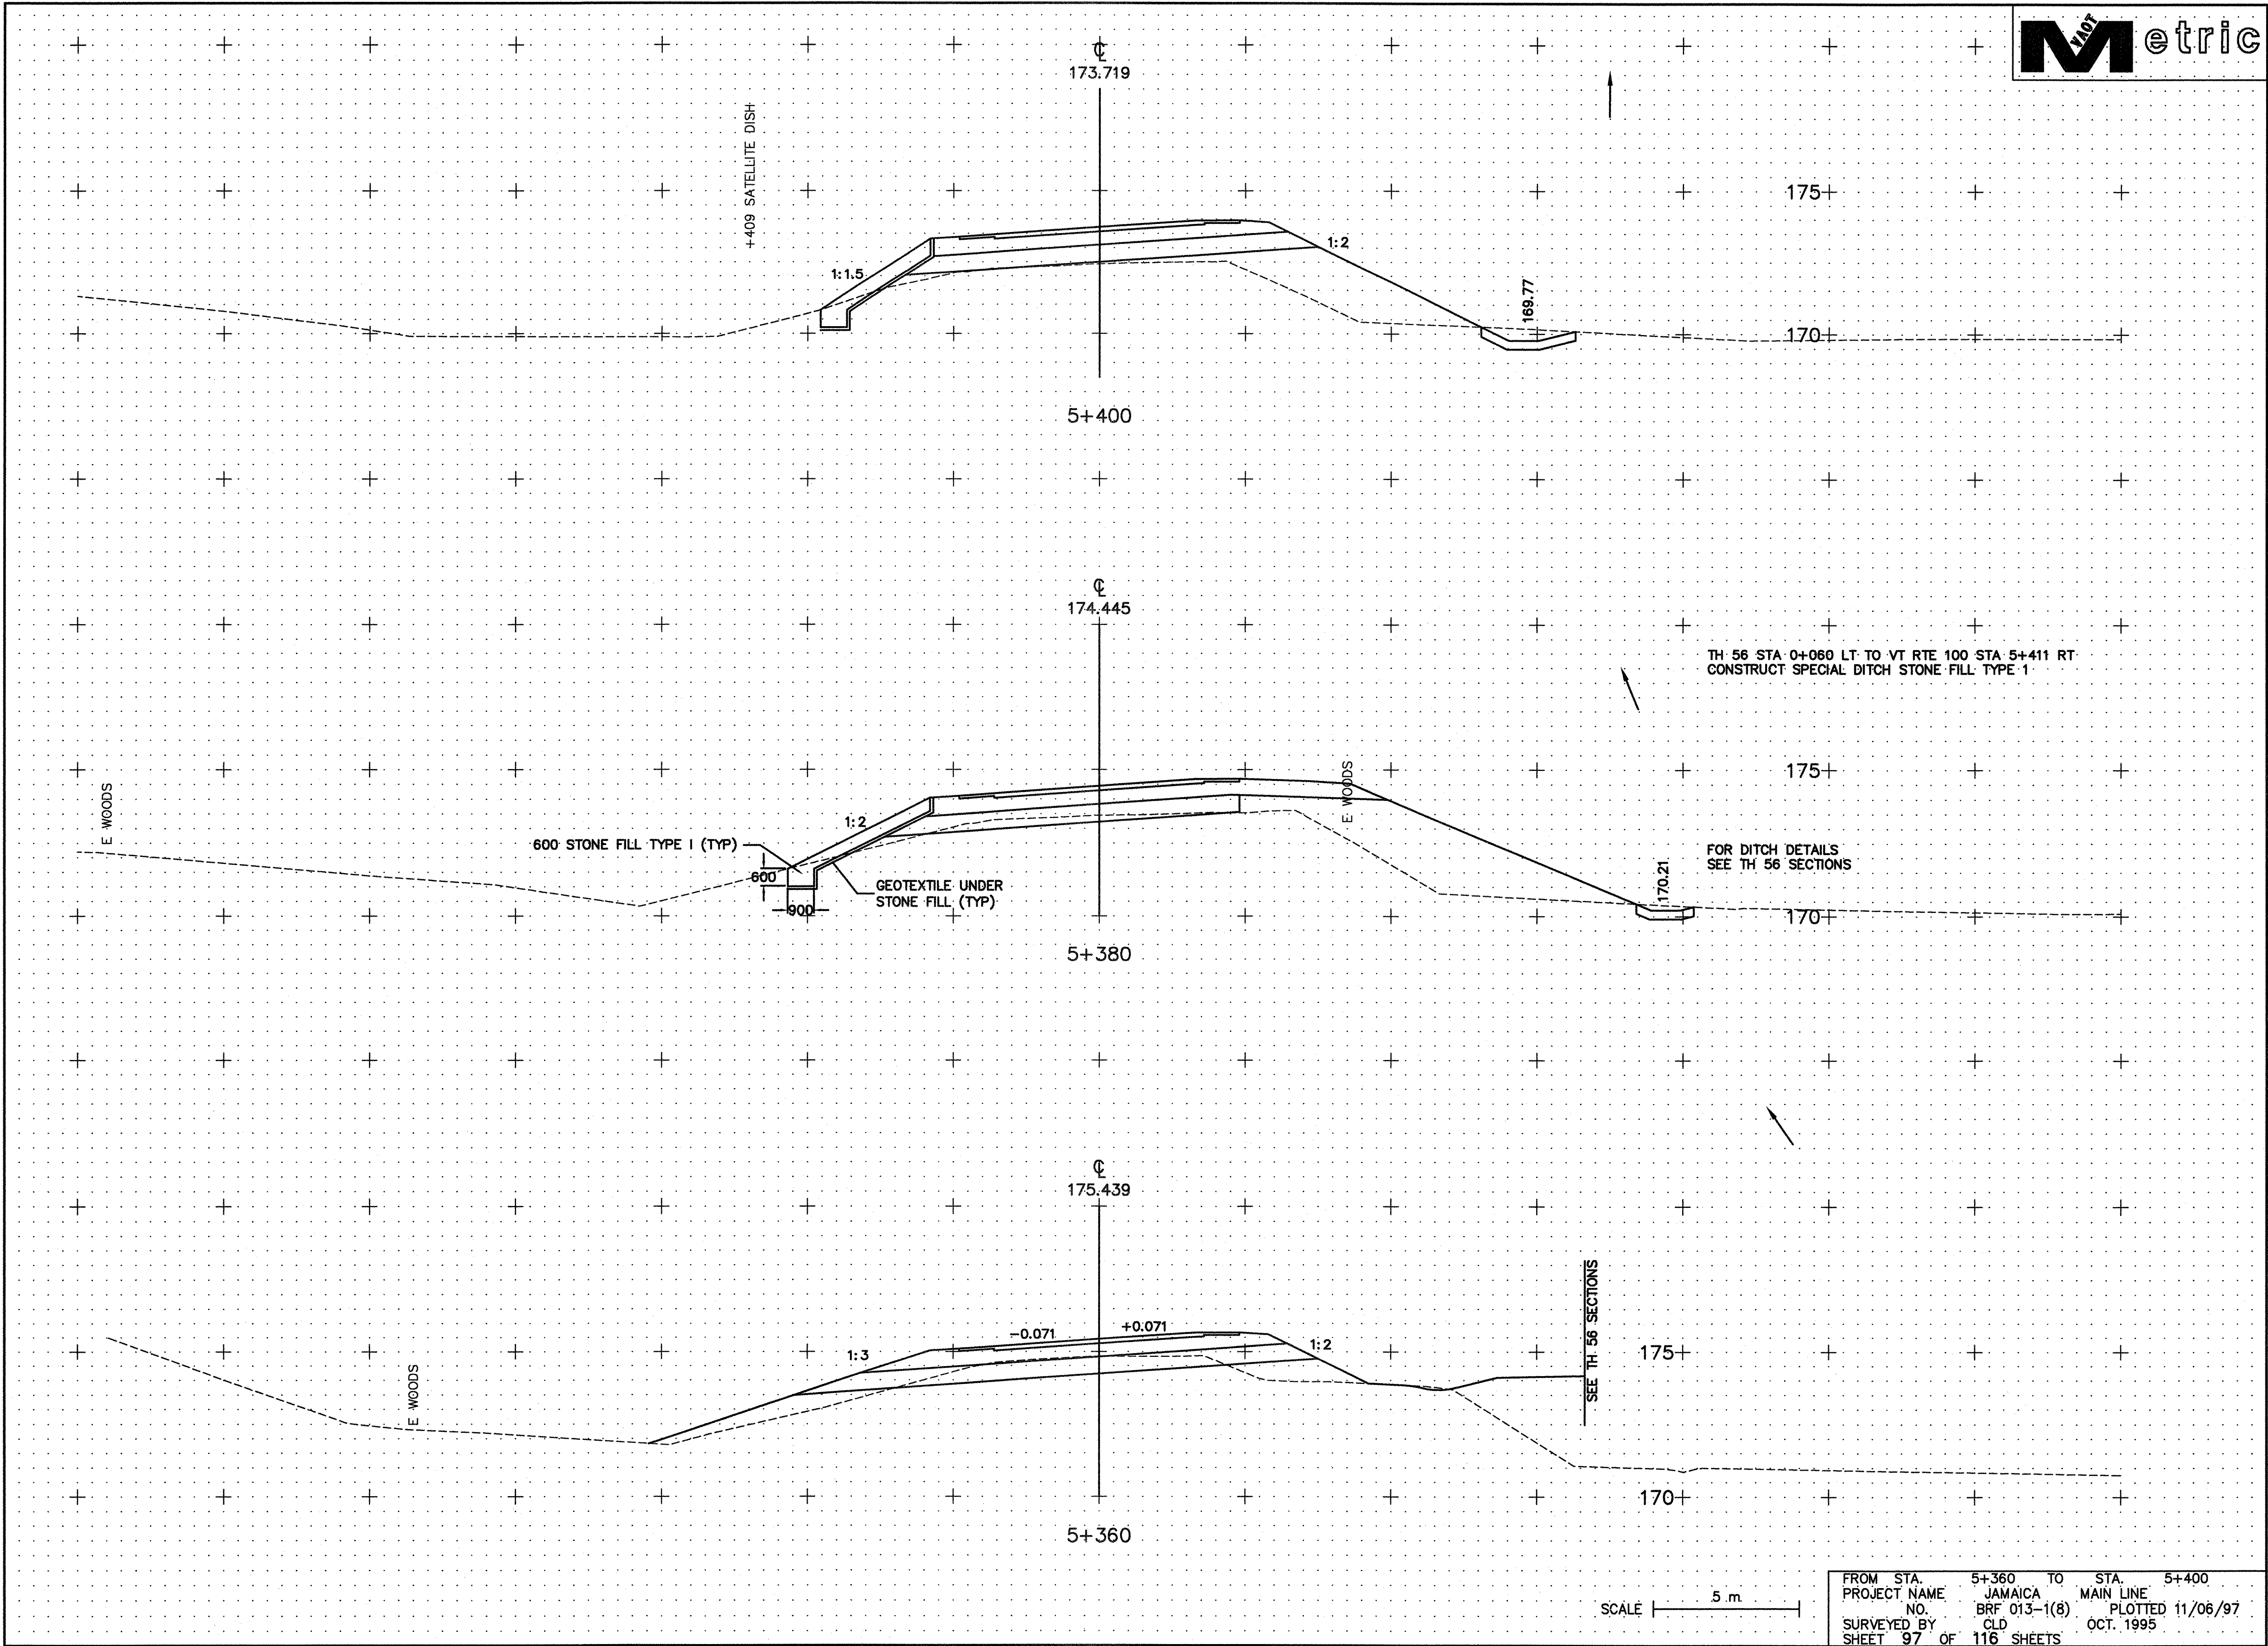

TH 56 STA 0+060 LT TO VT RTE 100 STA 5+411 RT
CONSTRUCT SPECIAL DITCH STONE FILL TYPE 1

FOR DITCH DETAILS
SEE TH 56 SECTIONS

SEE TH 56 SECTIONS

SCALE 5 m

FROM STA.	5+360	TO STA.	5+400
PROJECT NAME	JAMAICA MAIN LINE		
NO.	BRF 013-1(8)		
SURVEYED BY	CLD	PLOTTED	11/06/97
SHEET	97	OF	116 SHEETS