


DATE	
BY	
APPROVED	
DATE	
NO.	
CHECKED	
NO.	

DATE	
BY	
APPROVED	
DATE	
NO.	
CHECKED	
NO.	

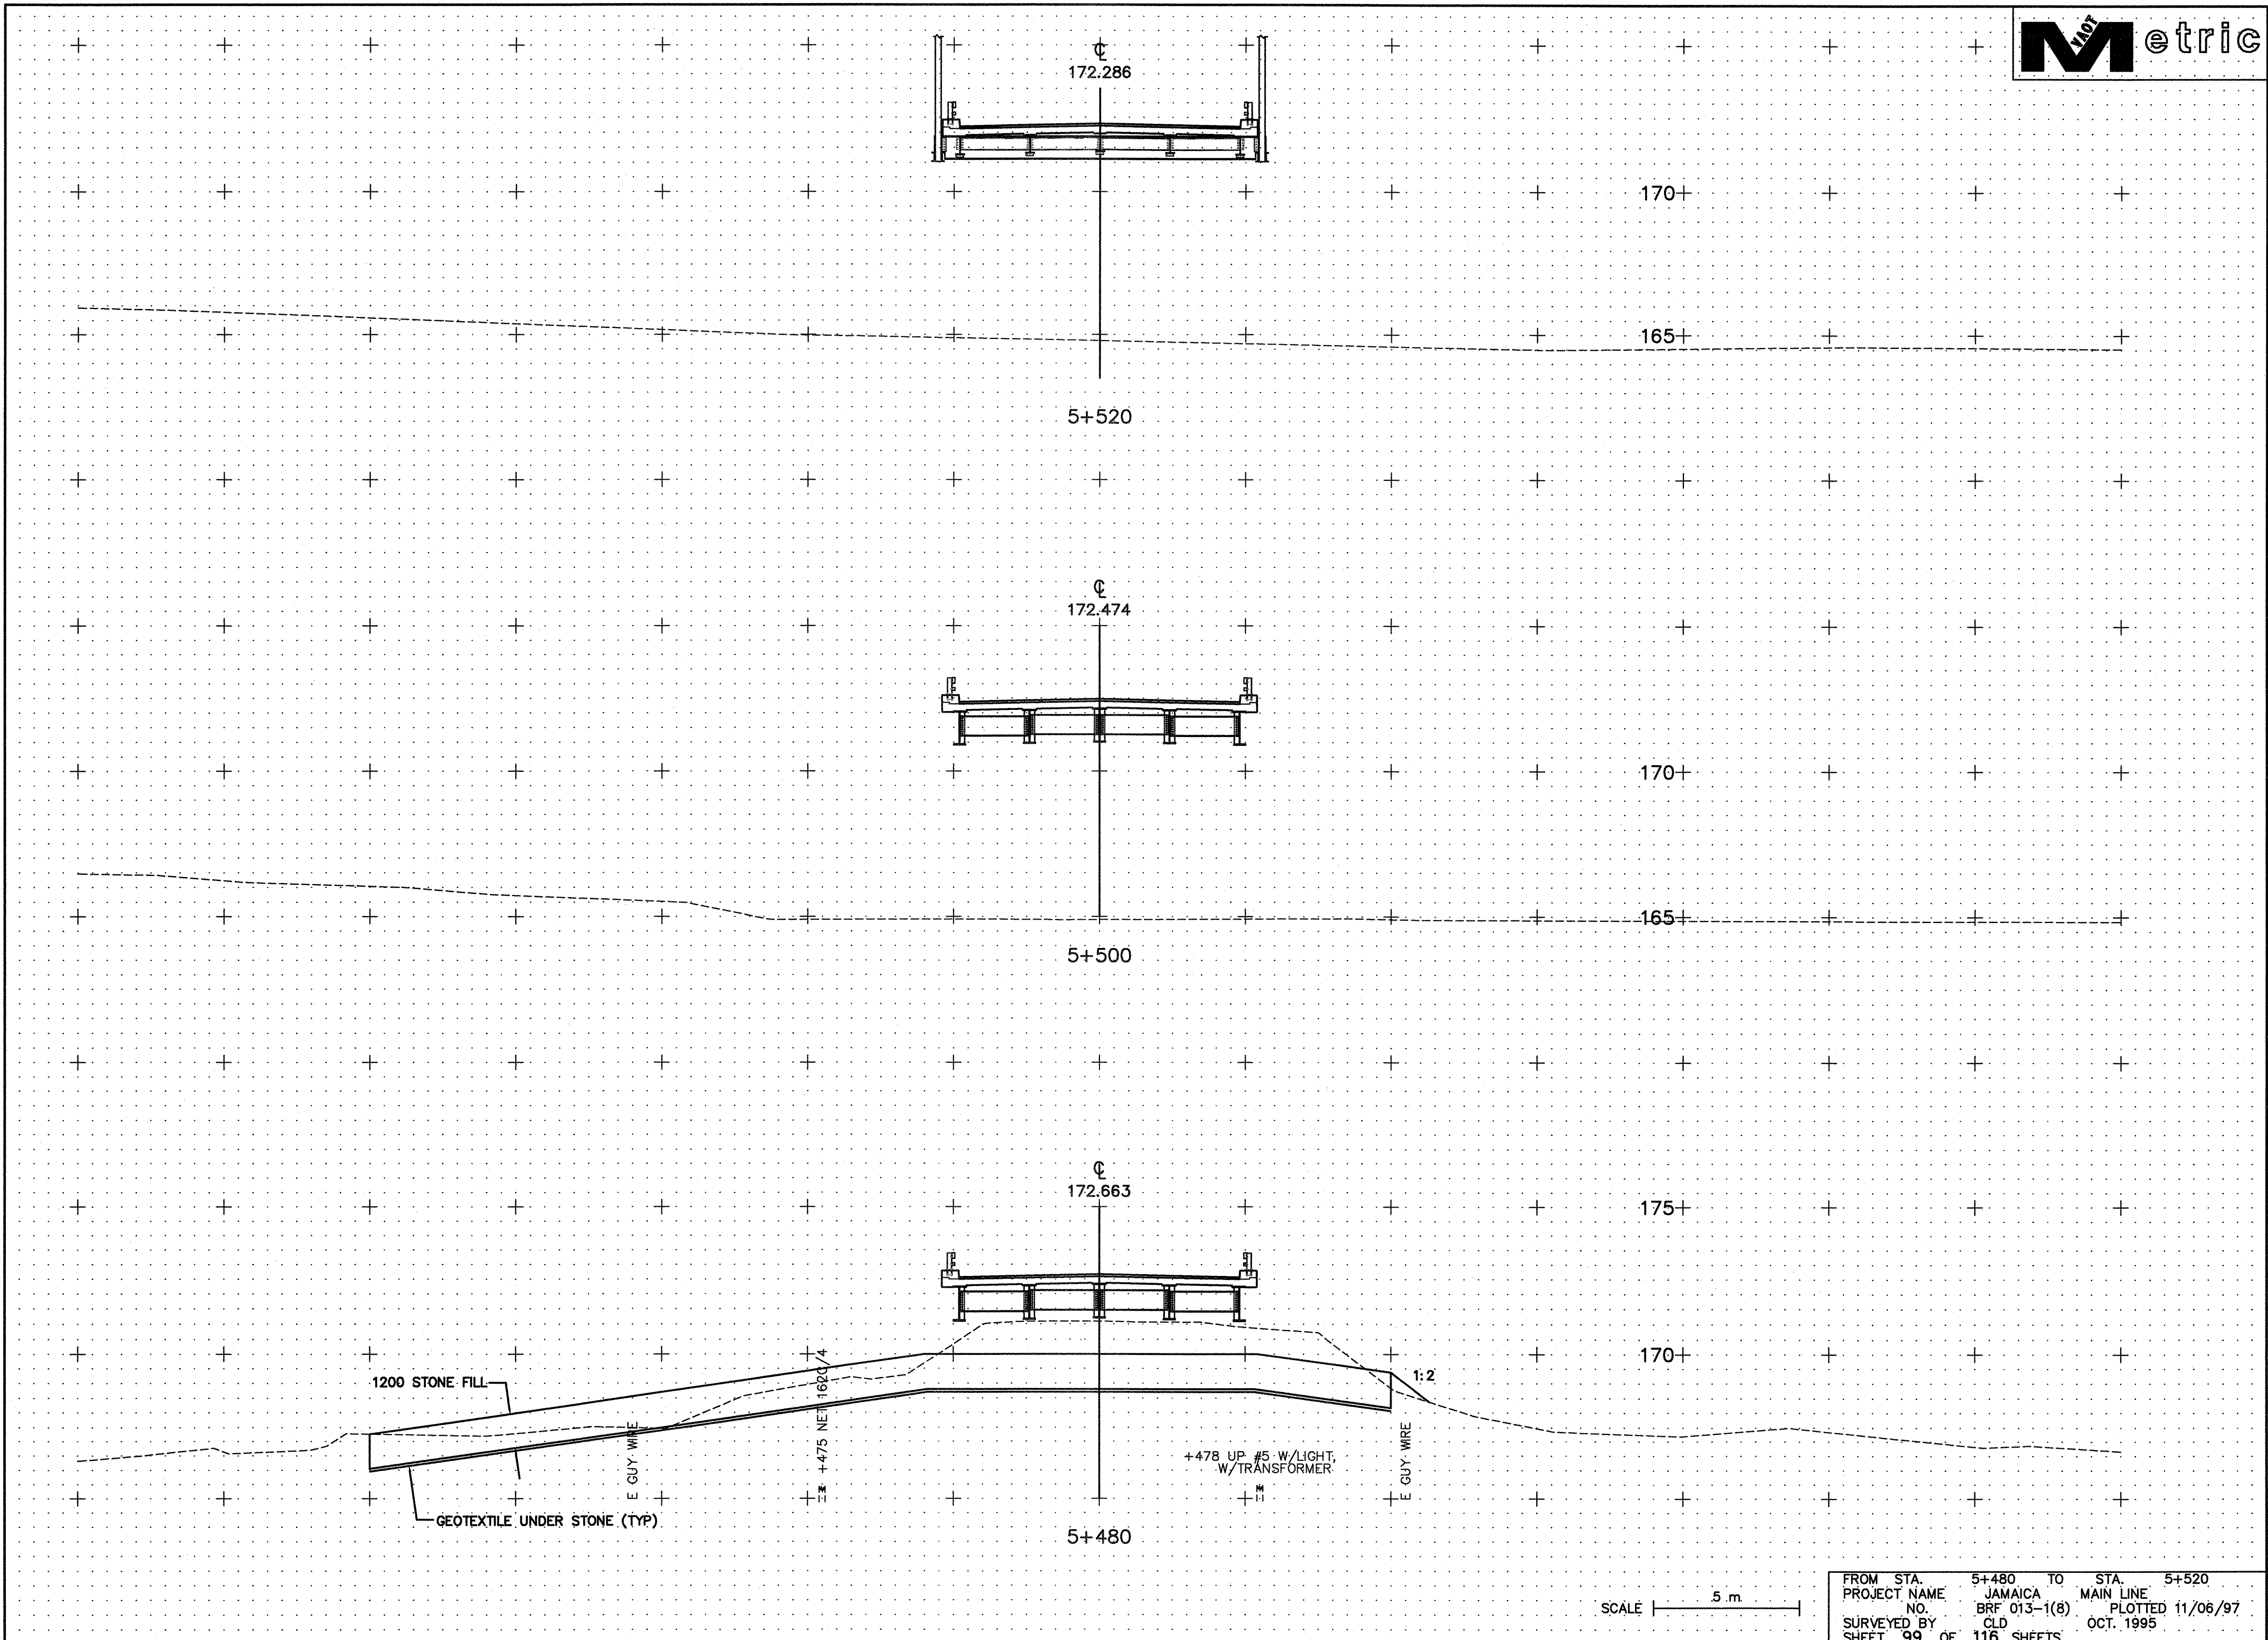

FROM STA.	5+480	TO STA.	5+520
PROJECT NAME	JAMAICA	MAIN LINE	
NO.	BRF 013-1(8)	PLOTTED	11/06/97
SURVEYED BY	CLD	OCT.	1995
SHEET 99 OF	116 SHEETS		