
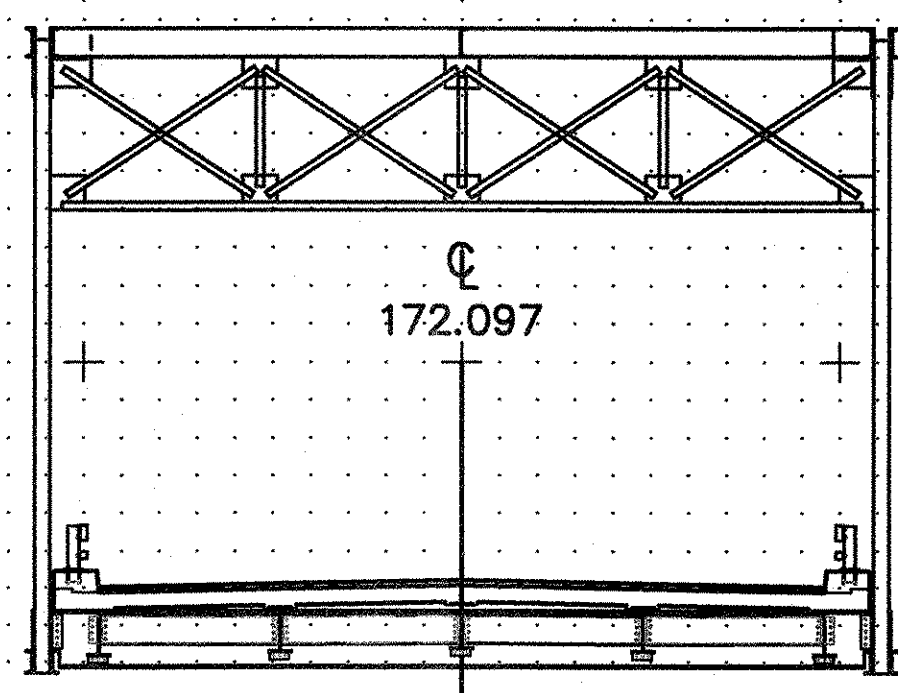


DATE	
BY	
REVISIONS	
NO.	
DATE	
BY	
REVISIONS	
NO.	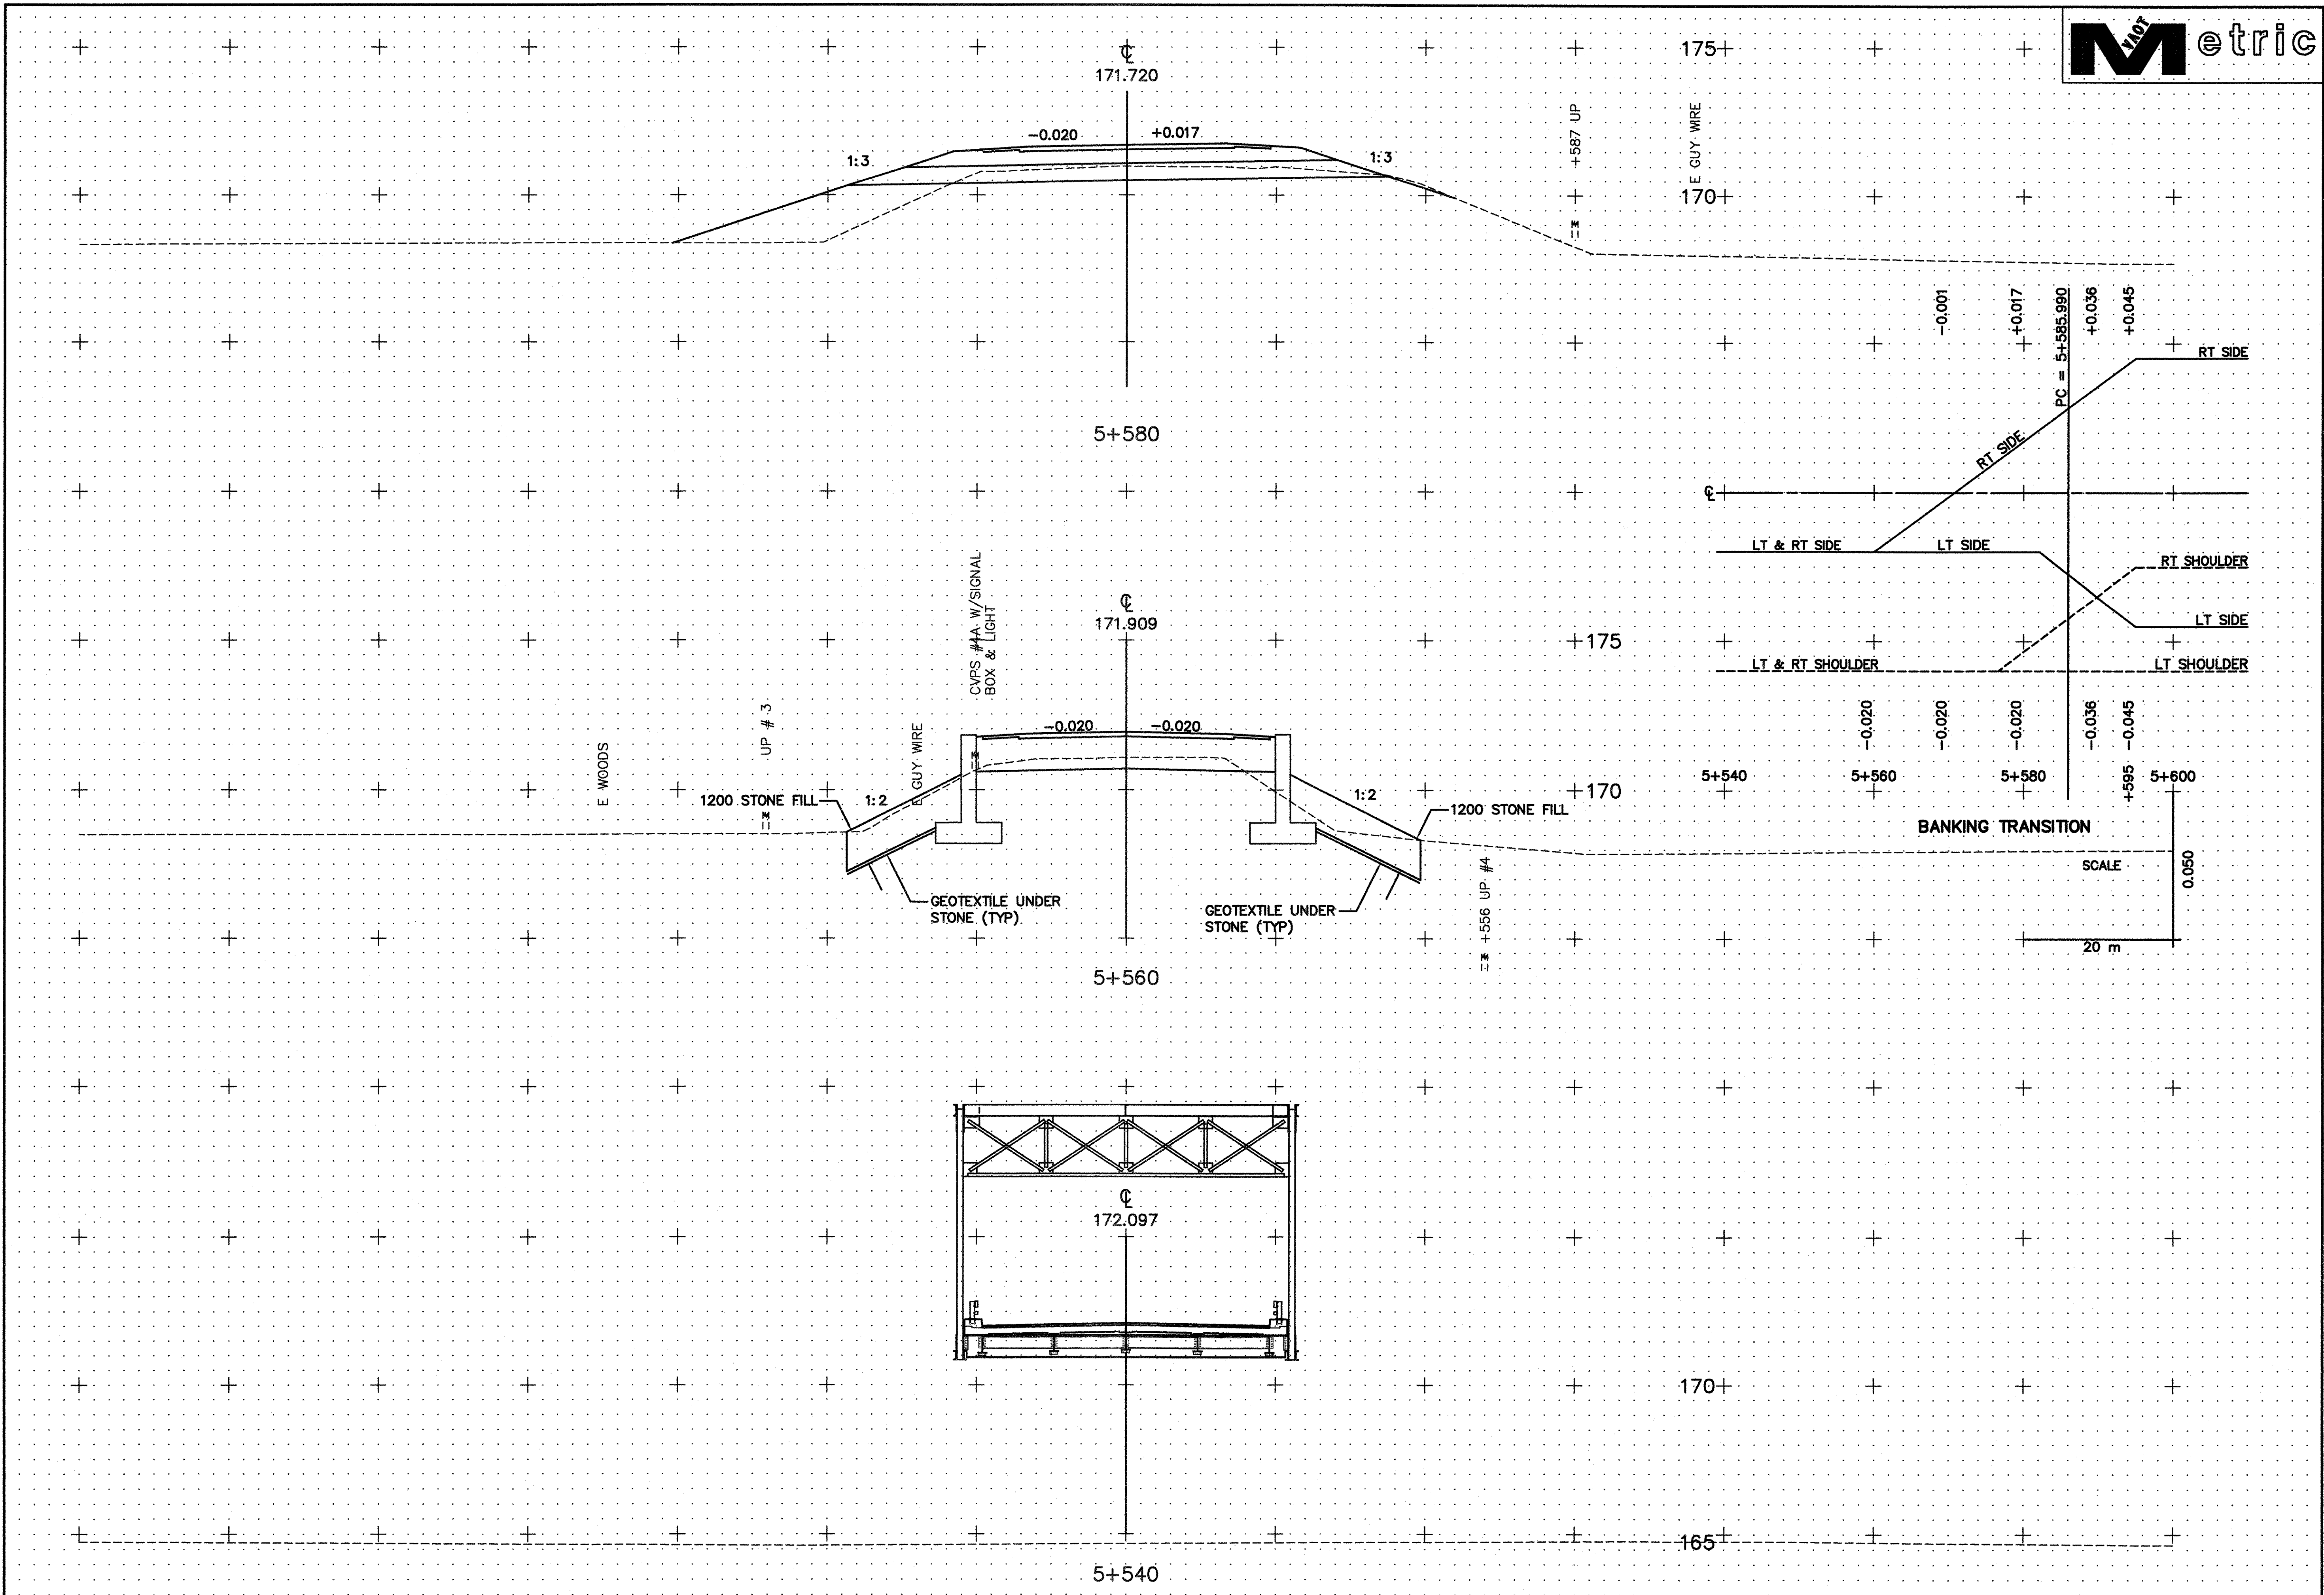
SCALE 5 m

FROM STA. 5+540 TO STA. 5+580
 PROJECT NAME JAMAICA MAIN LINE
 NO. BR 013-1(8) PLOTTED 11/06/97
 SURVEYED BY CLD OCT. 1995
 SHEET 100 OF 116 SHEETS